


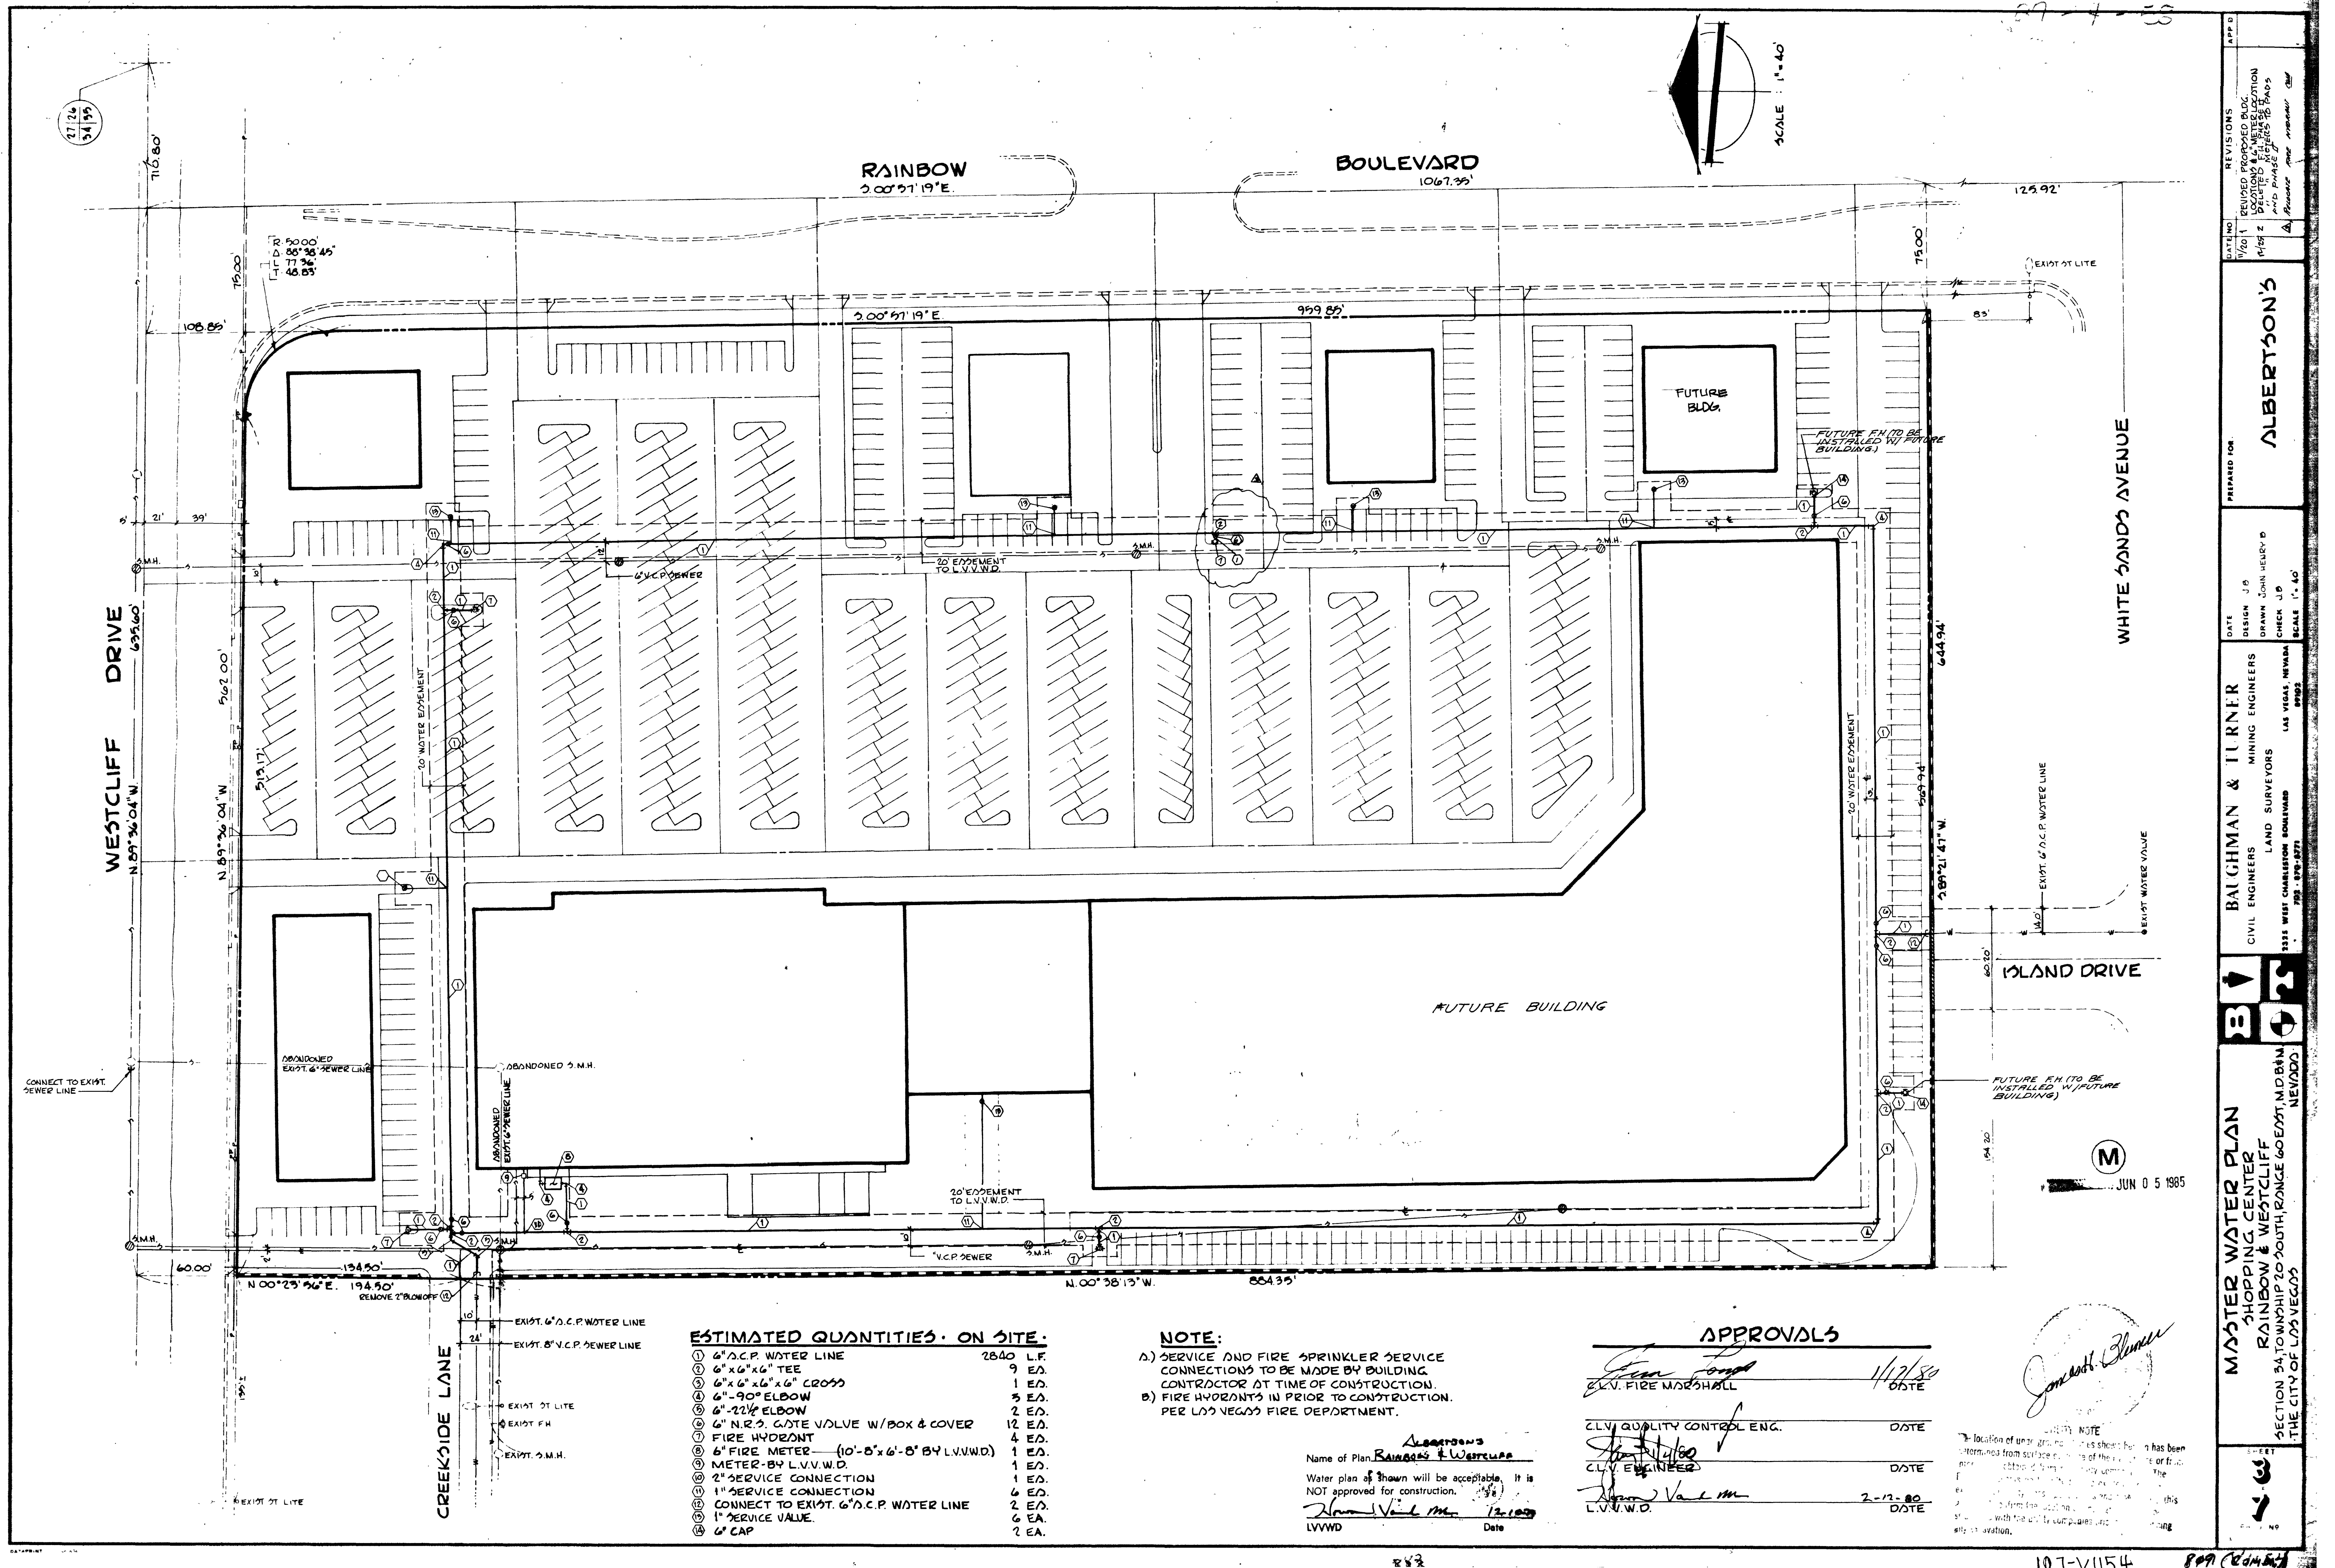

ESTIMATED QUANTITIES - ON SITE:

1) 6" A.C.P. WATER LINE	2840 L.F.
2) 6" x 6" x 6" TEE	9 EA.
3) 6" x 6" x 6" x 6" CROSS	1 EA.
4) 6" - 90° ELBOW	3 EA.
5) 6" - 22 1/2° ELBOW	2 EA.
6) 6" N.R.S. GATE VALVE W/BOX & COVER	12 EA.
7) FIRE HYDRANT	4 EA.
8) 6" FIRE METER (10'-8" x 6'-8" BY L.V.V.W.D.)	1 EA.
9) METER-BY L.V.V.W.D.	1 EA.
10) 2" SERVICE CONNECTION	1 EA.
11) 1" SERVICE CONNECTION	6 EA.
12) CONNECT TO EXIST. 6" A.C.P. WATER LINE	2 EA.
13) 1" SERVICE VALVE	6 EA.
14) 6" CAP	2 EA.

NOTE:

- A) SERVICE AND FIRE SPRINKLER SERVICE CONNECTIONS TO BE MADE BY BUILDING CONTRACTOR AT TIME OF CONSTRUCTION.
B) FIRE HYDRANTS IN PRIOR TO CONSTRUCTION. PER LAS VEGAS FIRE DEPARTMENT.

Name of Plan: Albertson's Shopping Center
Water plan as shown will be acceptable. It is NOT approved for construction.
James V. Valm 12-10-85
L.V.V.W.D. Date

APPROVALS

James V. Valm 11/2/85
CITY ENGINEER
DATE
James V. Valm 2-12-80
CITY ENGINEER
DATE

NOTE: The location of underground utilities shown on this plan has been determined from surface evidence and is not guaranteed. The City of Las Vegas is not responsible for the accuracy of this information. The user of this plan is advised to verify the location of underground utilities before construction.

REVISIONS	APPROVED FOR	DATE	DESIGN	CHECK	SCALE
1. REVISED PROPOSED LOCATIONS OF UTILITIES AND PHASE 2	ALBERTSON'S	JUN 5 1985	J.S.	J.P.	1"=40'
2. DELETED EXISTING UTILITIES					
3. DELETED EXISTING UTILITIES					
