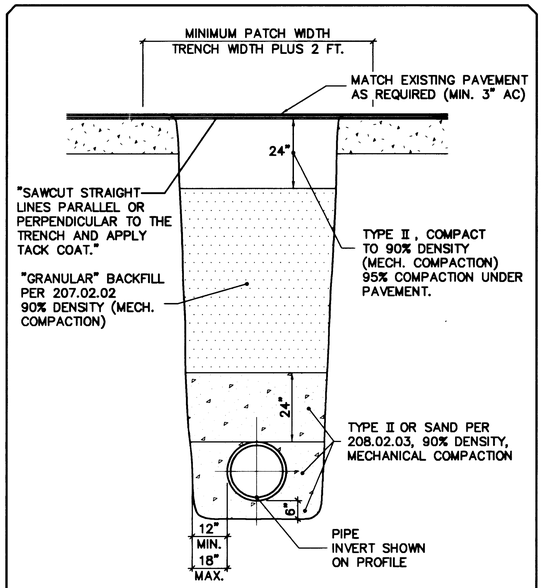

TRENCH SECTION

NOT TO SCALE

3/10

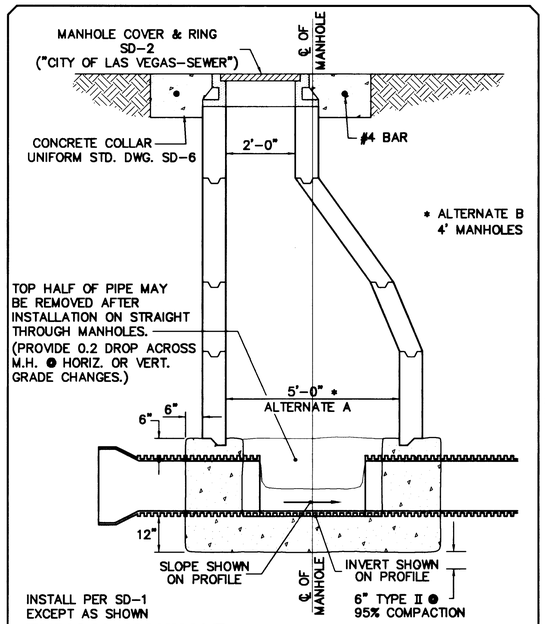

TYPICAL MANHOLE

NOT TO SCALE

2/10

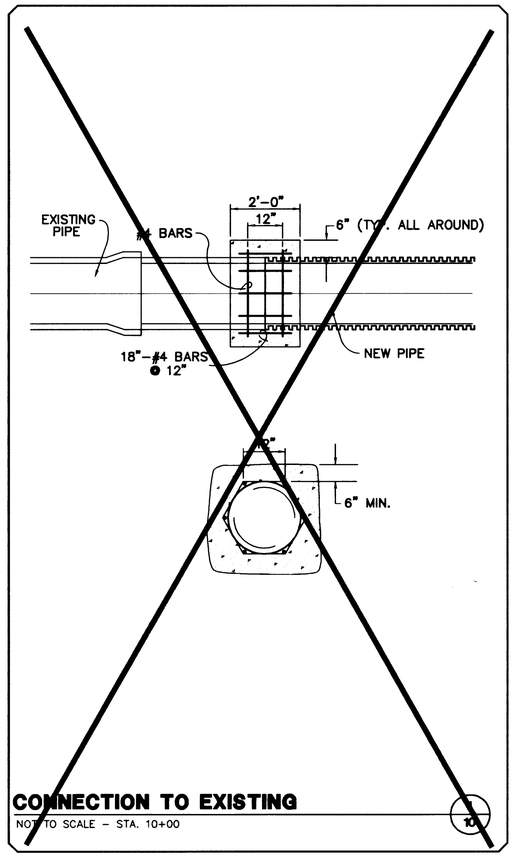

CONNECTION TO EXISTING

NOT TO SCALE – STA. 10+00

10

NO.	DESCRIPTION	DATE	APP'D

RECOMMENDED FOR APPROVAL — STATE OF NEVADA — NYTHAN D. WILLIAMS, R. E. — DATE 12/19/97 — No. 7248

DATE :	12/27/96
DRAWN BY :	VKA
DESIGNED BY :	BM
CHECKED BY :	MRW
JOB NO. :	158.0001
SCALE :	

PENTACORE
Engineering, Inc.
(702) 258-0115
6763 West Charleston Boulevard
Las Vegas, Nevada 89102

RAINBOW BOULEVARD OFFSITE SEWER
MOUNTAIN SPA DEVELOPMENT
DETAILS

SHEET 10 OF 10

DISK #

D:\0158\0158\0001131\NWT-SW10 Thu Aug 7 11:47:13 1997 J.P.Donalson

201

307-V741

 

 

 

PENTACORE

Engineering, Inc.



DETAILS

10