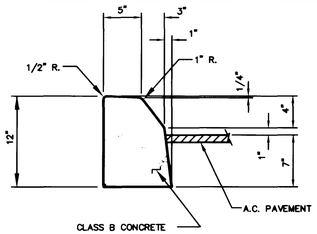


## TYPE "A" CURB DETAIL

NO SCALE (1/9)

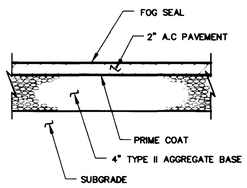


## TYPICAL ONSITE A.C. DETAIL

NO SCALE (2/9)

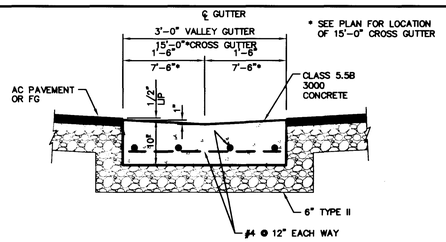


## VALLEY GUTTER / CROSS GUTTER

NO SCALE (3/9)

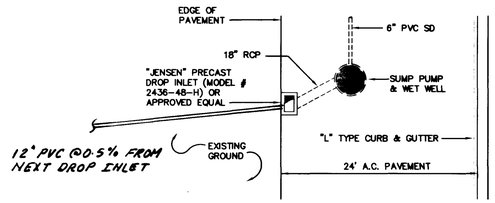


## PLAN

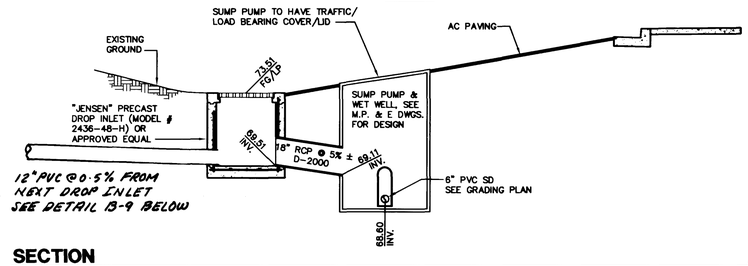


## SECTION

NO SCALE (H/9)

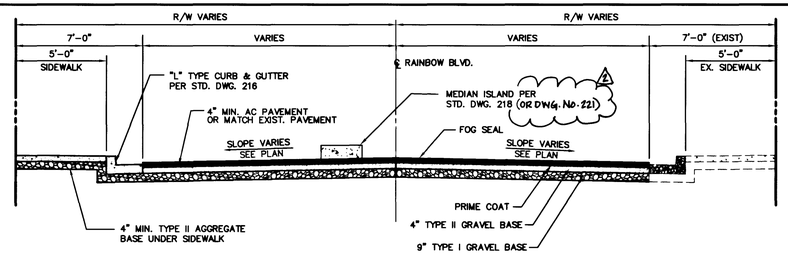


## TYPICAL STREET SECTION - RAINBOW BLVD.

NO SCALE — PER CLARK COUNTY AREA STD. DWG. No. 203 (G/9)

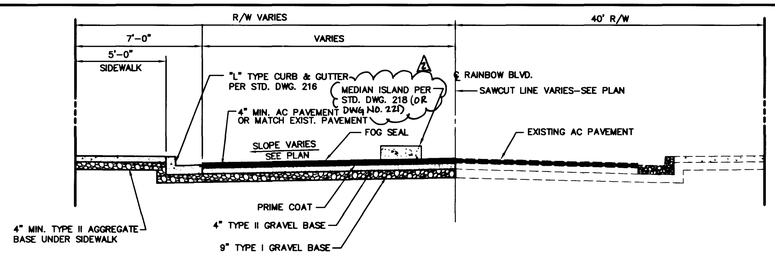


## TYPICAL STREET SECTION - RAINBOW BLVD.

NO SCALE — PER CLARK COUNTY AREA STD. DWG. No. 203 (A/9)

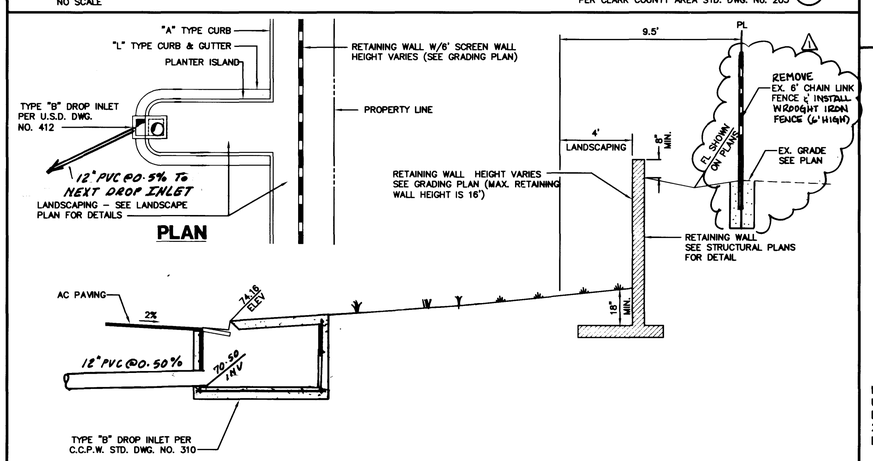


## SECTION

NO SCALE (B/9)

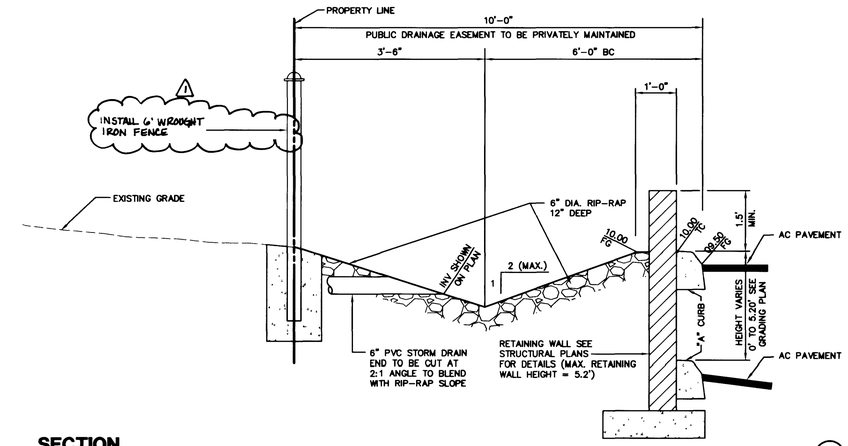


## SECTION

NO SCALE (C/9)

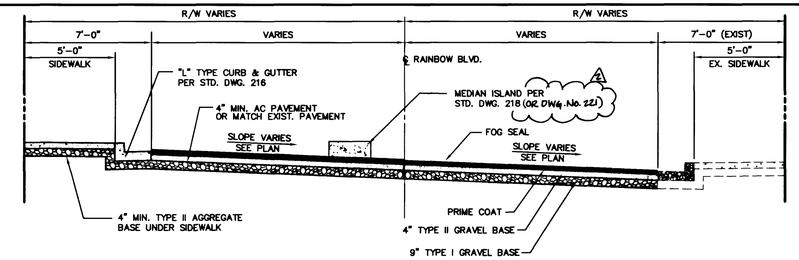


## TYPICAL STREET SECTION - RAINBOW BLVD.

NO SCALE — PER CLARK COUNTY AREA STD. DWG. No. 203 (F/9)

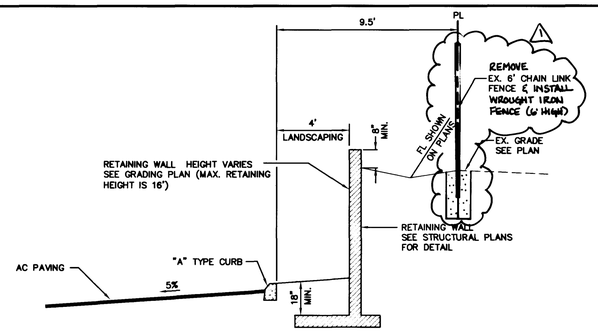


## SECTION

NO SCALE (E/9)

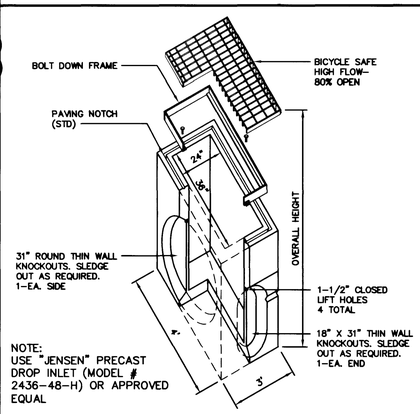


NOTE:
USE "JENSEN" PRECAST DROP INLET (MODEL # 2436-48-H) OR APPROVED EQUAL

## DROP INLET

NO SCALE (6/9)

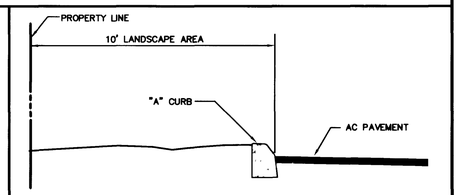


## SECTION

NO SCALE (D/9)

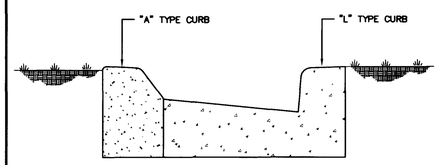


## PLANTER DRAIN

NO SCALE (7/9)

| NO. | REVISION | DATE | APPL |
|---|---|---|---|
| 1 | REPLACE EXIST. CHAIN LINK FENCE W/WROUGHT IRON FENCE. | 7/21/98 | |
| 2 | ADD TACE-ON ISLAND OPTION PER DWG. NO. 221 | 7/21/98 | |
| 3 | Combine Sump Area to One Sump Pump | 7/27/98 | |

DESIGNED BY: RF — DRAWN BY: SJW — CHKD BY:
JOB NUMBER: 693-003-963 — DATE: 7-21-98


L. R. NELSON CONSULTING ENGINEERS, INC.
•STRUCTURAL •CIVIL •SURVEY
3035 East Patrick Lane Suite 9
Las Vegas, Nevada 89120
(702) 798-7978
(702) 451-2296 FAX


DETAIL SHEET
RAINBOW CORPORATE CENTER
BORMAN DEVELOPMENT
CITY OF LAS VEGAS NEVADA

SHEET NUMBER
9
OF 12 SHEETS
693-003-963

DRAWING NAME: RCC-DET — LATEST PLOT DATE

H:\Projects\P600\693003\DWG\RCC-DET Thu Aug 27 09:25:50 1998 BY CAROL SCOTT

10106 11928 13576 13997

107-12837

 

TYPE "A" CURB DETAIL


 

VALLEY GUTTER / CROSS GUTTER

 

PLAN

SECTION

TYPICAL STREET SECTION - RAINBOW BLVD.

TYPICAL STREET SECTION - RAINBOW BLVD.

 

PLAN

SECTION

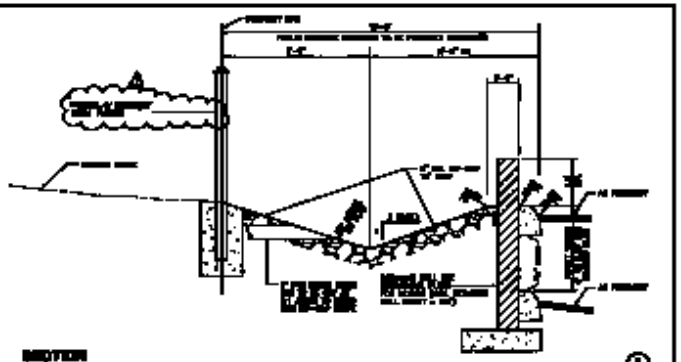

SECTION

TYPICAL STREET SECTION - RAINBOW BLVD.

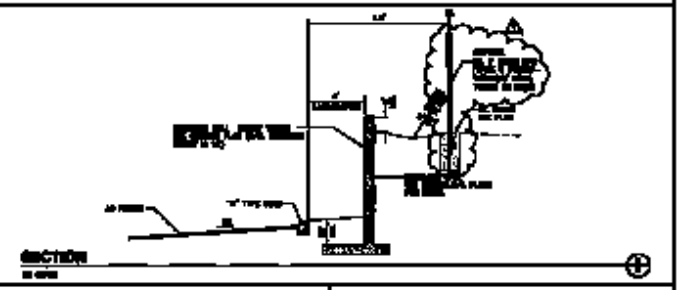

SECTION

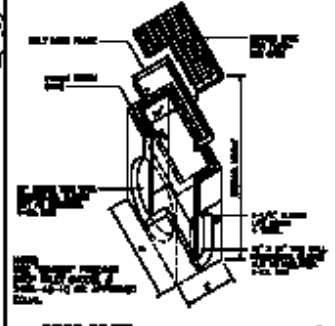

DROP INLET

SECTION

PLANTER DRAIN

DETAIL SHEET

RAINBOW CORPORATE CENTER

SHEET NUMBER 9 OF 12 SHEETS

10/7/2017