


RAINBOW PARK II - UNIT 1

A PORTION OF THE WEST HALF (W1/2) OF THE NORTHWEST QUARTER (NW1/4) OF SECTION 26, T.20S., R.60E., M.D.M.,
CITY OF LAS VEGAS, CLARK COUNTY, NEVADA.

MONUMENTATION TIE MAP

*DIRECT VEHICULAR ACCESS TO RAINBOW BLVD.
FROM THE ADJUTING LOTS IS PROHIBITED.

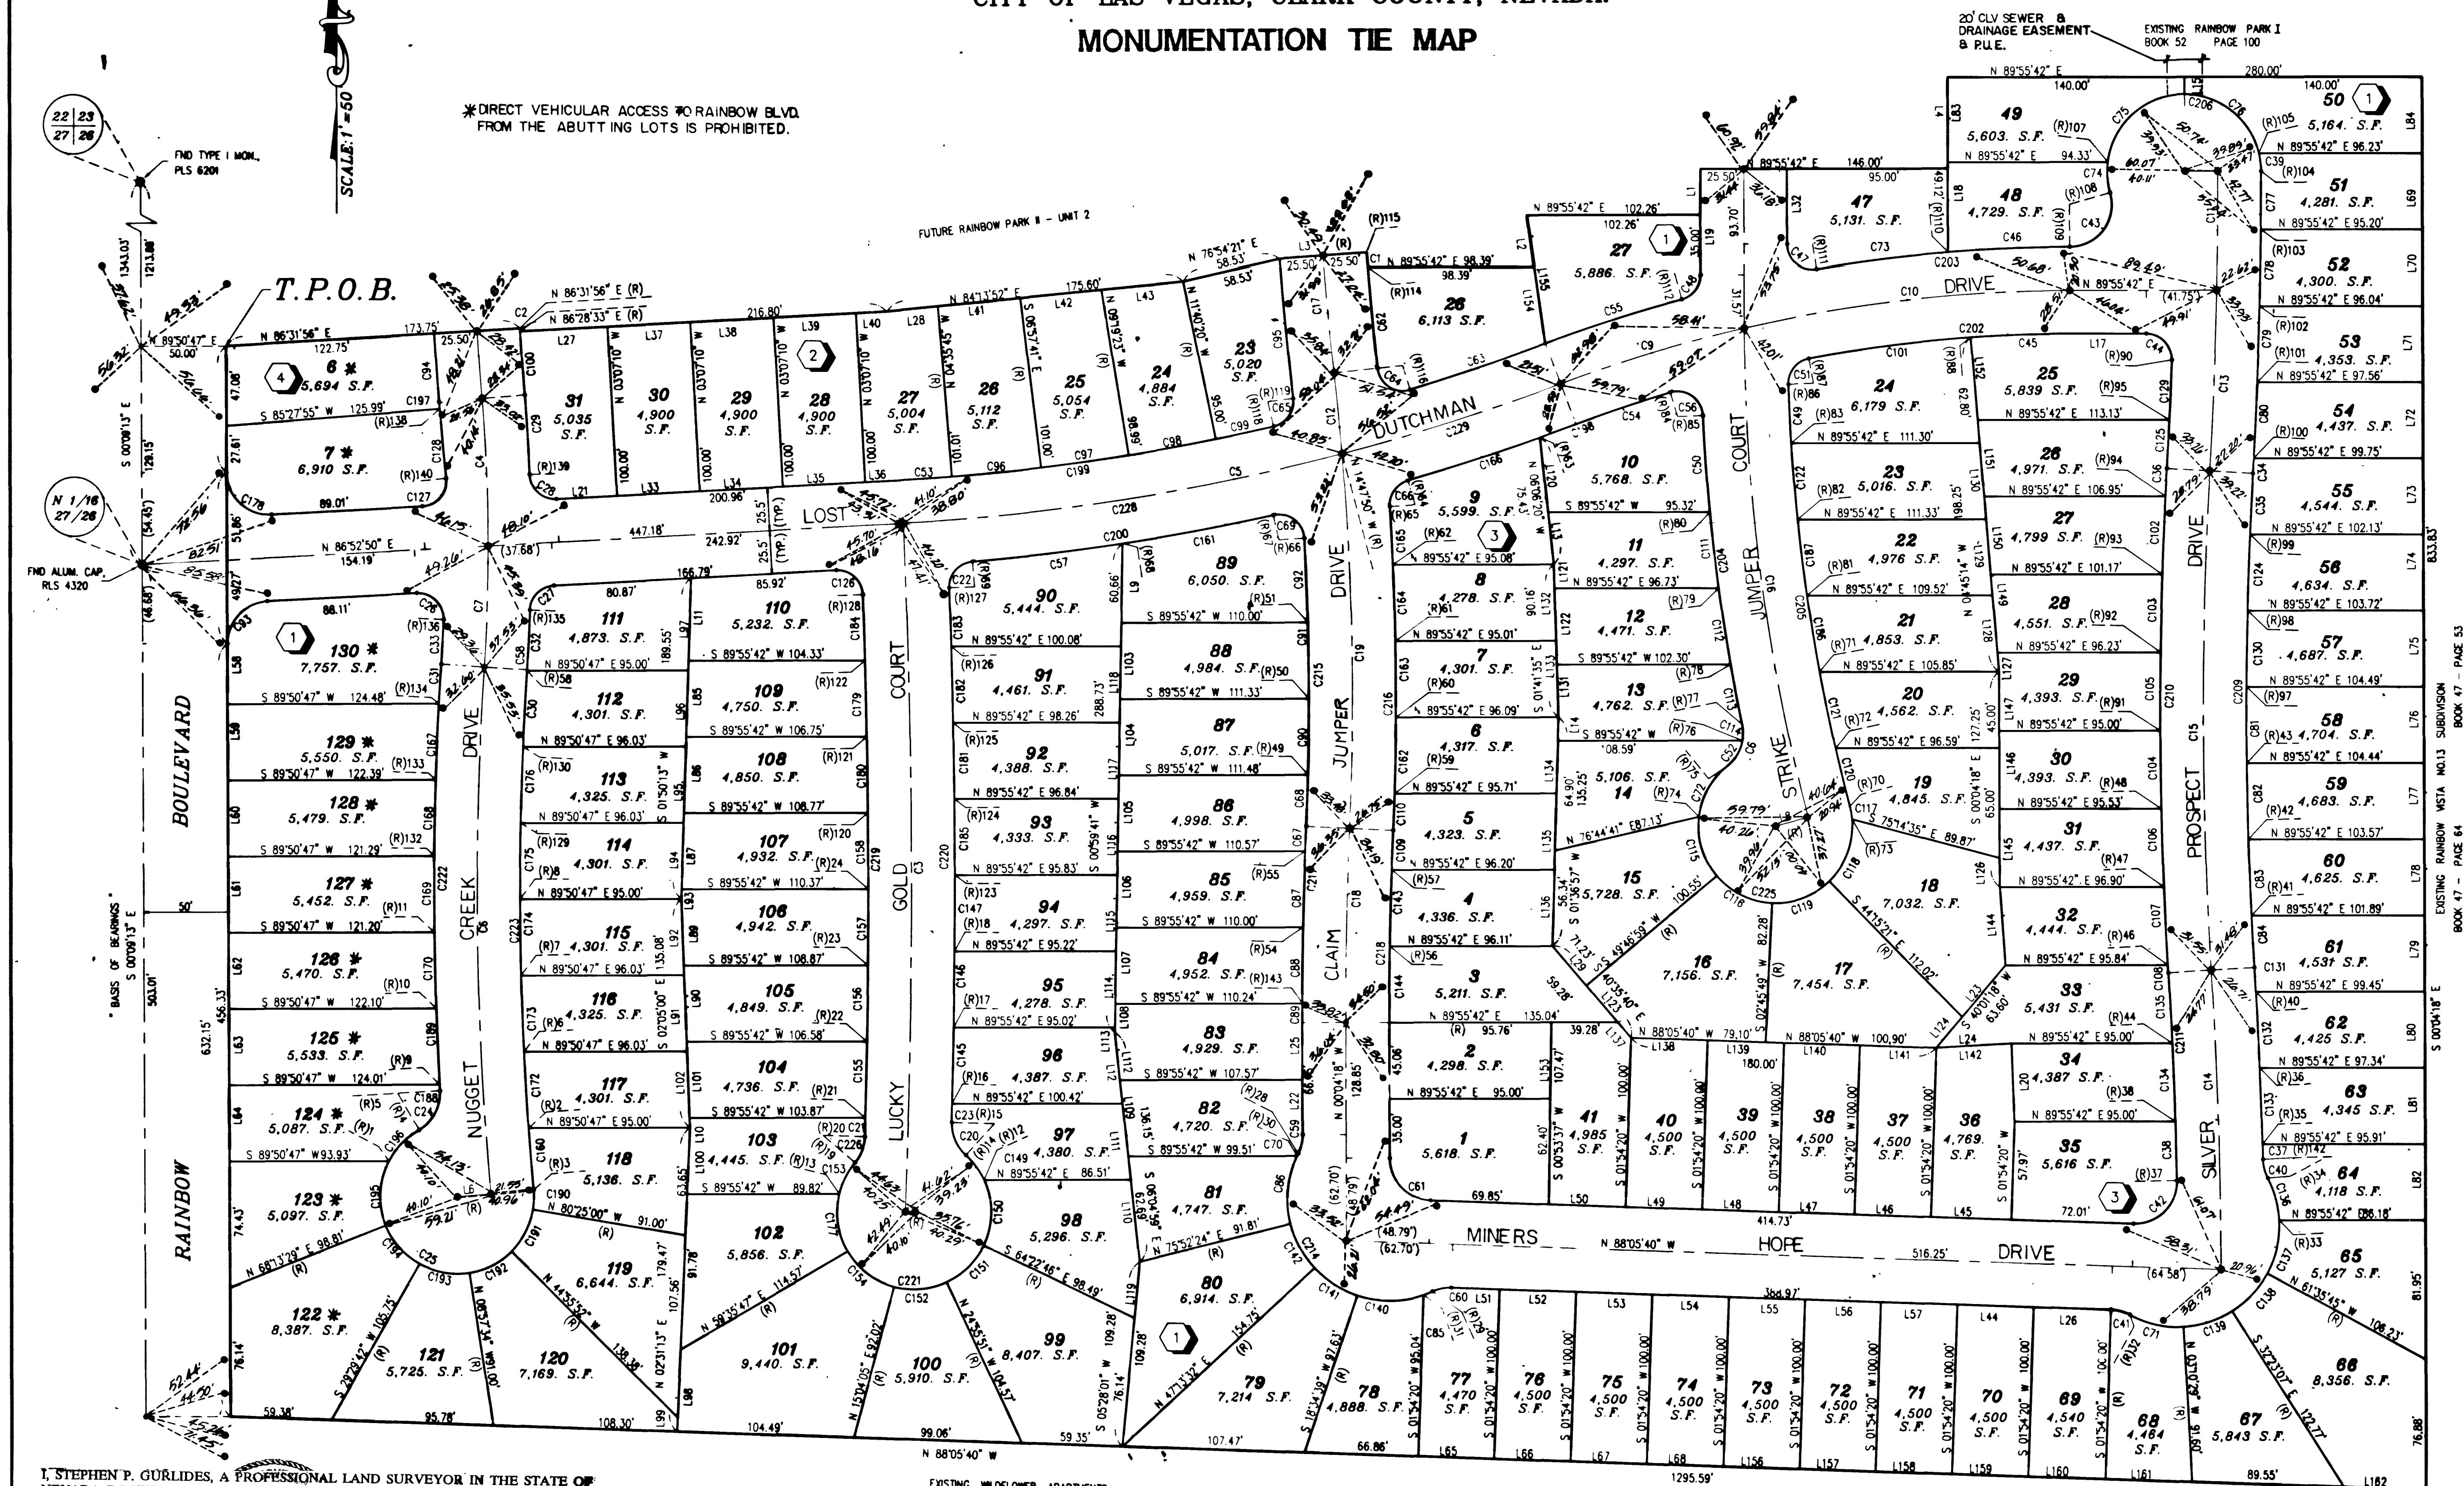

I, STEPHEN P. GURLIDES, A PROFESSIONAL LAND SURVEYOR IN THE STATE OF NEVADA, DO HEREBY CERTIFY THAT THE MONUMENTS HAVE BEEN SET AND THE DISTANCE ESTABLISHED AS SHOWN HEREON. THIS SURVEY WAS COMPLETED ON 10-19-11.

STEPHEN P. GURLIDES
NEVADA CERTIFICATION NO. 9106

NOTE: PURSUANT TO NRS 278.371, ALL REAR LOT CORNERS SHALL BE SET WITH A NAIL & TAG "PLS 9105" ON BLOCK WALLS AND ALL FRONT OR SIDE LOT CORNERS ADJOINING RIGHT-OF-WAY SHALL BE MARKED BY THE SAWCUTTING OF THE BACK OF CURBS ON THE PROLONGATION OF THE PROPERTY LINES.

NOTE: SEE SHEET 3 OF 3 FOR CURVE TABLE, COURSE TABLE, LEGEND AND RADIAL BEARING TABLE.

NOTE: ALL INTERIOR STREETS ARE 51' UNLESS OTHERWISE INDICATED.

W.O. 4426-1
SHEET 2 OF 3

Book 57 Page 62 058-4217-11 (UNIT 1)
11-6-10

RAINBOW PARK II - UNIT 1

CITY OF LAS VEGAS, CLARK COUNTY, NEVADA.

ACKNOWLEDGMENTS THE MAP

