


1944

A PORTION OF THE WEST HALF (W1/2) OF THE NORTHWEST QUARTER (NW1/4) OF SECTION 26, T.20S., R.60E., M.D.M.,
CITY OF LAS VEGAS, CLARK COUNTY, NEVADA.

MONUMENTATION TIE MAP

RAINBOW PARK
A COMMERCIAL SUBDIVISION
BK.50 PG.28

RAINBOW PARK I
BK.52 PG.100

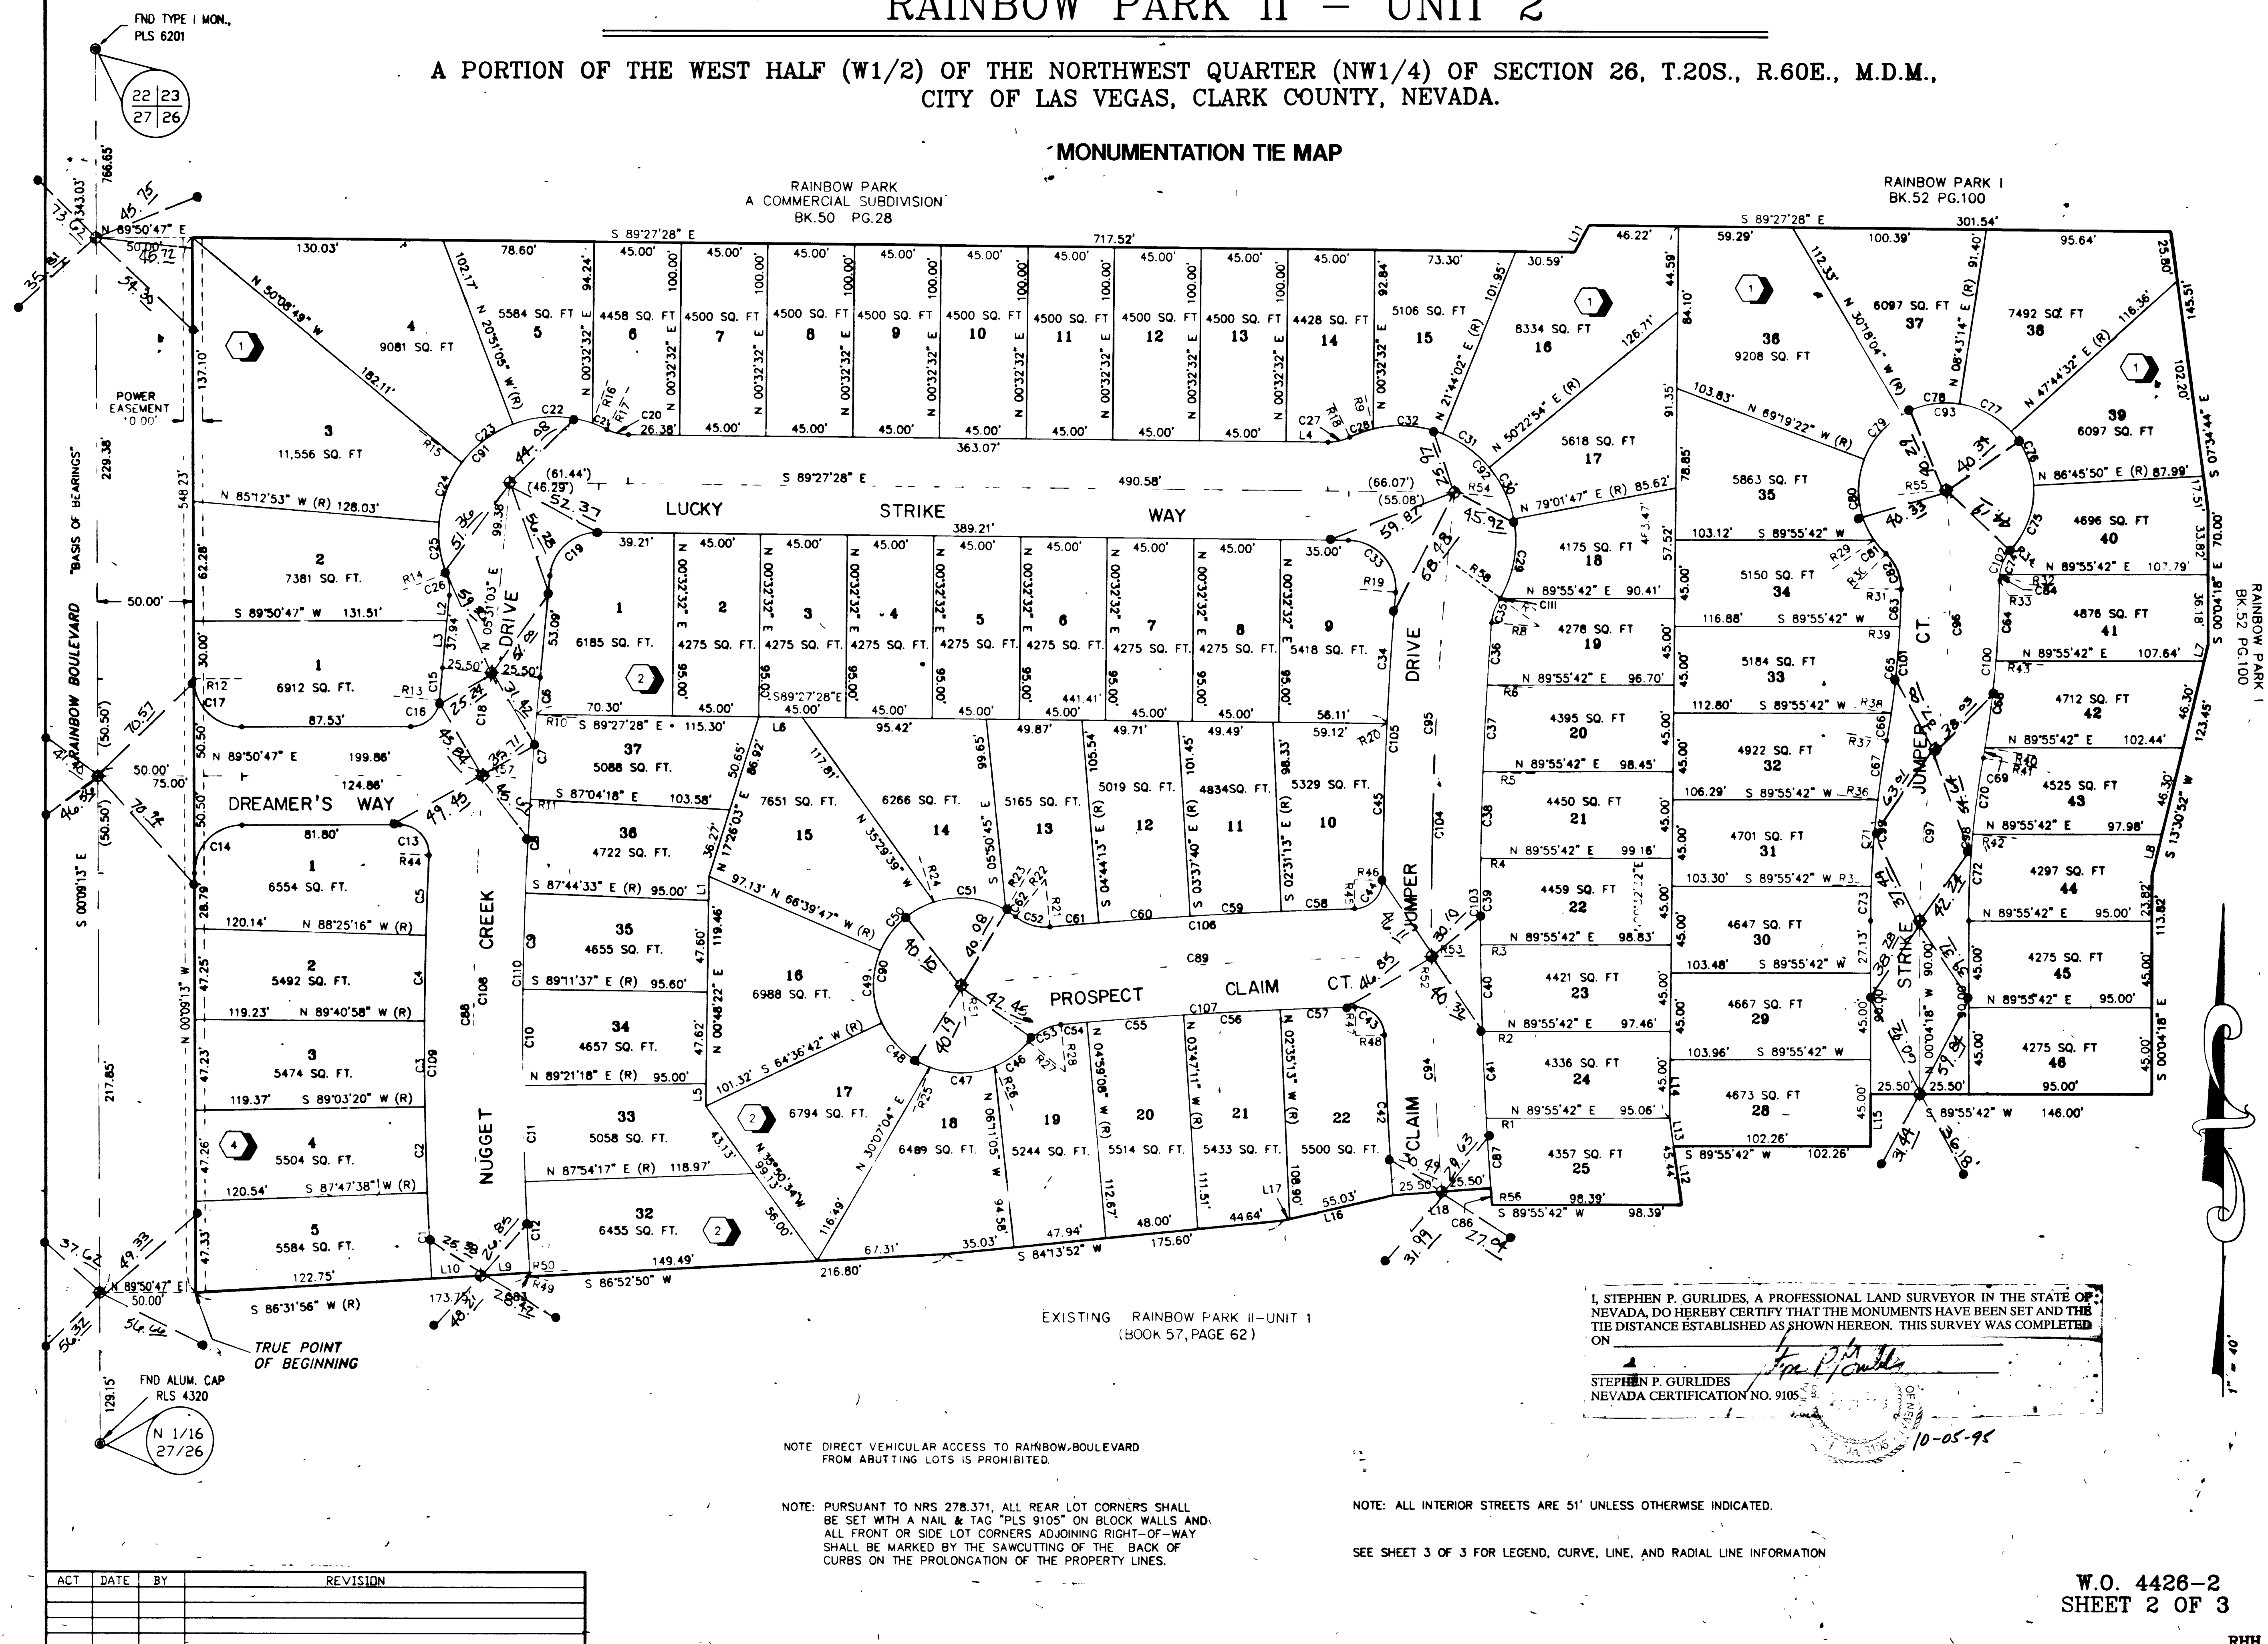

W.O. 4426-2
SHEET 2 OF 3

BOOK 58 PAGE 88
058-4217-II-3

93/022

0194

RAINBOW PARK II - UNIT 2

CITY OF LAS VEGAS, CLARK COUNTY, NEVADA.


