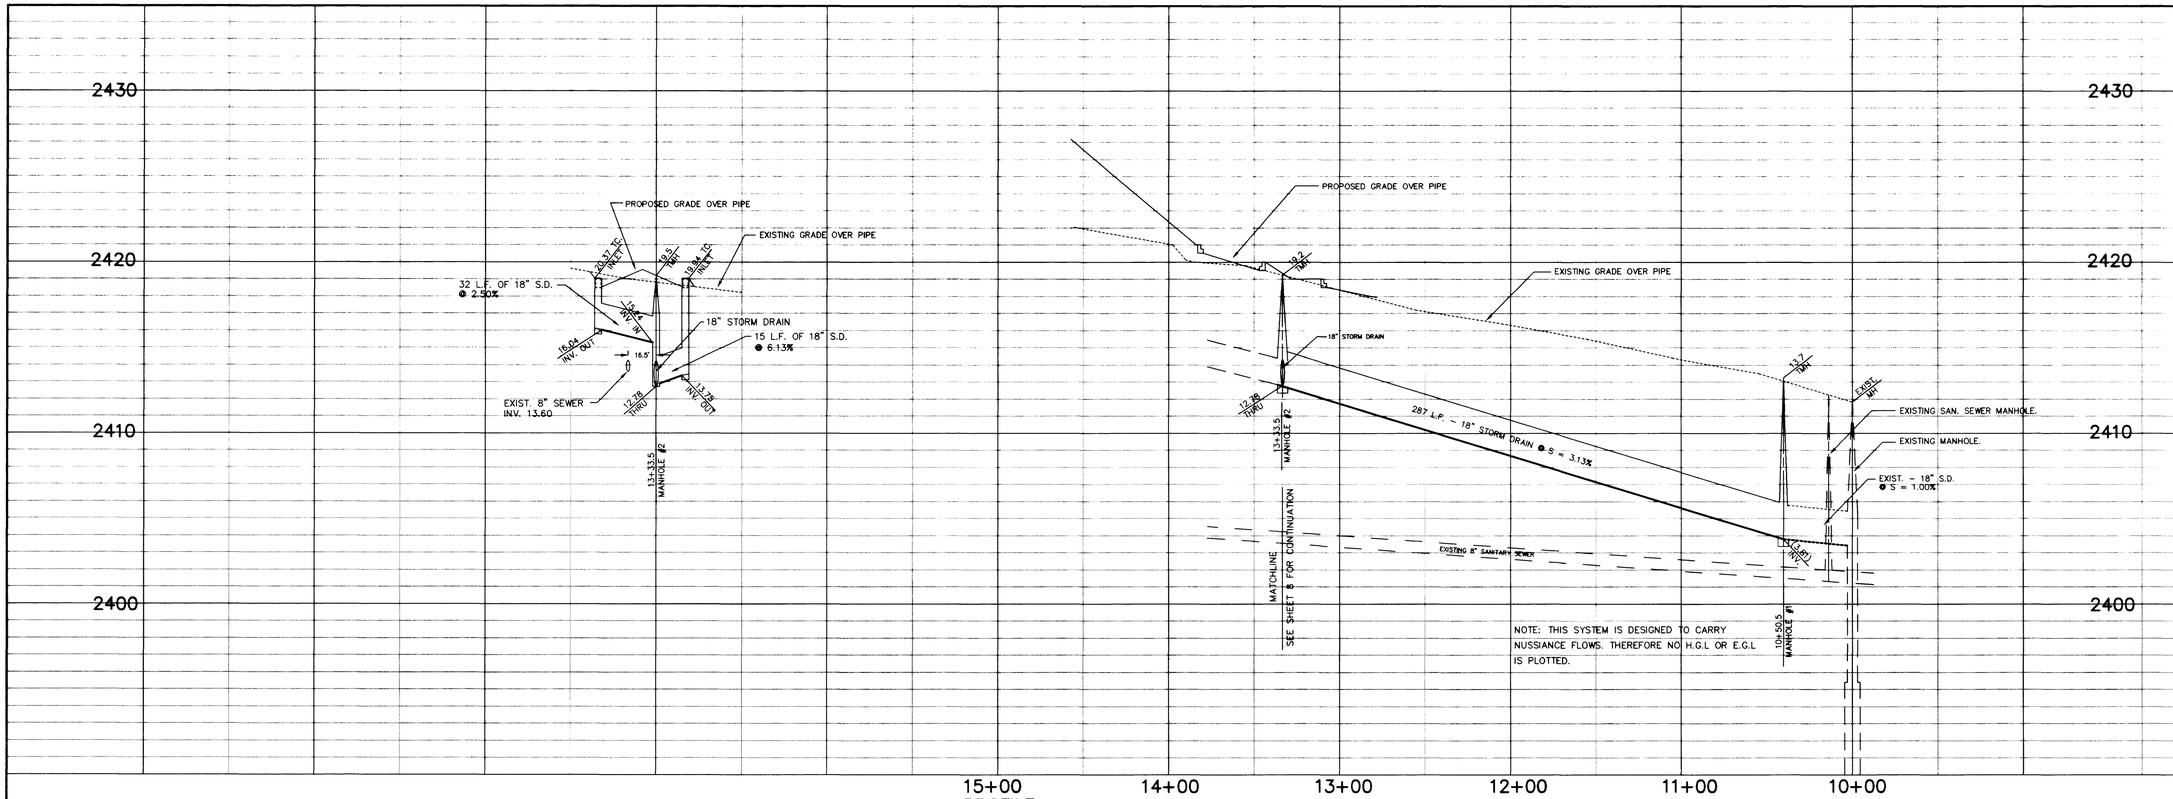

15+00 PROFILE

SCALES, 1" = 40' HORIZONTAL
1" = 4' VERTICAL

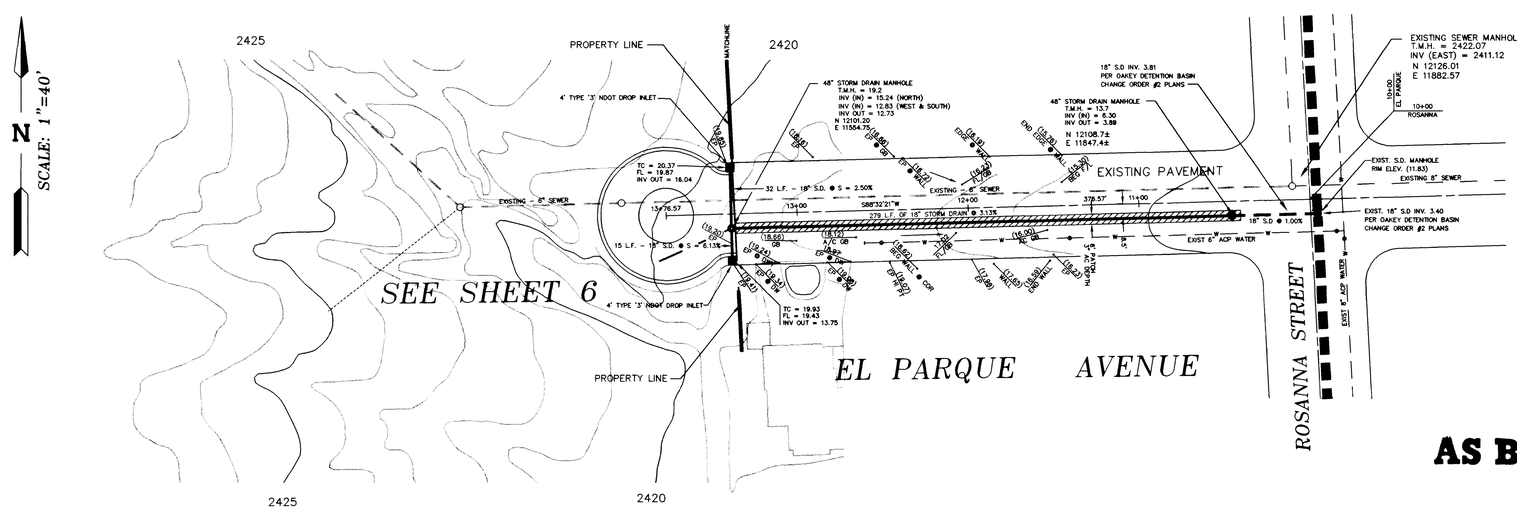

18" STORM DRAIN

REVISION	DATE	BY	APPROVED	
1	9-26-96	DF		REVISE CUL-DE-SAC GRADES, ADD EX. WATER AND EX. GRADES

SUBMITTED BY:

ALPHA & ENGINEERING COMPANY
Yamboy Plaza, Suite 204, Las Vegas, NV. 89107
50 So. Jones

TITLE: 18" STORM DRAIN PLAN & PROFILE

PROJECT: RAINBOW PARK

NOTICE!

EXISTING UTILITIES ARE SHOWN ON PLANS FOR THE CONVENIENCE OF THE CONTRACTOR ONLY. THE CONTRACTOR IS RESPONSIBLE FOR THE PROTECTION OF ALL UTILITIES. THE ENGINEER BEARS NO RESPONSIBILITY FOR UTILITIES NOT SHOWN OR SHOWN INCORRECTLY.

AVOID CUTTING UNDERGROUND UTILITIES. IT'S COSTLY.

Call BEFORE YOU Dig
1-800-227-2600
UNDERGROUND SERVICE (USA)

JOB #	601211
NAME	CRAWFORD/RF
DATE	8-22-96
SCALE	1" = 40'

PAGE 7 OF 10

650.30-6

601211S7.DWG

E:\601211\601211s7 Mon Sep 30 11:29:46 1996

2837

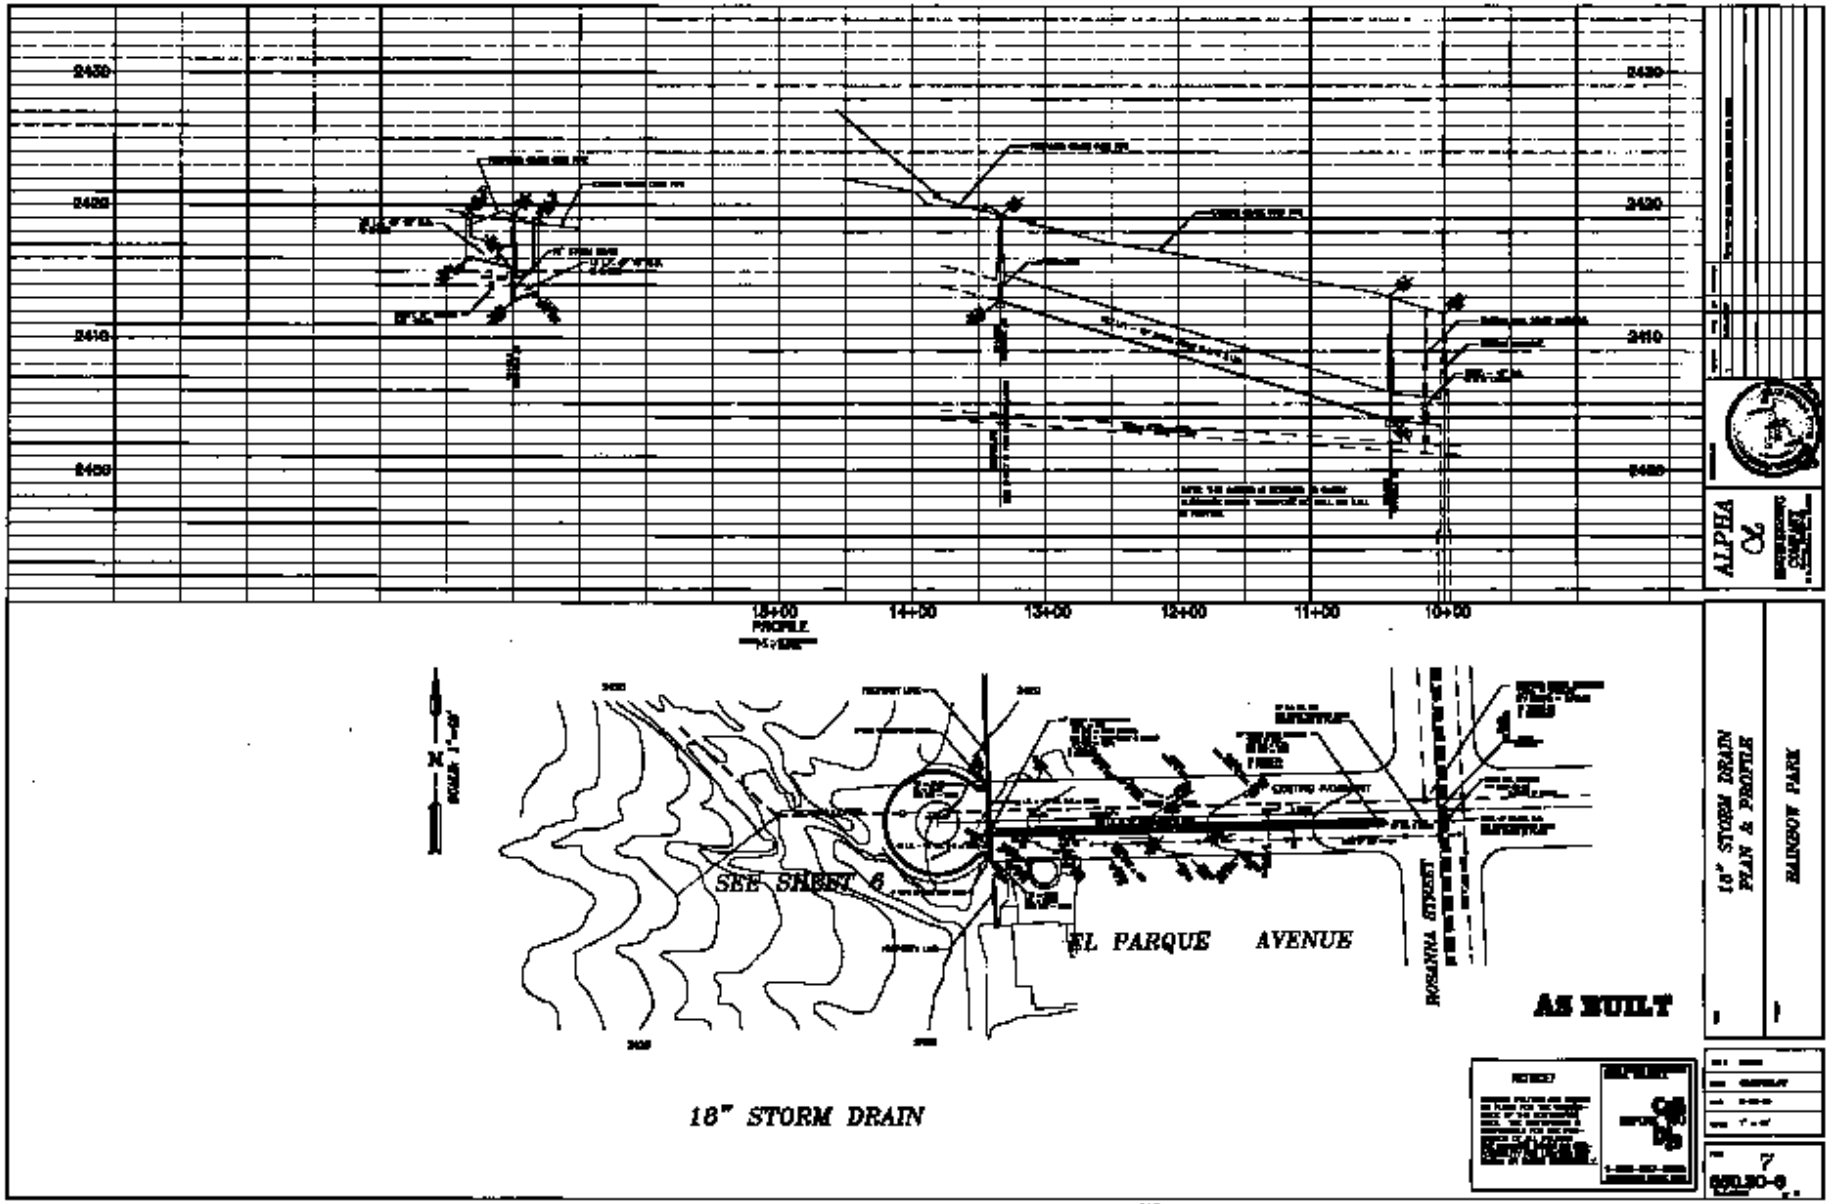
2430
2420
2410
2400
15+00
PROFILE
14+00
13+00
12+00
11+00
10+00
N
SCALE 1"=40'
SEE SHEET 6
EL PARQUE AVENUE
ROSANTA STREET
AS BUILT
18" STORM DRAIN
18" STORM DRAIN
PLAN & PROFILE
RAINBOW PARK
ALPHA
7