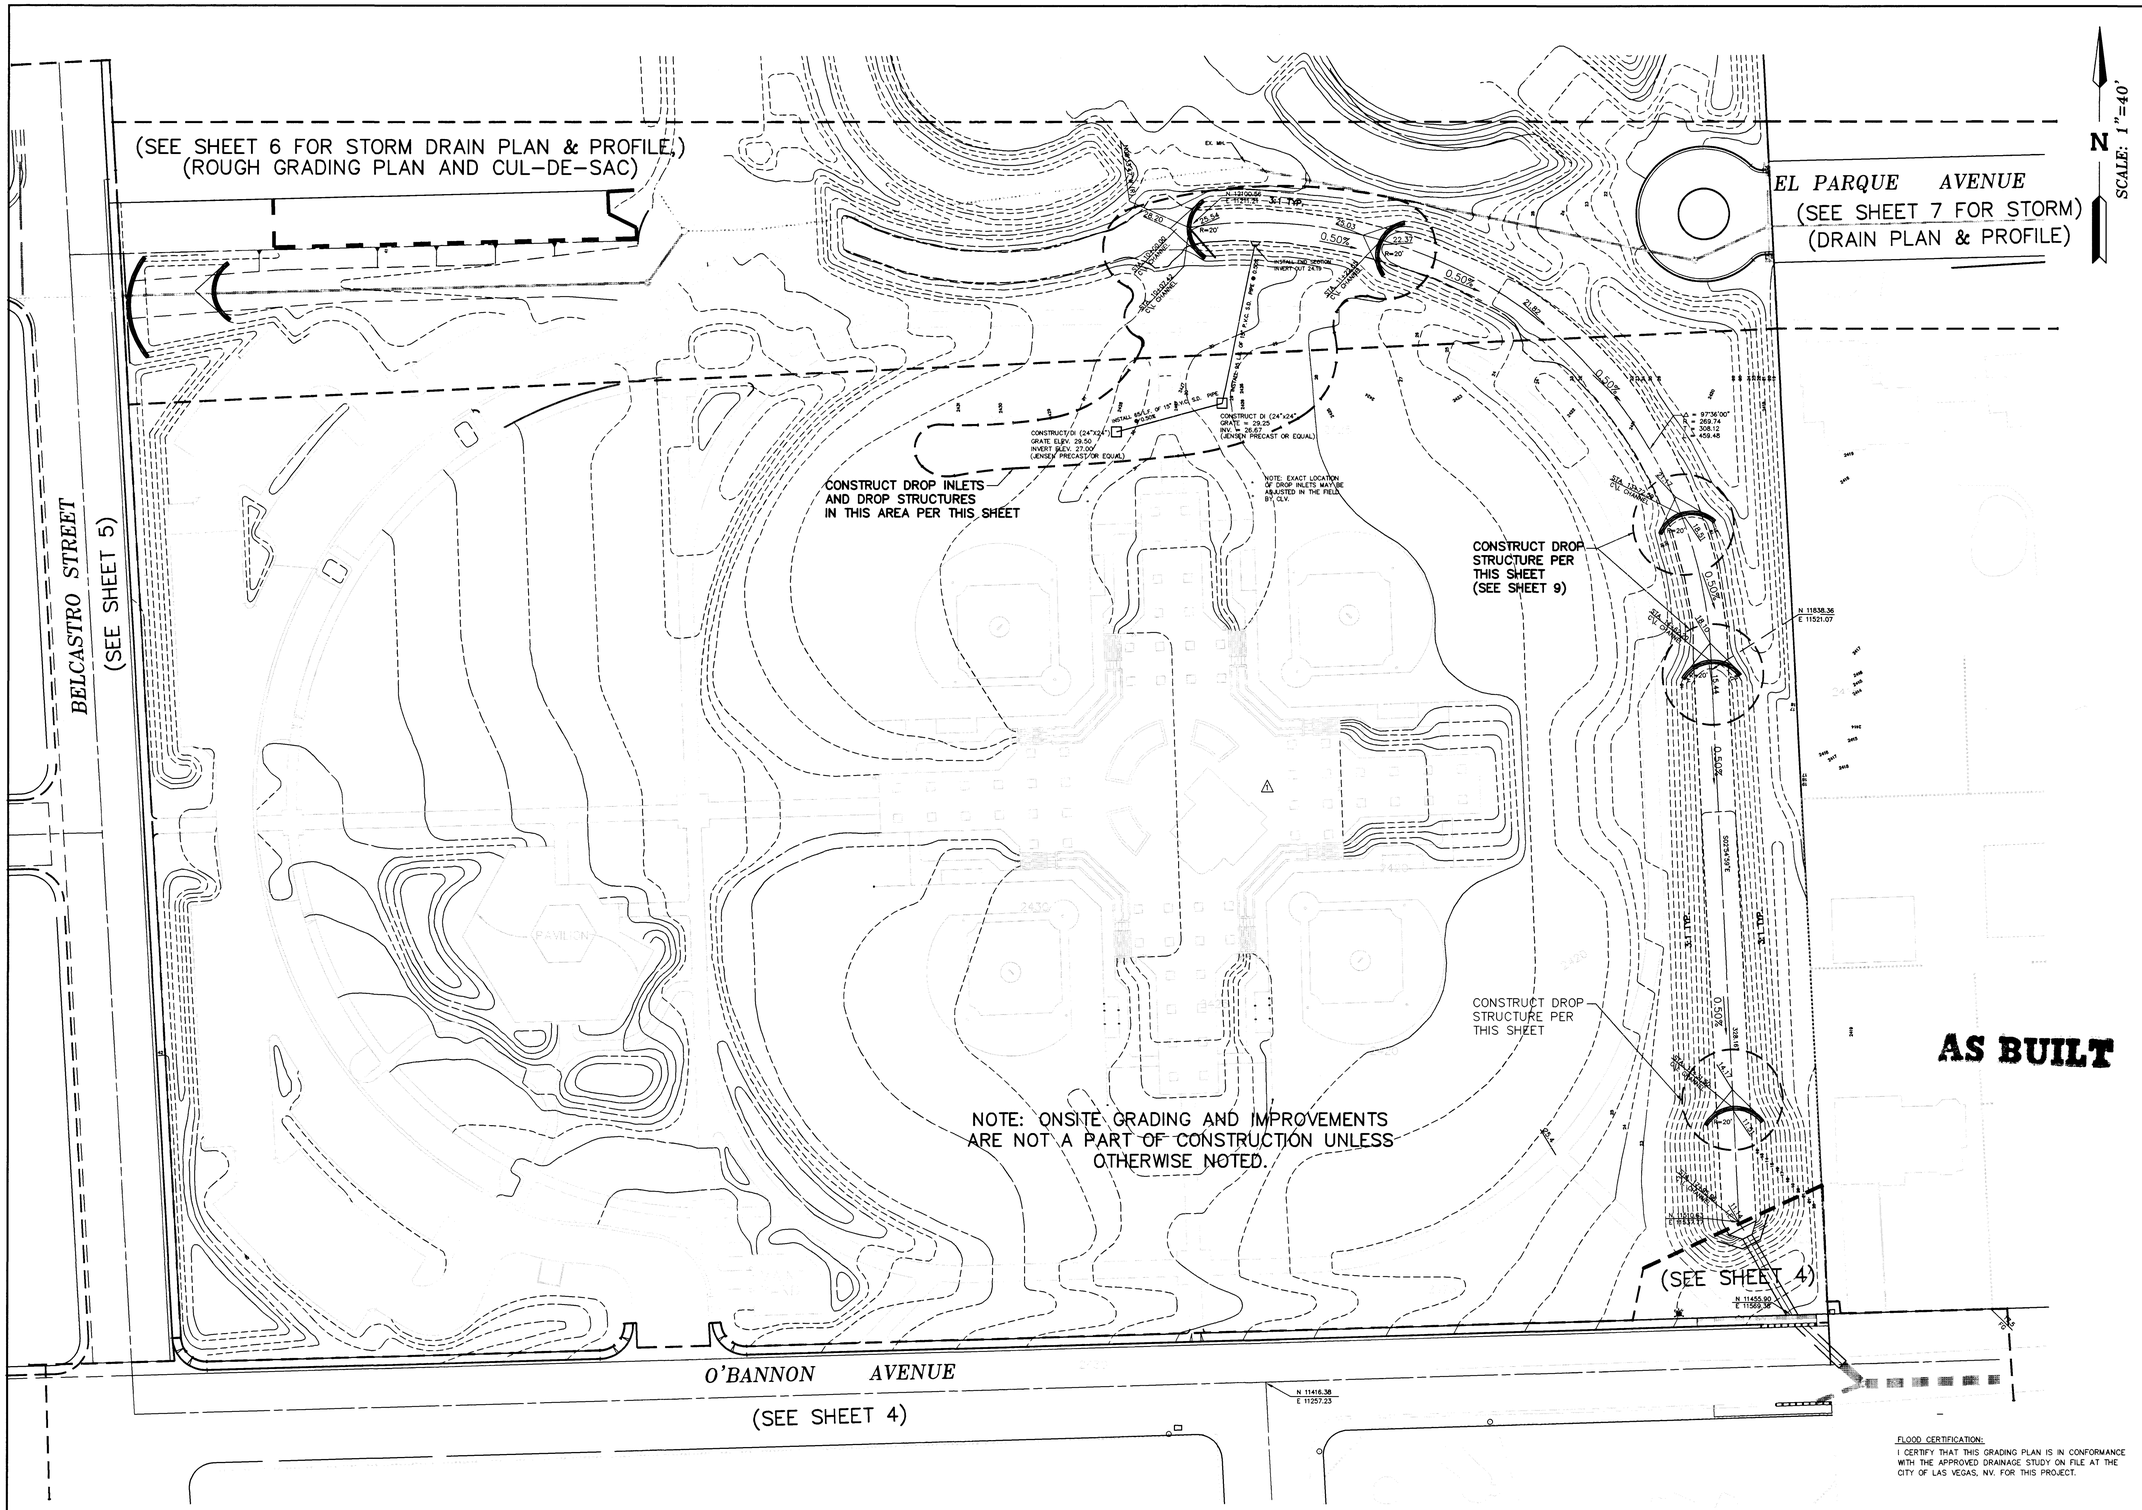

FLOOD CERTIFICATION:
I CERTIFY THAT THIS GRADING PLAN IS IN CONFORMANCE WITH THE APPROVED DRAINAGE STUDY ON FILE AT THE CITY OF LAS VEGAS, NV. FOR THIS PROJECT.

REVISION	DATE	BY	APPROVED

SUBMITTED BY:

ALPHA & ENGINEERING COMPANY
50 So. Jones #204, Las Vegas, NV. 89107
Telephone: (702) 877-1300

TITLE: REFFERNCE MAP AND ONSITE DRAINAGE IMPROVEMENTS

PROJECT: RAINBOW PARK

JOB #	6012-11
NAME	CRAWFORD/MRA/RF
DATE	8/26/96
SCALE	1"=40'

PAGE 3 OF 10

650.30-6

601211S3.DWG

2843

c:\IN_OUT\rick\601211\601211s3 Thu Aug 29 11:35:18 1996 DENEY
HP Designjet 600 TCUSTOU.hpc Hewlett-Packard HP-GL/2 devices, ADI 4.2 - for Autodesk by HP

(SEE SHEET 6 FOR STORM DRAIN PLAN & PROFILE)
(ROUGH GRADING PLAN AND CUL-DE-SAC)

EL PARQUE AVENUE
(SEE SHEET 7 FOR STORM)
(DRAIN PLAN & PROFILE)

(SEE SHEET 5)

NOTE: ONSITE GRADING AND IMPROVEMENTS ARE NOT A PART OF CONSTRUCTION UNLESS OTHERWISE NOTED.

AS BUILT

O'BANNON AVENUE
(SEE SHEET 4)

ALPHA & ENGINEERING COMPANY

REFERENCE MAP AND GRADING IMPROVEMENTS

RAINBOW PARK

3
650.30-B