




NOTE:
PROVIDE 1/8" x 1" DEEP CONTROL JOINTS AT 8' OC MAX. JOINTS TO CONTINUE THROUGH CONC. OR CURB & GUTTER. PROVIDE 1/2" EXPANSION JOINTS AT 30' OC.

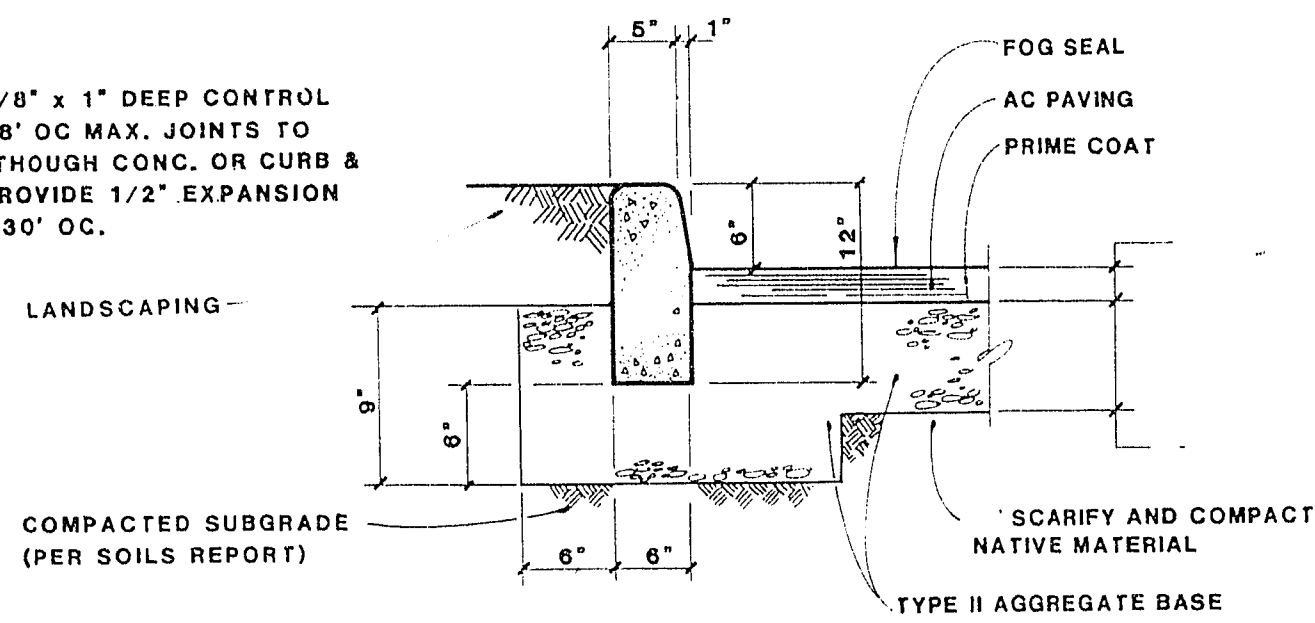


ON-SITE CURB DETAIL
NO SCALE

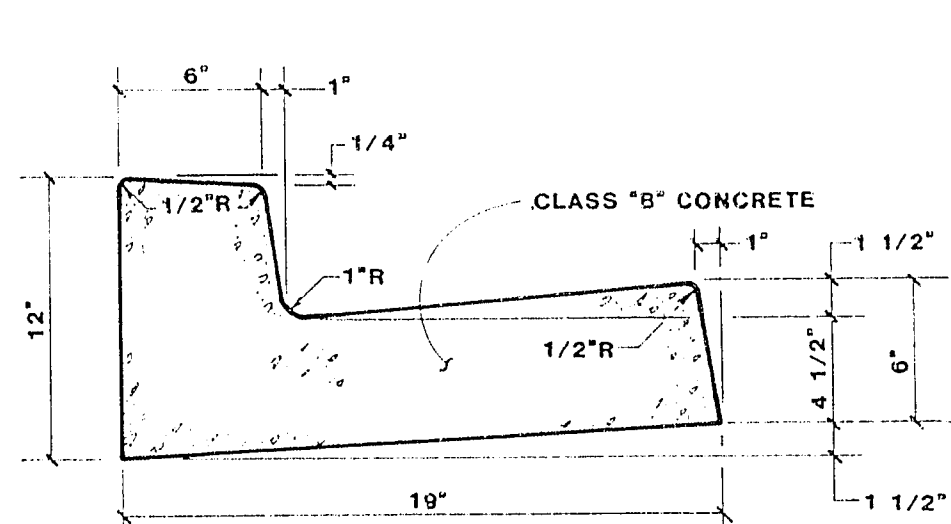


ON-SITE "L" TYPE CURB AND GUTTER
NO SCALE

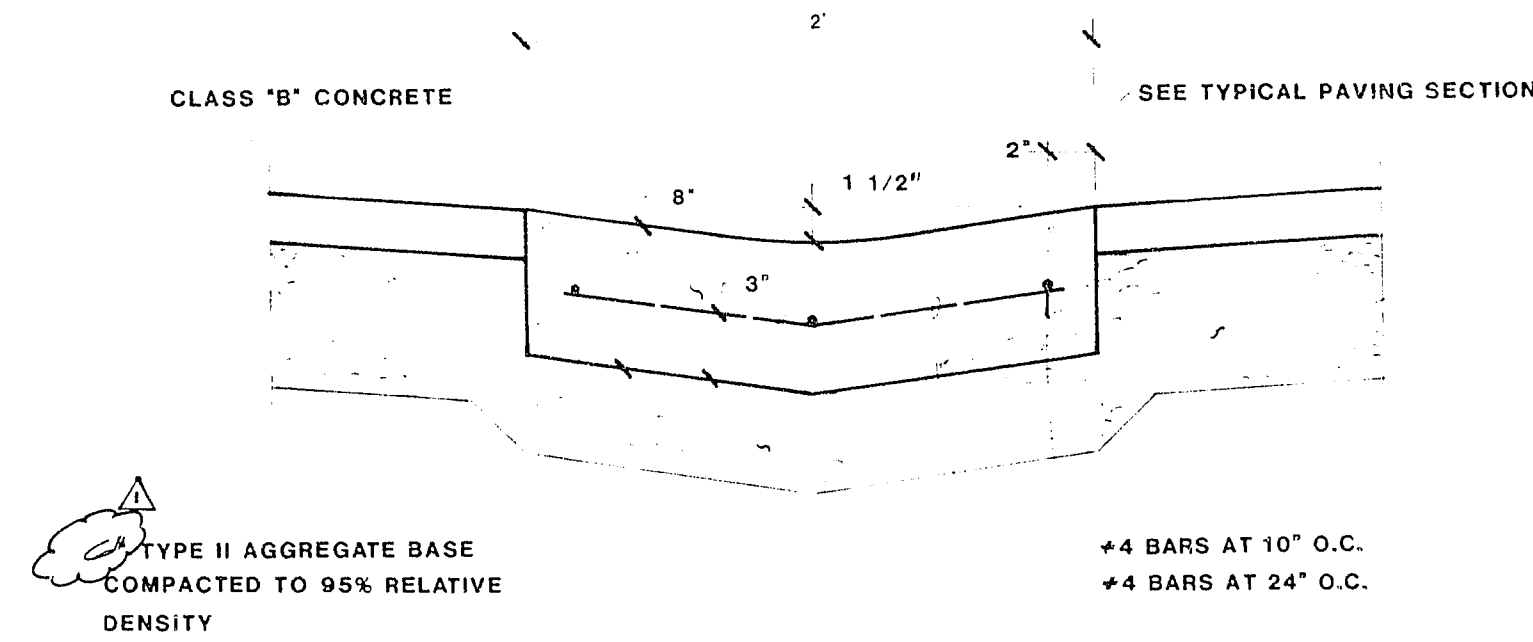


2' VALLEY GUTTER DETAIL
NO SCALE

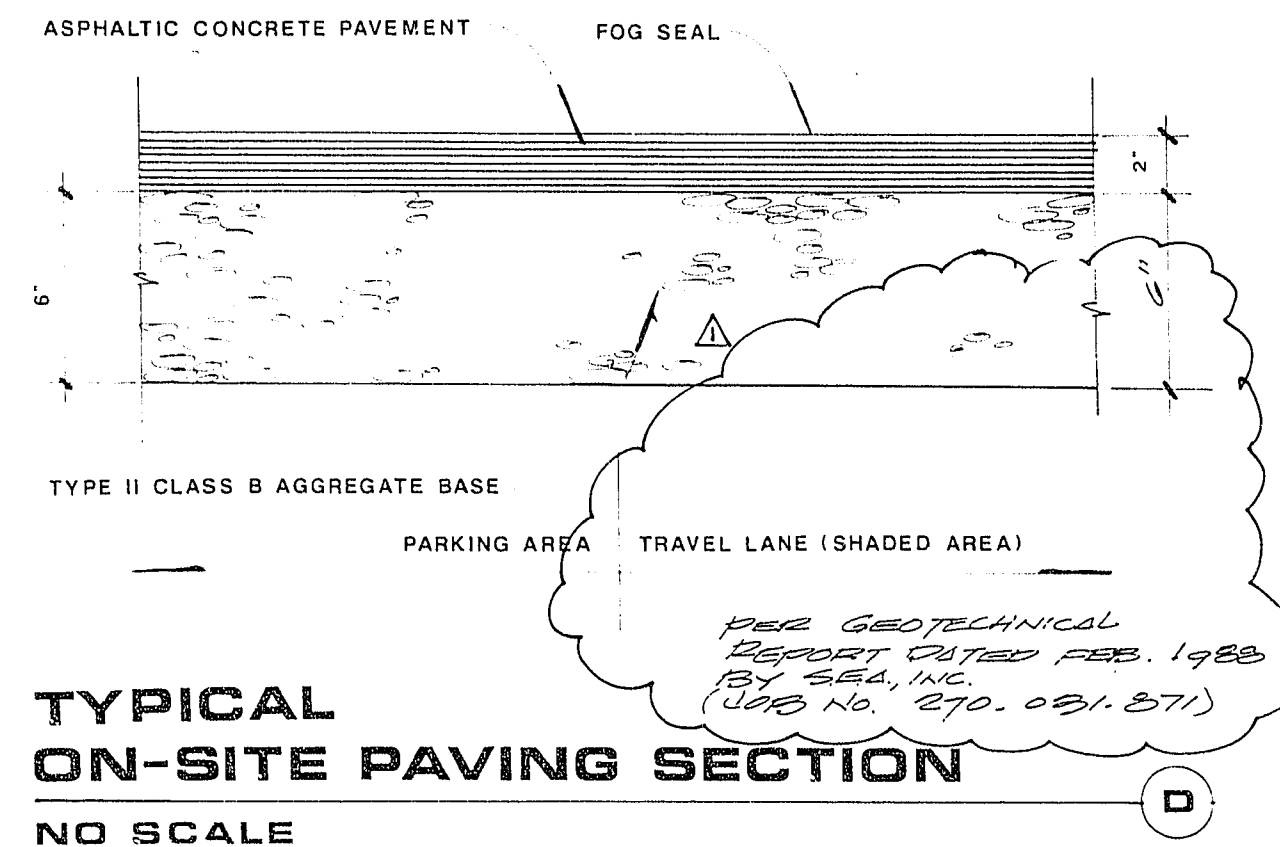

TYPICAL ON-SITE PAVING SECTION
NO SCALE

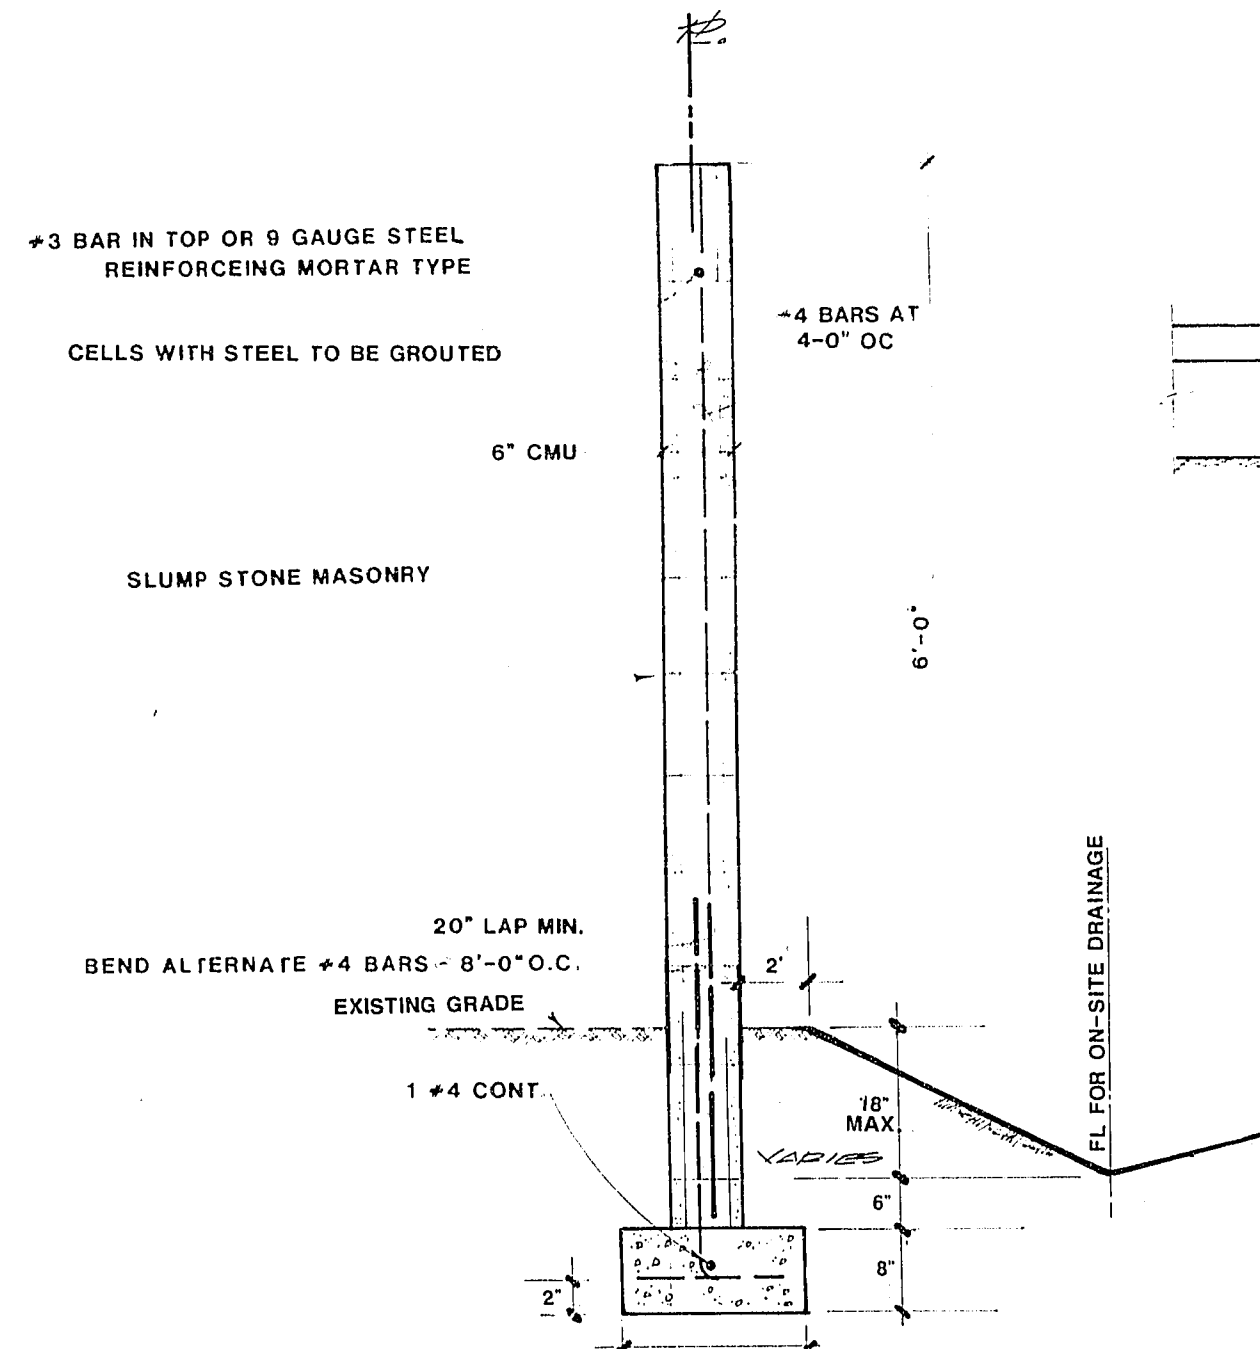


SCREEN WALL
NO SCALE

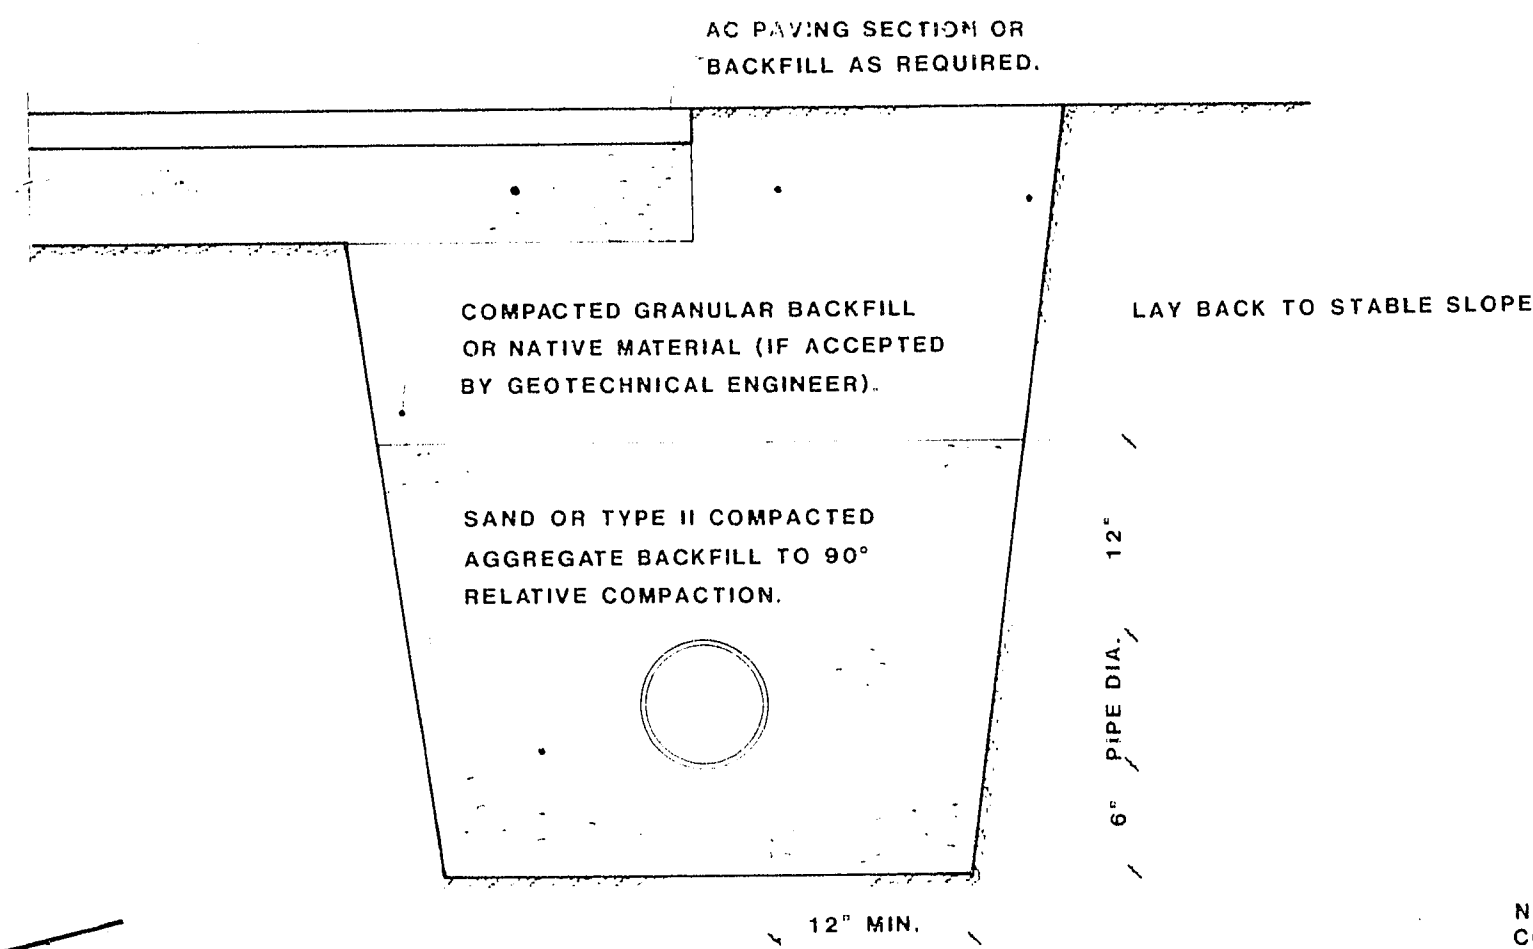


NOTE:
COMPACT GRANULAR BACKFILL TO 95% RELATIVE COMPACTION IN PAVED AREAS, 90% IN LANDSCAPED AREAS.

ON-SITE TRENCH DETAIL
NO SCALE

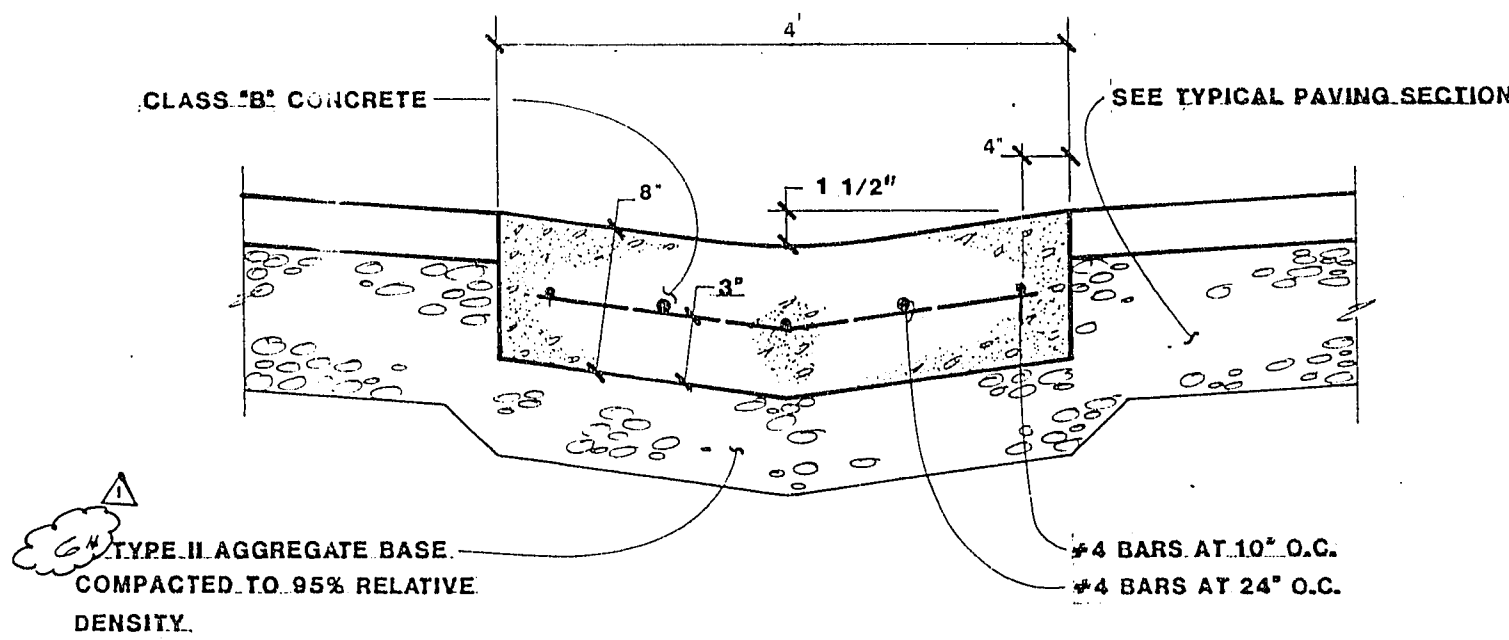


4' VALLEY GUTTER DETAIL
NO SCALE

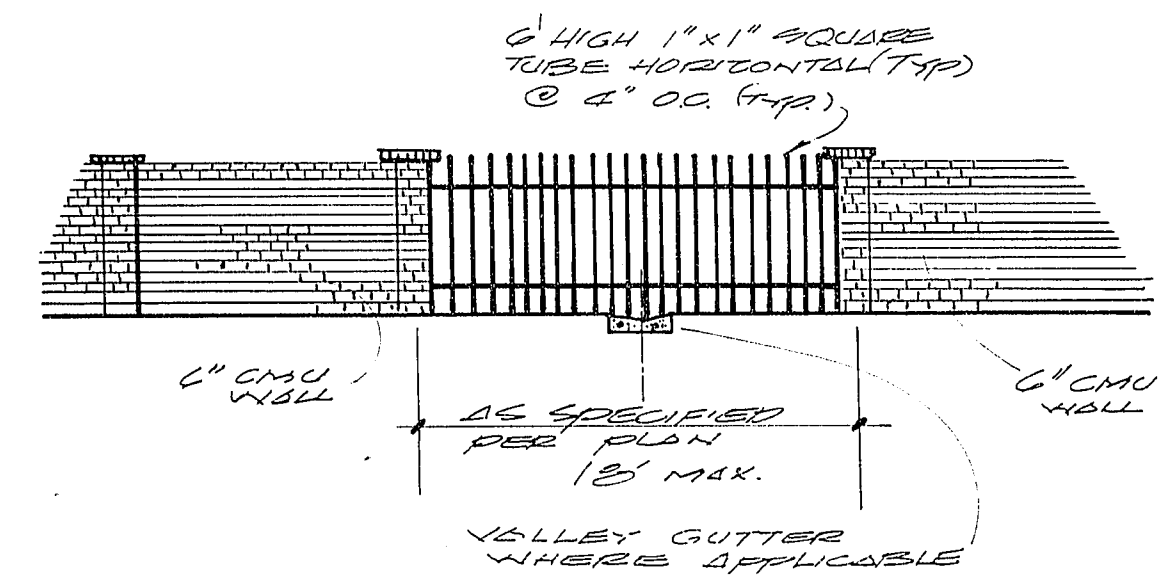


ST. LT. LOCATION

NOTE: PROVIDE 1 1/2" DEEP X 1/4" TOOLED CONTROL JOINTS AT 5' O.C. IN ADDITION, AT 25' O.C. PROVIDE 1/2" THICK PREMOLED EXPANSION JOINT. REINFORCING IS NOT CONTINUOUS ACROSS EXPANSION JOINTS.

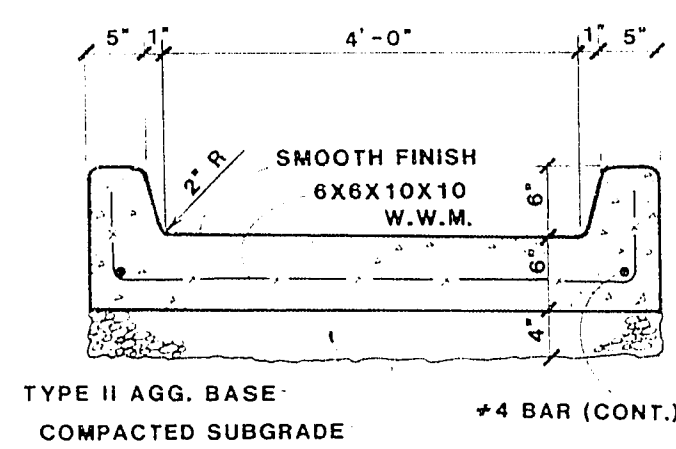


CONCRETE SWALE DETAIL
TYPICAL ALL PARKING AREAS

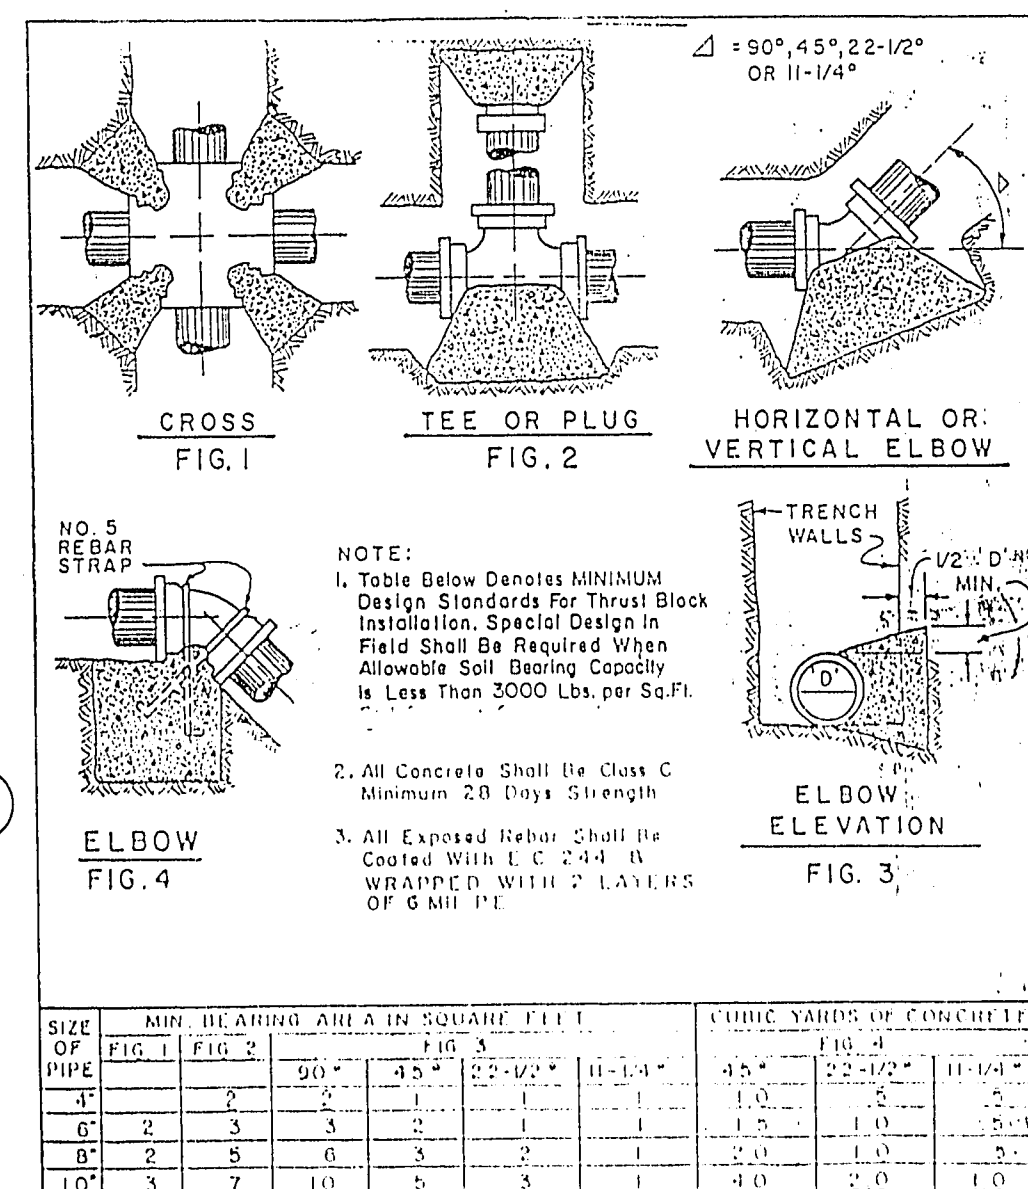


TYPICAL THRUST BLOCK DETAIL
NO SCALE


NOTE:
PROVIDE 1/8" x 1" DEEP CONTROL JOINTS AT 8' OC MAX. JOINTS TO CONTINUE THROUGH CONC. OR CURB & GUTTER. PROVIDE 1/2" EXPANSION JOINTS AT 30' OC.

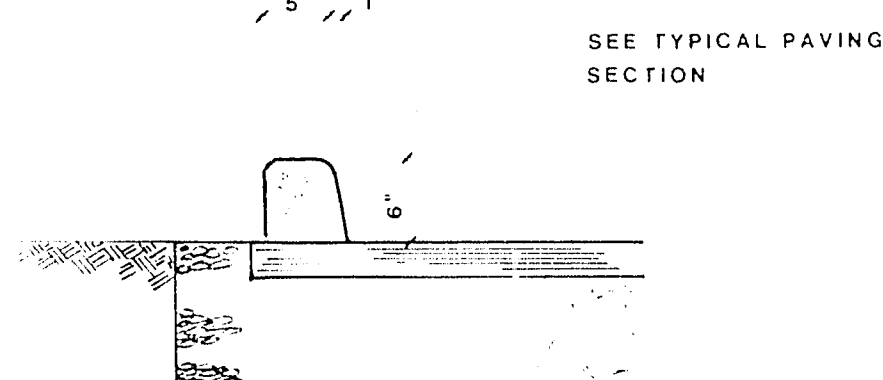

ON-SITE TACK ON CURB
NO SCALE

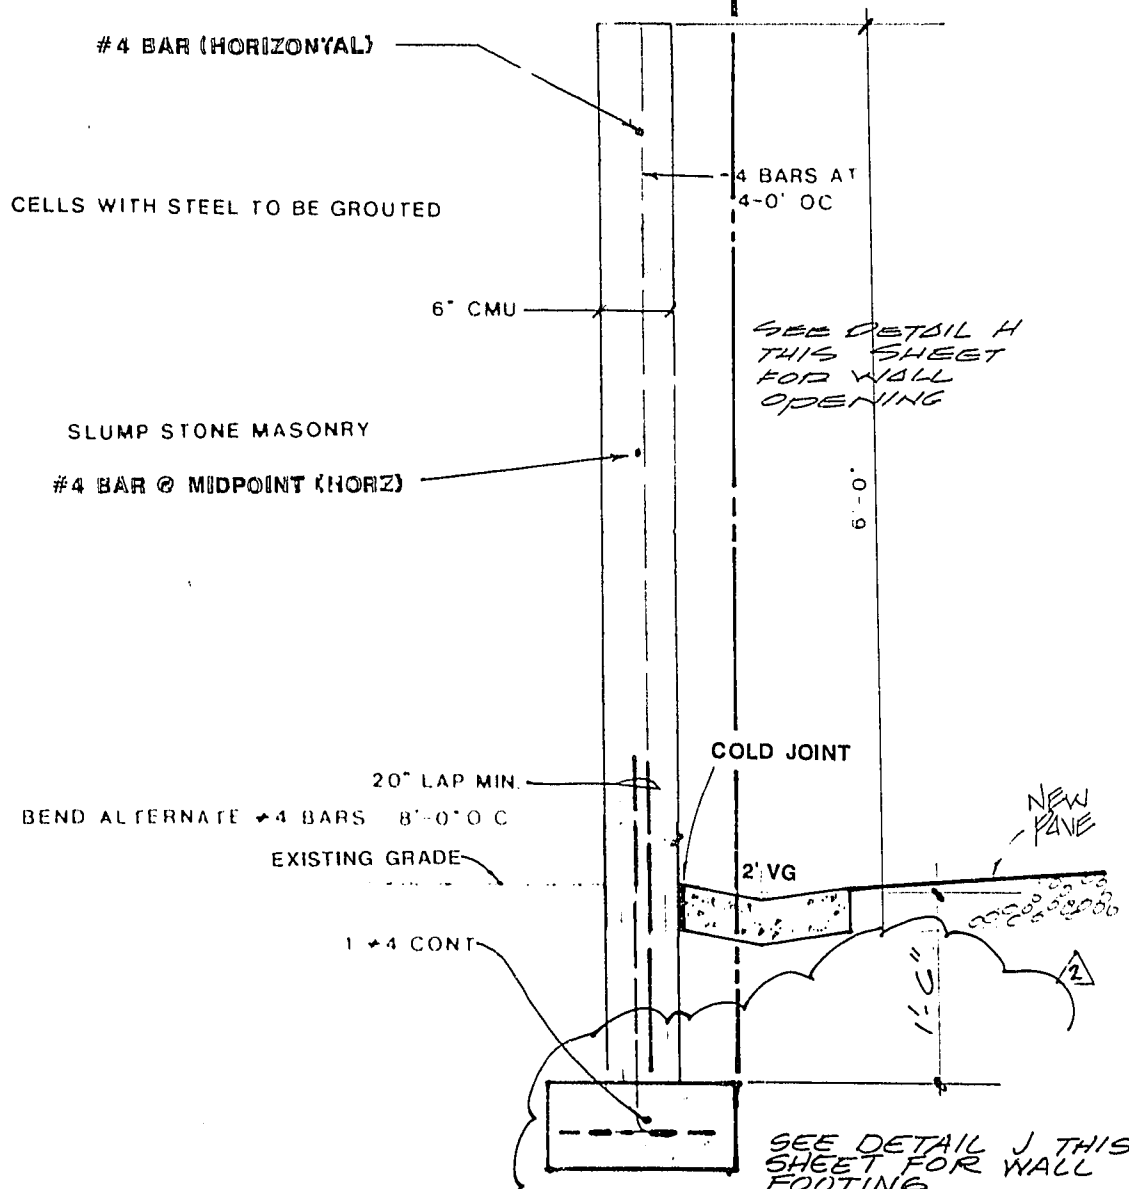

SCREEN WALL
NO SCALE

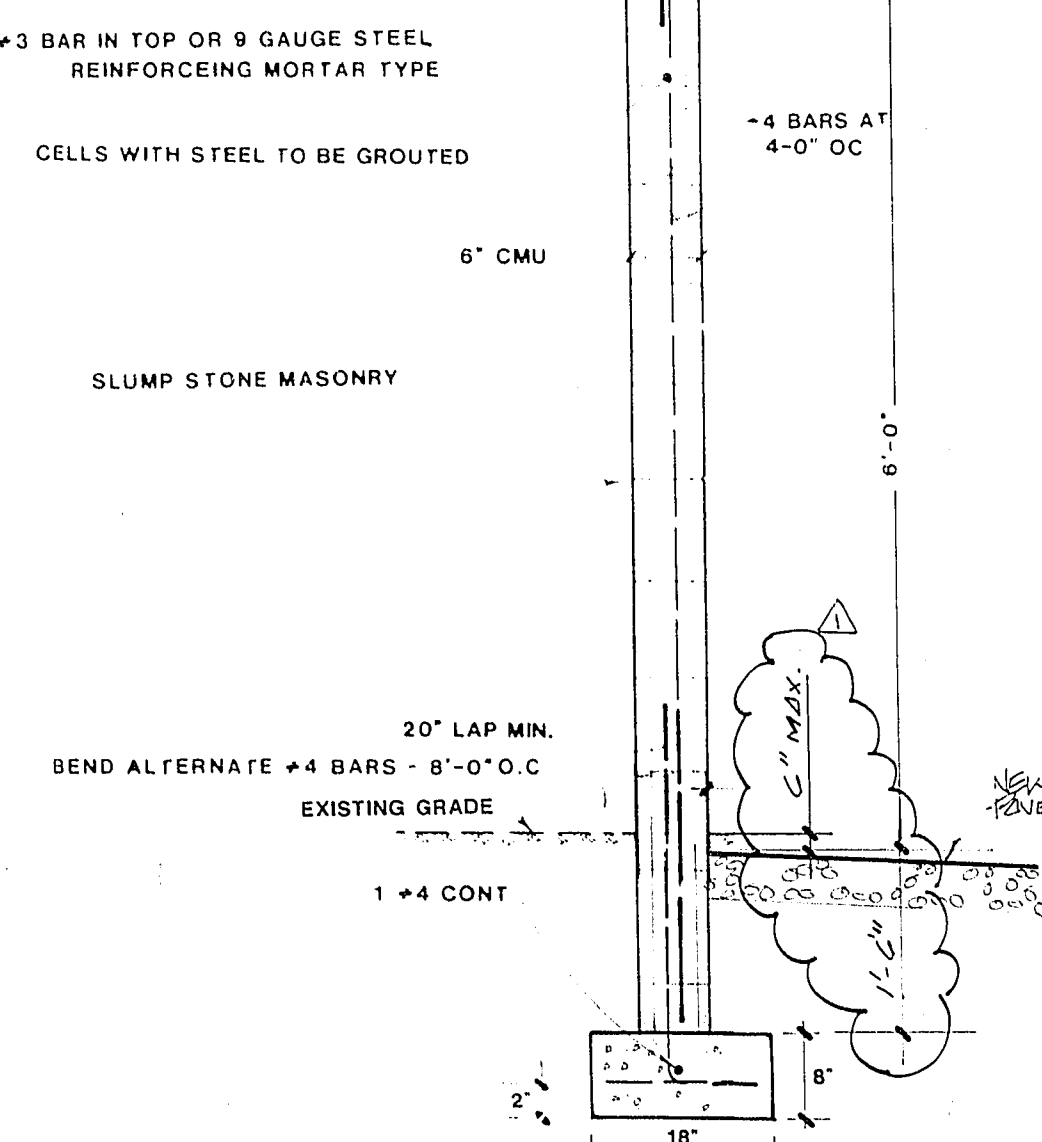

SCREEN WALL
NO SCALE

"A"	"B"
2'-0"	2'-0"
4'-0"	4'-0"
6'-0"	6'-0"
8'-0"	8'-0"
10'-0"	10'-0"

APPROVALS

N/A SEE COVER SHEET
CLV ENGINEER
CLV CHIEF LAND DEVELOPMENT & FLOOD CONTROL
CLV PUBLIC WORKS

DATE
DATE
DATE


DETAIL SHEET RAINBOW RIDGE APARTMENTS-PHASE I

A PORTION OF THE SW 1/2, SE 1/4, OF SECTION 10, T20S, R60S, MDM

CITY OF LAS VEGAS

NEVADA

NO.	DESCRIPTION/DATE	BY
1	REV. DETAIL 1/2/88	SEA
2	REV. DETAIL 1/2/88	SEA
3	REV. DETAIL 1/2/88	SEA

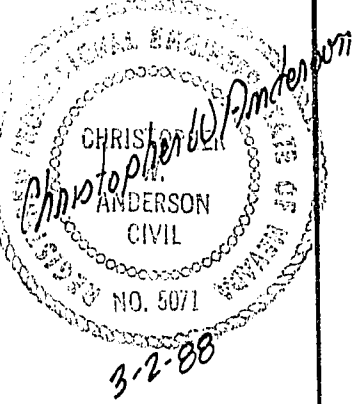

SPARKS, NEVADA
LAS VEGAS, NEVADA
PHOENIX, ARIZONA

incorporated
SEA
ENGINEERS/PLANNERS

JOB NO. 2-270-031-871
DESIGNED CWA
DRAWN JB
COMP.
CHECKED
DATE FEBRUARY 1988

8

8 OF 8 SHEETS

107Y-2544-1