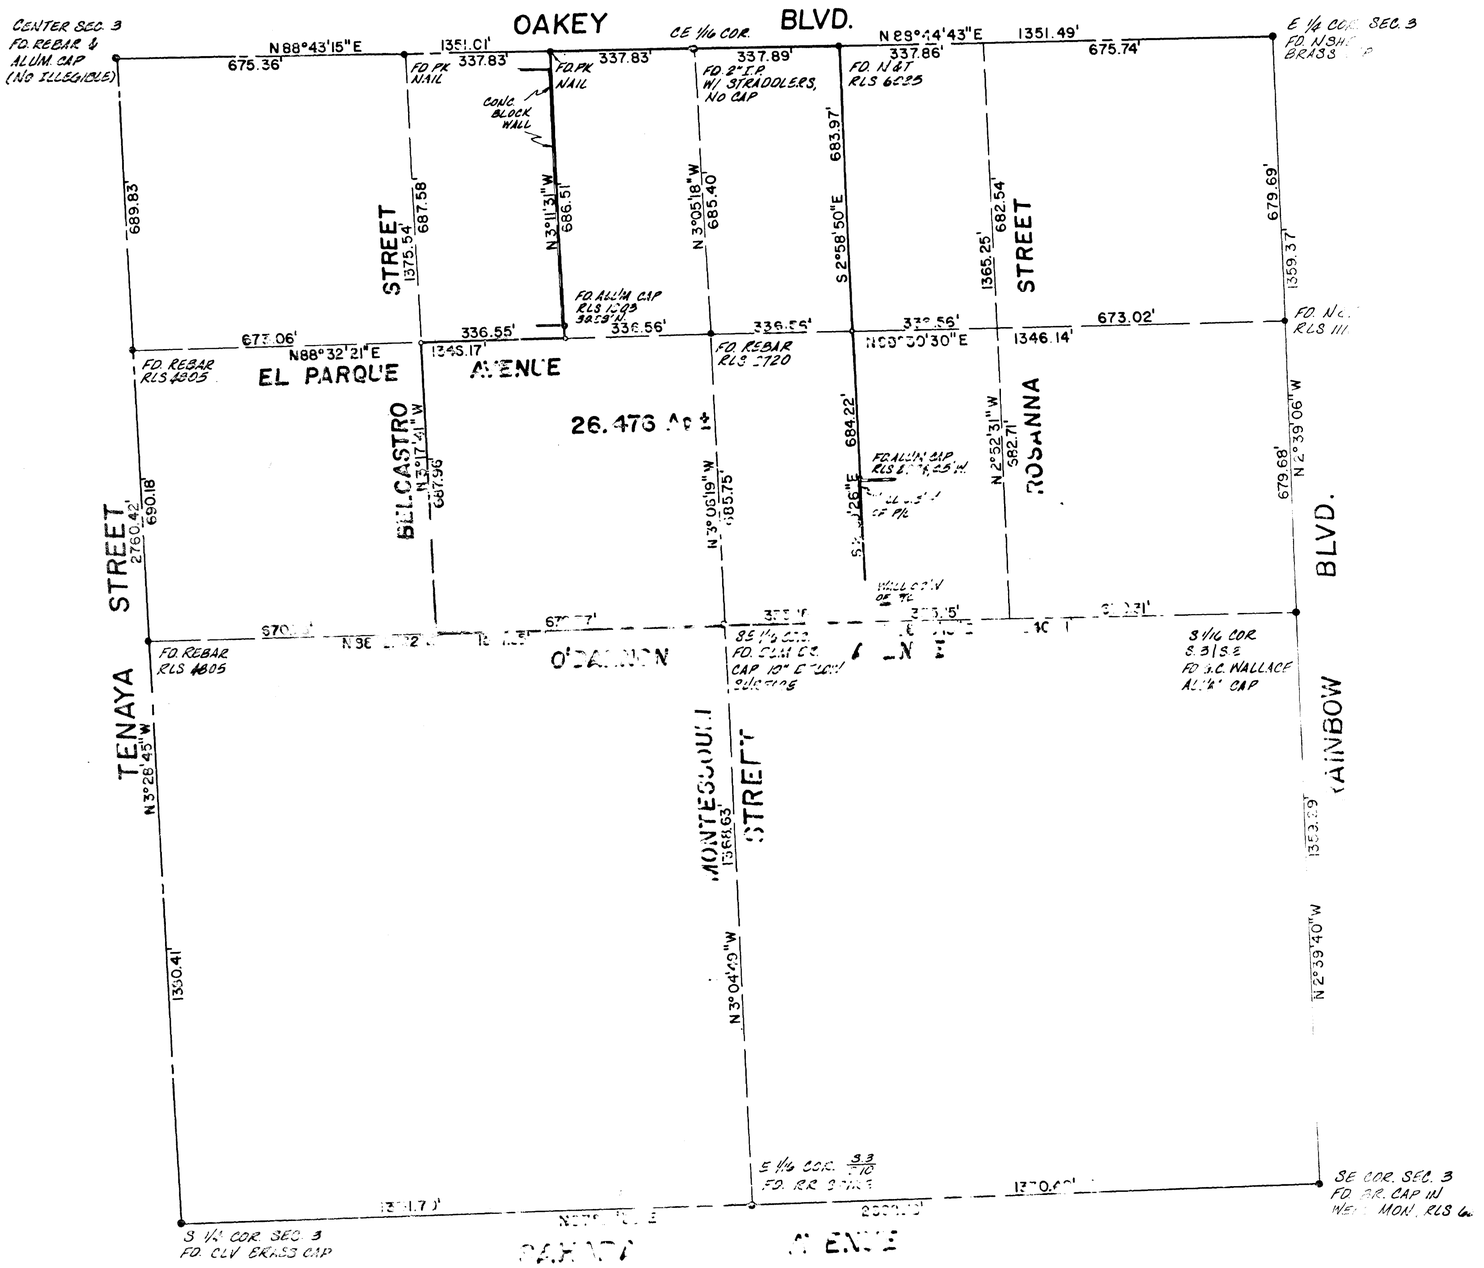

SCALE: 1" = 200'

BASIS OF BEARINGS

The South line of the Southeast Quarter (SE 1/4) of Section 3, Township 21 South, Range 60 East, M.D.M., bears North 87°51'38" East per Record of Survey, File 44, Page 9, Clark County, Nevada Records.

REFERENCE SURVEYS

Parcel Maps: File 8, Page 20
File 8, Page 52
File 27, Page 26
File 22, Page 26
File 8, Page 2

Record Of Survey: File 44, Page 9

SURVEYOR'S CERTIFICATE

I, Rita M. Lumos, a Professional Land Surveyor, do hereby certify that this map truly and correctly represents the results of a survey made under my supervision and completed on the 2nd day of April, 1990, for the City of Las Vegas. This survey is not a subdivision as defined in the Nevada revised statutes and complies with the applicable state statutes and local ordinances.

Rita M. Lumos
P.L.S. No. 5094

PROFESSIONAL LAND SURVEYOR — STATE OF NEVADA
RITA M. LUMOS
No. 5094

4/23/90

RECORD OF SURVEY

RAINBOW PARK

SE 1/4 SEC. 3, T. 21 S., R. 60 E., M.D.M.
CITY OF LAS VEGAS, NEVADA

4/10/90
RML
WQ2489

No. 00580
filed at the request of
CITY OF LAS VEGAS
Date 4/24/90 at 10:08 a.m.
File 54 Page 67
of Surveys
Official Records Book No. 900424
Clark County, Nevada Records
Joan L. Swift, Recorder
Fee $10.00 Deputy BLF

14-71

352

055-617