



SECTION

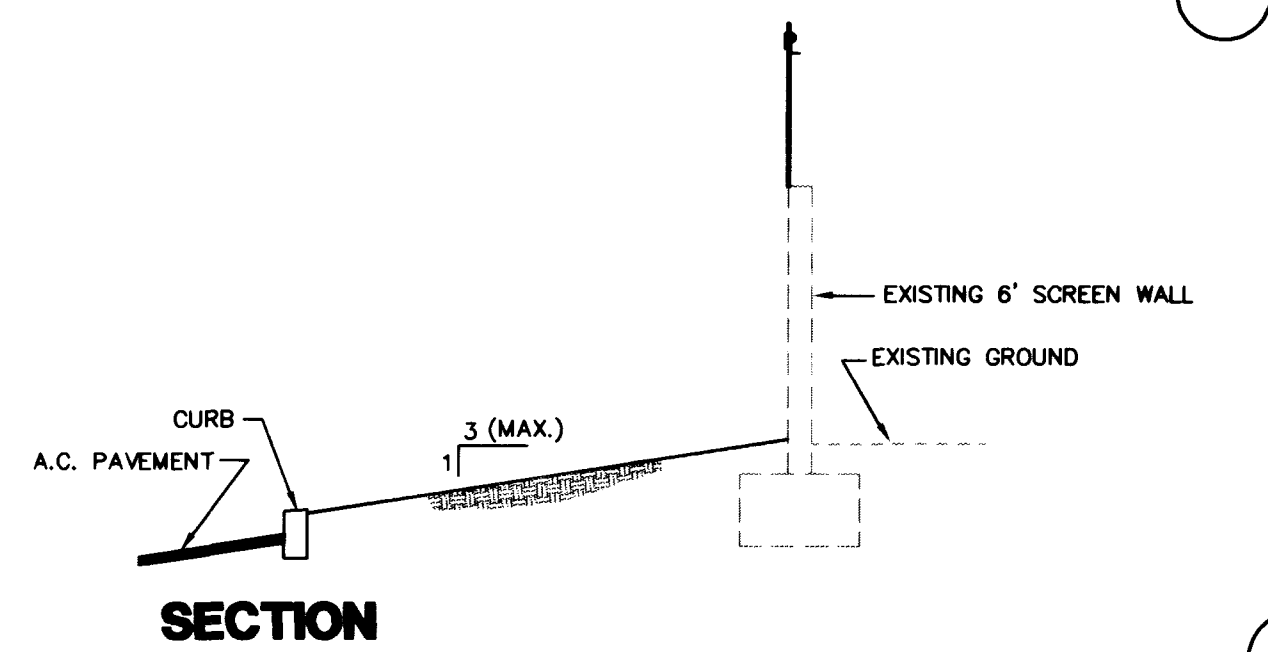

SECTION

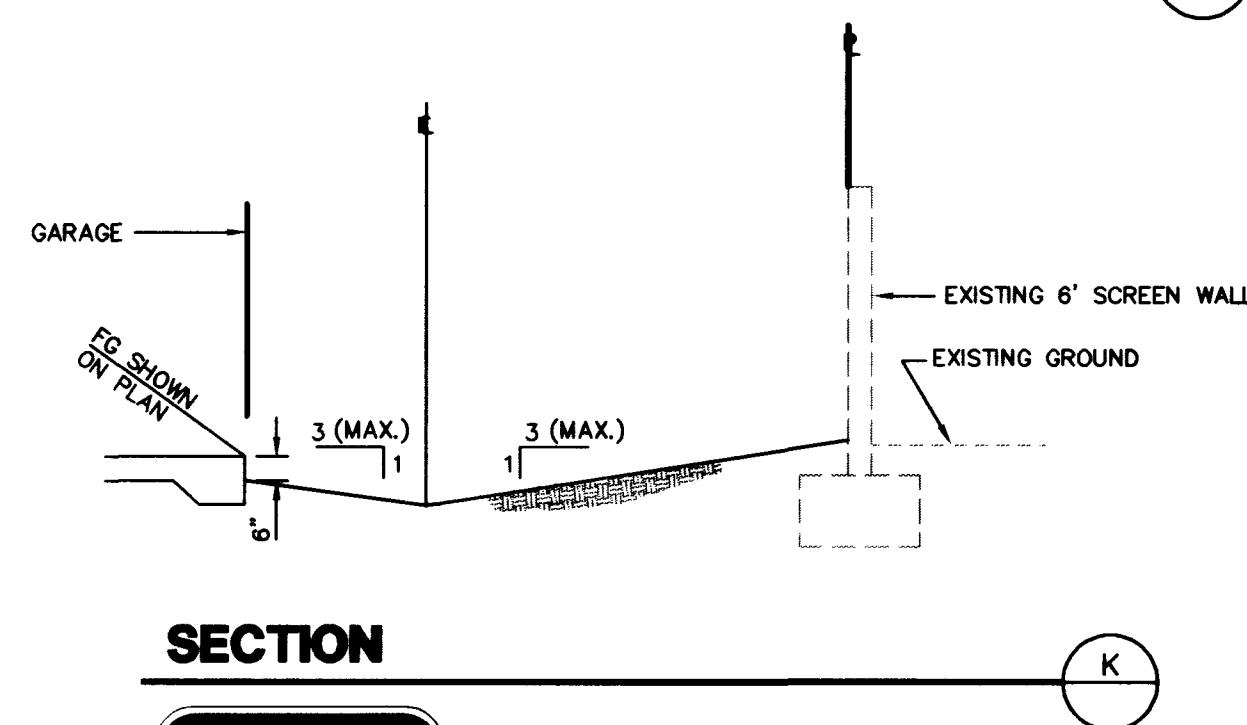

MINIMUM SPECIFICATIONS OF "NO PARKING FIRE LANE SIGNS"


SIZE: 1' WIDE x 1 1/2' LONG AS REQUIRED

COLOR: RED AND BLACK ON WHITE LUMINOUS BACKGROUND (SEE ABOVE EXAMPLE)

SYMBOL: INTERNATIONAL NO PARKING SYMBOL


HEIGHT: TO BE INSTALLED NOT LESS THAN SEVEN FEET NOR MORE THAN TEN FEET FROM GROUND LEVEL

FIRE LANE SIGN DETAIL

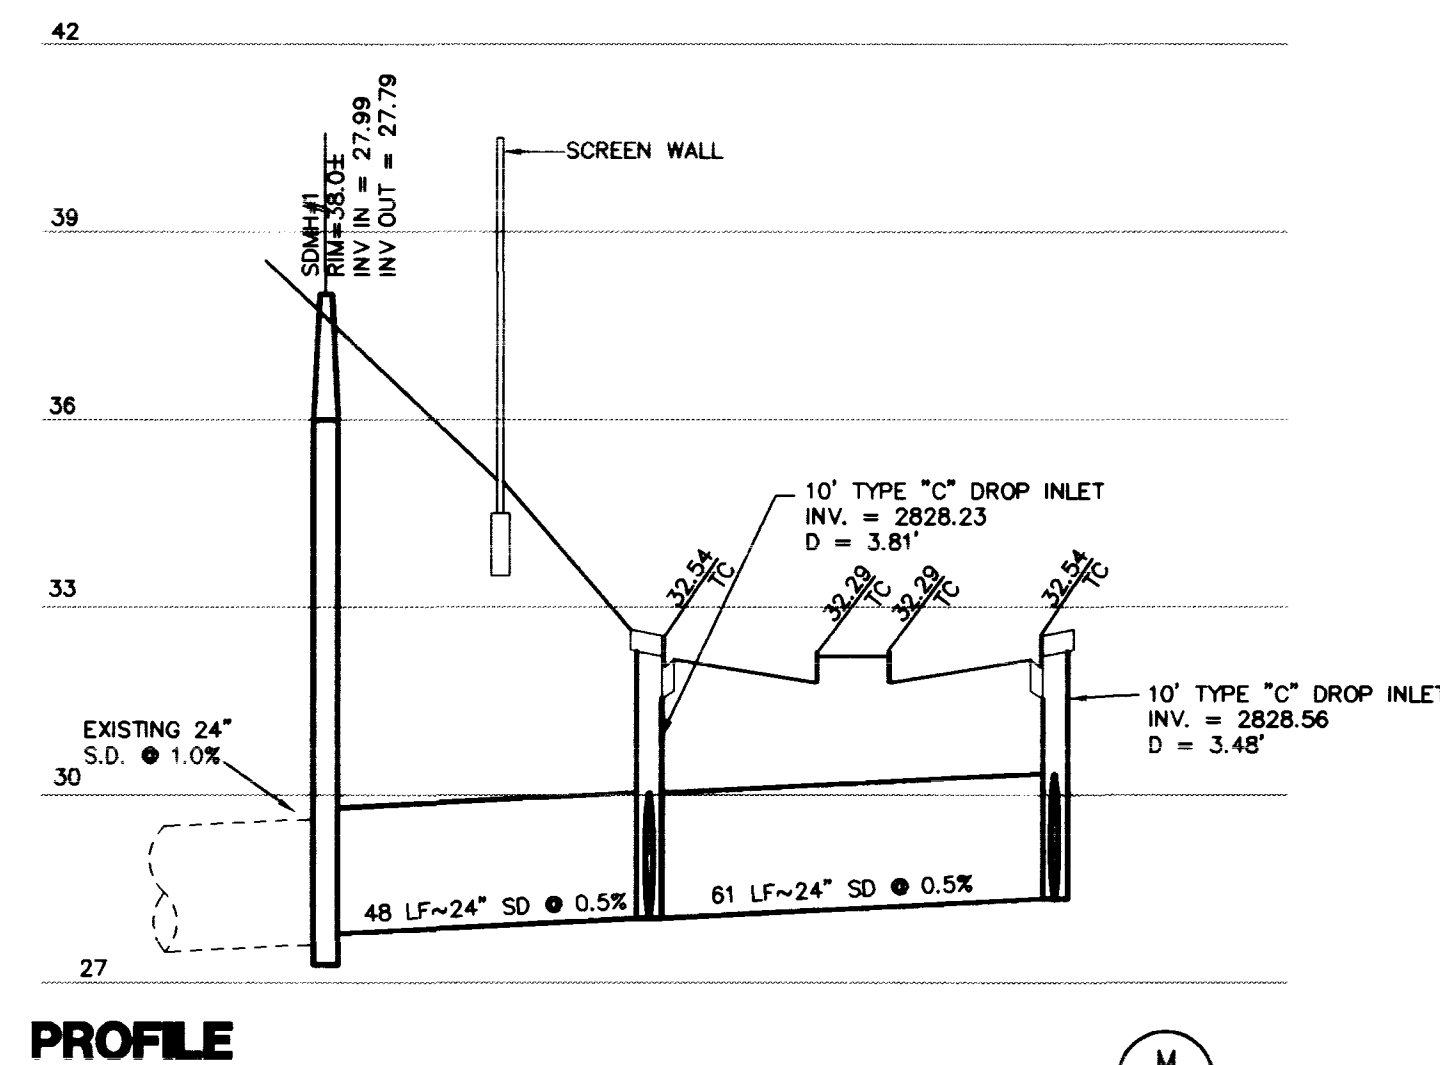


PROFILE


SECTION

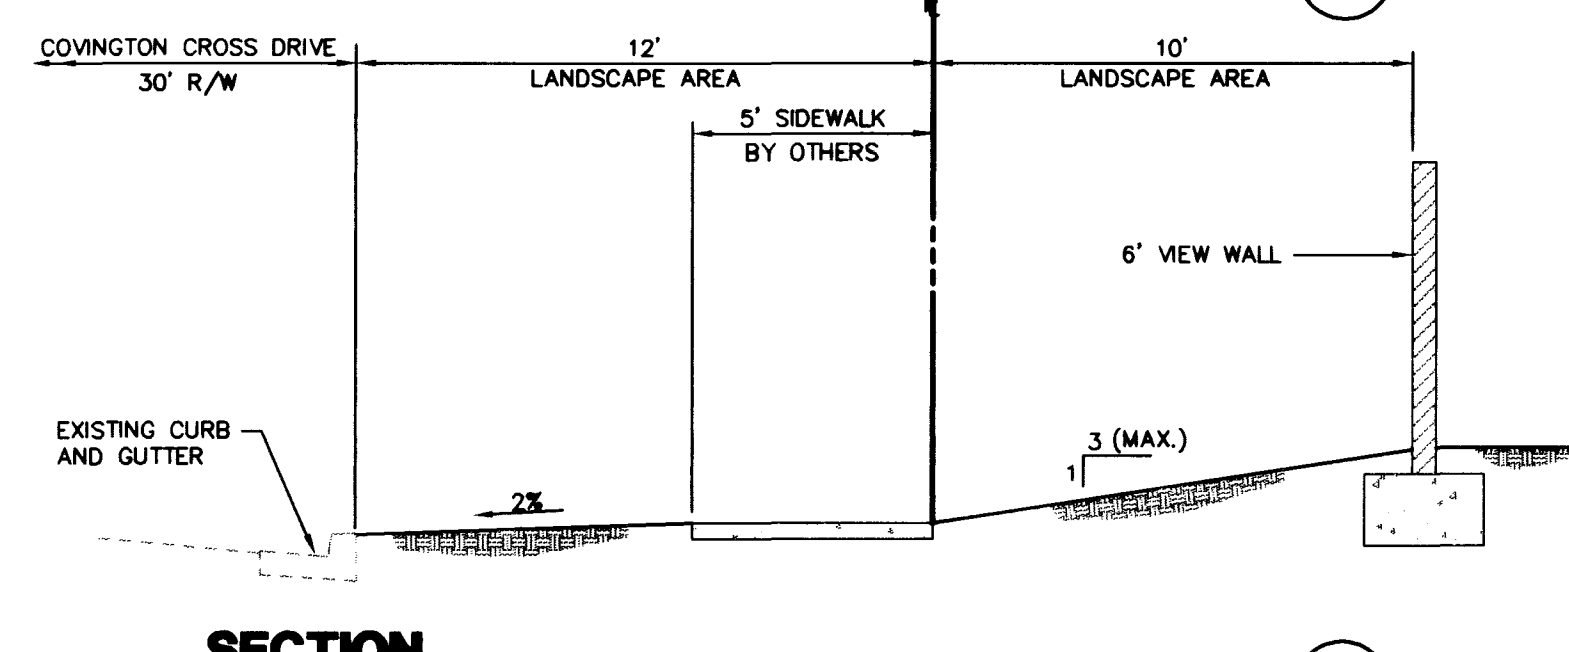


SECTION

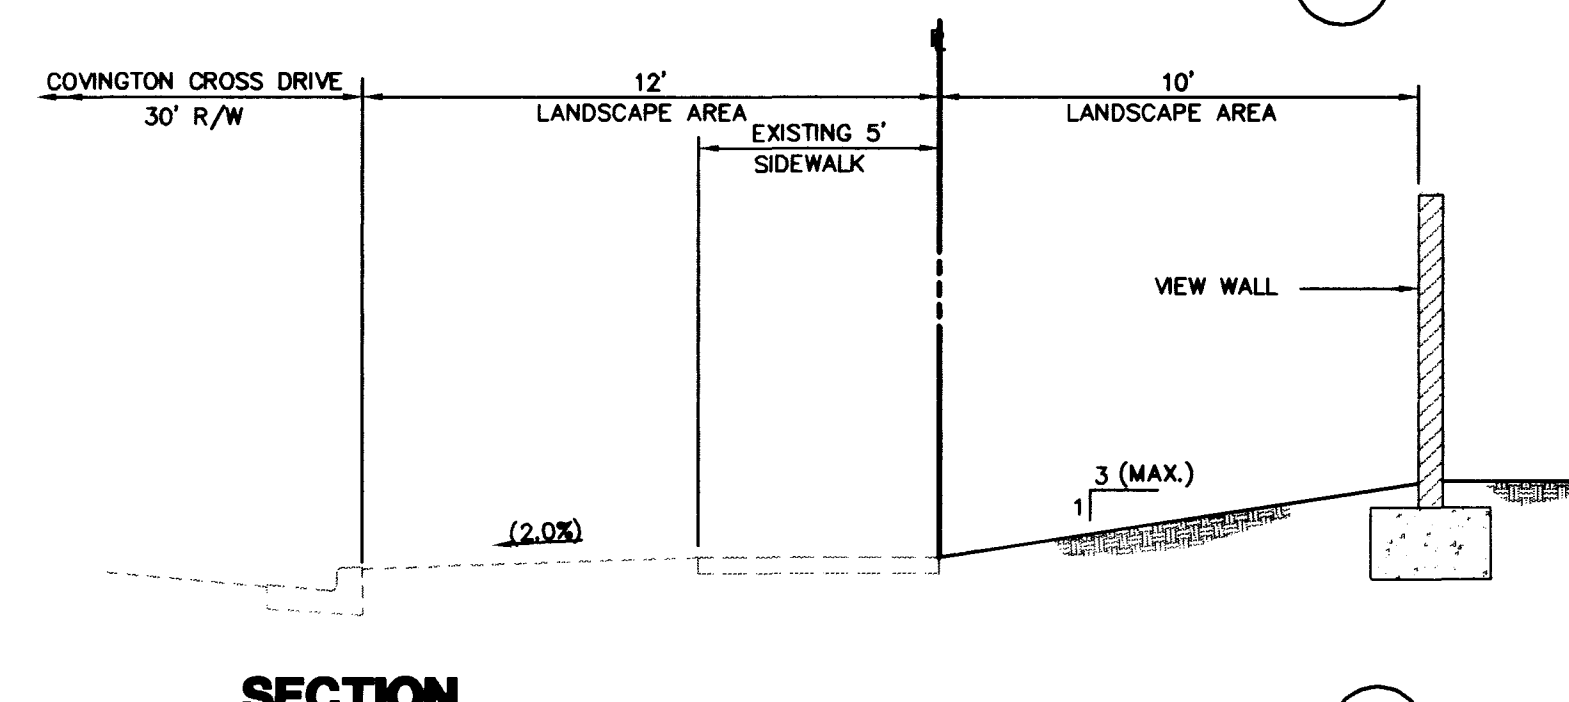

SECTION

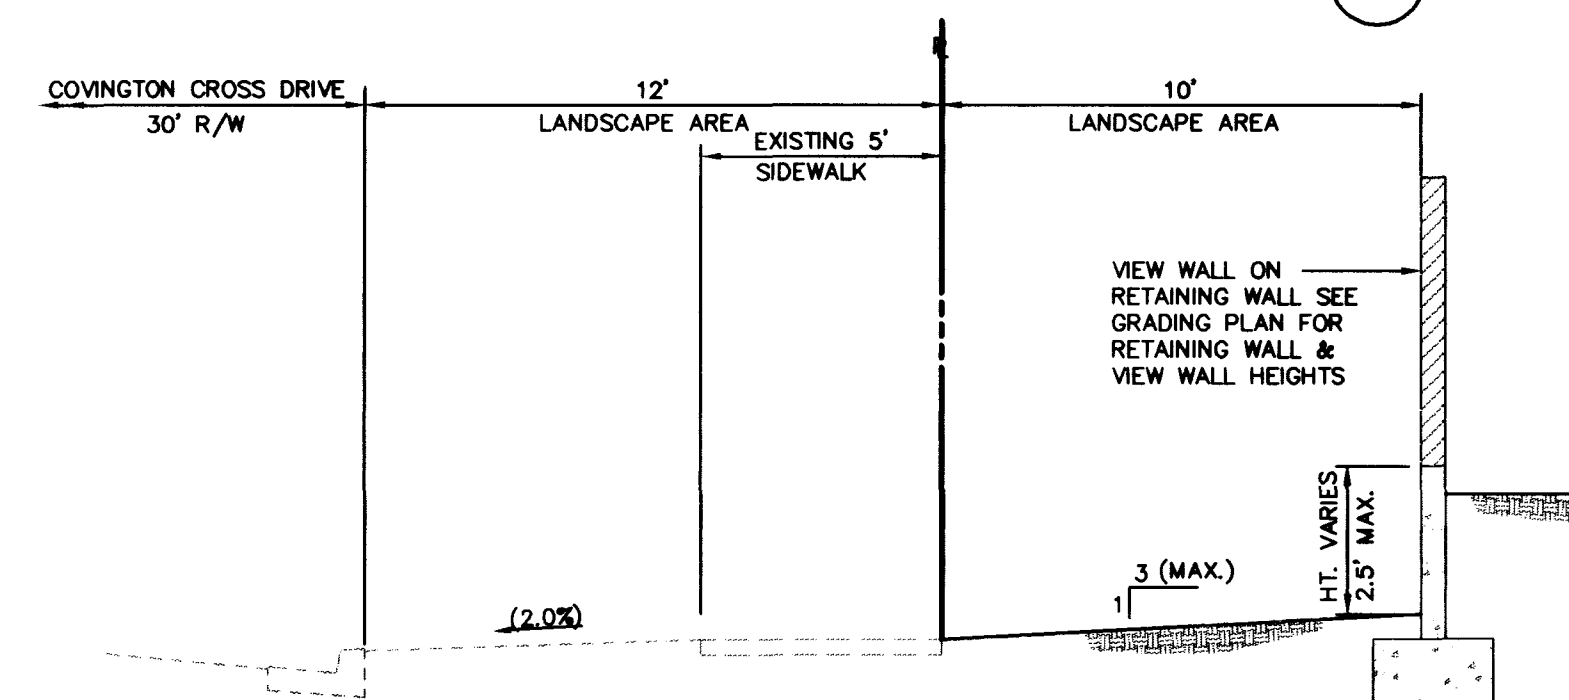


SECTION

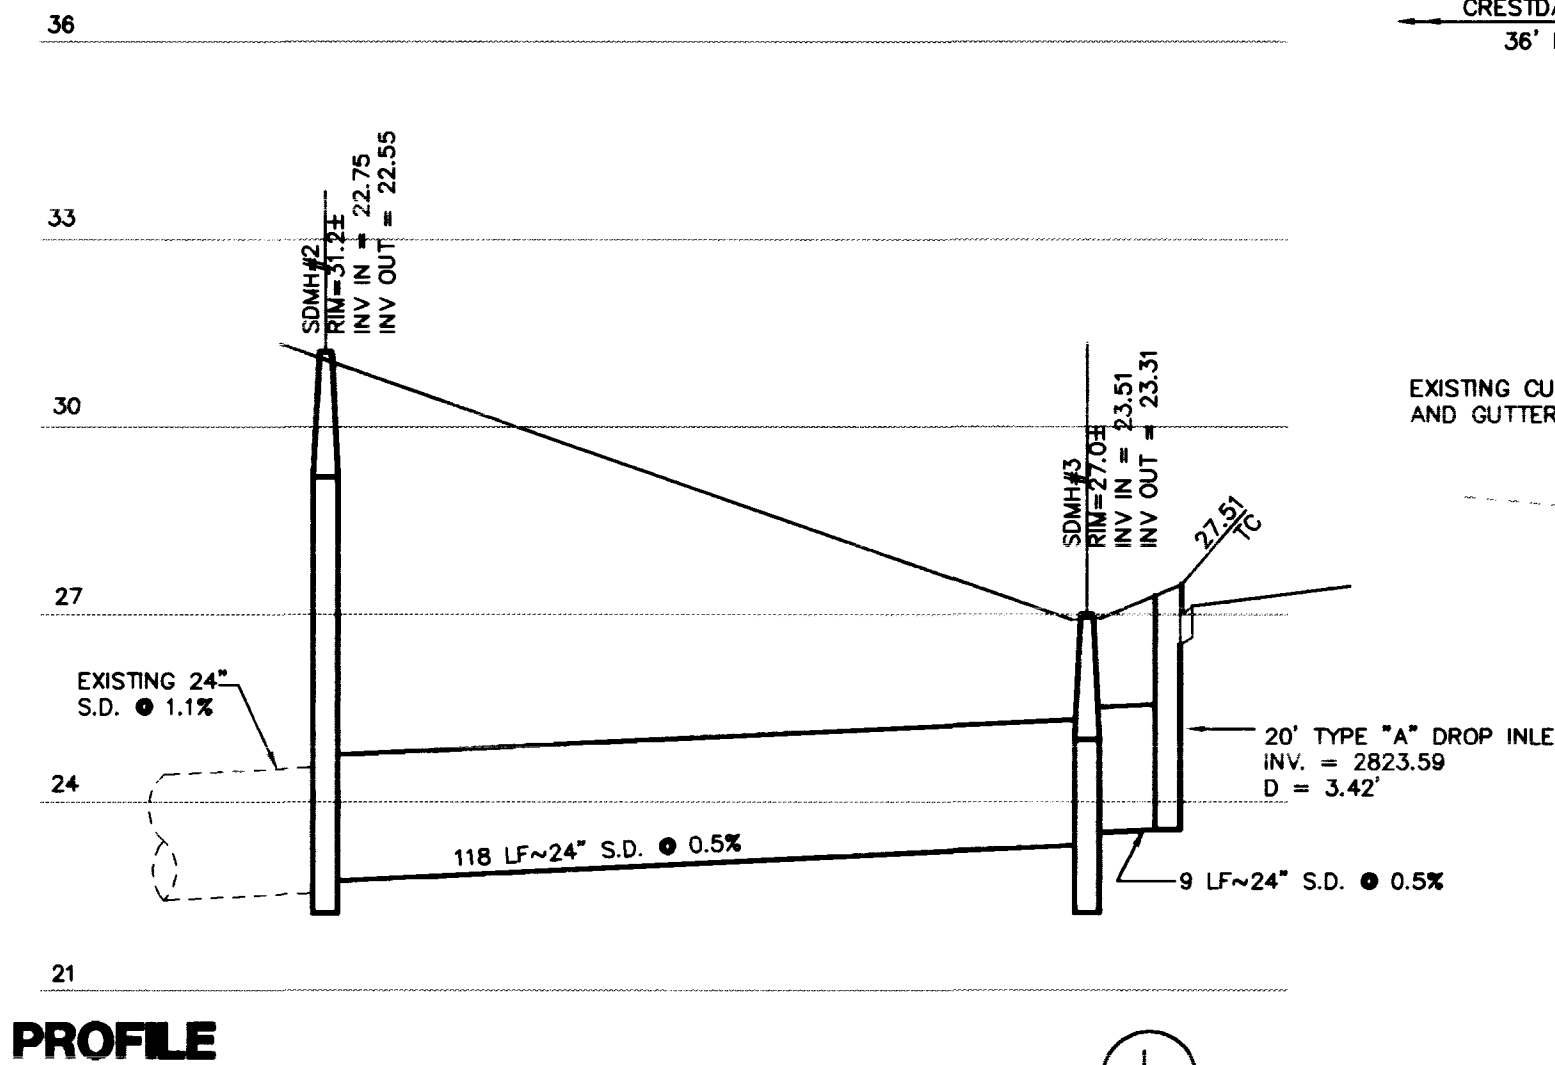


PROFILE


RETAINING WALL

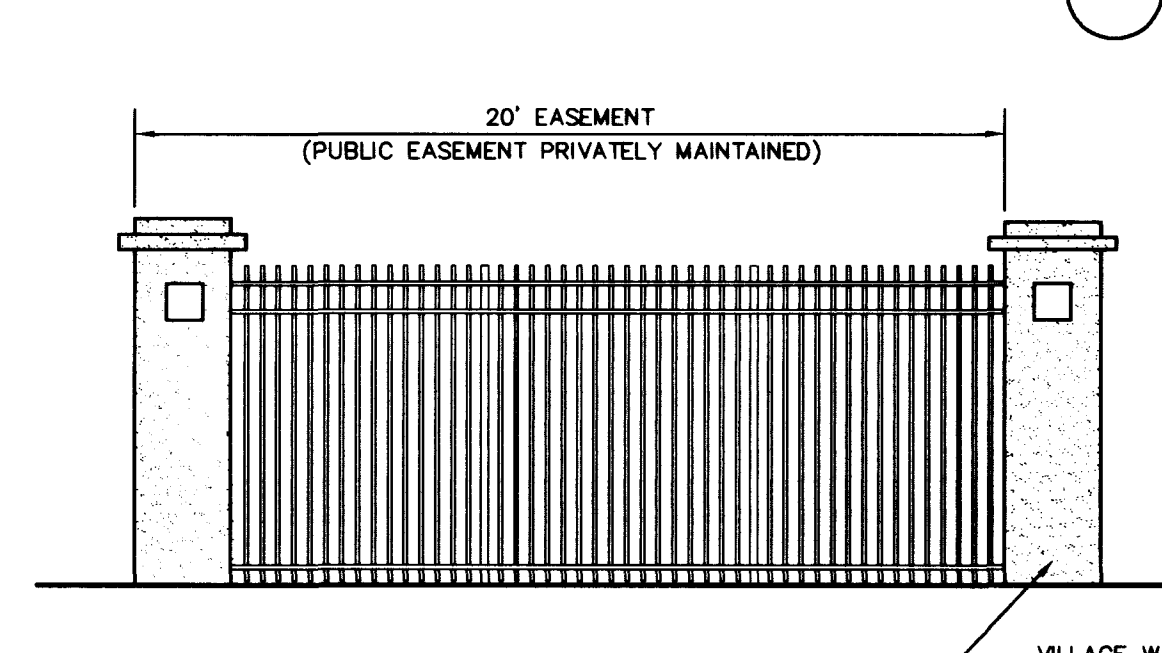


VIEW FENCE AT EASEMENT

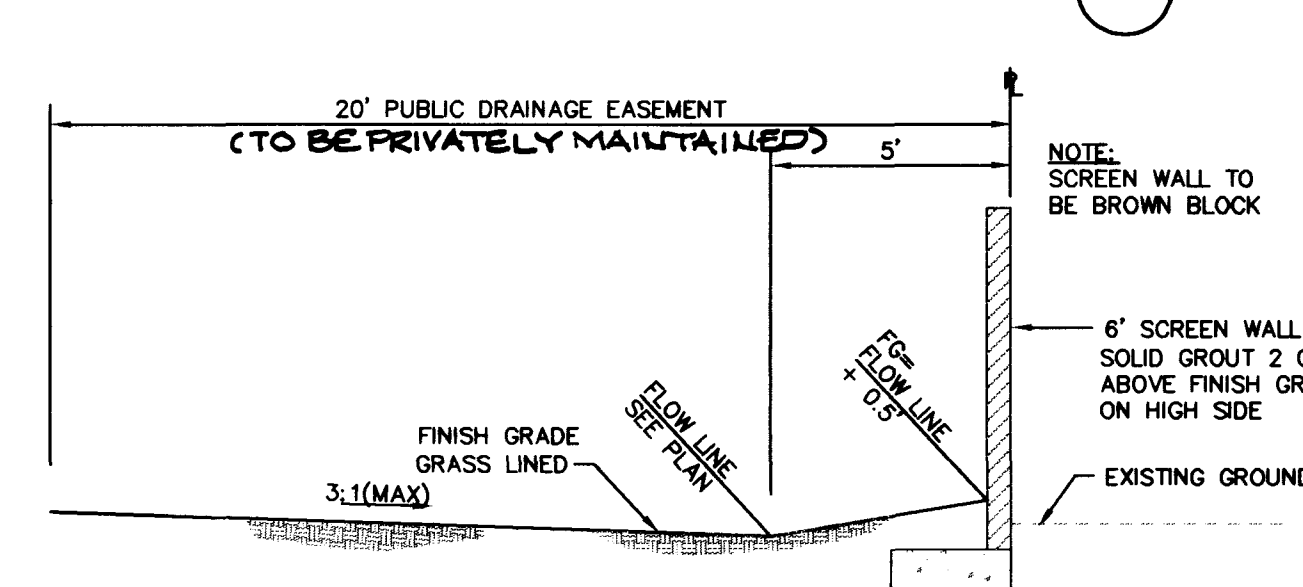

SECTION

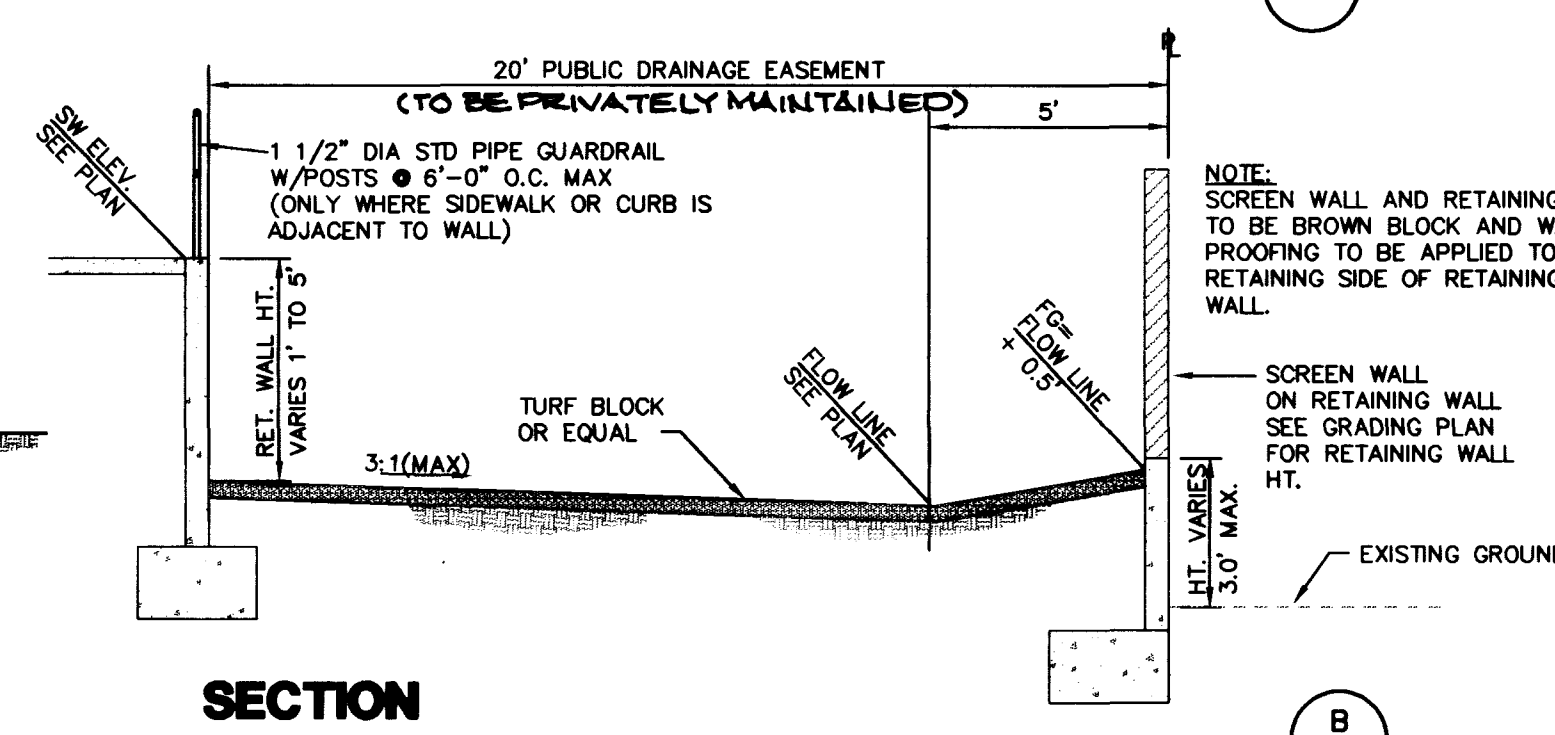


SECTION

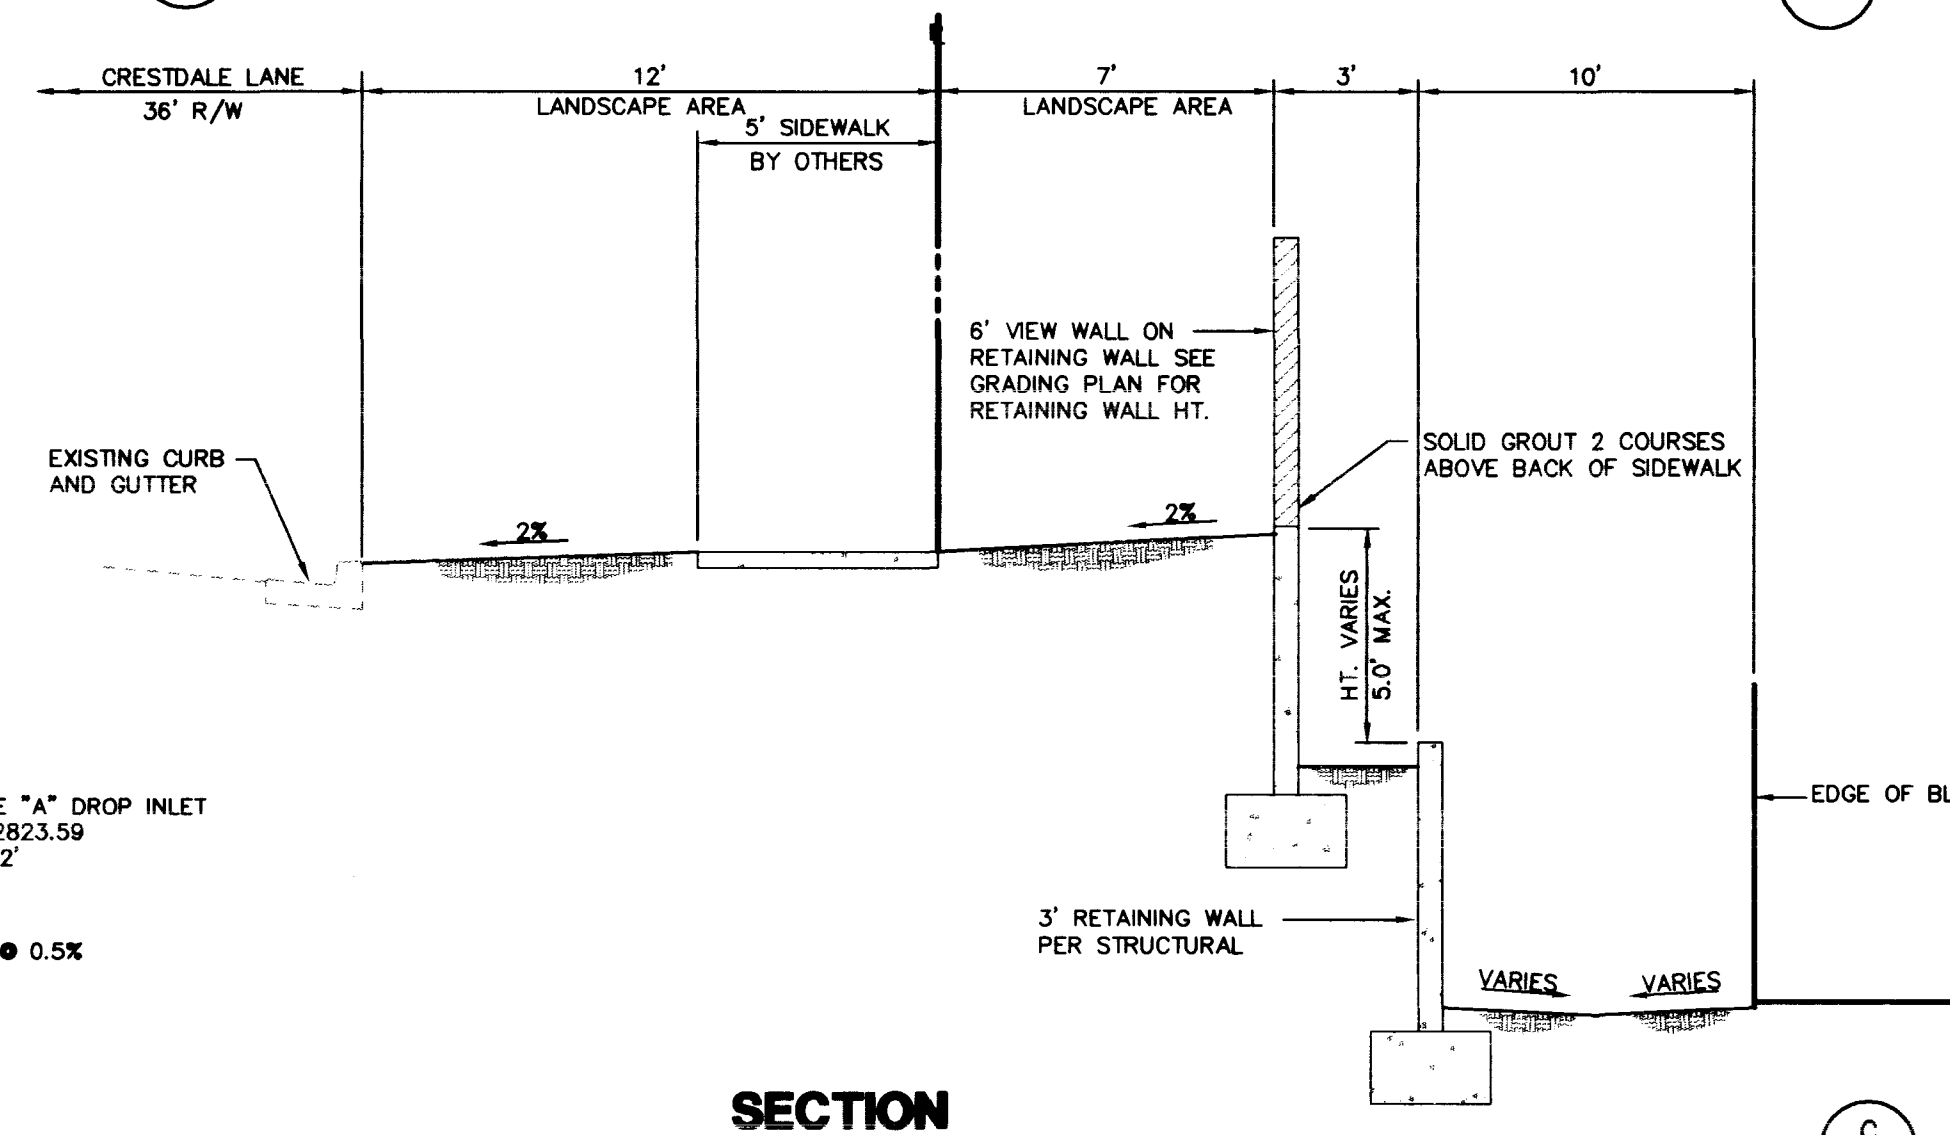


SECTION


RETAINING WALL AT UTILITY BOXES

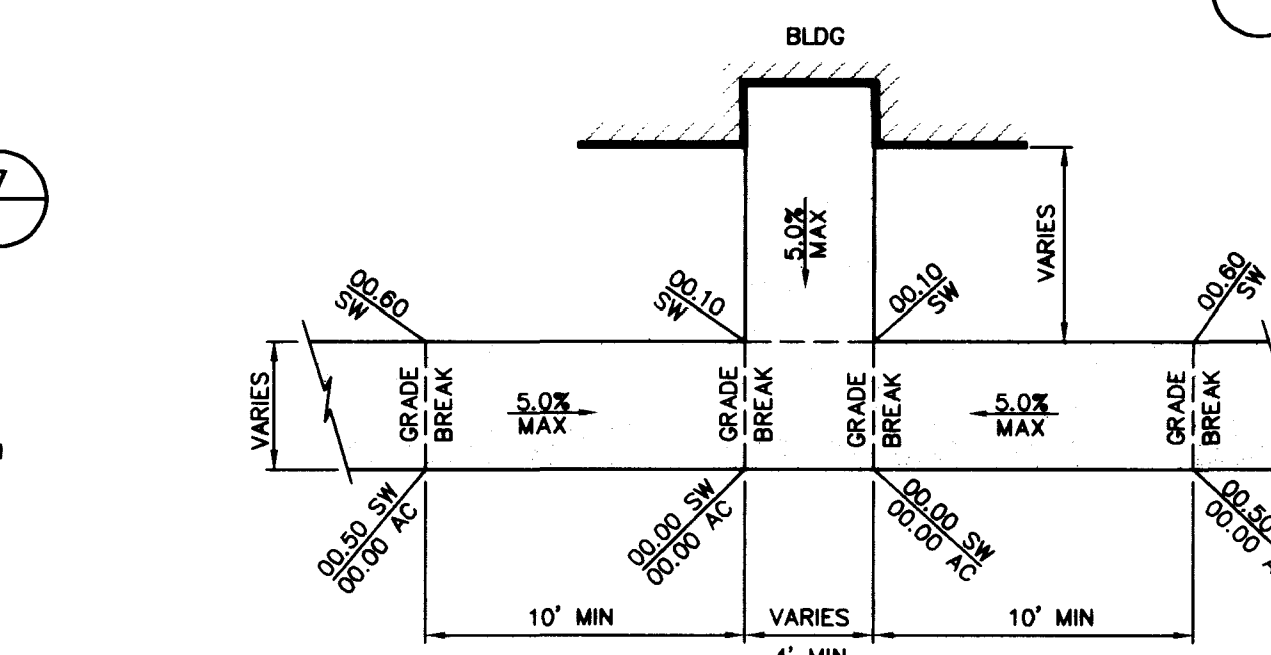


TYP. RAMP DETAIL

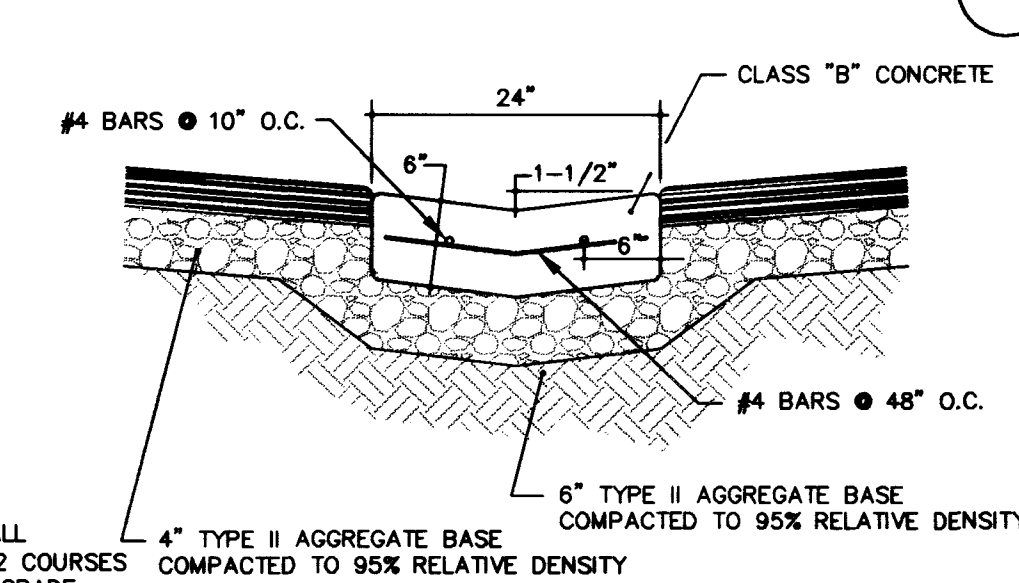


2' WIDE VALLEY GUTTER

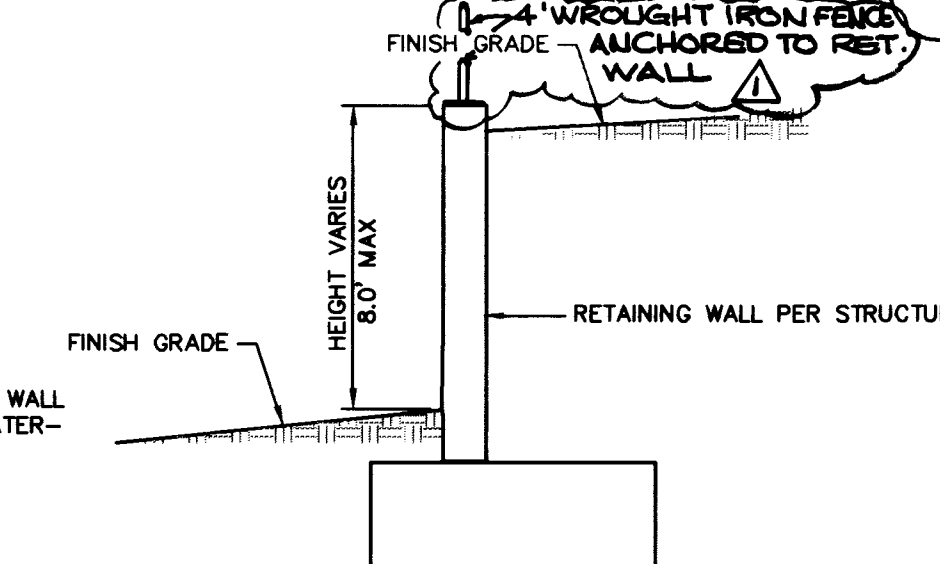


RETAINING WALL

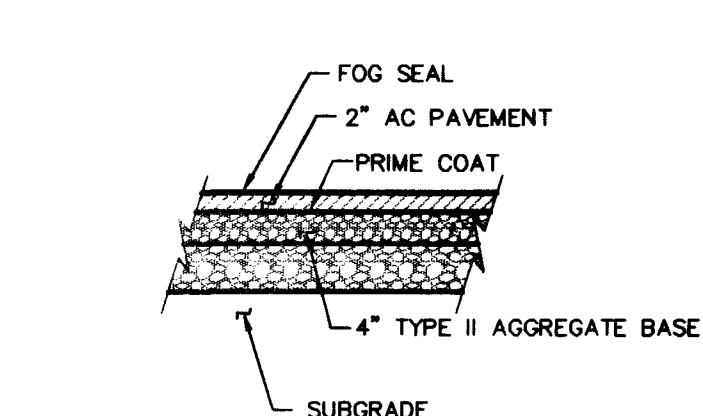

TYP. ON-SITE AC SECTION

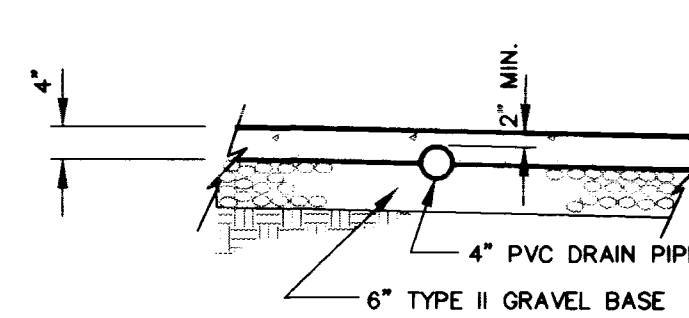

UNDER SIDEWALK DRAIN (ON-SITE)

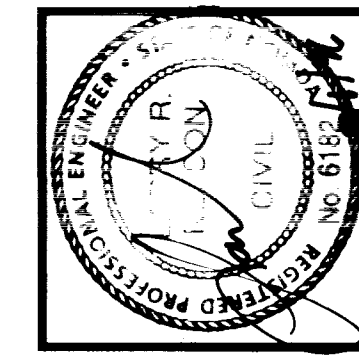

DESIGNED BY: PK	DRAWN BY: RD	CHECKED BY: J
JOB NUMBER: 218-067-952	DATE: 12-18-95	REVISION:
ADD W/REINFORCING FENCE TO DET. 4.1		
NO.	DATE	BY
1	12/18/95	RD

L. R. NELSON CONSULTING ENGINEERS, INC.

• STRUCTURAL Suite 9 89120

• CIVIL Las Vegas, Nevada

• SURVEY (702) 798-7978 (702) 451-2296 FAX

DETAIL SHEET

RED BLUFFS AT THE CROSSING

PARCEL - C


ROBERT V. JONES, CORP.

CITY OF LAS VEGAS NEVADA





SHEET NUMBER

5

OF 11 SHEETS

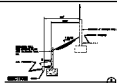

NOTE: FIRE LANE IS TO BE MAINTAINED CLEAR AT ALL TIMES.

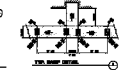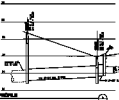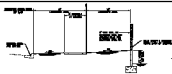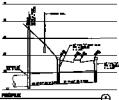


