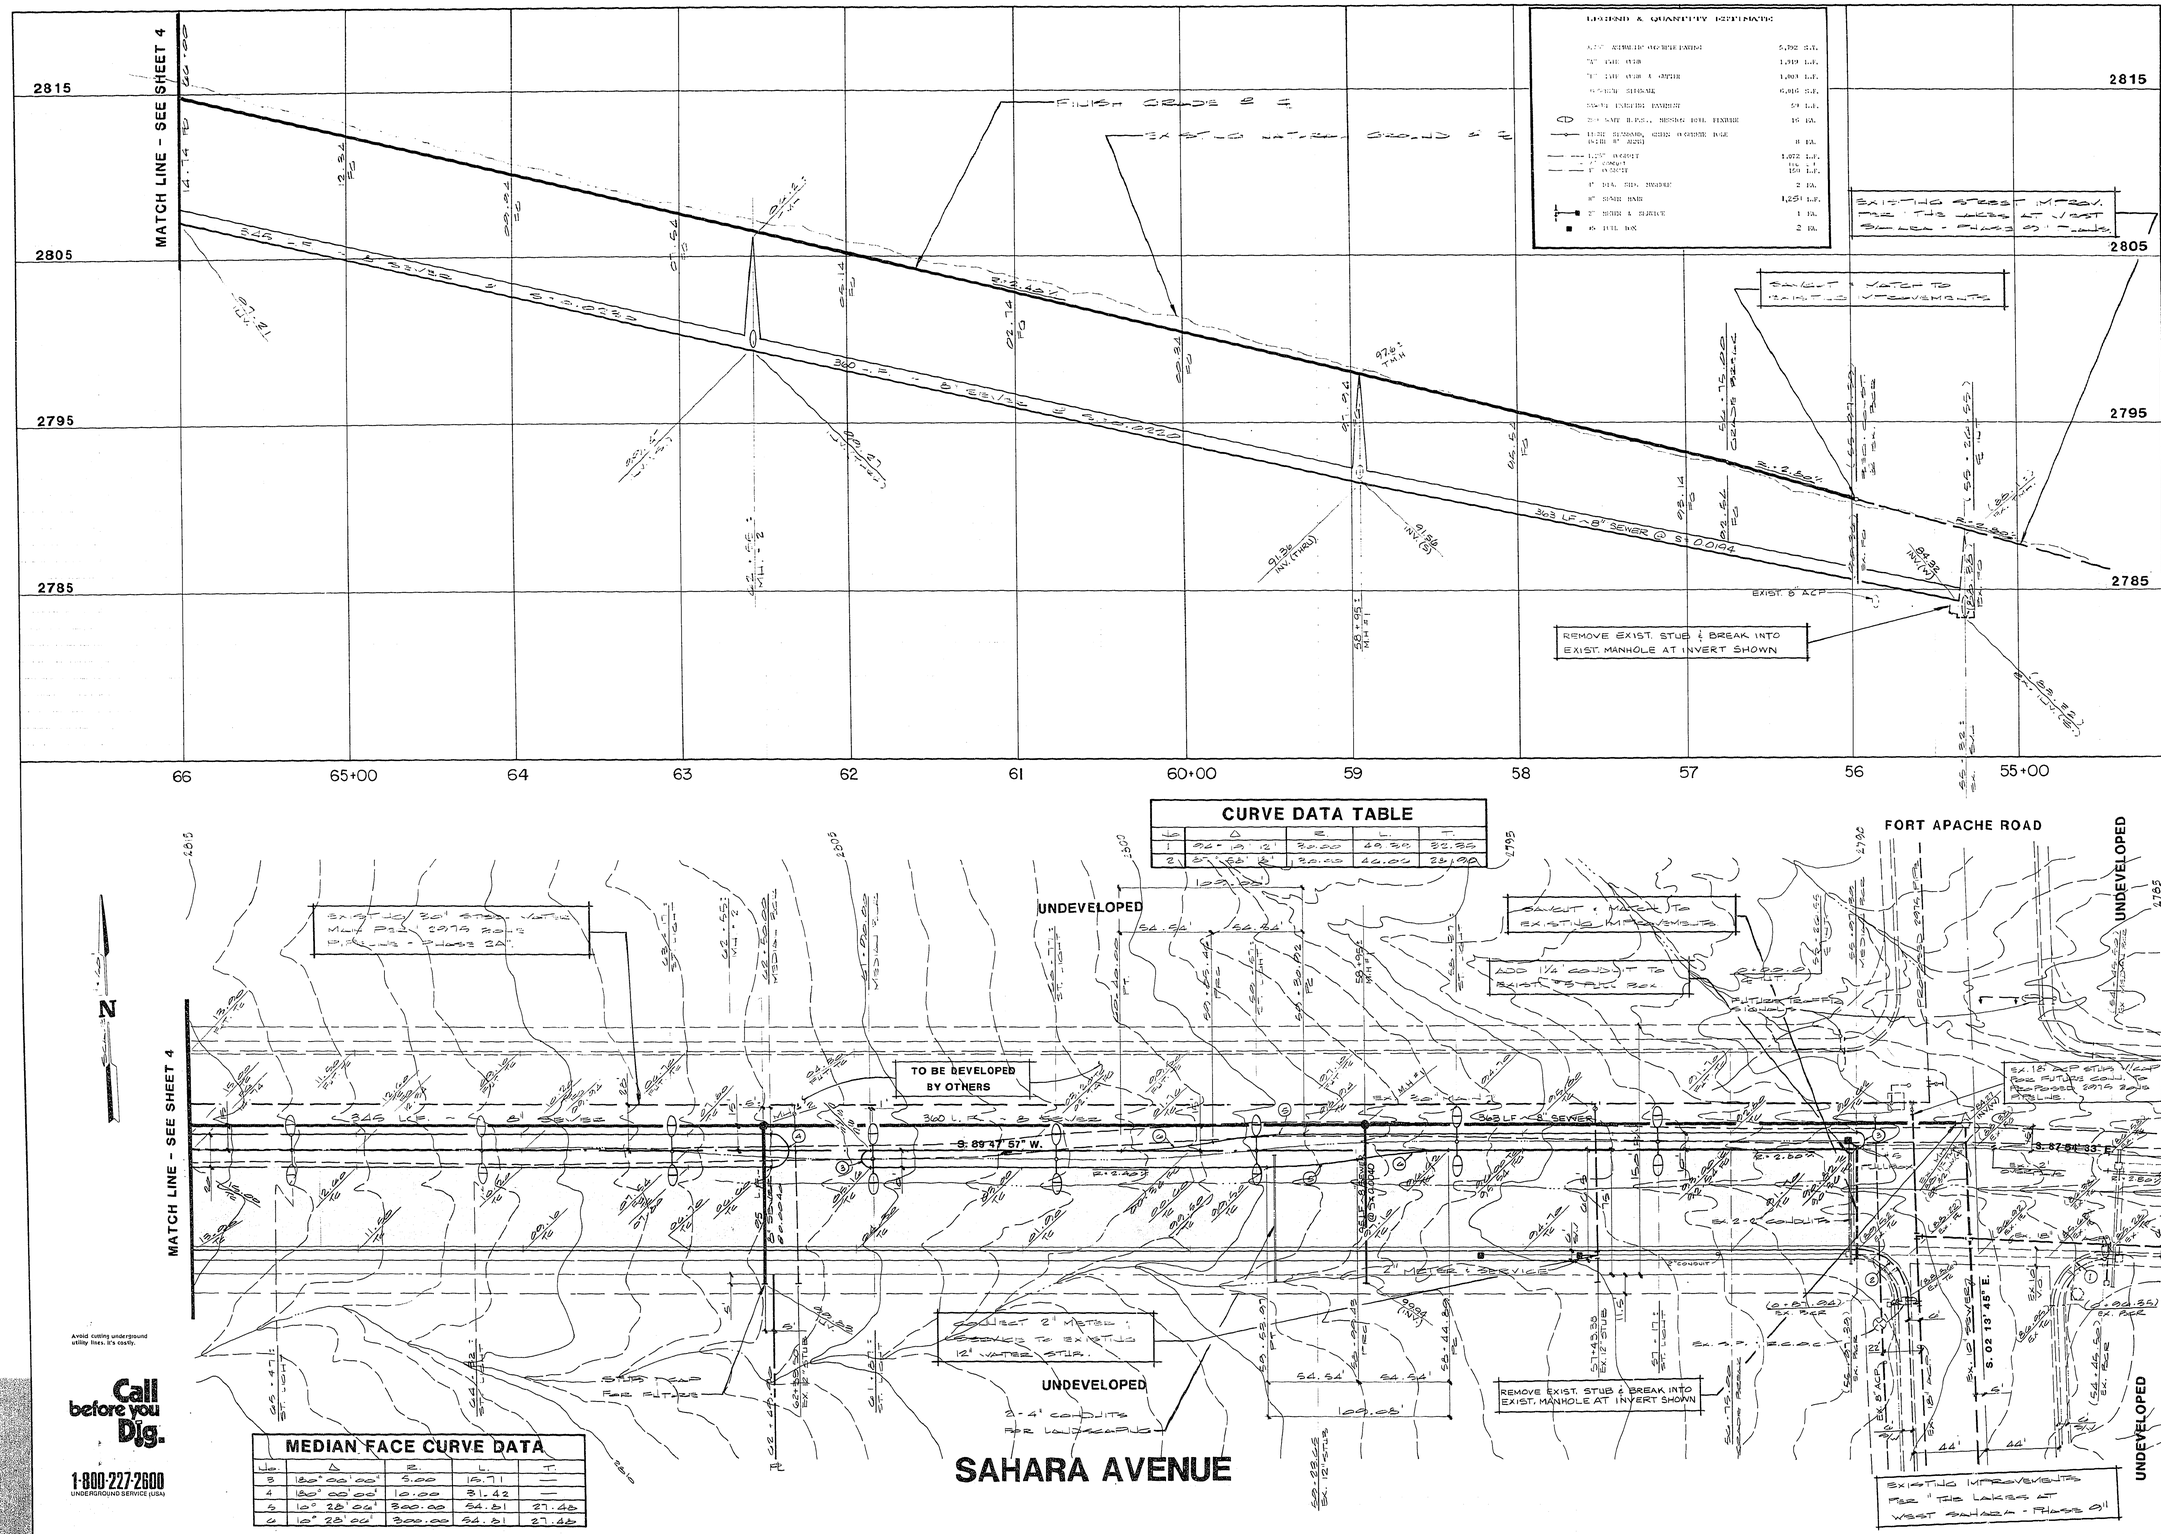

REV.	DATE	BY	REVISION
1	11-24-87	TB	ADD EX. 8" ACP RELOCATED M.H.#1 ADD STUB AT STA. 58+95, REVISED QUANTITIES
2	11-15-88	GJ	REVISE STREET LIGHT TO 6" SOIL
3	8-1-88	BN	REVISE STUB LOCATION PER 2016 ZONE PIPELINE, PHASE 2A

ESI ENGINEERS & SURVEYORS INC.
7018 W. CHARLESTON BLVD. LAS VEGAS, NEVADA 89117 (702) 243-4115

SUBMITTED BY: Paul E. Valentine 9/2/87

TITLE: STREET & SEWER PLAN & PROFILE (SAHARA AVENUE : STA. 55+26.55 TO 66+00)

PROJECT: SEC. 7 THE LAKES AT WEST SAHARA (PHASE 4)

WO NO.	5052
BY	F.L.S.
DATE	8/87
SCALE	HORIZ. 1" = 40' VERT. 1" = 4'

SHEET 3 OF 11 SHEETS

Avoid cutting underground utility lines. It's costly.

Call before you Dig.

1-800-227-2600
UNDERGROUND SERVICE (USA)

14.7.29

1097-1933-4