


[illegible]

✓ 2700

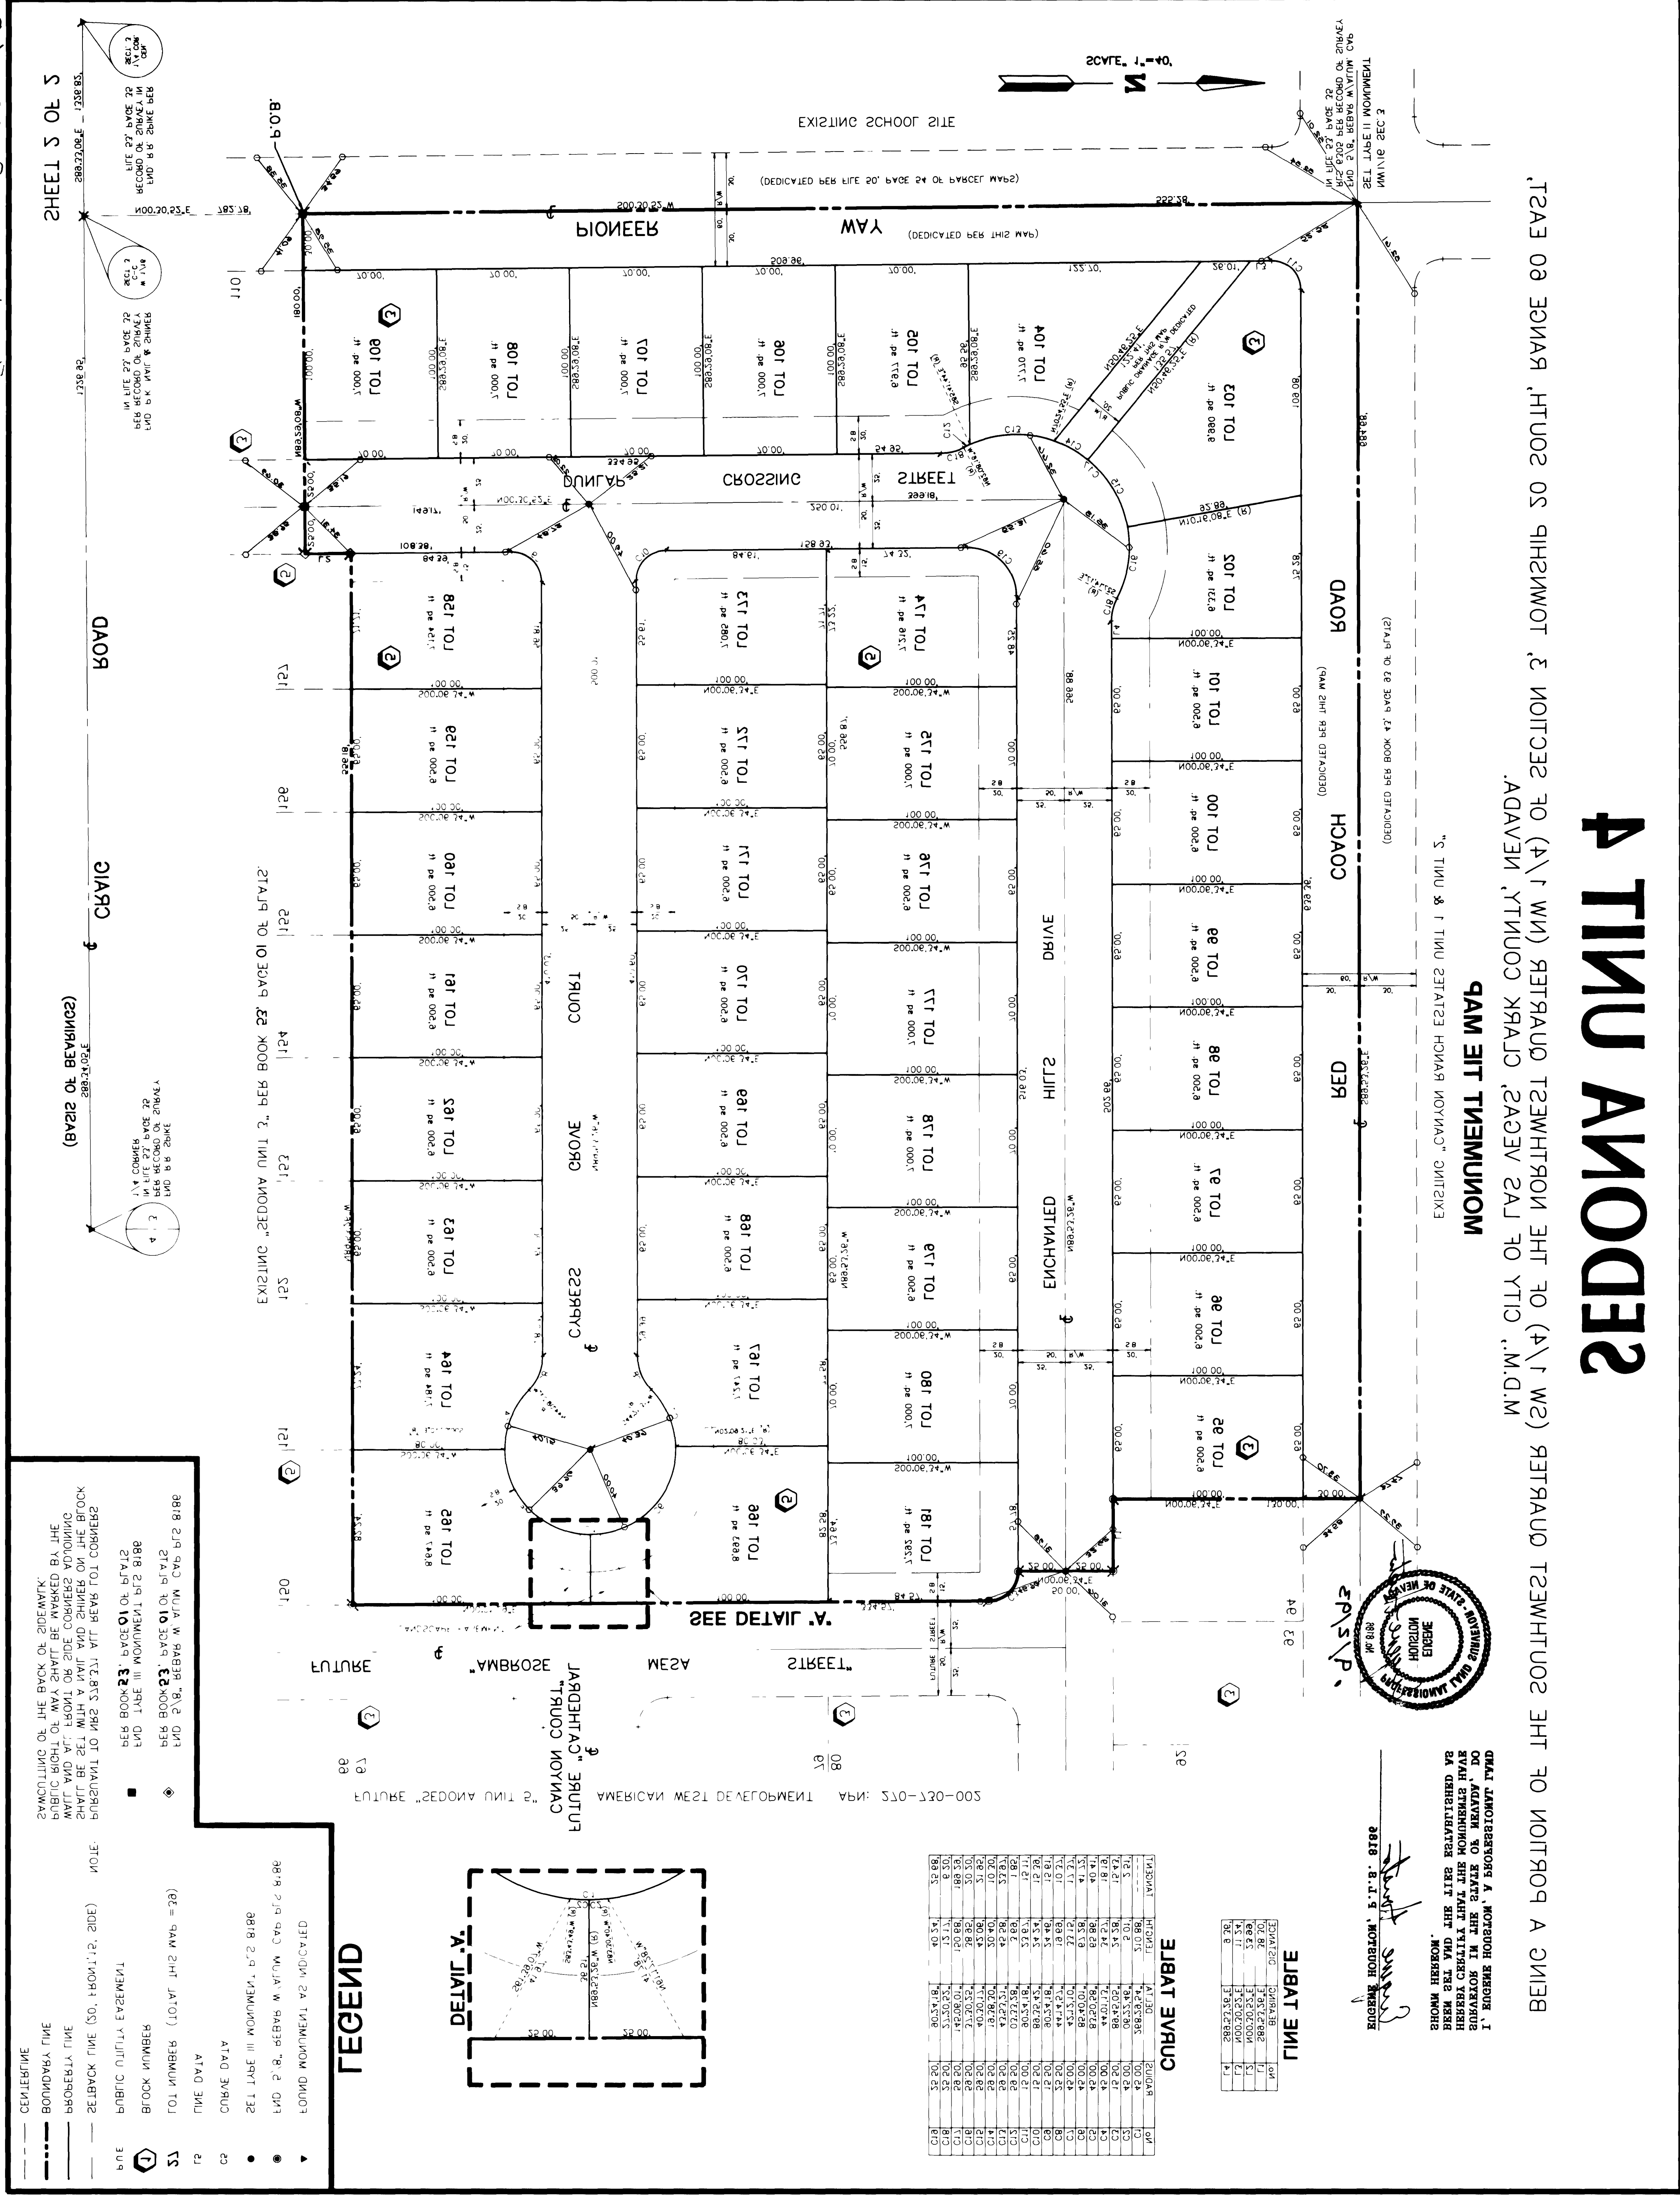