

REVISIONS

Δ TITLE BLOCK CHANGED
5/26/93 PSS



NOTES:

- ALL UTILITIES SHOWN ARE BELIEVED TO BE ACCURATELY LOCATED, BUT THE ACCURACY AND COMPLETENESS OF UTILITY INFORMATION IS NOT GUARANTEED. FOR EXACT LOCATION OF ANY UTILITY SEE THE APPROPRIATE UTILITY OR GOVERNMENTAL AGENCY.
- THE FOLLOWING CLARK COUNTY UNDERGROUND FACILITIES MAY BE LOCATED IN THIS PROJECT'S AREA. TRAFFIC SIGNALS, STREETLIGHTING, INTERCONNECT CABLE. YOU MUST CONTACT CLARK COUNTY TRAFFIC AT 438-2311 FOR LOCATIONS AT LEAST 48 HOURS PRIOR TO WORKING IN THE AREA. CLARK COUNTY IS NOT A MEMBER OF CALL BEFORE YOU DIG (UNDERGROUND SERVICE ALERT) AND A CALL TO THAT ORGANIZATION DOES NOT RELIEVE YOU OF LIABILITY FOR CLARK COUNTY FACILITIES.
- THESE DRAWINGS ARE PRELIMINARY AND SUBJECT TO REVISION UNTIL THEY BEAR THE APPROVAL SIGNATURE FROM ALL OF THE APPROPRIATE DESIGNING AGENCIES. ALL ESTIMATED QUANTITIES DEPICTED ON THE PLANS ARE FOR INFORMATIONAL PURPOSES ONLY AND SHALL NOT BE USED AS THE BASIS OF BIDDING, QUANTITIES, ESTIMATES, AND INFORMATION. THESE PRELIMINARY DRAWINGS ARE APPROXIMATE ONLY, BEING GIVEN AS A BASIS FOR COMPARISON OF BIDS ONLY. THE ENGINEER RESERVES THE RIGHT TO MAKE ALTERATIONS, DEVIATIONS, ADDITIONS AND DELETIONS TO THESE PRELIMINARY PLANS, INCLUDING THE RIGHT TO INCREASE OR DECREASE THE QUANTITY OF ANY ITEM OF WORK, AS DEEMED NECESSARY BY THE ENGINEER.



SCALE
1" = 30'

DRAWN BY
PSS

SMOKE RANCH ROAD IMPROVEMENT PLAN FOR SMOKE RANCH VILLAS SE 1/4, S13, T20S, R60E, MDM CITY OF LAS VEGAS, NEVADA

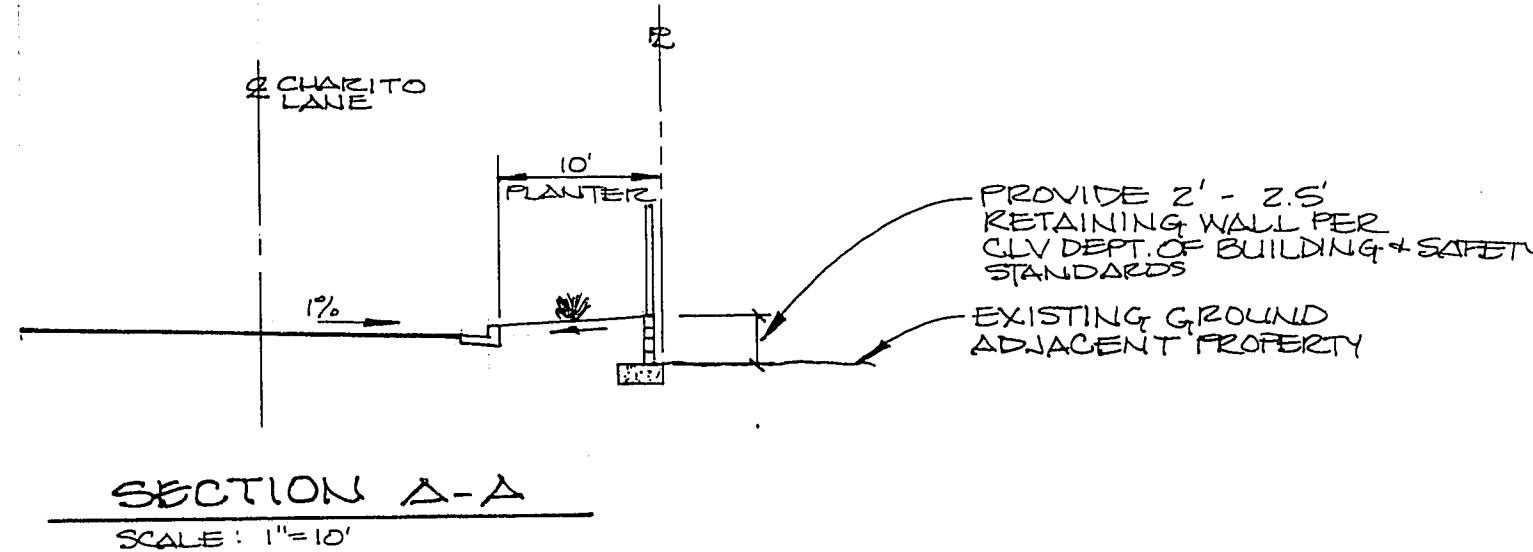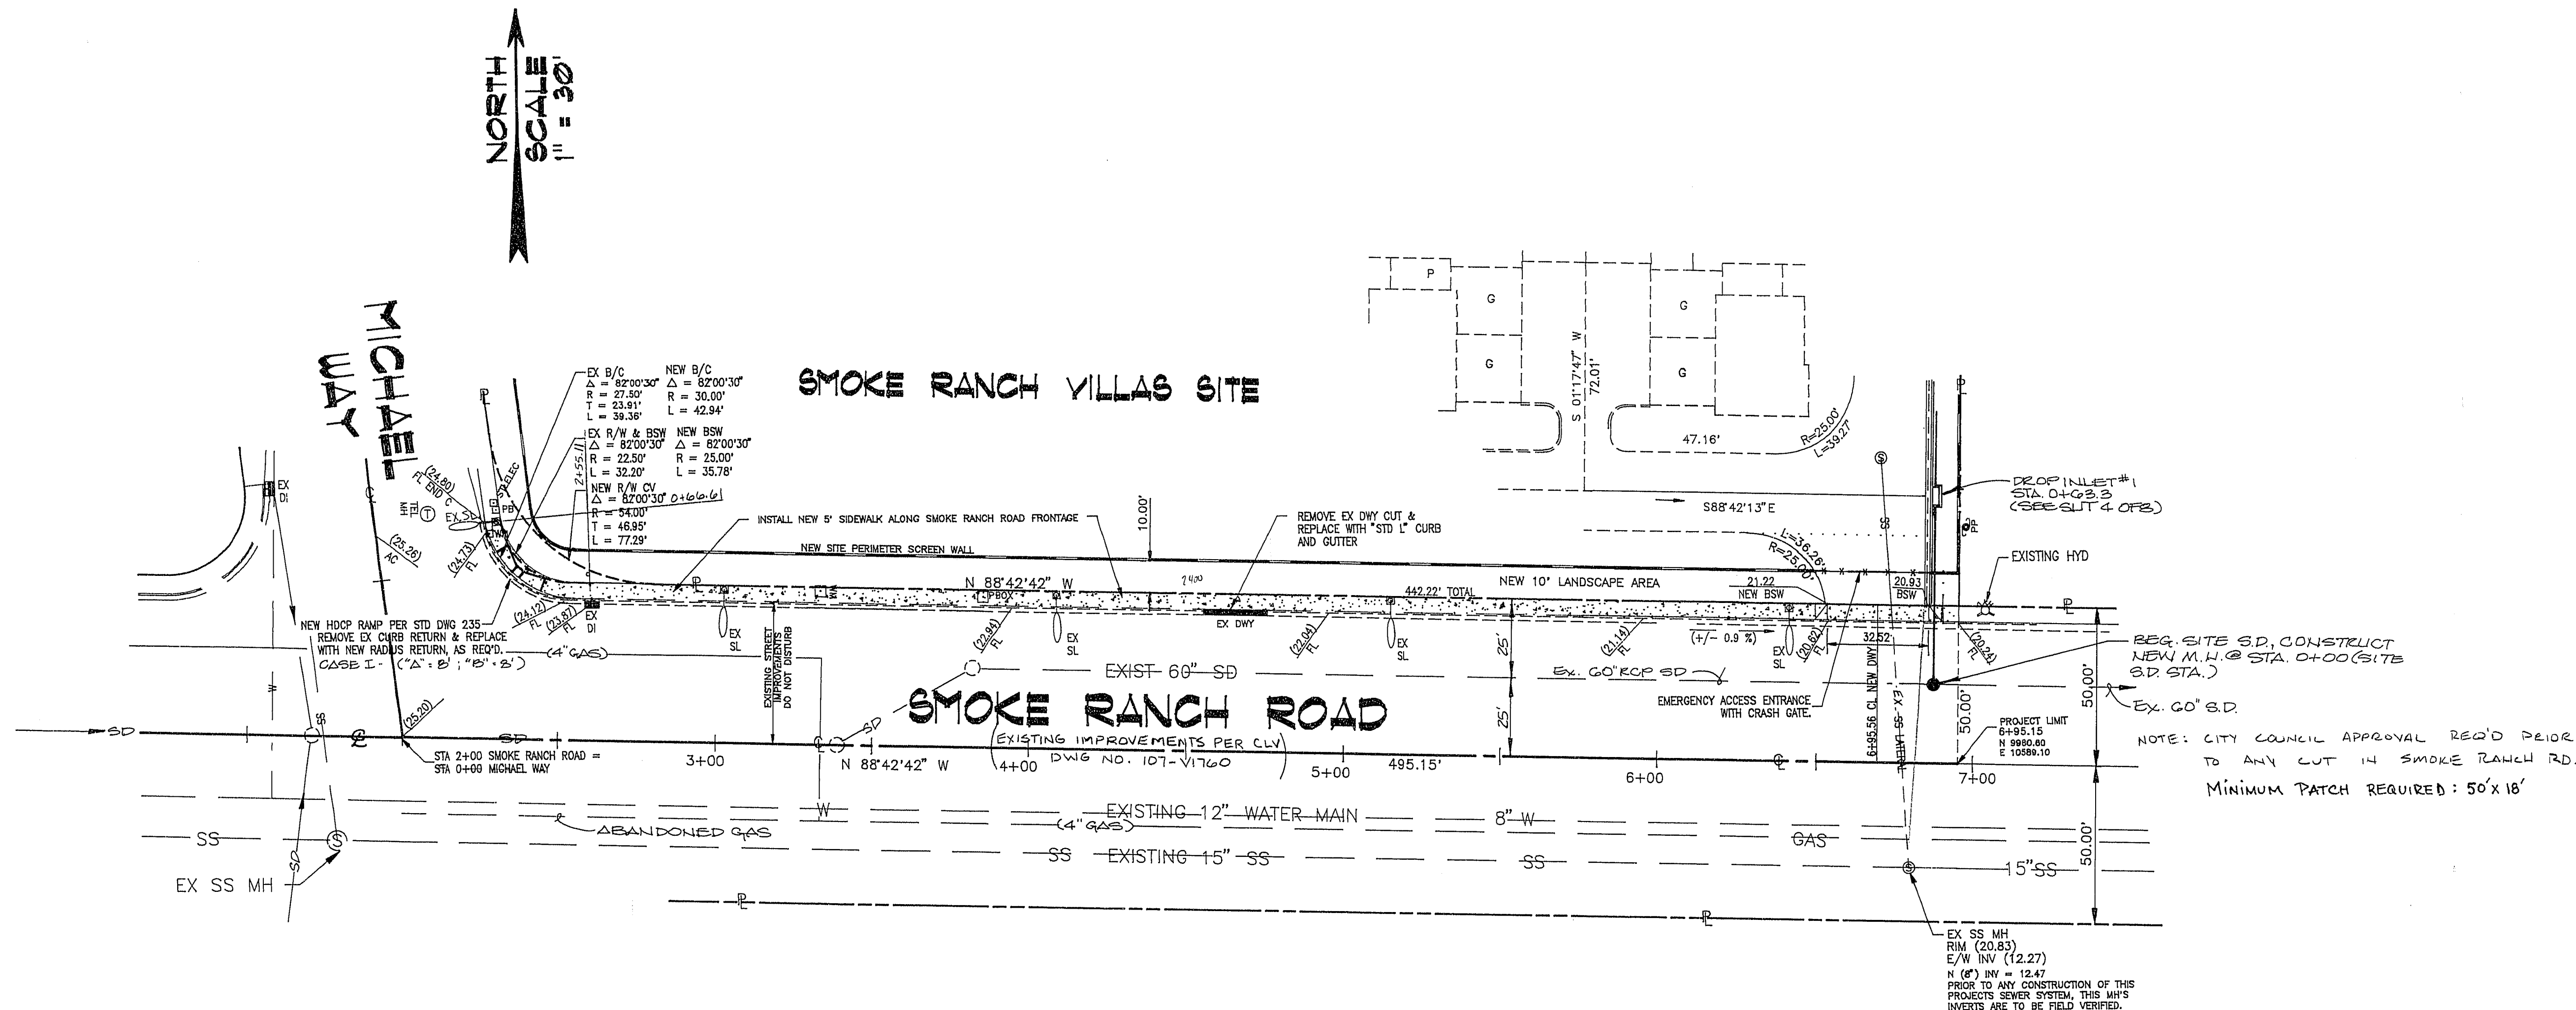

CALL
BEFORE YOU DIG
1-800-227-2600

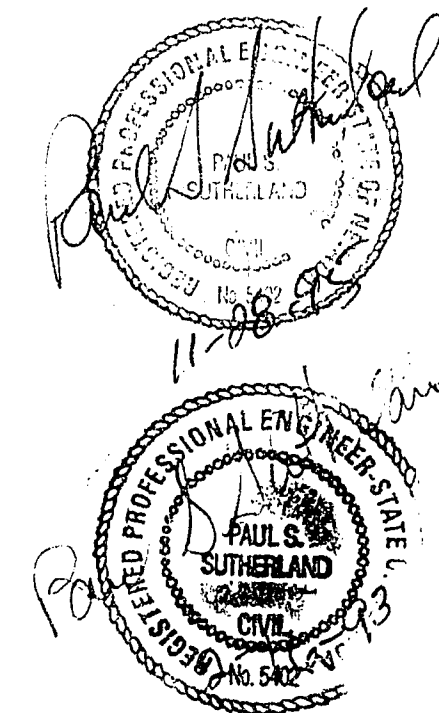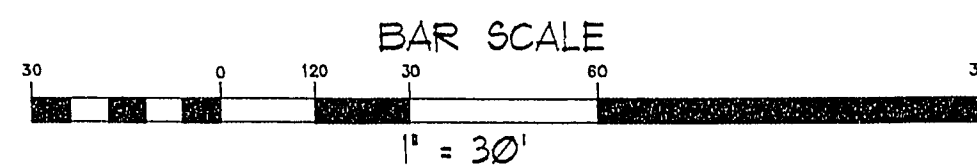

SAHARA ENGINEERING
SERVING - NEVADA - CALIFORNIA - ARIZONA
ENGINEERING - PLANNING - DESIGN
DRAINAGE & TRAFFIC STUDIES
1086 East Sahara Avenue
Suite No. 203
Las Vegas, Nevada 89104
(702) 792-1502 fax 792-4563

DWG: SMOKER
9-28-92
PROJECT FILE DESIGNATION
30-92
SHEET
7
OF EIGHT

10-29-7 1074-4261