
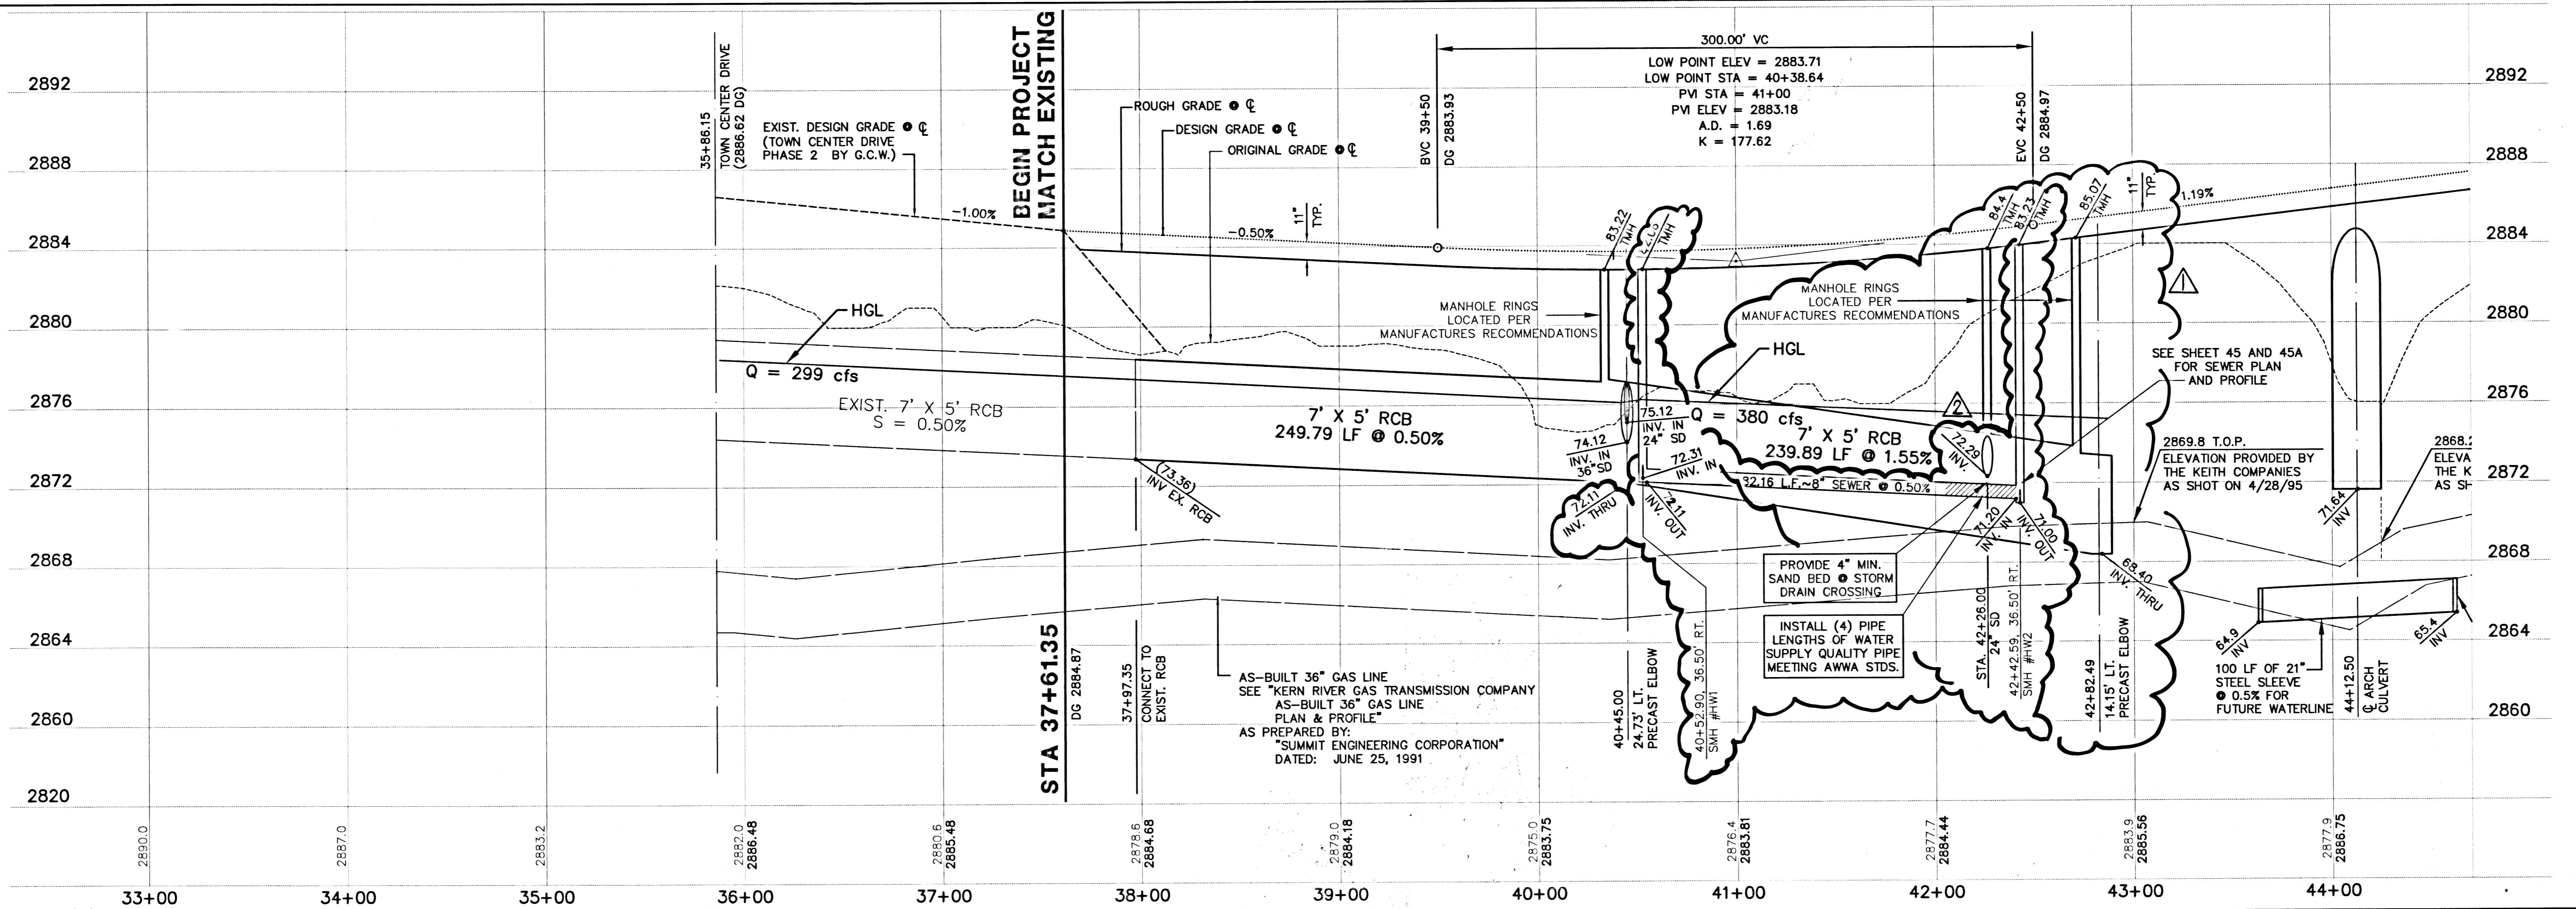


CURVE TABLE (CURVE DATA REPRESENTS ENTIRE CURVE)

CURVE	DELTA	RADIUS	LENGTH	TANGENT
1	14°35'39"	211.22'	53.80'	27.05'
2	16°30'19"	140.00'	40.33'	20.31'
3	0°49'50"	1010.00'	32.27'	16.14'
4	86°01'16"	30.00'	45.04'	27.93'
5	26°53'44"	1952.50'	916.53'	466.87'
6	88°37'15"	30.00'	46.40'	29.29'
7	26°53'44"	2000.00'	938.83'	478.23'
8	22°09'30"	2047.50'	791.84'	400.93'

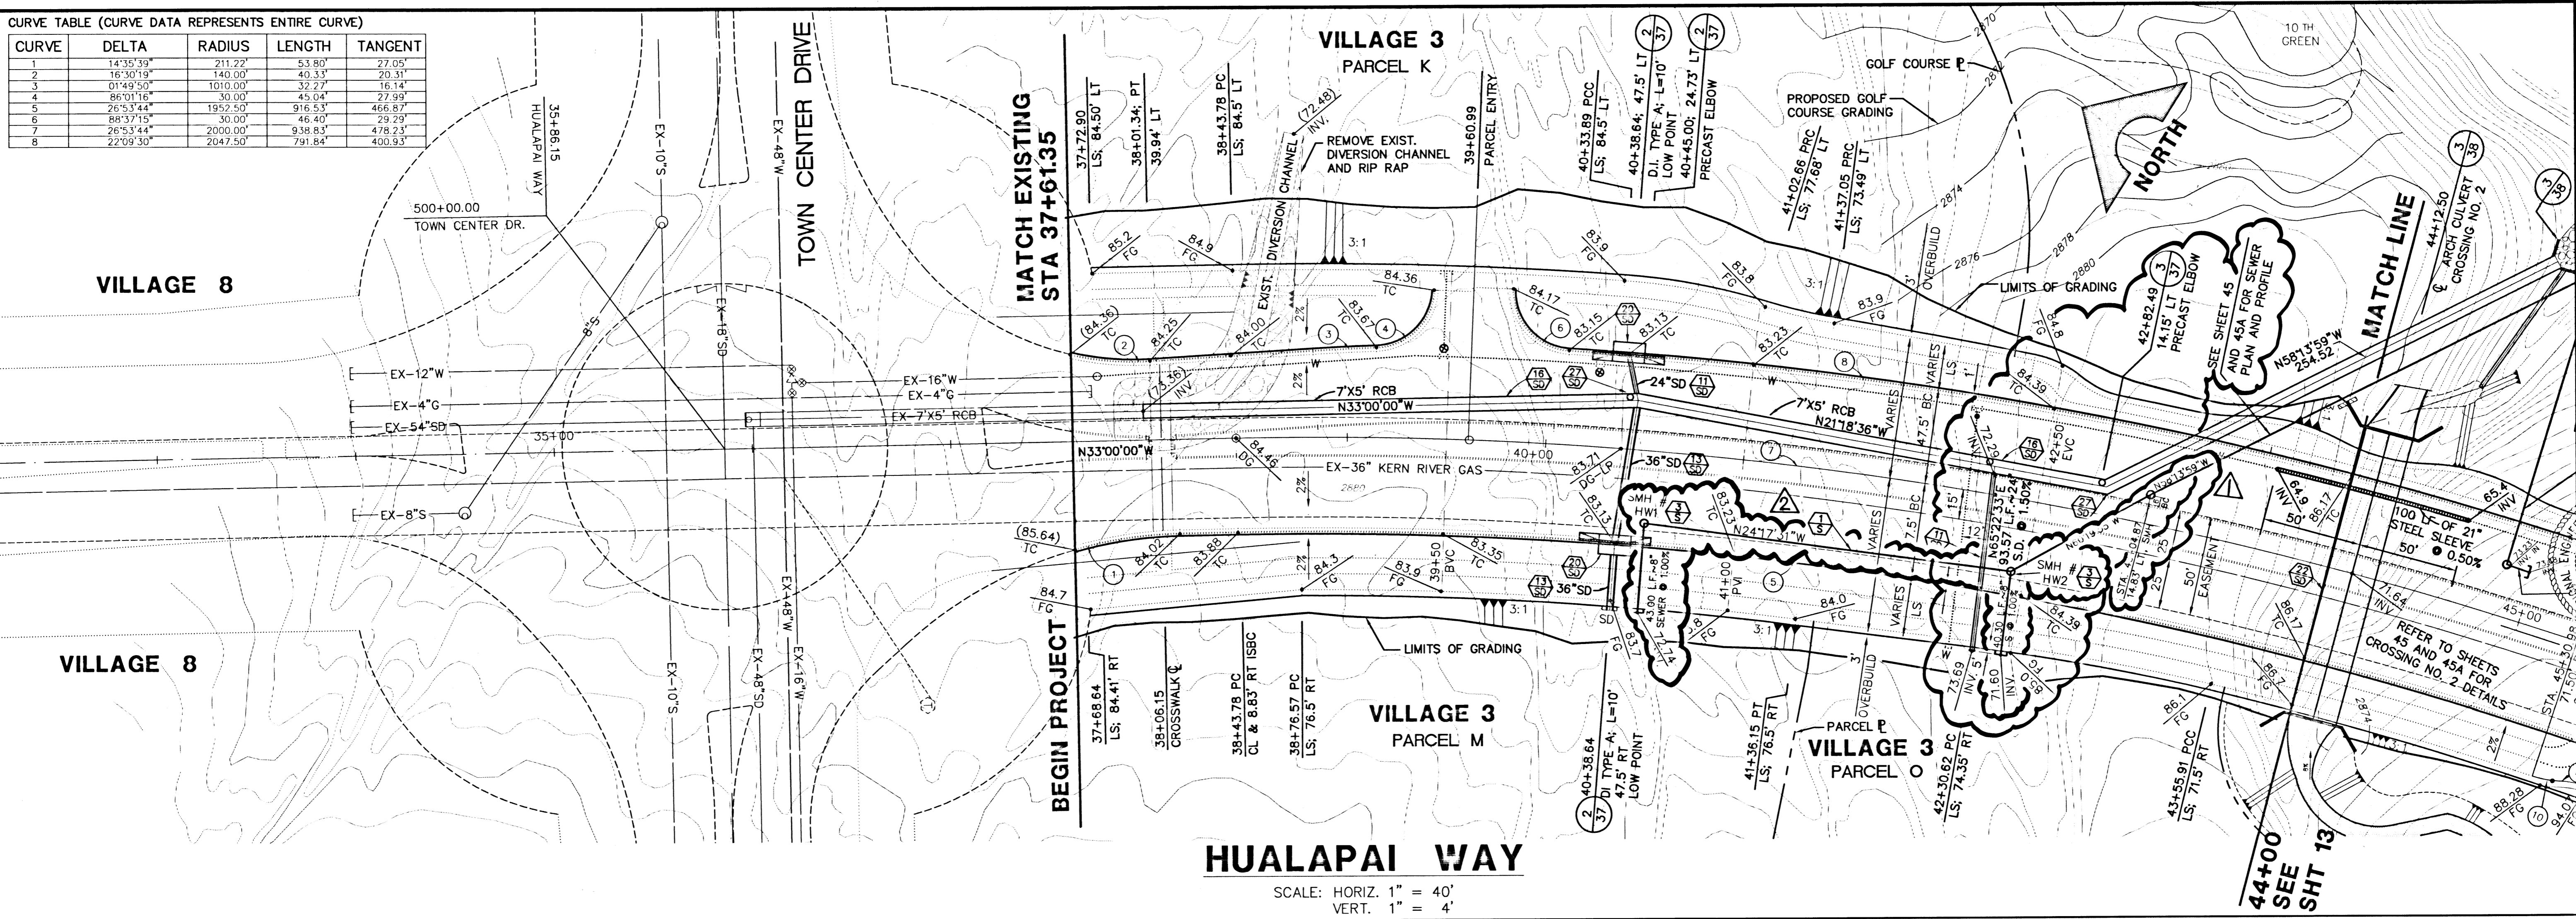

JOB NO. 62003.203

RECOMMENDED BY: *[Signature]* DATE: 11/09/95
 CHECKED BY: *[Signature]* DATE: 12/14/95
 DESIGNED BY: *[Signature]* DATE: 12/14/95
 DRAWN BY: *[Signature]* DATE: 12/14/95

11/09/95 REVISE SEWER SERVICE TO M AND O
 07/10/95 REV. SD ALIGN. 7'X5' MHS
 DATE: 12/14/95

STATE OF NEVADA
 BERT A. WALLACE, INC.
 ENGINEERING ARCHITECTURE

1555 SOUTH RAINBOW BLVD./LAS VEGAS, NEVADA 89102

SUMMERLIN
VILLAGE 3 ROUGH GRADING
HUALAPAI WAY
PLAN & PROFILE
STA 37+61.35 TO 44+00

SHEET
12
 SHT 12 OF 47

107-V2355