


GOLF COURSE SEWER AND STORM DRAIN CROSSING PLAN AND PROFILE

SCALE: HORIZ. 1" = 40'
VERT. 1" = 4'

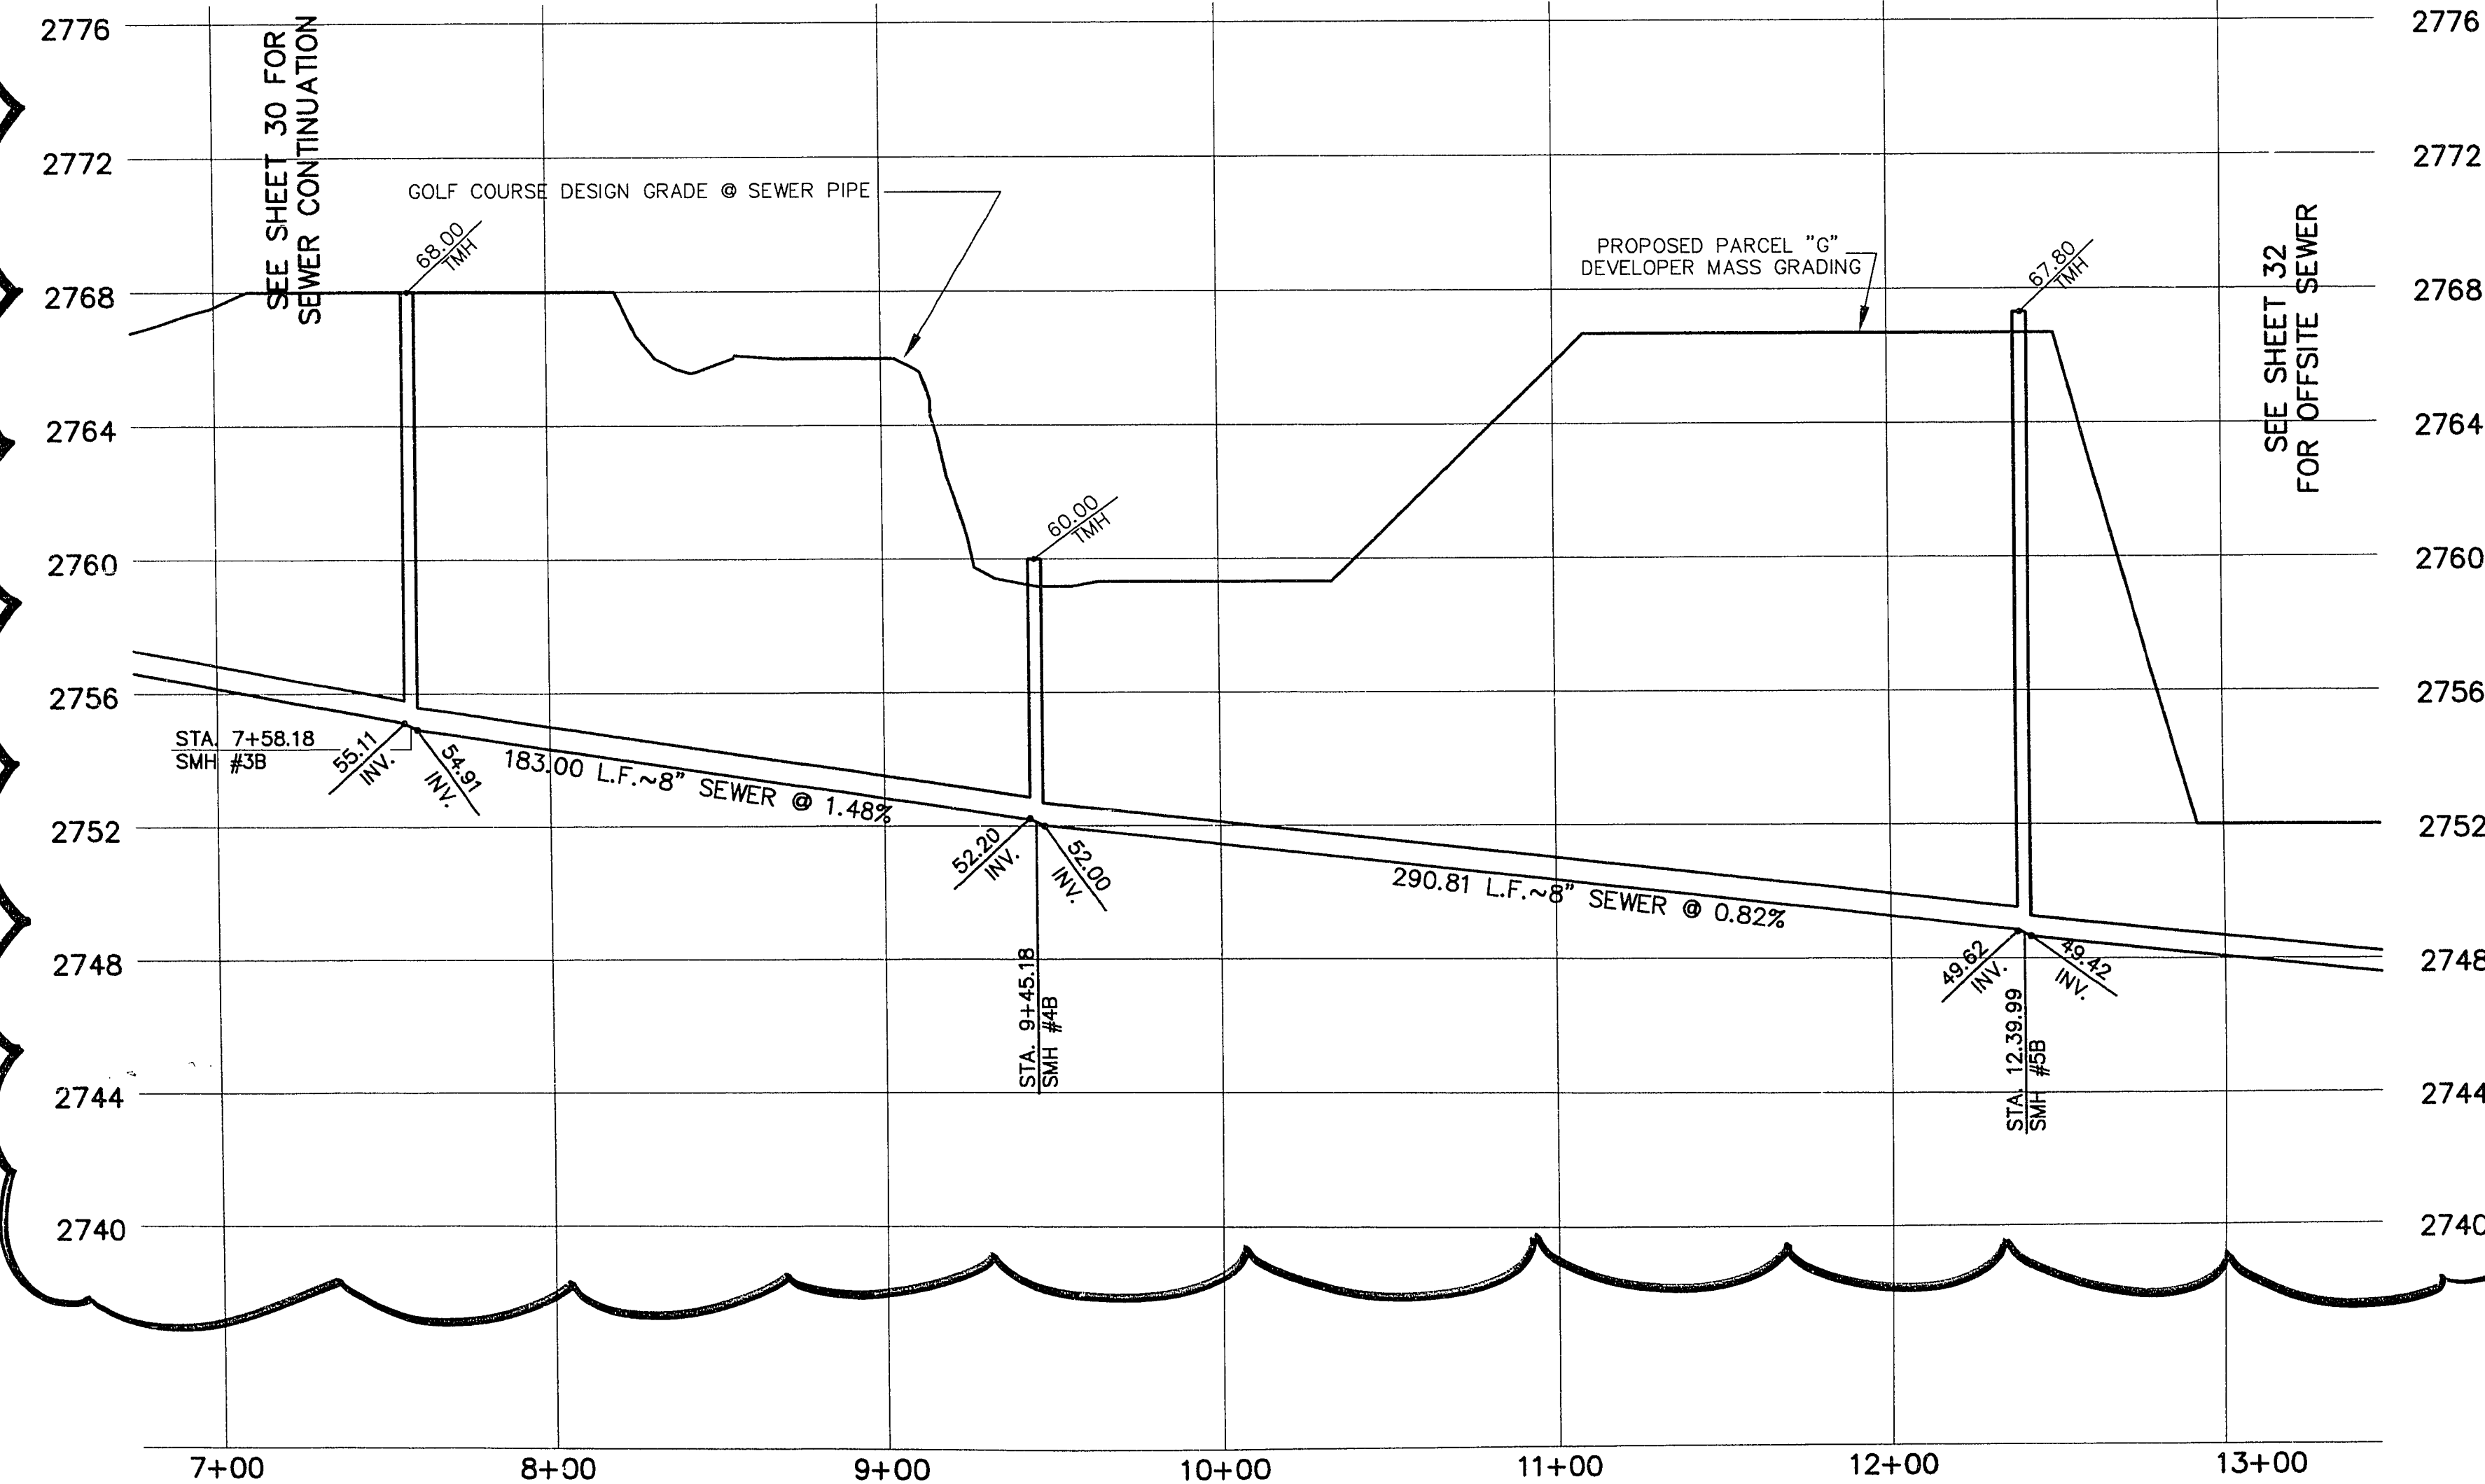


MATCH LINE SEE SHEET 30

MATCH LINE SEE SHEET 32

CURVE	DELTA	RADIUS	LENGTH	TANGENT
1	108°42'53"	50.00'	94.87'	69.73'
2	48°50'28"	100.00'	85.24'	45.41'
3	38°05'54"	150.00'	99.73'	51.79'

LINE	BEARING	DISTANCE
L1	N85°32'25"E	46.78'
L2	N49°42'48"W	1263.82'
L3	N47°28'51"E	149.81'

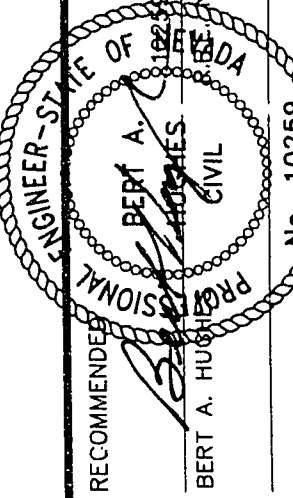

RECOMMENDED BY
Professional Engineer
Civil
No. 10259
STATE OF NEVADA

SUMMERLIN
VILLAGE 3 ROUGH GRADING
UTILITY SERVICE EXTENSION
PROFILES

SHEET
31
SHT 31 OF 47

1555 SOUTH RANCHO BLVD./LAS VEGAS, NEVADA 89030
G.C. WALLACE, INC.
Engineering/Architecture

REV	DATE	DESCRIPTION
1	12/14/95	REV SEWER ALIGN. ADD FENCE NOTE
2	12/14/95	REV SEWER ALIGN. ADD FENCE NOTE

24-2-11E

107-V2355