
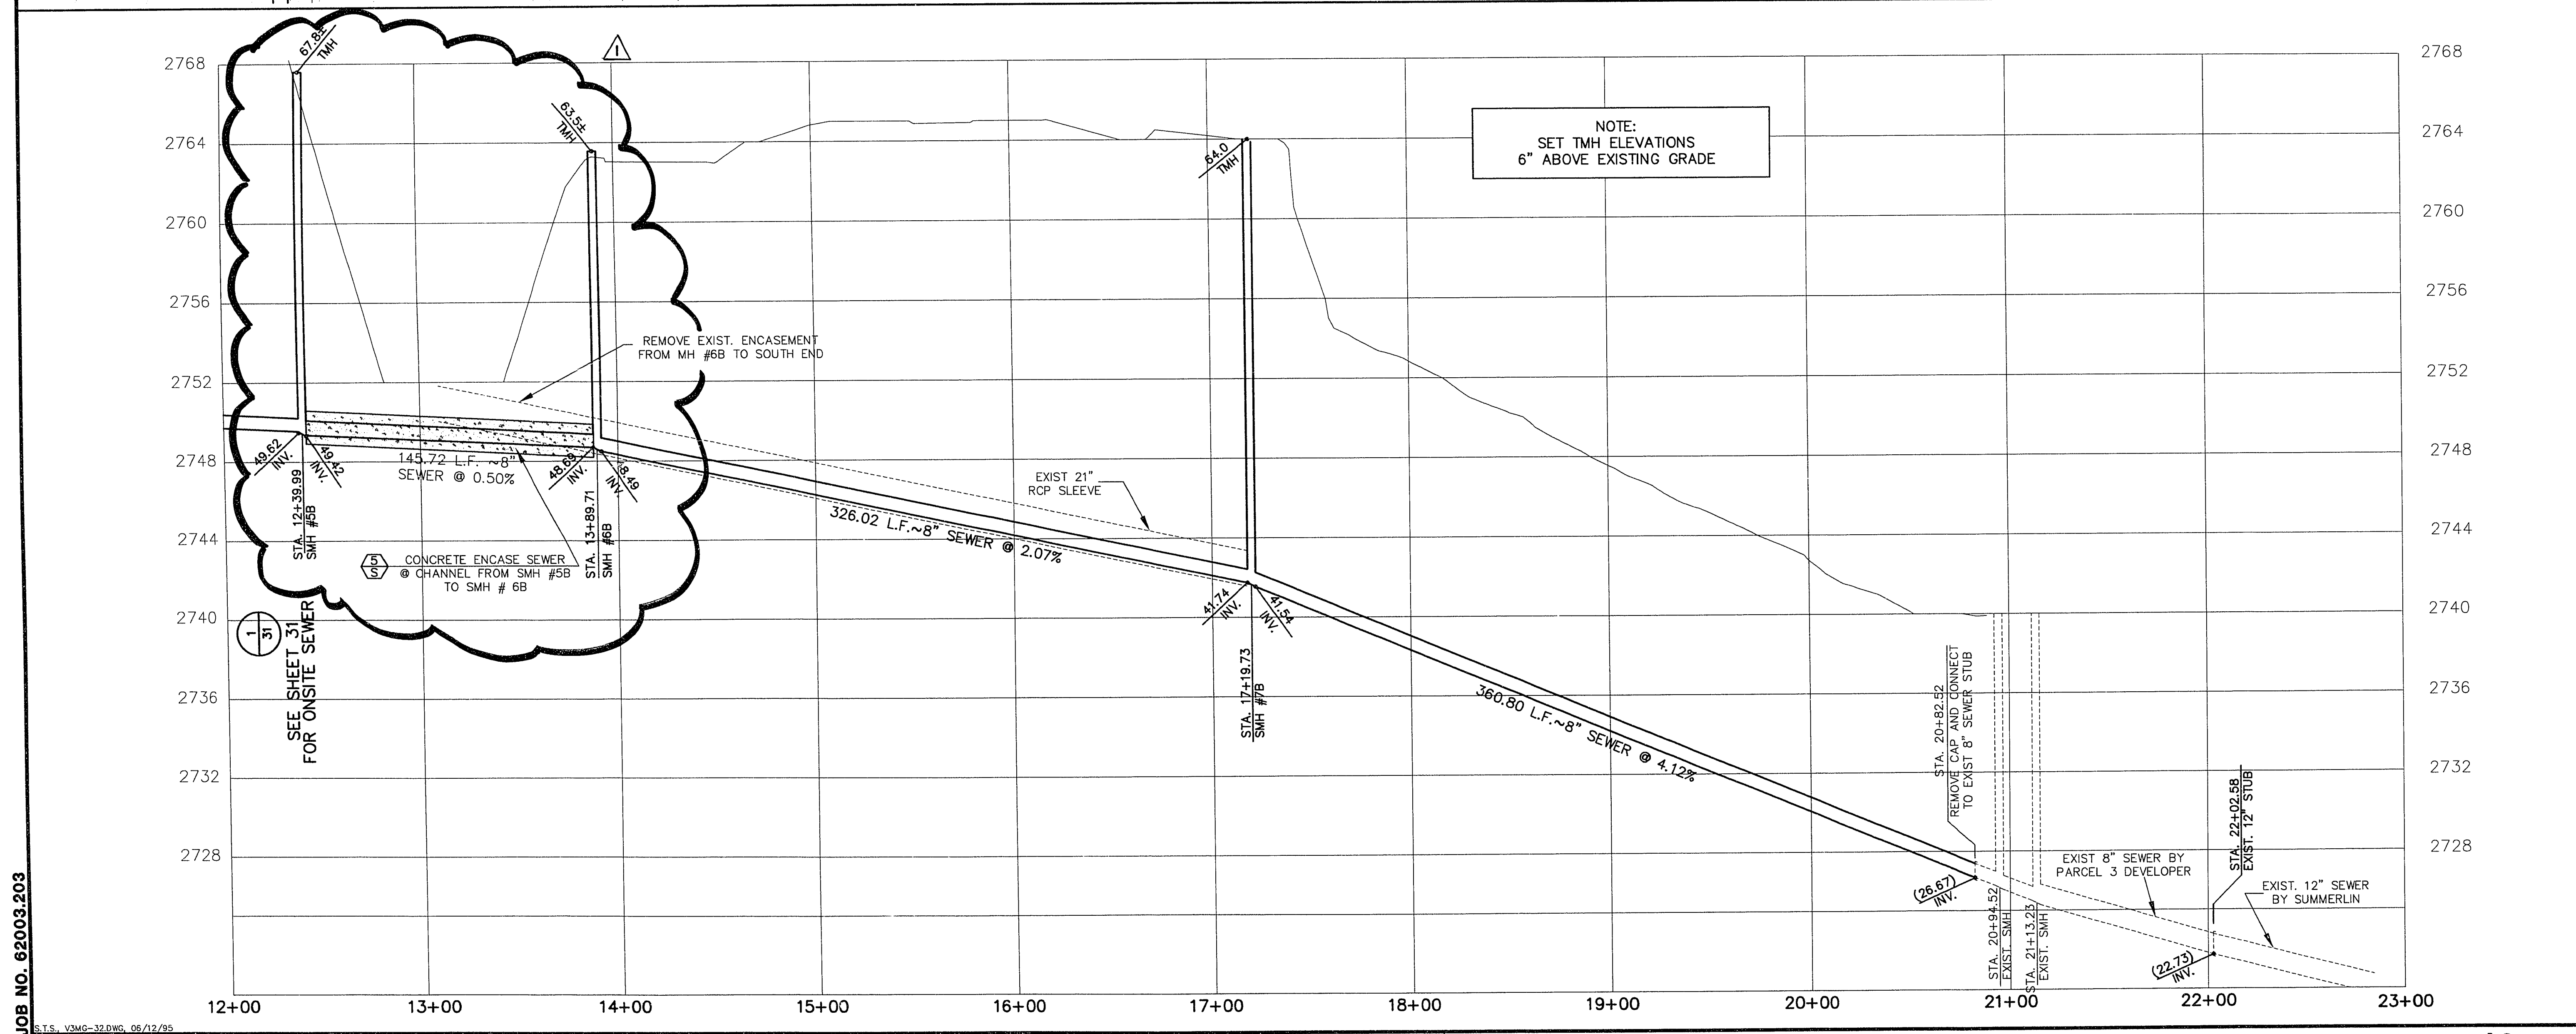


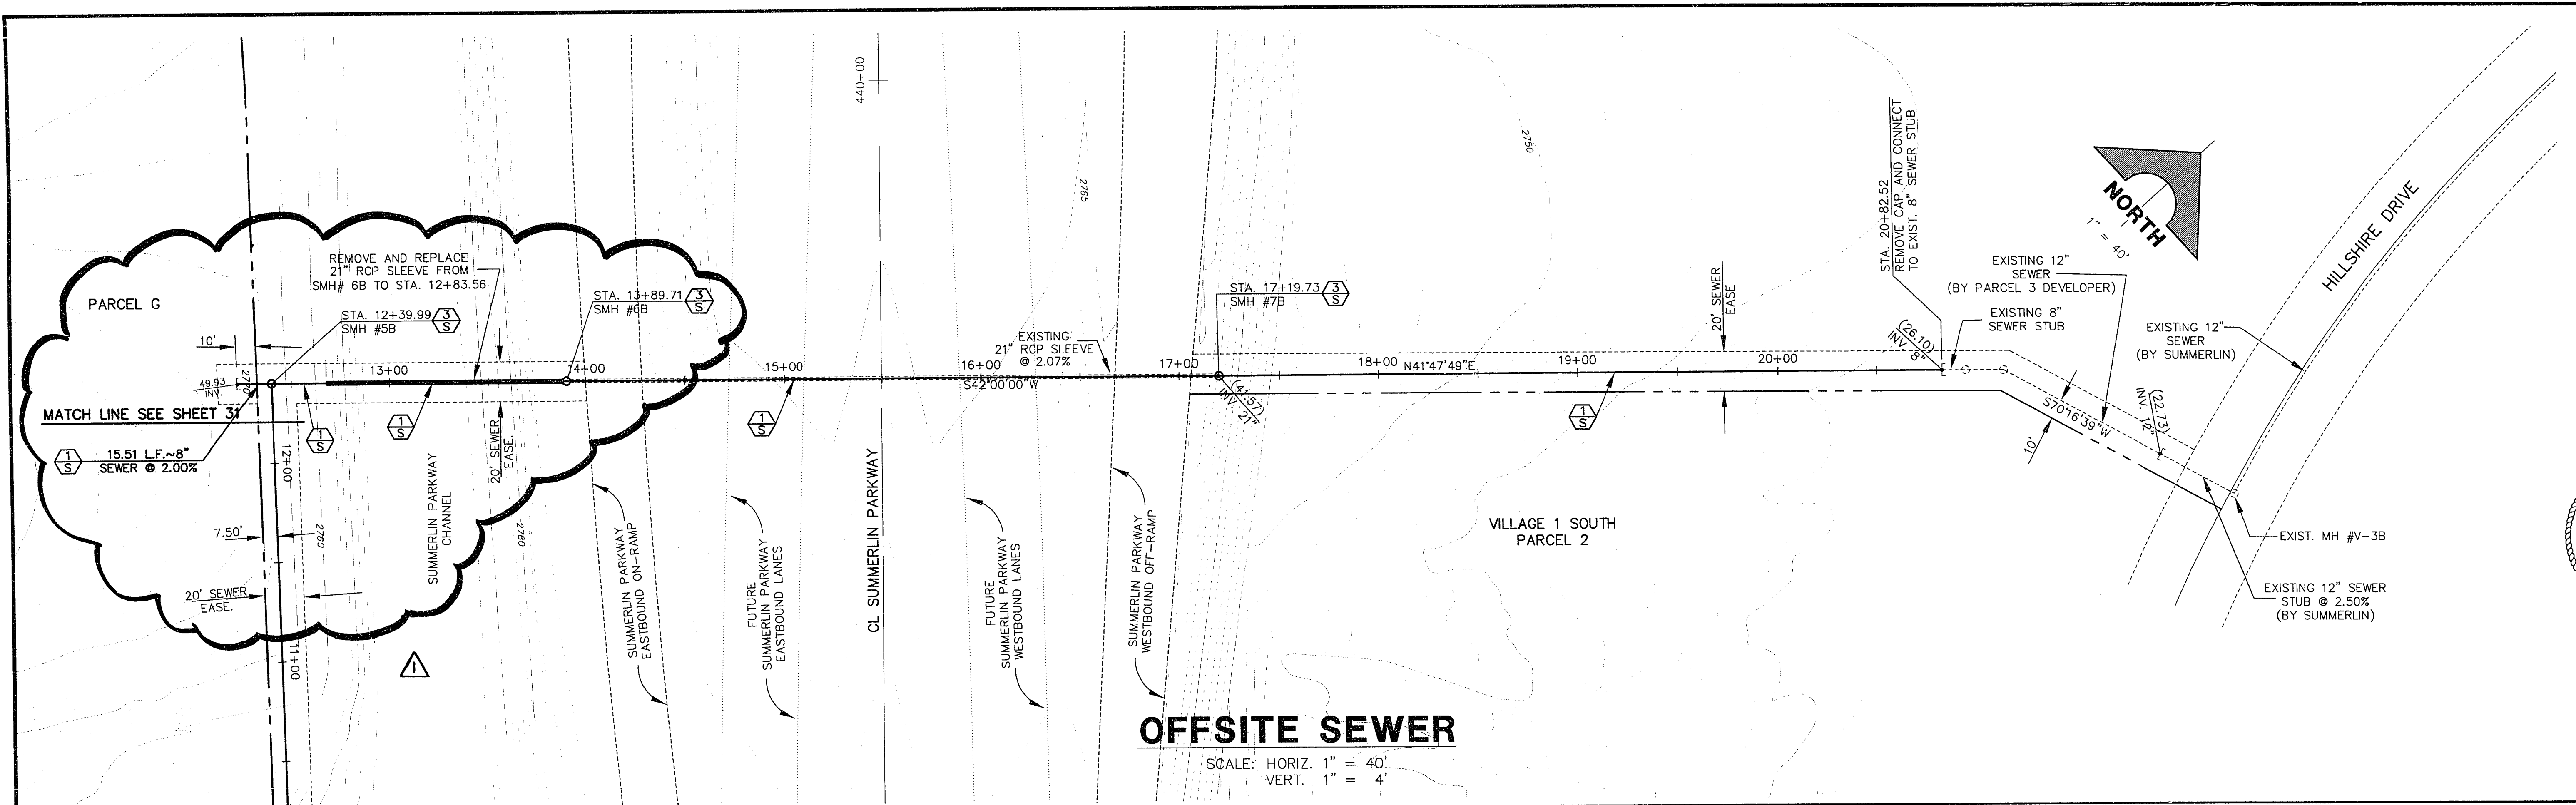

JOB NO. 62003.203

S.T.S. V3MG-32.DWG, 06/12/95

		RECOMMENDED BY BEST A. WALLACE, INC. CIVIL ENGINEER No. 10259	DATE 07/10/95	REV. SEWER ALIGN DESCRIPTION DATE 12/14/95	APPROVAL DATE 12/14/95
SUMMERLIN VILLAGE 3 ROUGH GRADING UTILITY SERVICE EXTENSION PROFILE					
SHEET 32 SHT 32 OF 47					

24-8-106

107-V2355