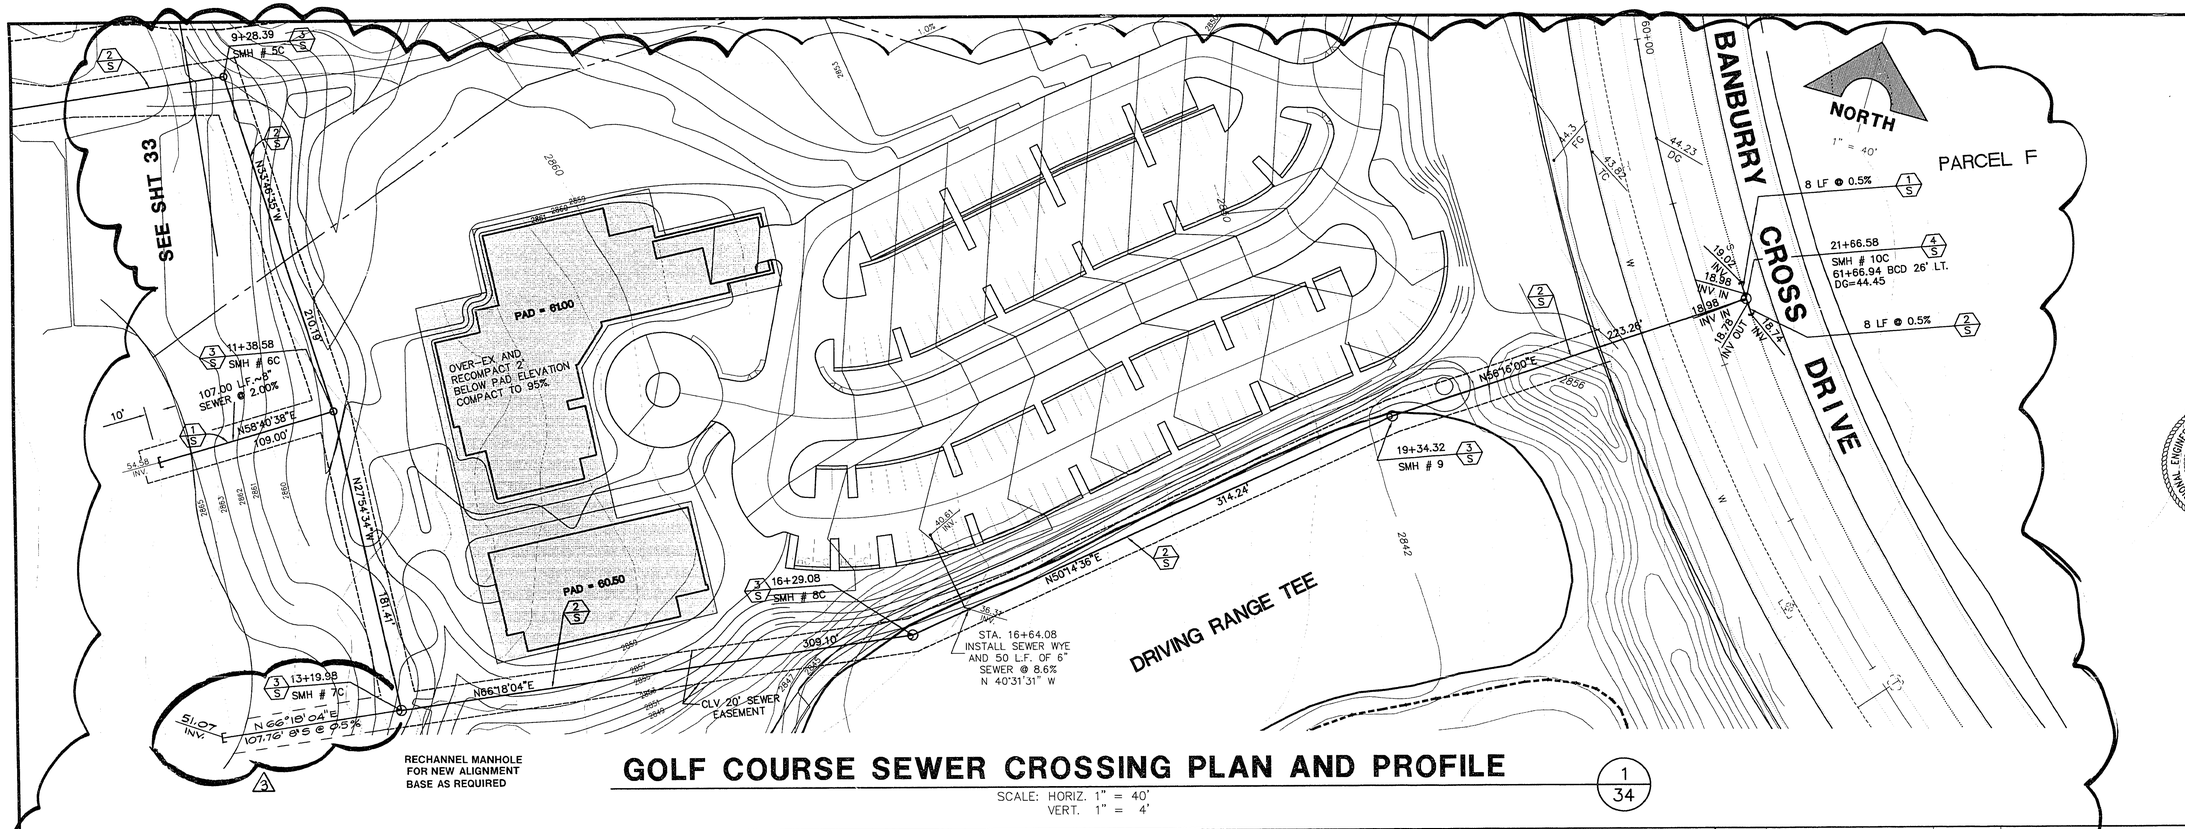

RECHANNEL MANHOLE FOR NEW ALIGNMENT BASE AS REQUIRED

GOLF COURSE SEWER CROSSING PLAN AND PROFILE

1
34

SCALE: HORIZ. 1" = 40'
VERT. 1" = 4'

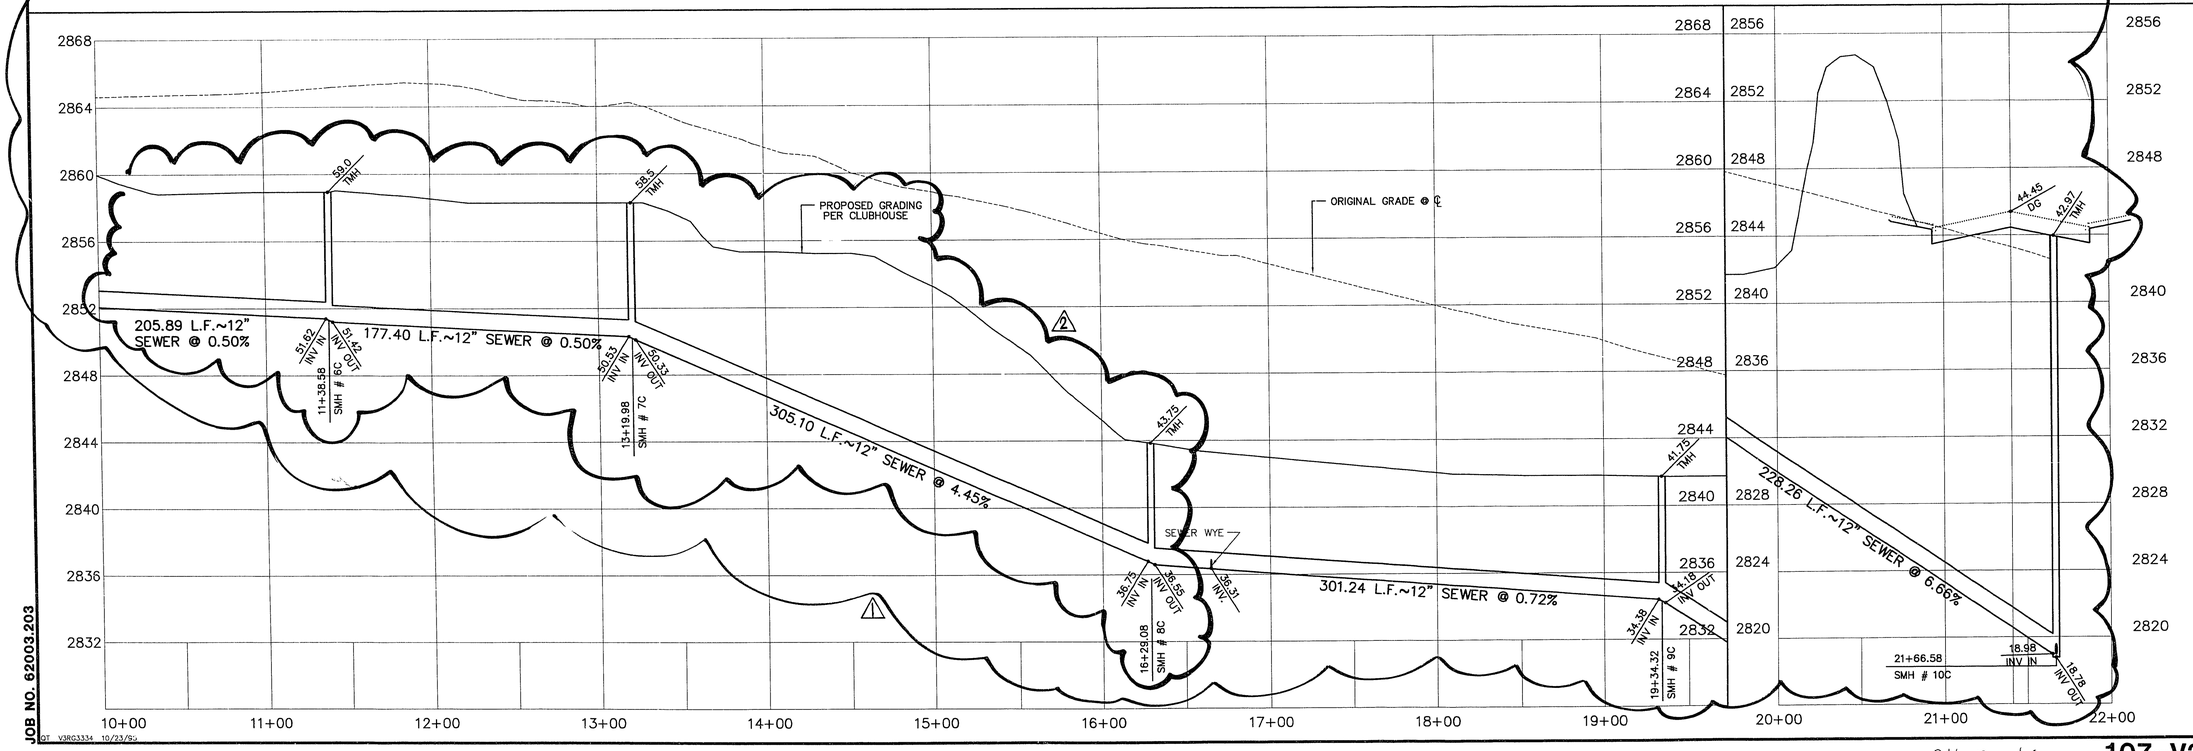

JOB NO. 62003.203

REV.	DATE	DESCRIPTION	APPROVAL
1	07/10/95	REV. CLUBHOUSE SITE, SEWER ALIGN.	12/4/95
2	10/24/95	REVISE SEWER	12/4/95
3	01/12/96	ADD SEWER LATERAL	2/21/96

RECOMMENDED: BERT A. HUCHEE, PROFESSIONAL ENGINEER, STATE OF NEVADA, REG. NO. 8916
BERT A. HUCHEE 12/21/95

G.C. WALLACE, INC.
Engineering/Architecture 1555 SOUTH RAINBOW BLVD./LAS VEGAS, NEVADA 89102

SUMMERLIN
VILLAGE 3 ROUGH GRADING
UTILITY PLAN & PROFILE
HOLE # 18 SEWER

SHEET 34
SHT 34 OF 47

24-2-NA

107-V2355