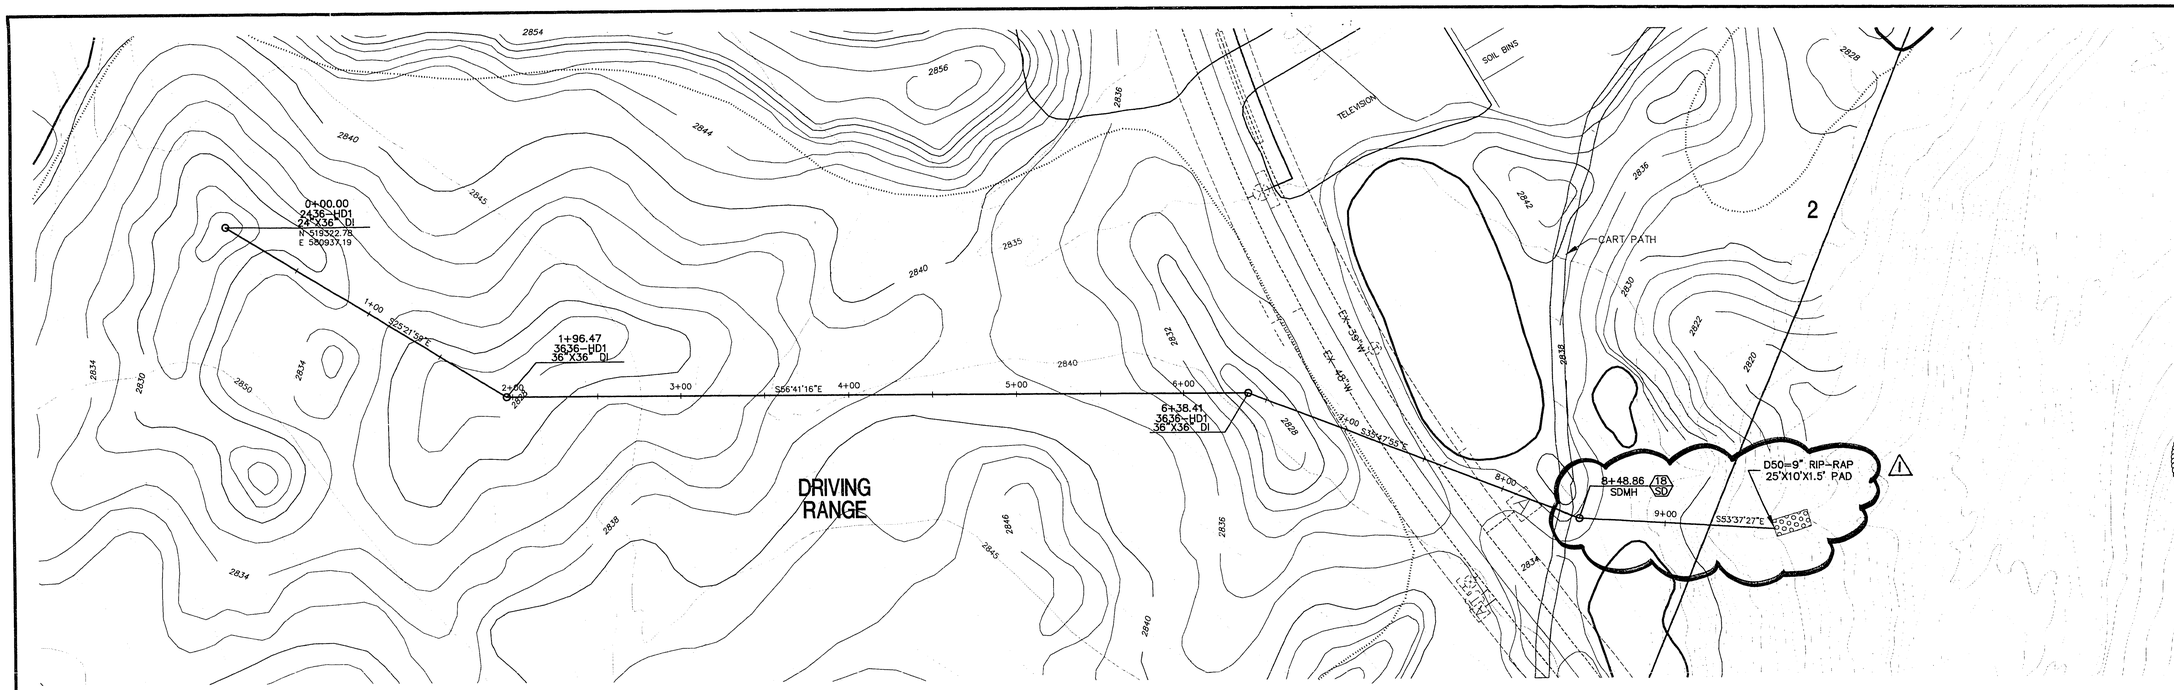

GOLF COURSE STORM DRAIN CROSSING

PRIVATE STORM DRAIN SYSTEM TO BE PRIVATELY OWNED AND MAINTAINED.

SCALE: HORIZ. 1" = 40'
VERT. 1" = 4'

PRIVATE SYSTEM

1/35

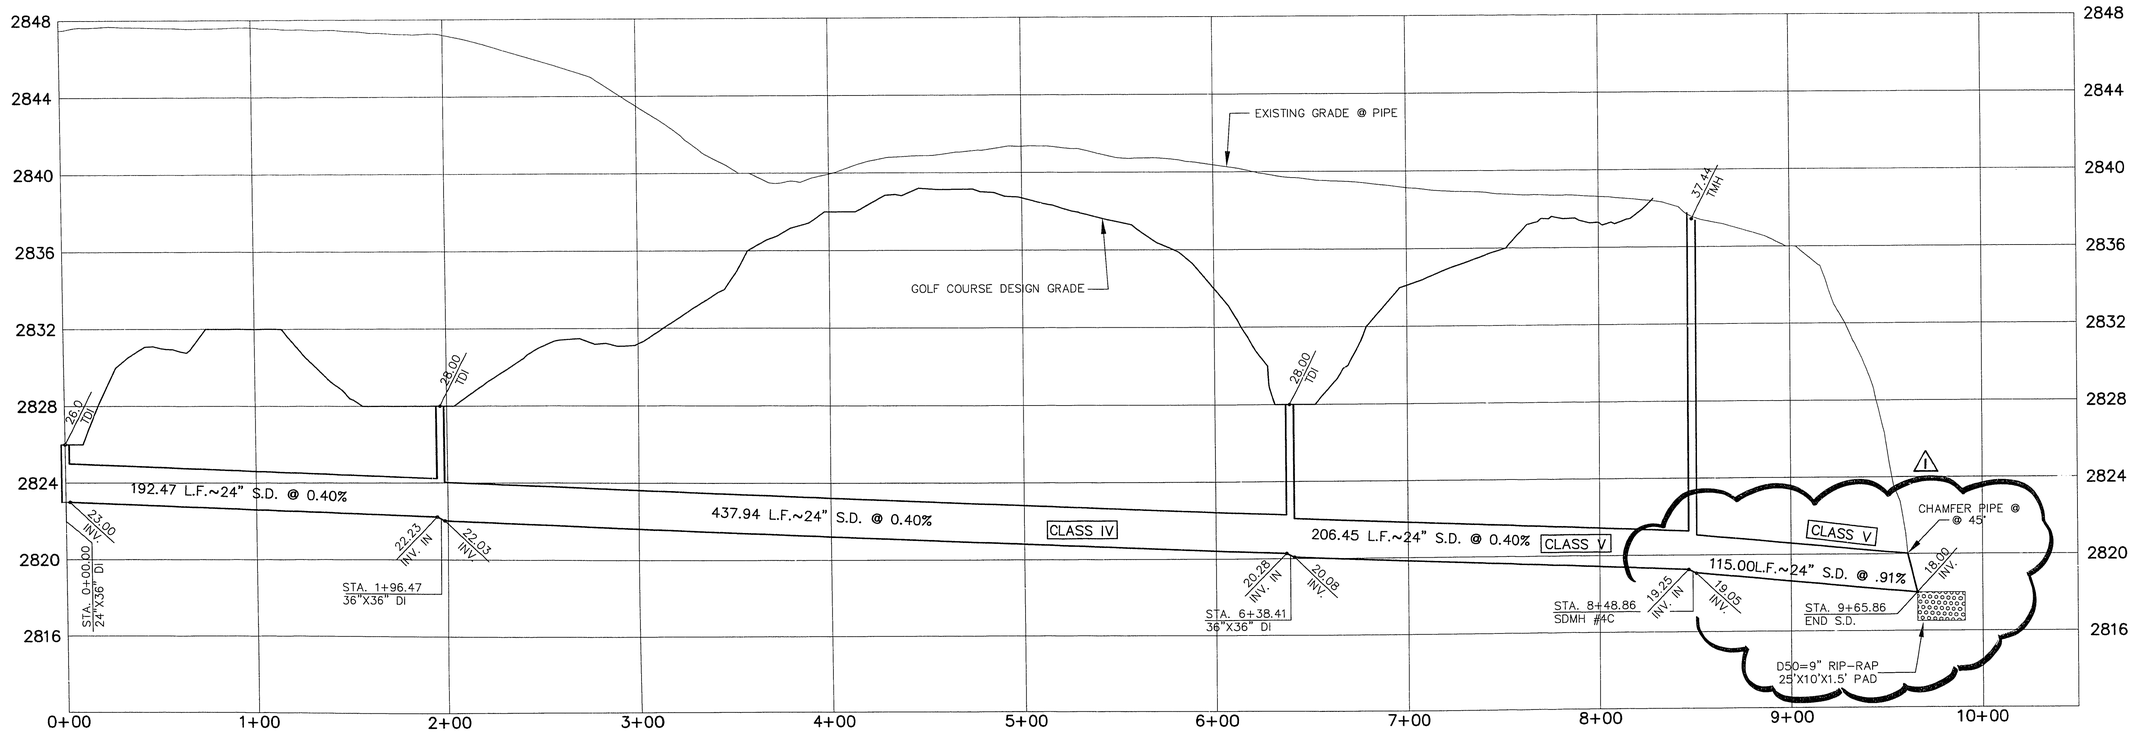

JOB NO. 62003.203

S.T.S. V3MG-35.DWG 08/04/95

REV.	DATE	DESCRIPTION	APPROVAL
1	07/10/95	REV. SD ALIGN AT OUTFALL	12/14/95

RECOMMENDED BY: BERT A. HUGHES, CIVIL, No. 10259 — DATE 10/25/95

PROFESSIONAL ENGINEER — STATE OF NEVADA

G.C. WALLACE, INC.
Engineering/Architecture 1555 SOUTH RAINBOW BLVD/LAS VEGAS, NEVADA 89102

SUMMERLIN
VILLAGE 3 ROUGH GRADING
UTILITY SERVICE EXTENSION
PROFILE

SHEET 35
SHT 35 OF 47

24-2-116

107-V2355