


GOLF COURSE STORM DRAIN CROSSING PLAN AND PROFILE


PRIVATE STORM DRAIN SYSTEM TO BE PRIVATELY OWNED AND MAINTAINED (12" S.D. ONLY) SCALE: HORIZ. 1" = 40' VERT. 1" = 4'

1
29

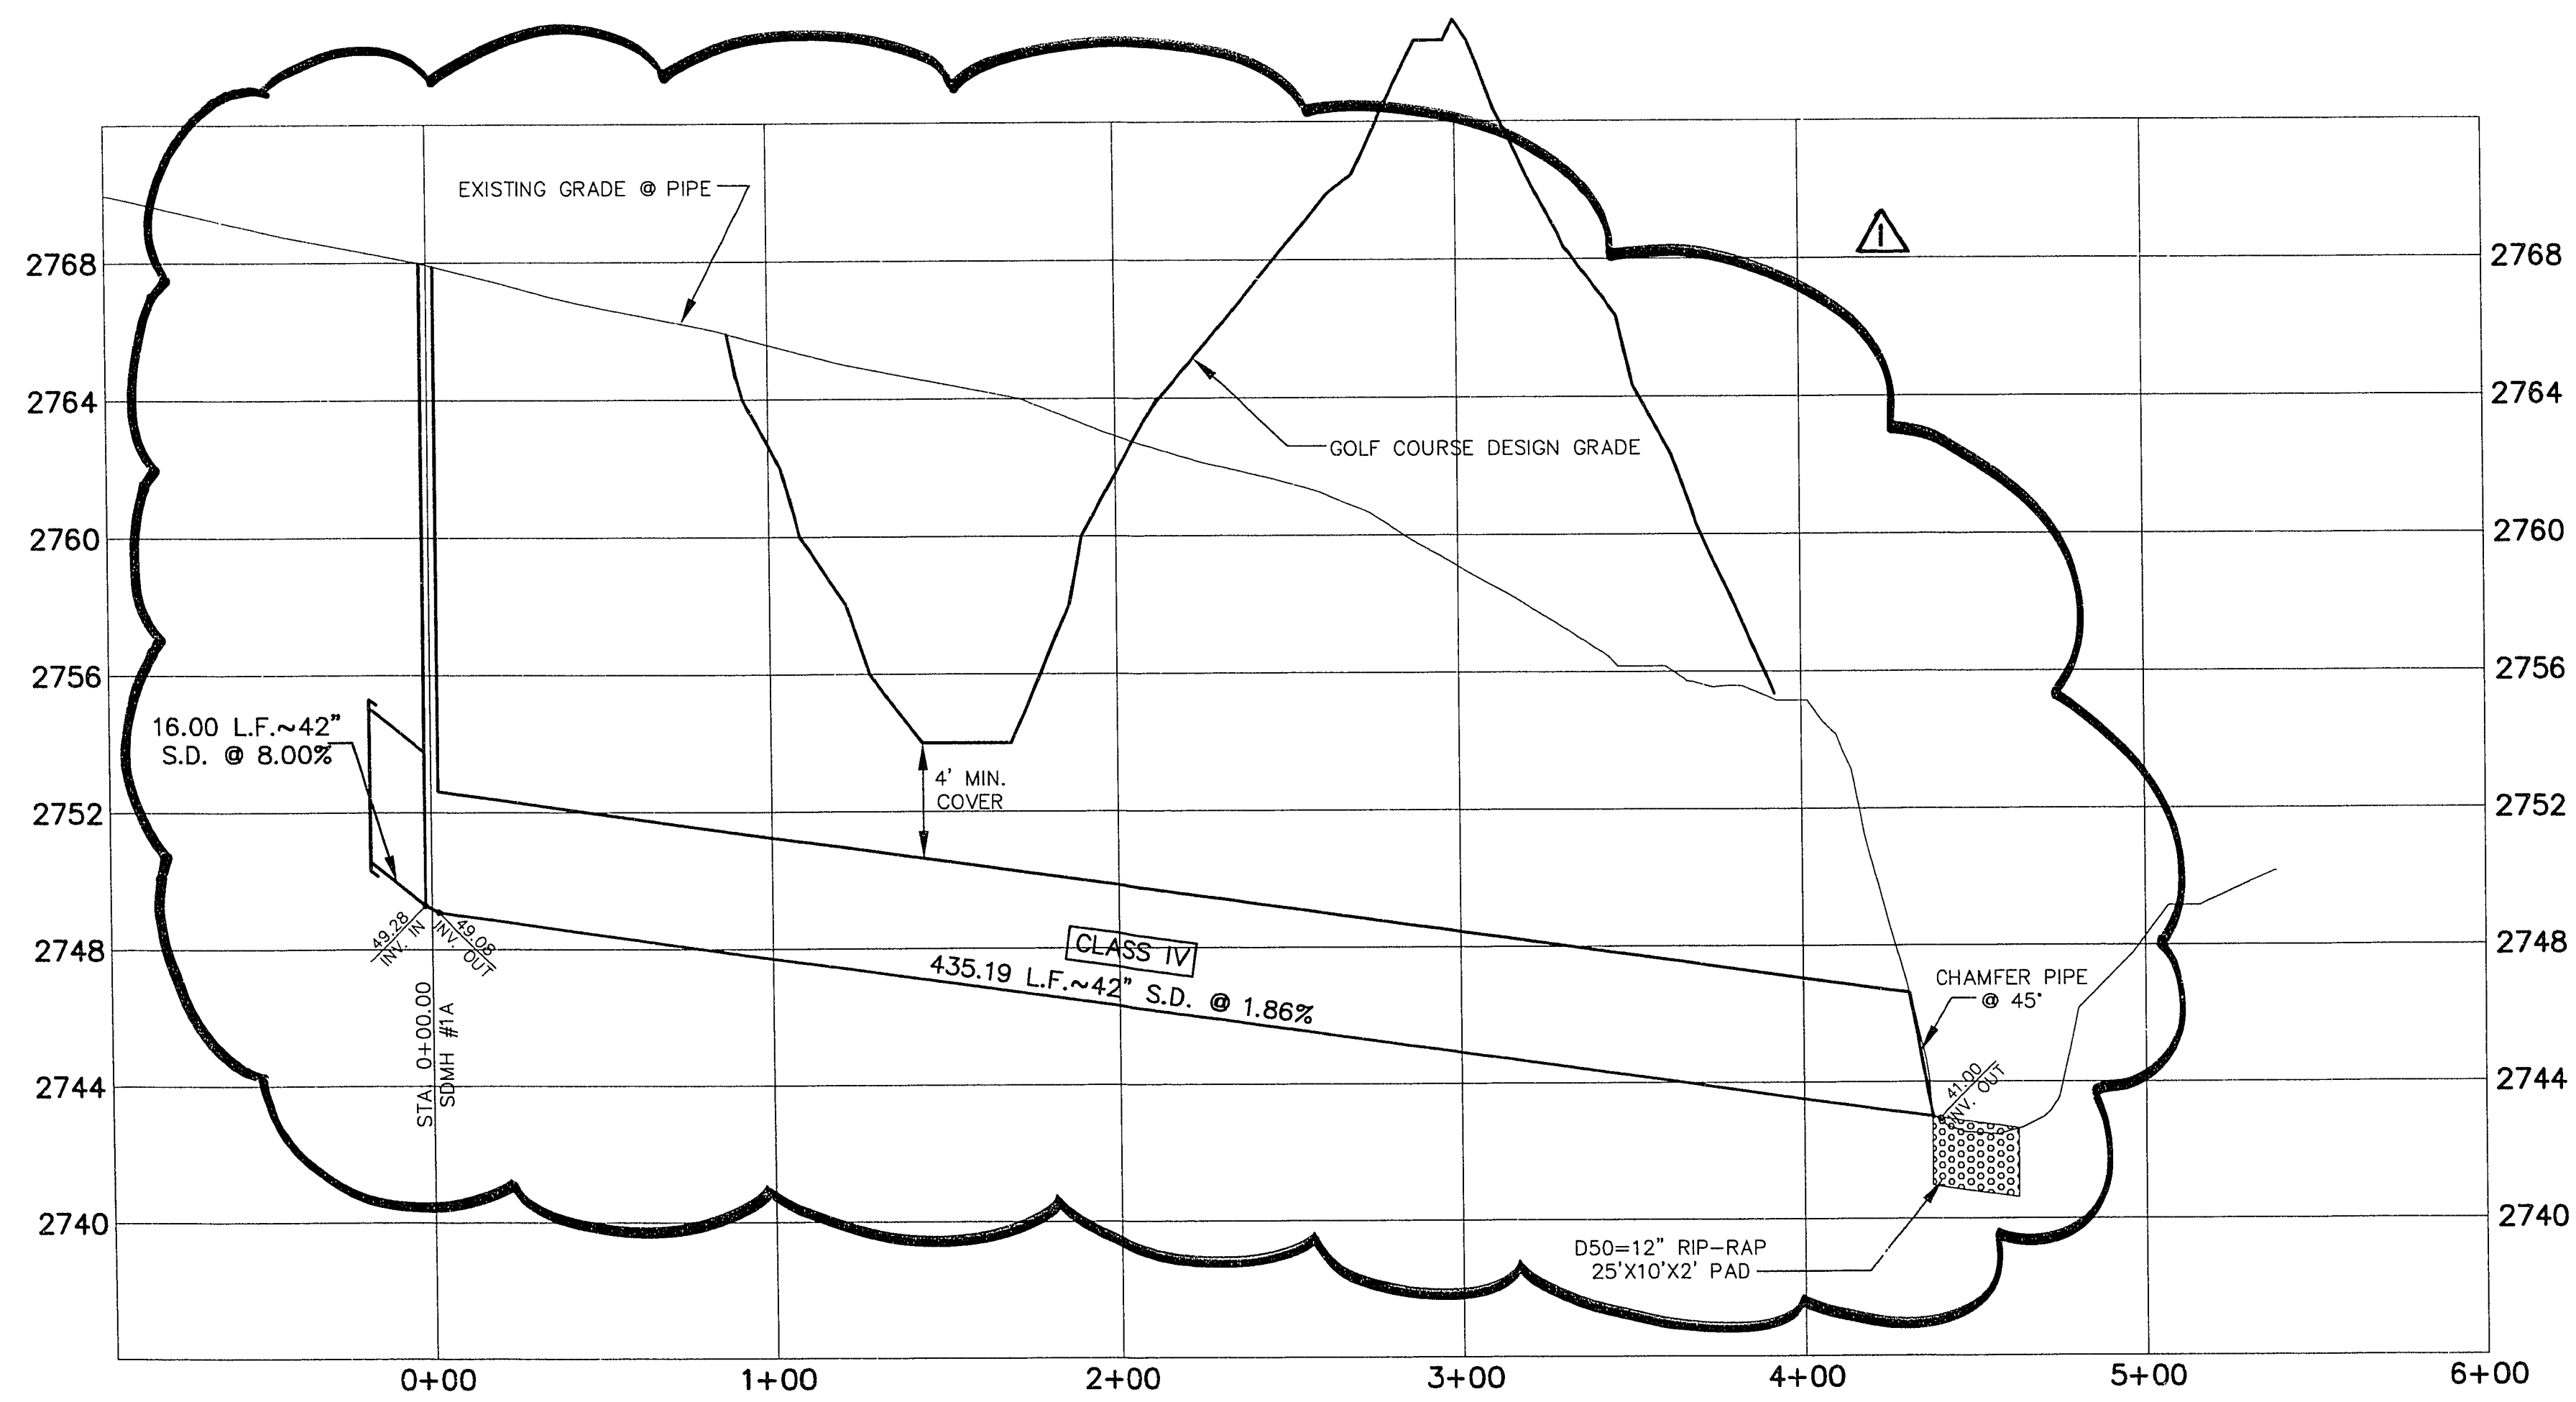

JOB NO. 62003.203

ETS, VMG-29.DWG, 08/04/05

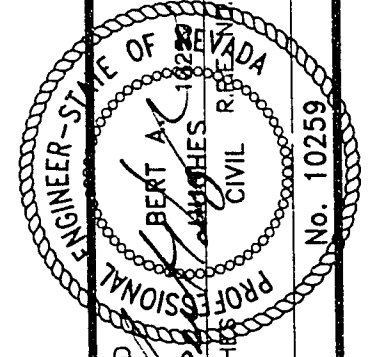

RECOMMENDED BY: BERY A. HUGHES, CIVIL ENGINEER, No. 10259

G. C. WALLACE, INC. Engineering/Architecture
1955 SOUTH RANNEY BLVD., LAS VEGAS, NEVADA 89108

SUMMERLIN VILLAGE 3 ROUGH GRADING UTILITY SERVICE EXTENSION PROFILES

SHEET 29 OF 47

24-3-143

107-V2355