




GOLF COURSE STORM DRAIN CROSSING PLAN AND PROFILE 1/28

SCALE: HORIZ. 1" = 40'
VERT. 1" = 4'

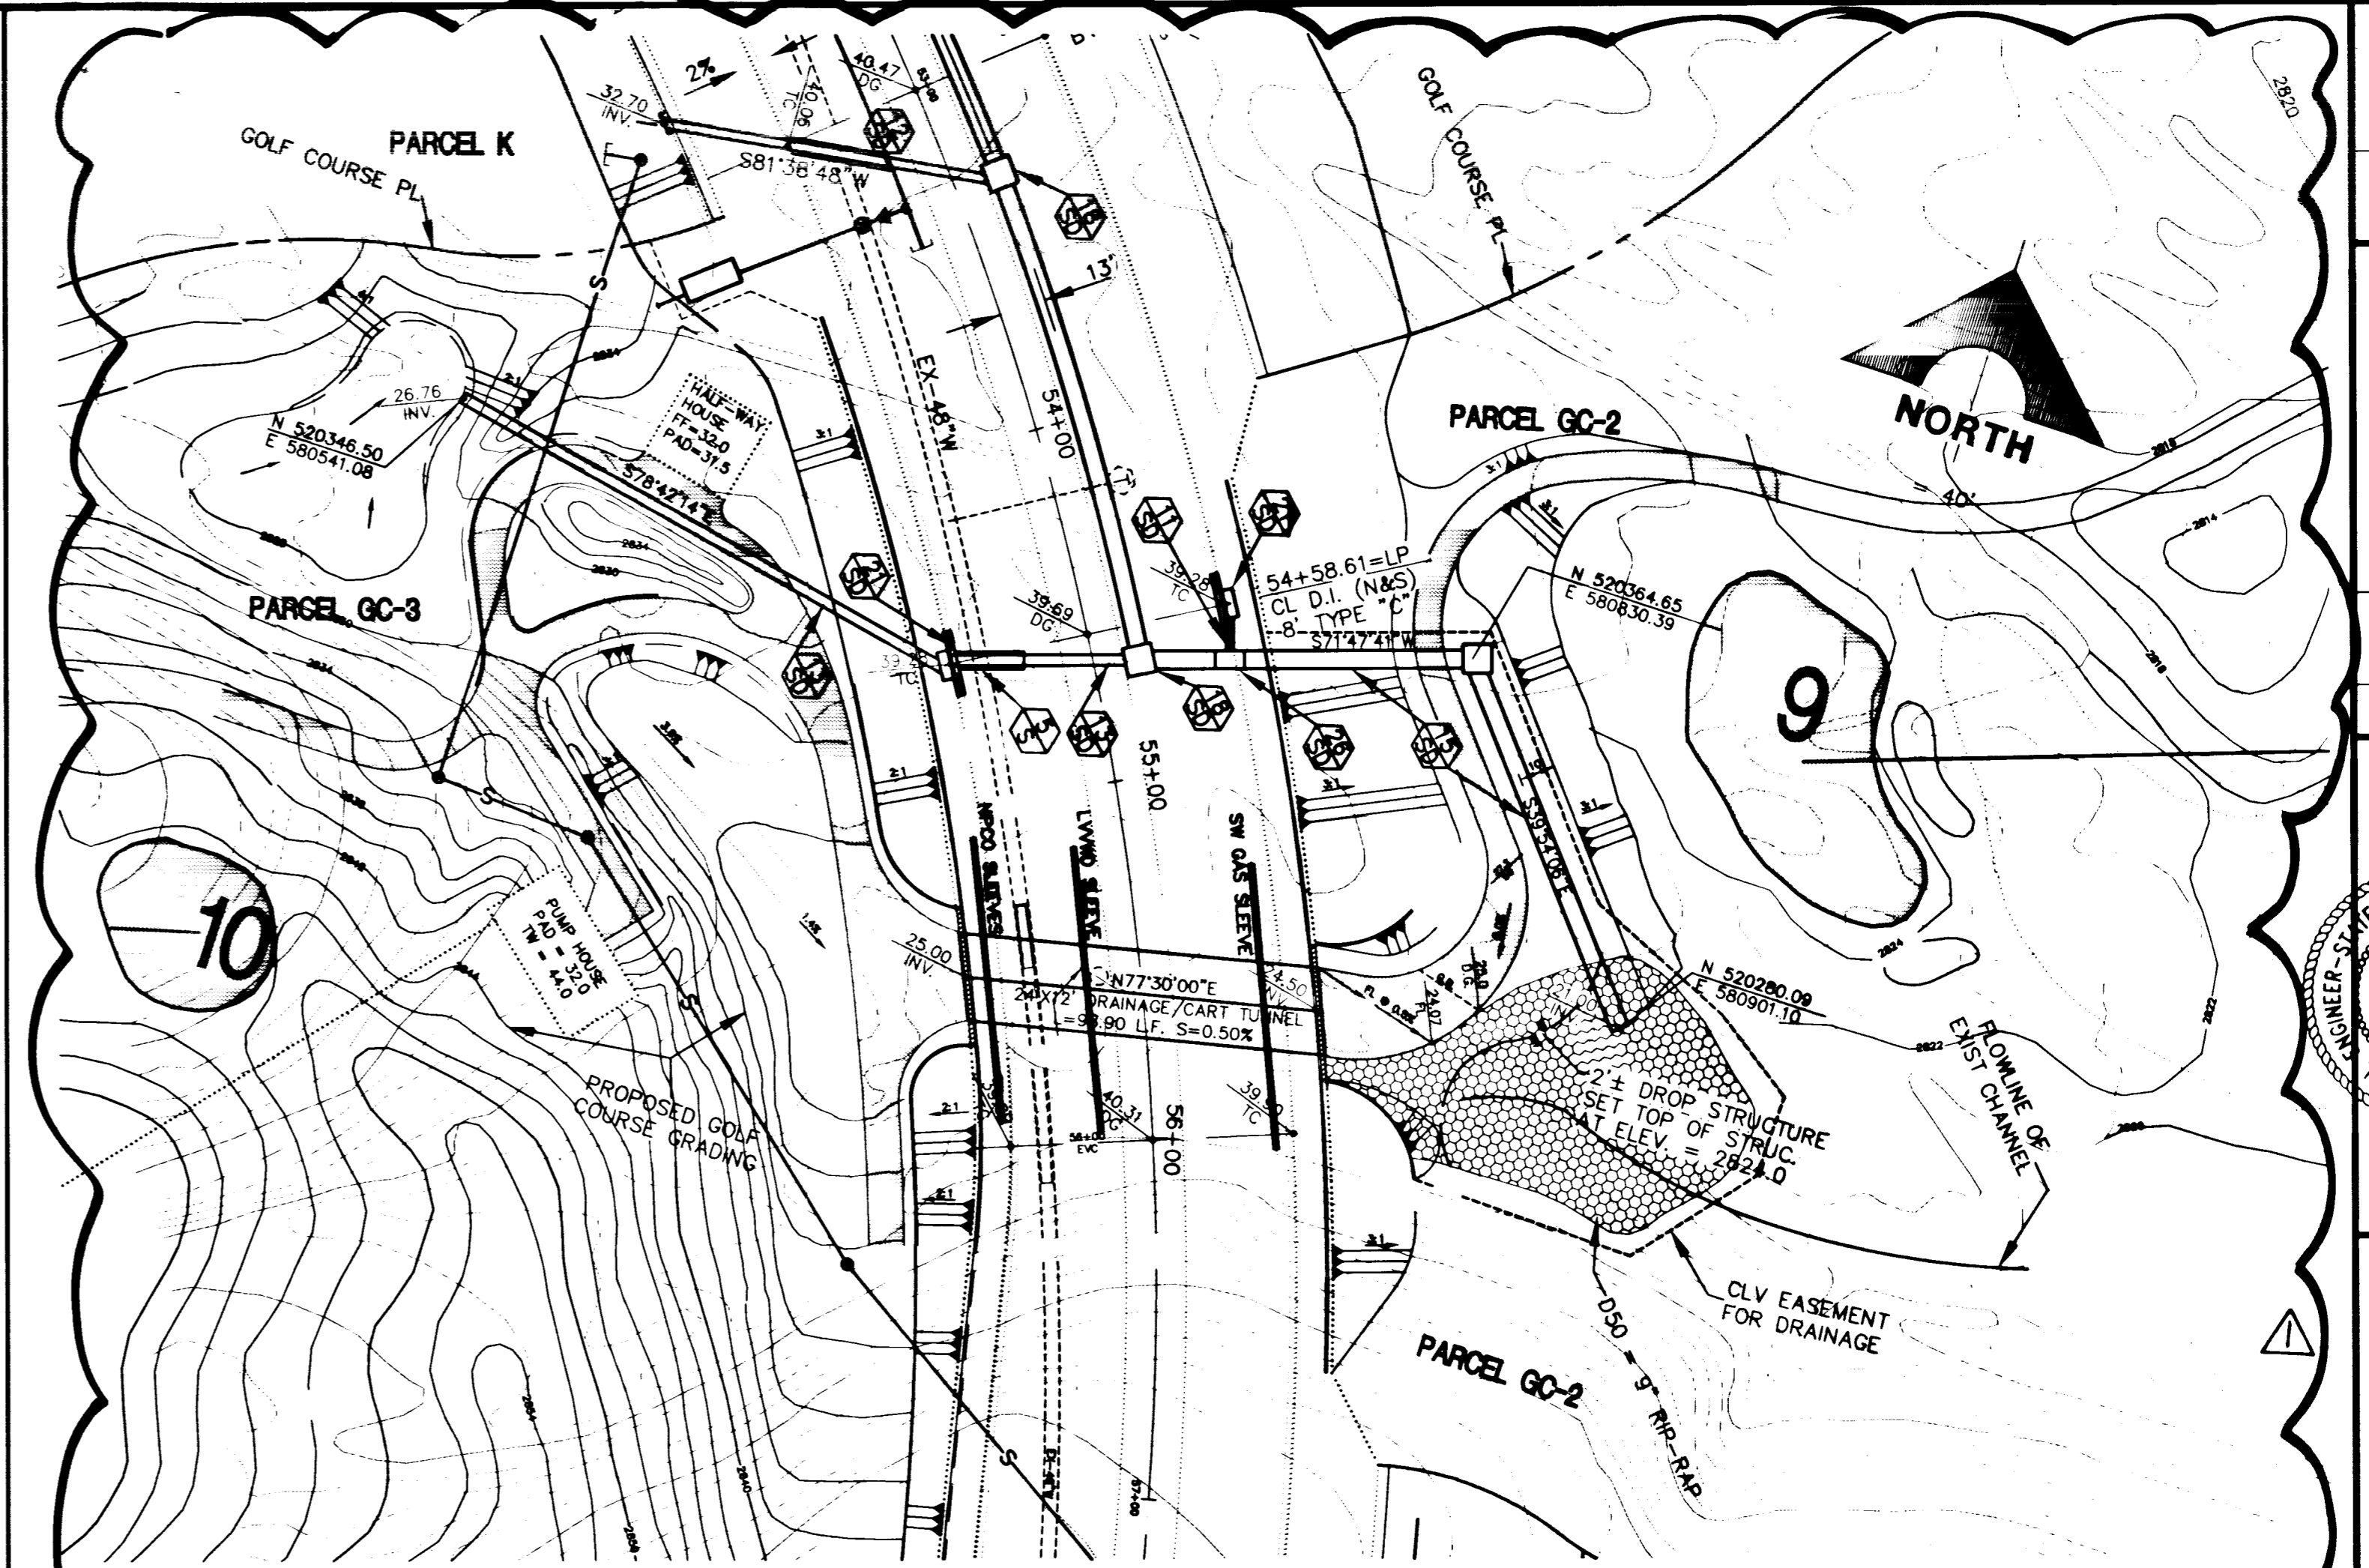

STORM DRAIN OUTLET DETAIL @ B.C.D. STA. 54+68.61 2/28


SCALE: HORIZ. 1" = 40'
VERT. 1" = 4'

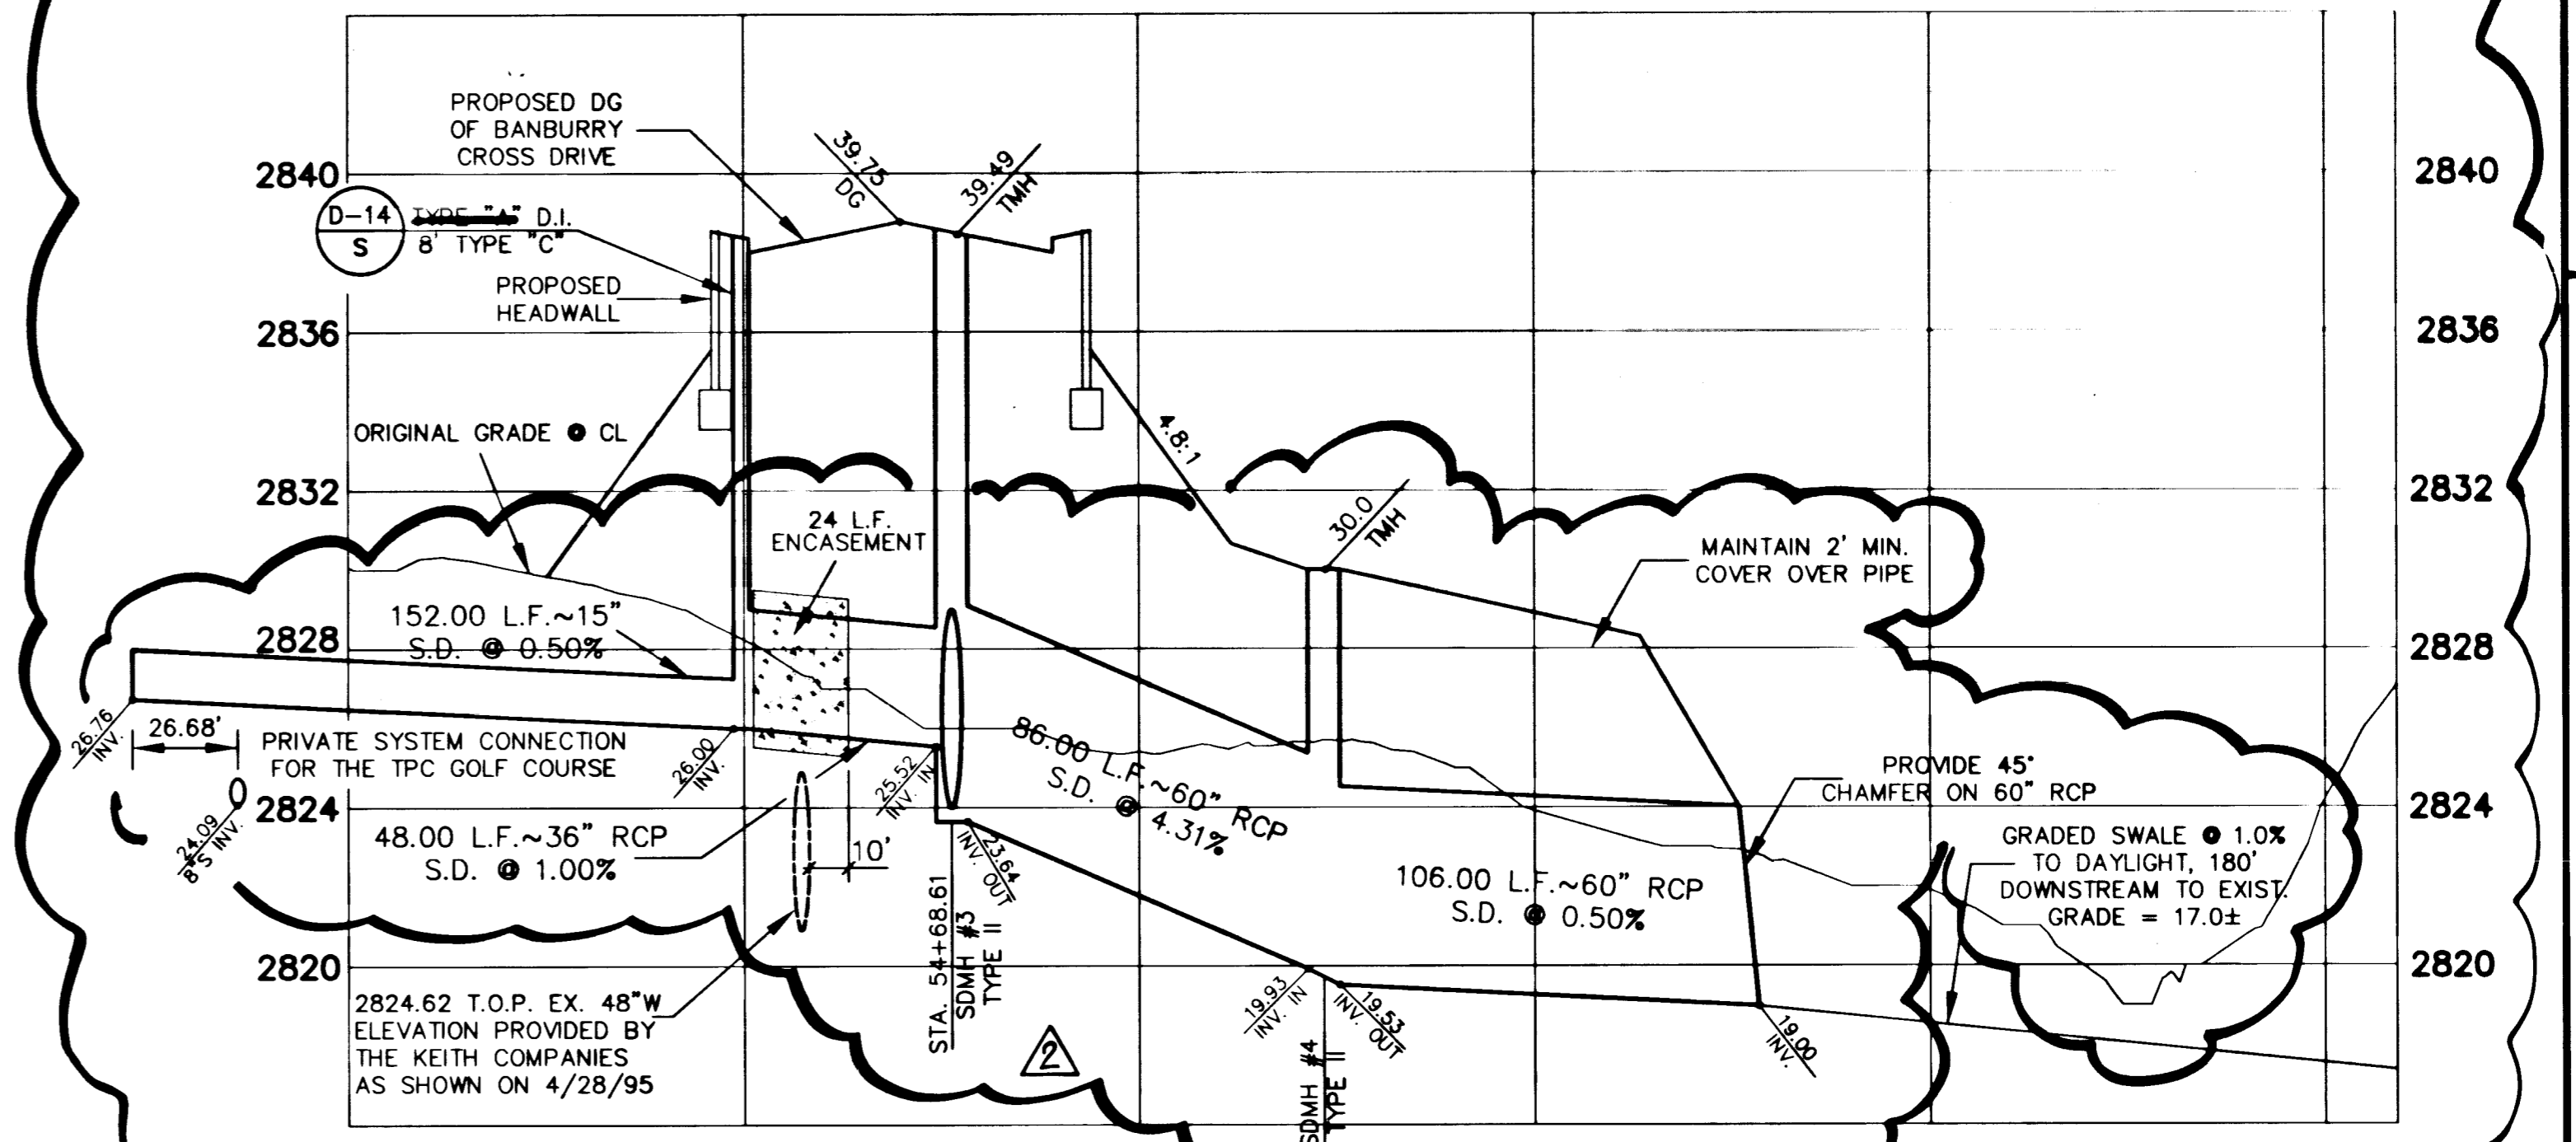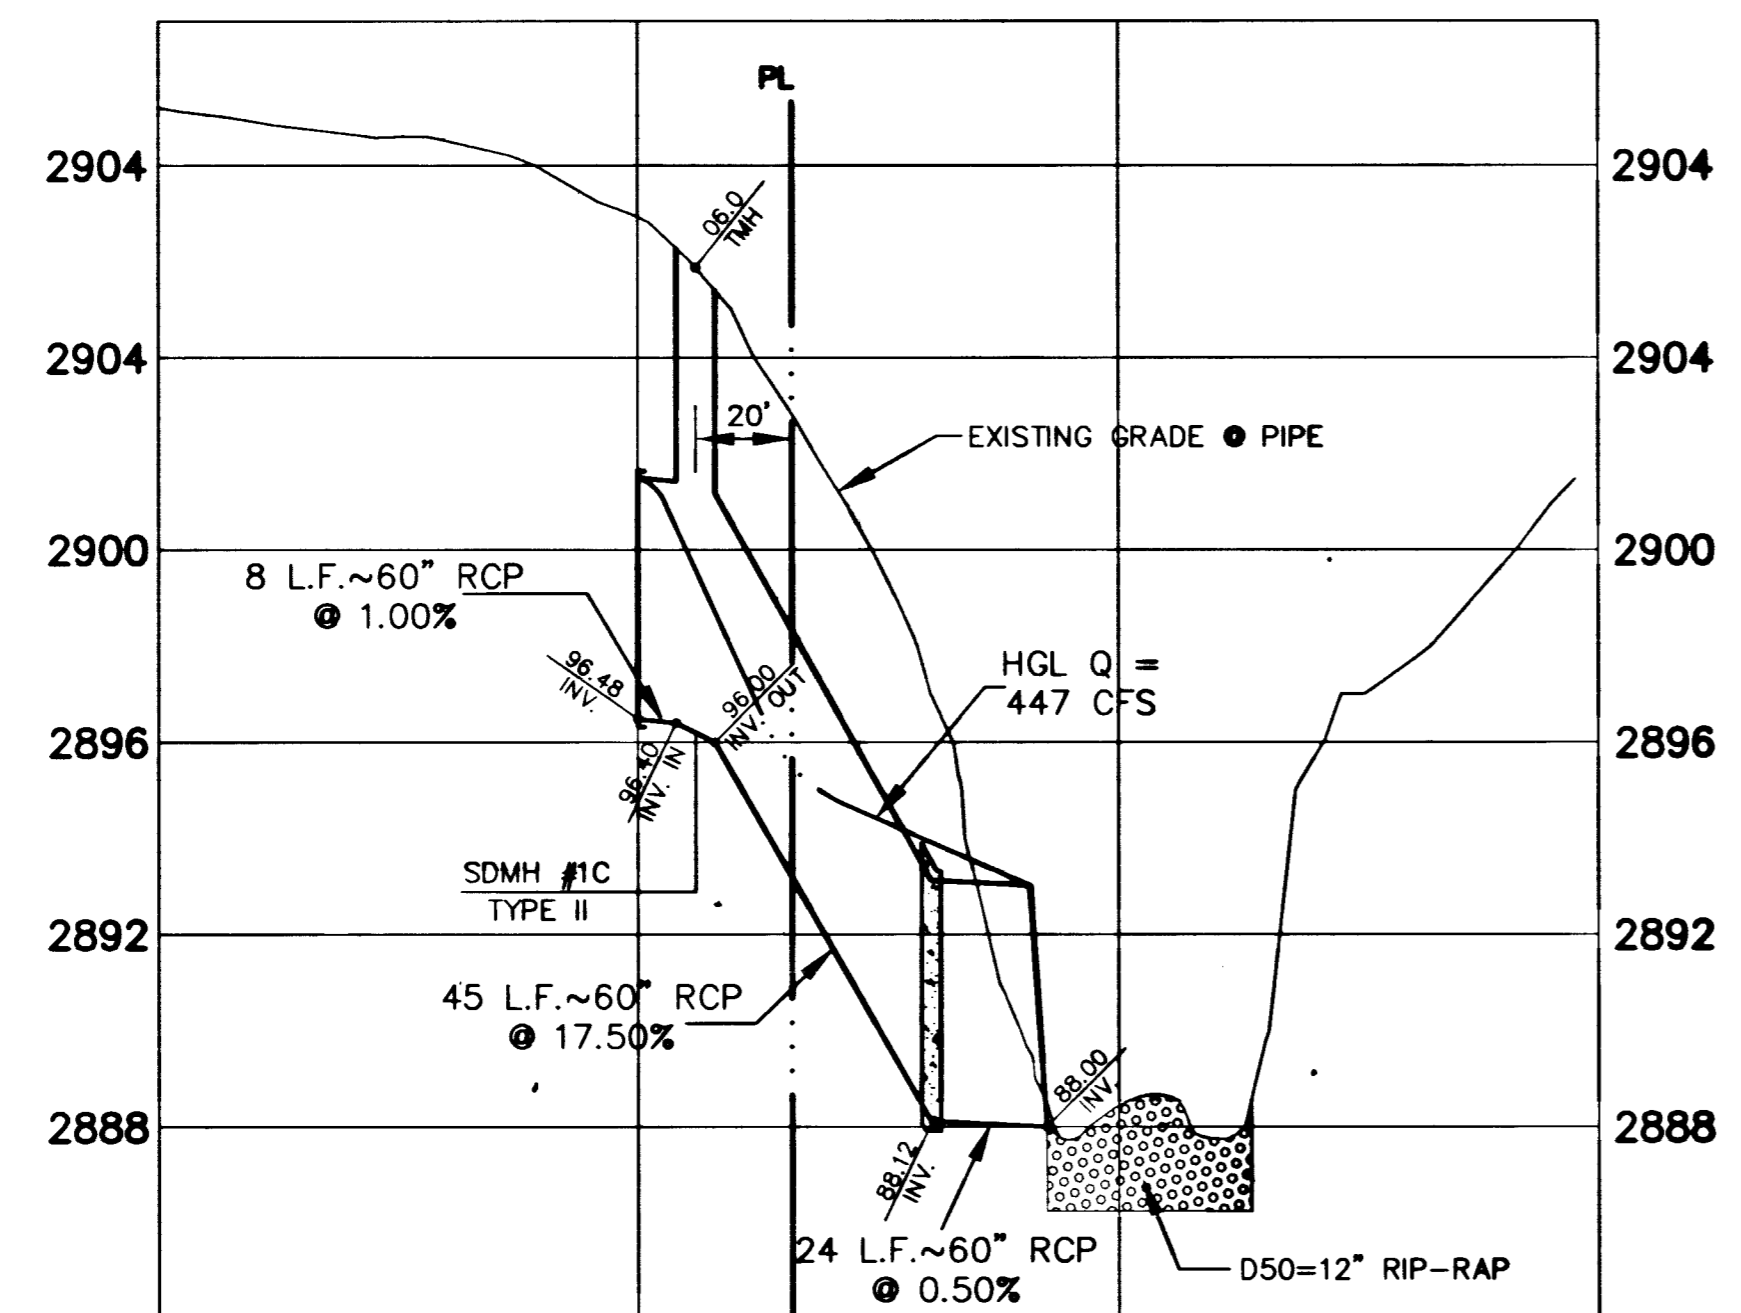

JOB NO. 62003.203


6.1.3, VMC-28.05, 10/24/95

RECOMMENDED BY: BERT A. WALLACE, INC. ENGINEERING/ARCHITECTURE
 1555 SOUTH RANCHO BLVD./LAS VEGAS, NEVADA 89102
 No. 102559
 APPROVED FOR CONSTRUCTION: [Signature]
 DATE: 4/19/95
 SHEET 28 OF 47
 SUMMERLIN VILLAGE 3 ROUGH GRADING UTILITY SERVICE EXTENSION PROFILES

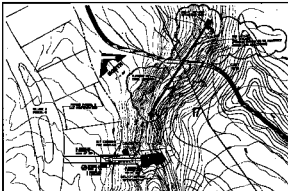



GOLF COURSE STORM DRAIN CROSSING PLAN AND PROFILE

SCALE: HORIZ. 1" = 50'
VERT. 1" = 5'

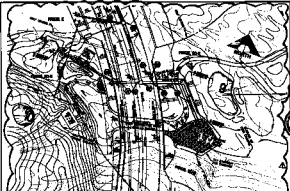

STORM DRAIN OUTLET DETAIL @ B.C.D. STA. 54+68.61

SCALE: HORIZ. 1" = 10'
VERT. 1" = 5'

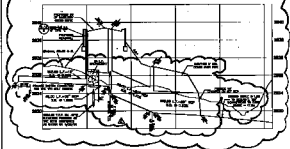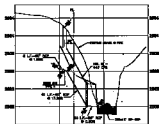

J. C. WALLACE, INC.

J. C. WALLACE, INC.
SURVEYING & ENGINEERING
TRAFFIC ENGINEERING