

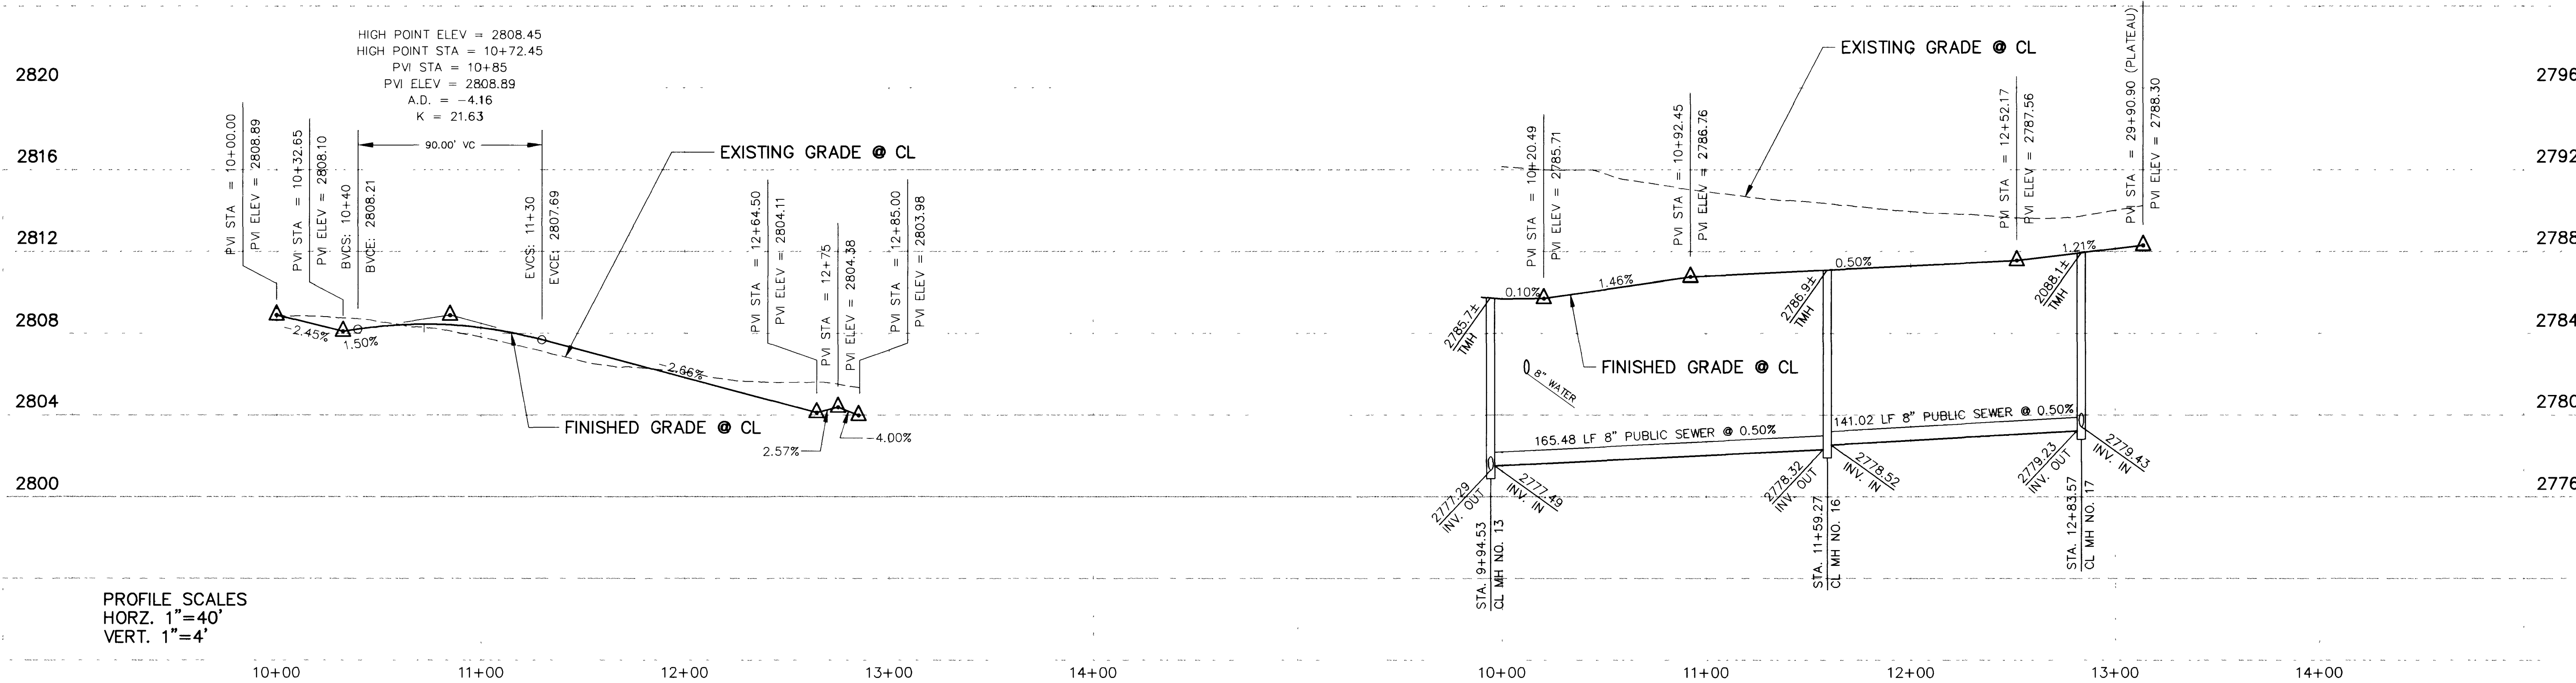


C:\ZIPS\175H45 Thu Apr 4 15:24:41 1996 PLOTTED BY K.E.C.

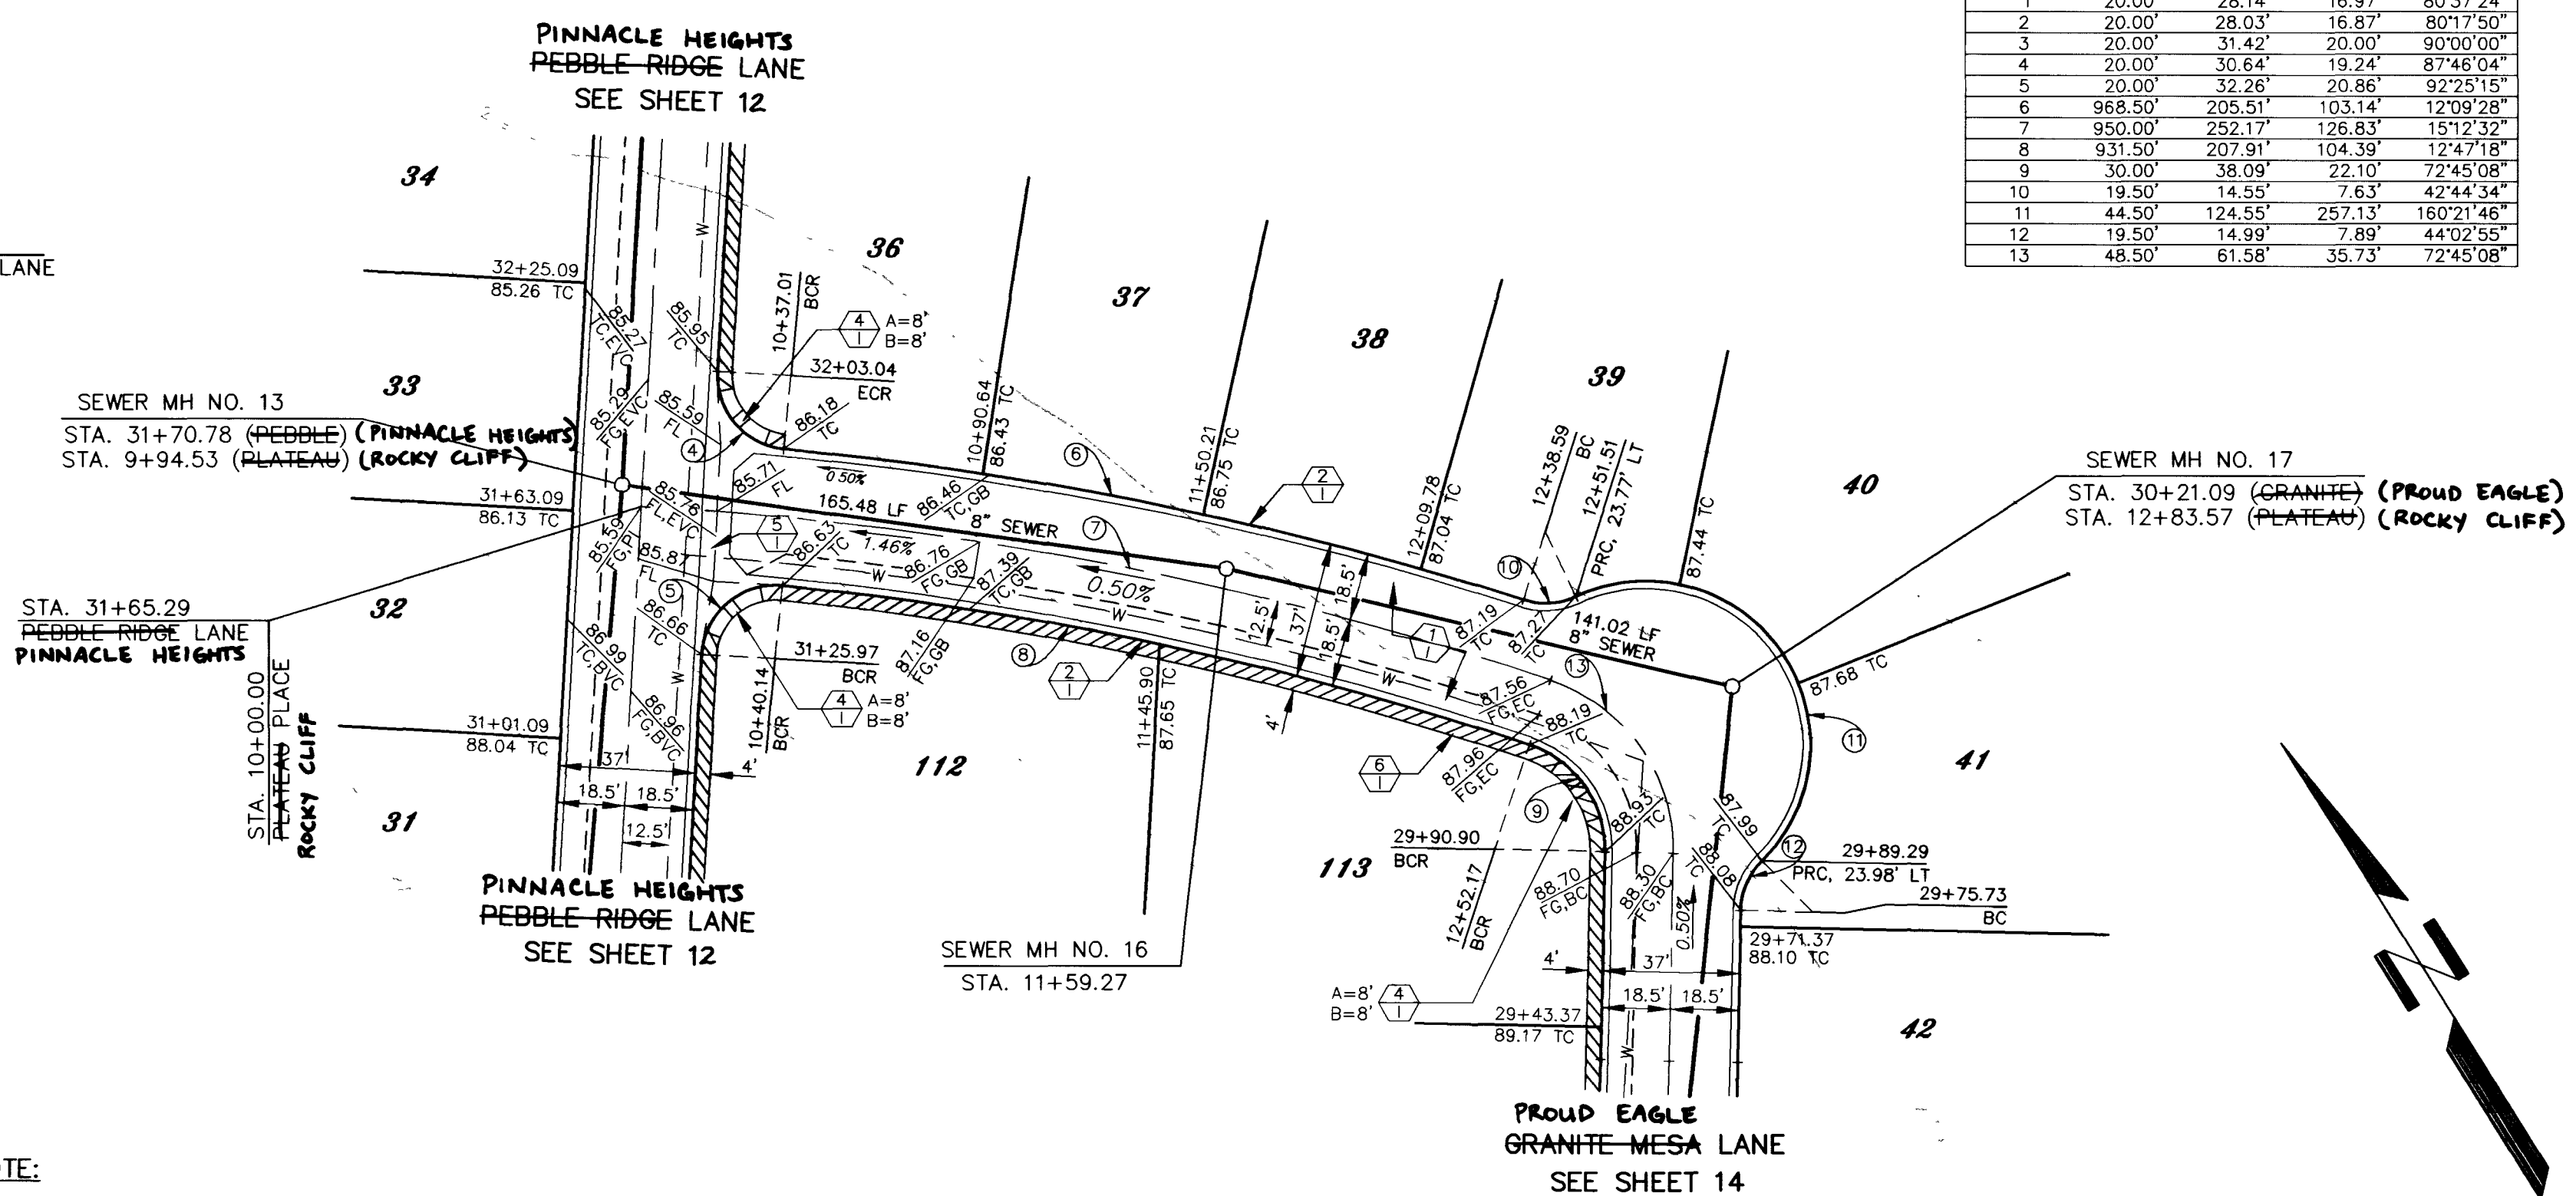

PROFILE SCALES
HORZ. 1"=40'
VERT. 1"=4'


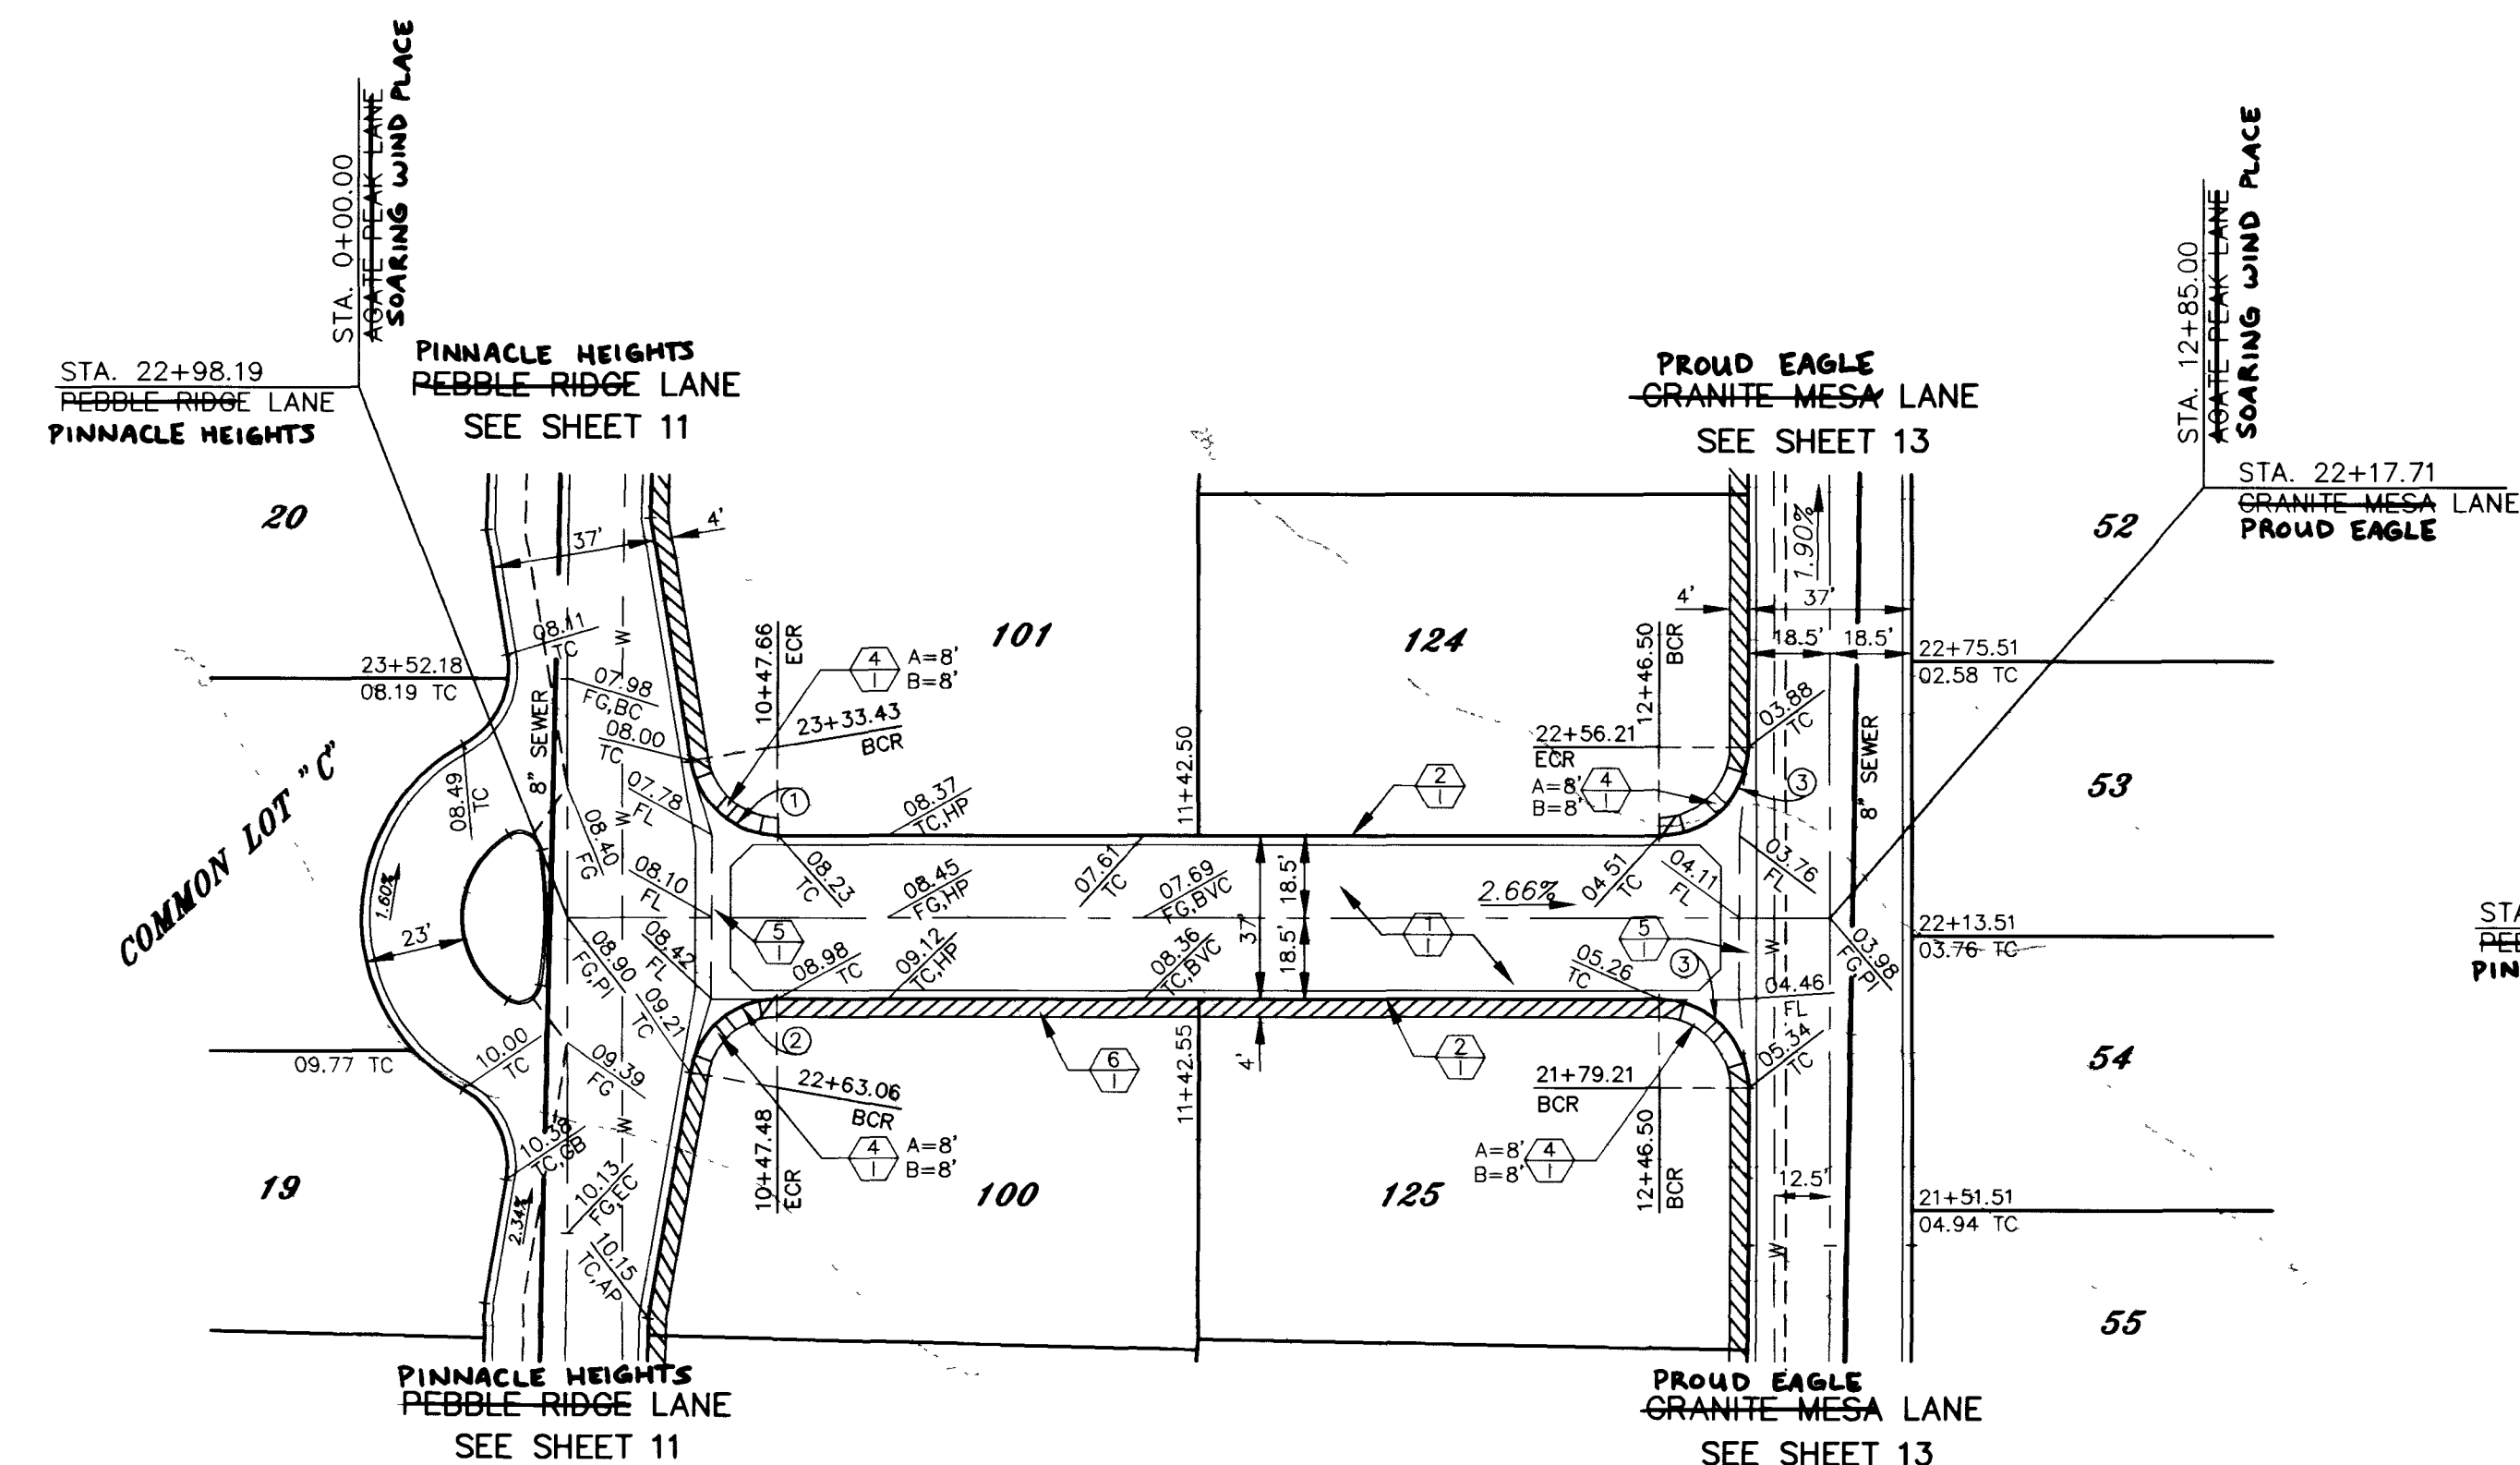


CURVE DATA TABLE				
CURVE	RADIUS	LENGTH	TANGENT	DELTA
1	20.00'	28.14'	16.97'	80°37'24"
2	20.00'	28.03'	16.87'	80°17'50"
3	20.00'	31.42'	20.00'	90°00'00"
4	20.00'	30.64'	19.24'	87°46'04"
5	20.00'	32.26'	20.86'	92°25'15"
9	30.00'	38.09'	22.10'	72°45'08"
10	19.50'	14.55'	7.63'	42°44'34"
11	44.50'	124.55'	257.13'	160°21'46"
12	19.50'	14.99'	7.89'	44°02'55"
13	48.50'	61.58'	35.73'	72°45'08"

- NOTE:
1. INSTALL A.C. PAVEMENT PER STREET SECTIONS, SHEET NO. 2
 2. INSTALL "L" TYPE CURB AND GUTTER (S-47)
 3. INSTALL "A" TYPE ISLAND CURB (S-50)
 4. INSTALL CASE 1 HANDICAP RAMP CURB DEPRESSION (S-77)
 5. INSTALL CROSS GUTTER (S-84)
 6. INSTALL 4' WIDE SIDEWALK (S-72)

SOARING WIND PLACE
AGATE PEAK LANE
PRIVATE STREET & CLV SEWER EASEMENT

ROCKY CLIFF
PLATEAU PLACE
PRIVATE STREET & CLV SEWER EASEMENT

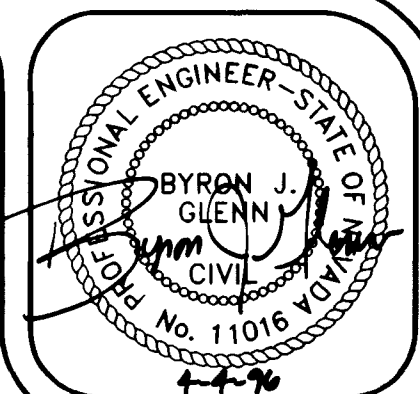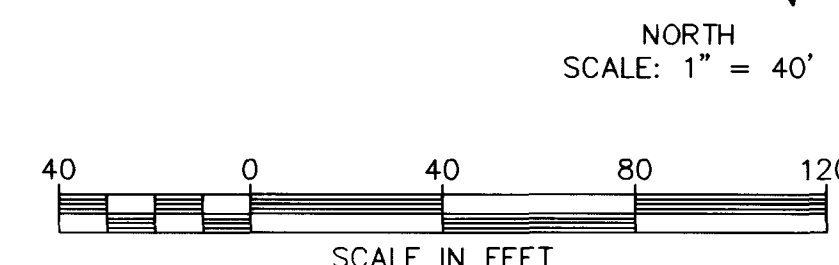

DESIGNED BY: K.E.C.	DRAWN BY: K.E.C.	DATE: 4/03/96
CHECKED BY:	JOB NUMBER: 5117	BY: DATE:
NO. 13	REVISION	NO. 13
13	REVISE STREET MARKS, PAV. FINISH, MARK	REV. DATE:

BEAZER HOMES-SUMMERLIN VILLAGE 3
EAGLE ROCK-PARCEL "F"
AGATE PEAK LANE & PLATEAU PLACE
SOARING WIND PLACE

L. BRUCE NYBO, INC.
civil engineering • planning • land surveying
6700 South Paradise Road • Suite A-1
Las Vegas • Nevada • 89119
(702) 806-3262

SHEET 15

of: 17

107Y-4462

FILE NAME: 5117SH15.DWG

941.

11-30-16

