


PROFILE  
SCALE: HORIZ. 1" = 40'  
VERT. 1" = 4'

NOTE: FUTURE 12" WATERLINE TO BE BUILD WITH SUN CITY LAS VEGAS UNIT 25.

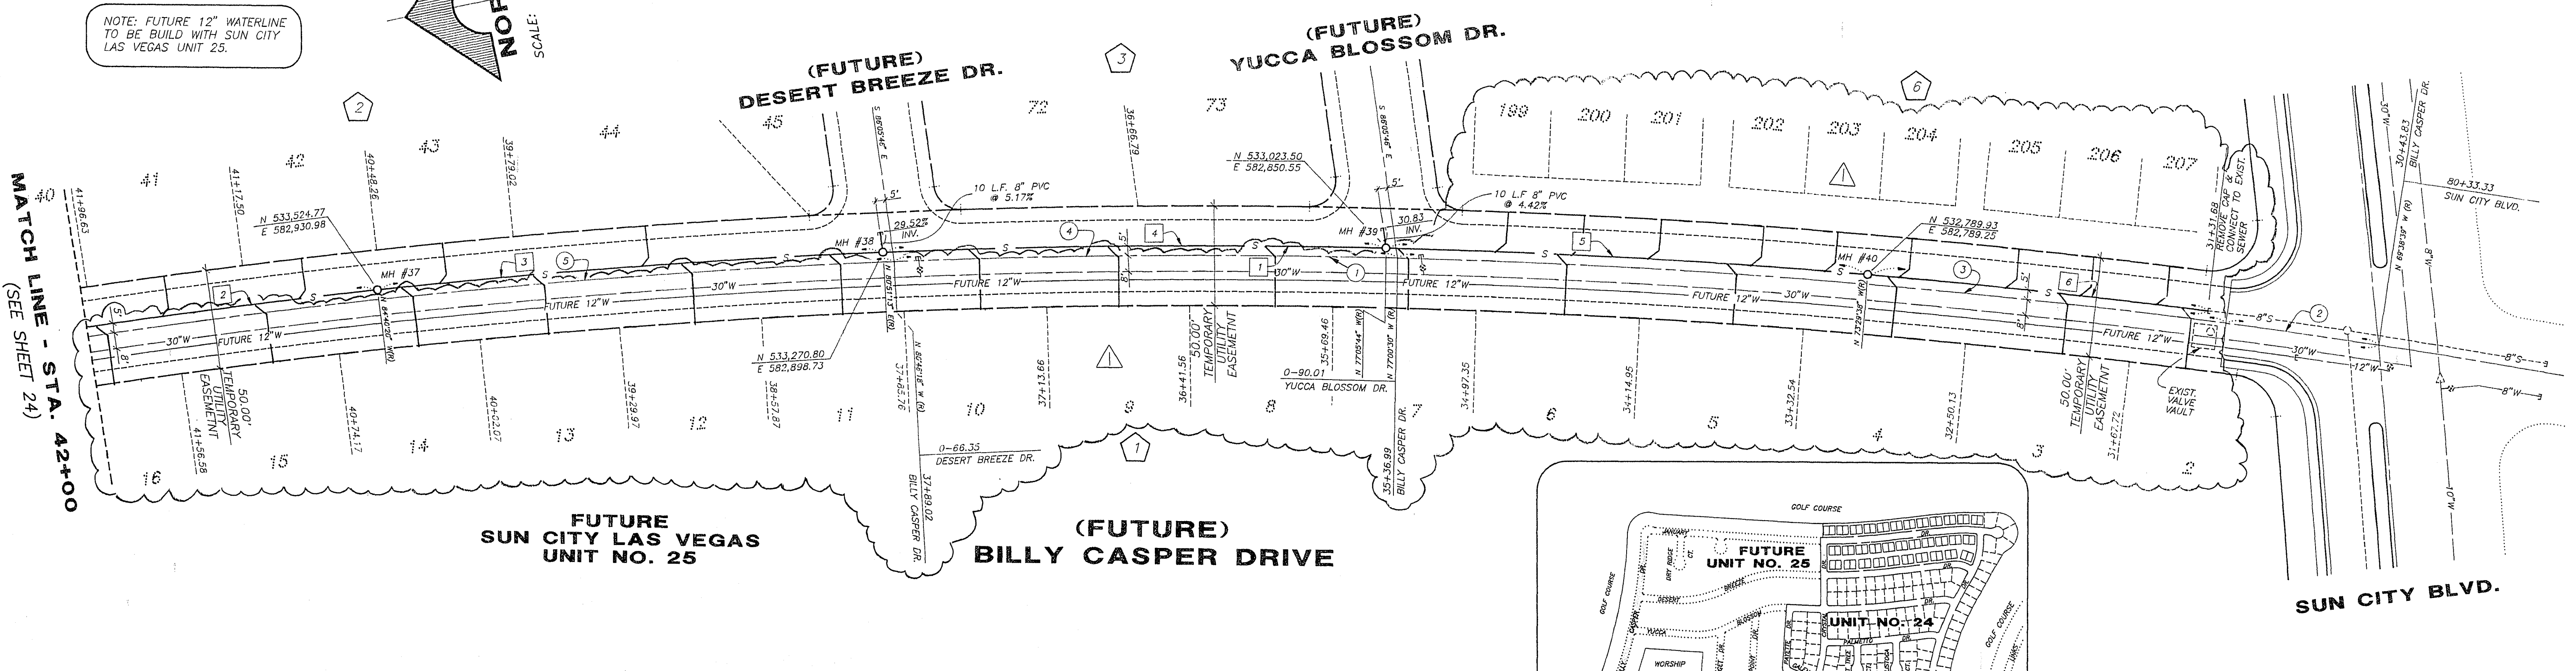


**1 CURVE TABLE**

CURVE	DELTA	RADIUS	LENGTH	TANGENT
1	17°56'19"	3837.00'	1201.32'	805.62'
2	01°09'45"	3837.00'	77.85'	38.93'
3	06°12'06"	3837.00'	415.31'	207.86'
4	03°45'48"	3837.00'	252.04'	126.06'
5	06°48'40"	3837.00'	456.12'	228.33'

**2 SEWER CURVE TABLE**

CURVE	DELTA	RADIUS	LENGTH	TANGENT
1	17°32'07"	3842.00'	1175.84'	592.55'
2	03°49'08"	3842.00'	256.08'	128.09'
3	03°49'07"	3842.00'	256.06'	128.09'
4	03°48'08"	3842.00'	251.99'	126.04'
5	03°36'06"	3842.00'	241.52'	120.80'
6	02°32'17"	3842.00'	170.19'	85.11'

NOTE:  
ALL STATIONING IS ALONG CENTERLINE OF FUTURE BILLY CASPER DRIVE.

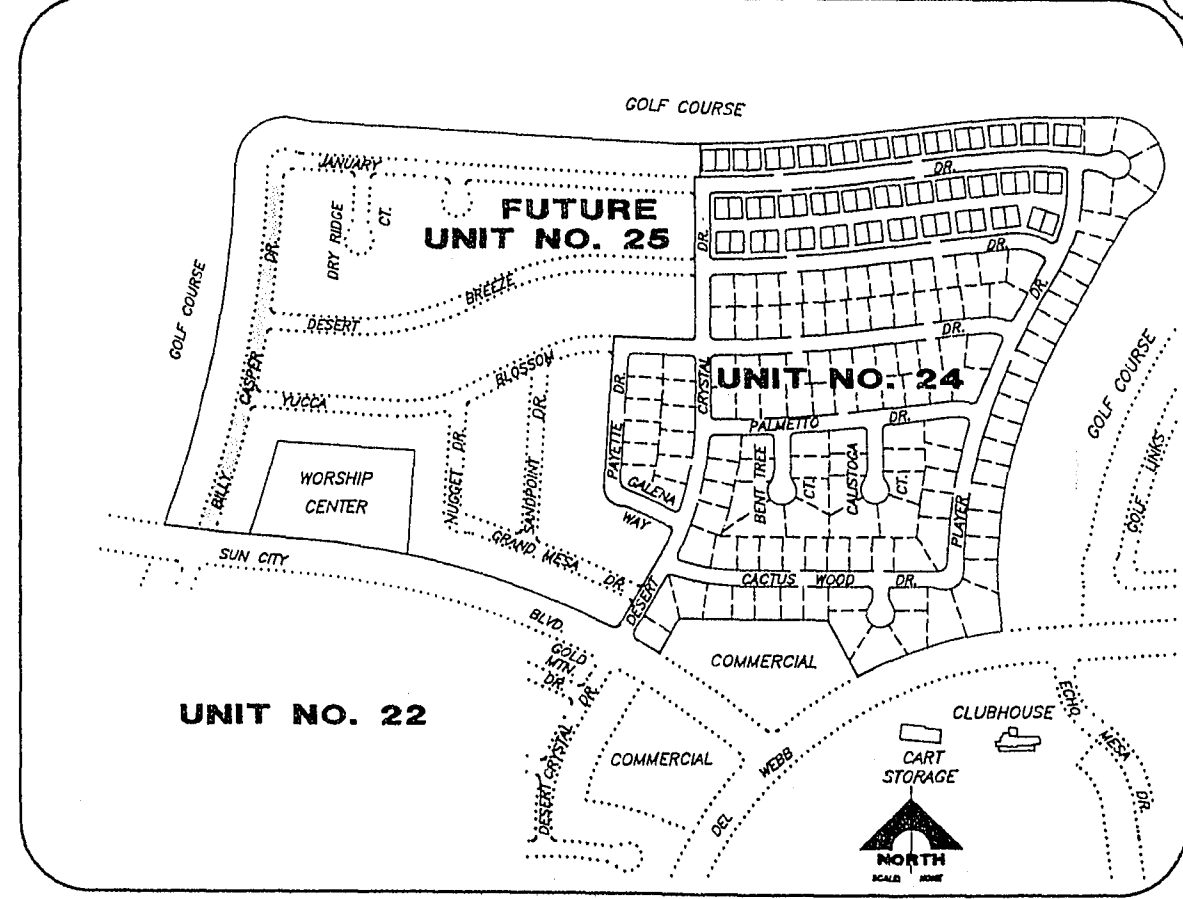

KEY MAP

APPROVED FOR CONSTRUCTION  
*[Signature]* 12/27/90  
DEL WEBB COMMUNITIES, INC. DATE

RECOMMENDED BY: *[Signature]*  
DATE: 12/27/90  
P.E. NO.: 6218  
P.E. NAME: MICHAEL D. ROSS  
REVISIONS: 1, 2, 1000