
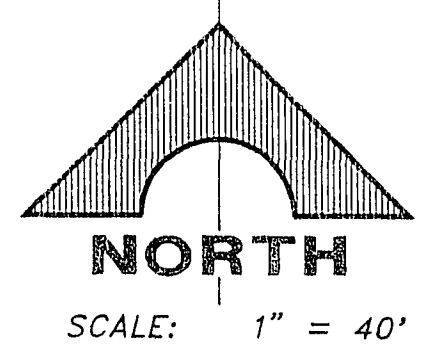


PROFILE
 SCALE: HORIZ. 1" = 40'
 VERT. 1" = 4'

(FUTURE) JANUARY DRIVE

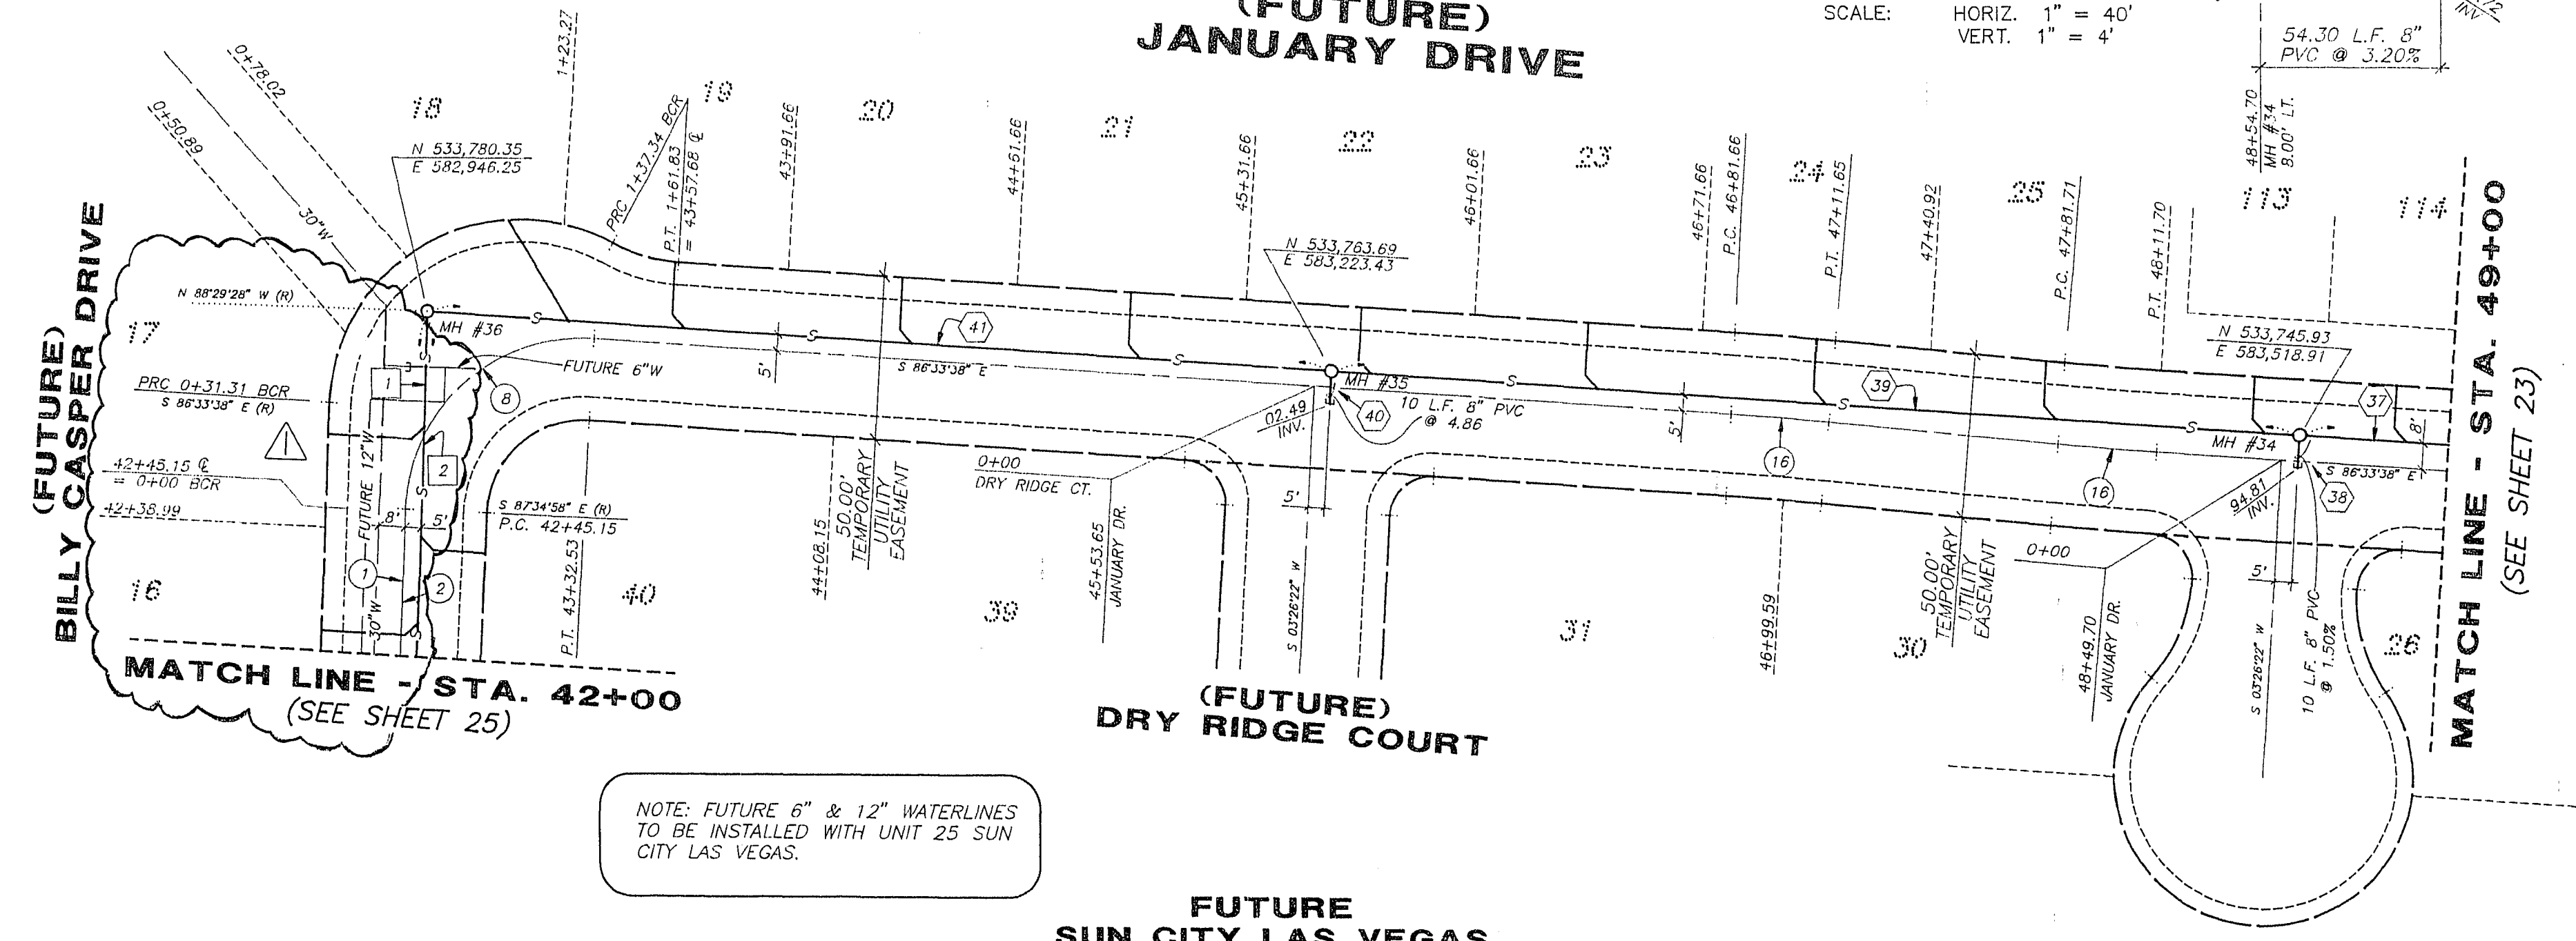

NOTE: FUTURE 6" & 12" WATERLINES TO BE INSTALLED WITH UNIT 25 SUN CITY LAS VEGAS.

NOTE: STATIONING IS ALONG CENTERLINE OF FUTURE JANUARY DRIVE

APPROVED FOR CONSTRUCTION
[Signature]
 DEL WEBB COMMUNITIES, INC. DATE 12/27/14

SEWER CURVE TABLE


CURVE	DELTA	RADIUS	LENGTH	TANGENT
1	17°32'07"	3842.00'	1175.84'	592.55'
2	07°48'08"	3842.00'	256.08'	128.09'

CURVE TABLE

CURVE	DELTA	RADIUS	LENGTH	TANGENT
1	17°56'19"	3837.00'	1201.32'	605.62'
2	06°48'40"	3837.00'	456.12'	228.33'
3	31°01'20"	55.00'	87.38'	53.99'
16	01°43'06"	1000.00'	29.99'	15.00'

SEWER LINE TABLE

LINE	BEARING	DISTANCE
37	N 86°33'36" W	386.69'
38	S 07°26'22" W	10.00'
39	N 86°33'36" W	296.01'
40	S 07°26'22" W	10.00'
41	N 86°33'36" W	277.69'

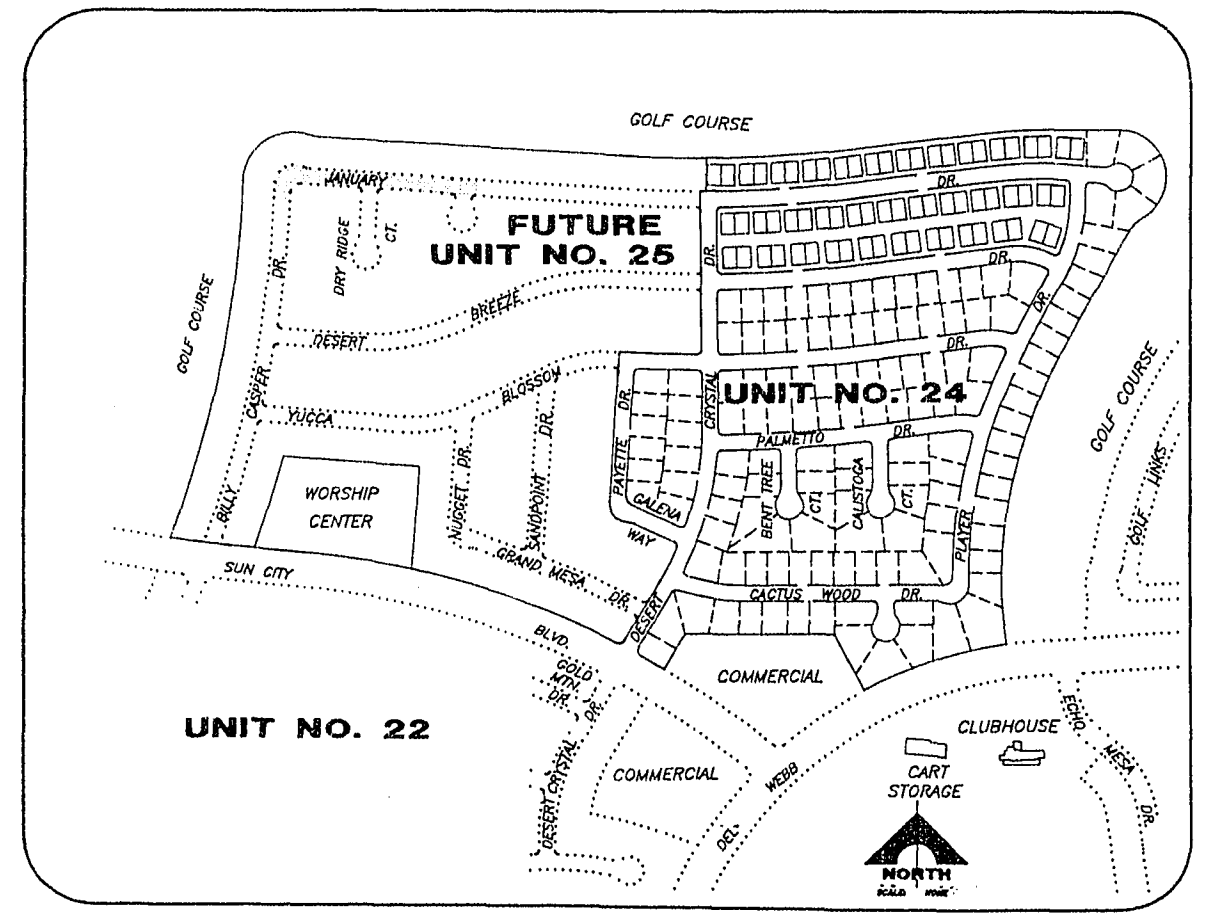

KEY MAP

701.096

RECOMMENDED
 MICHAEL D. ROSS
 P.E. NO. DATE

6218 27 DEC 14

1555 SOUTH RAINBOW BLVD., LAS VEGAS, NEVADA 89102

G. C. WALLACE, INC.
 Engineering/Architecture

DEL E. WEBB COMMUNITIES, INC.
 SUN CITY LAS VEGAS UNIT NO. 24
 OFFSITE SEWER
 STA. 42+00 TO STA. 49+00

SHEET
24
 OF 26 SHEETS

3071-4141-24