RECORD DRAWING

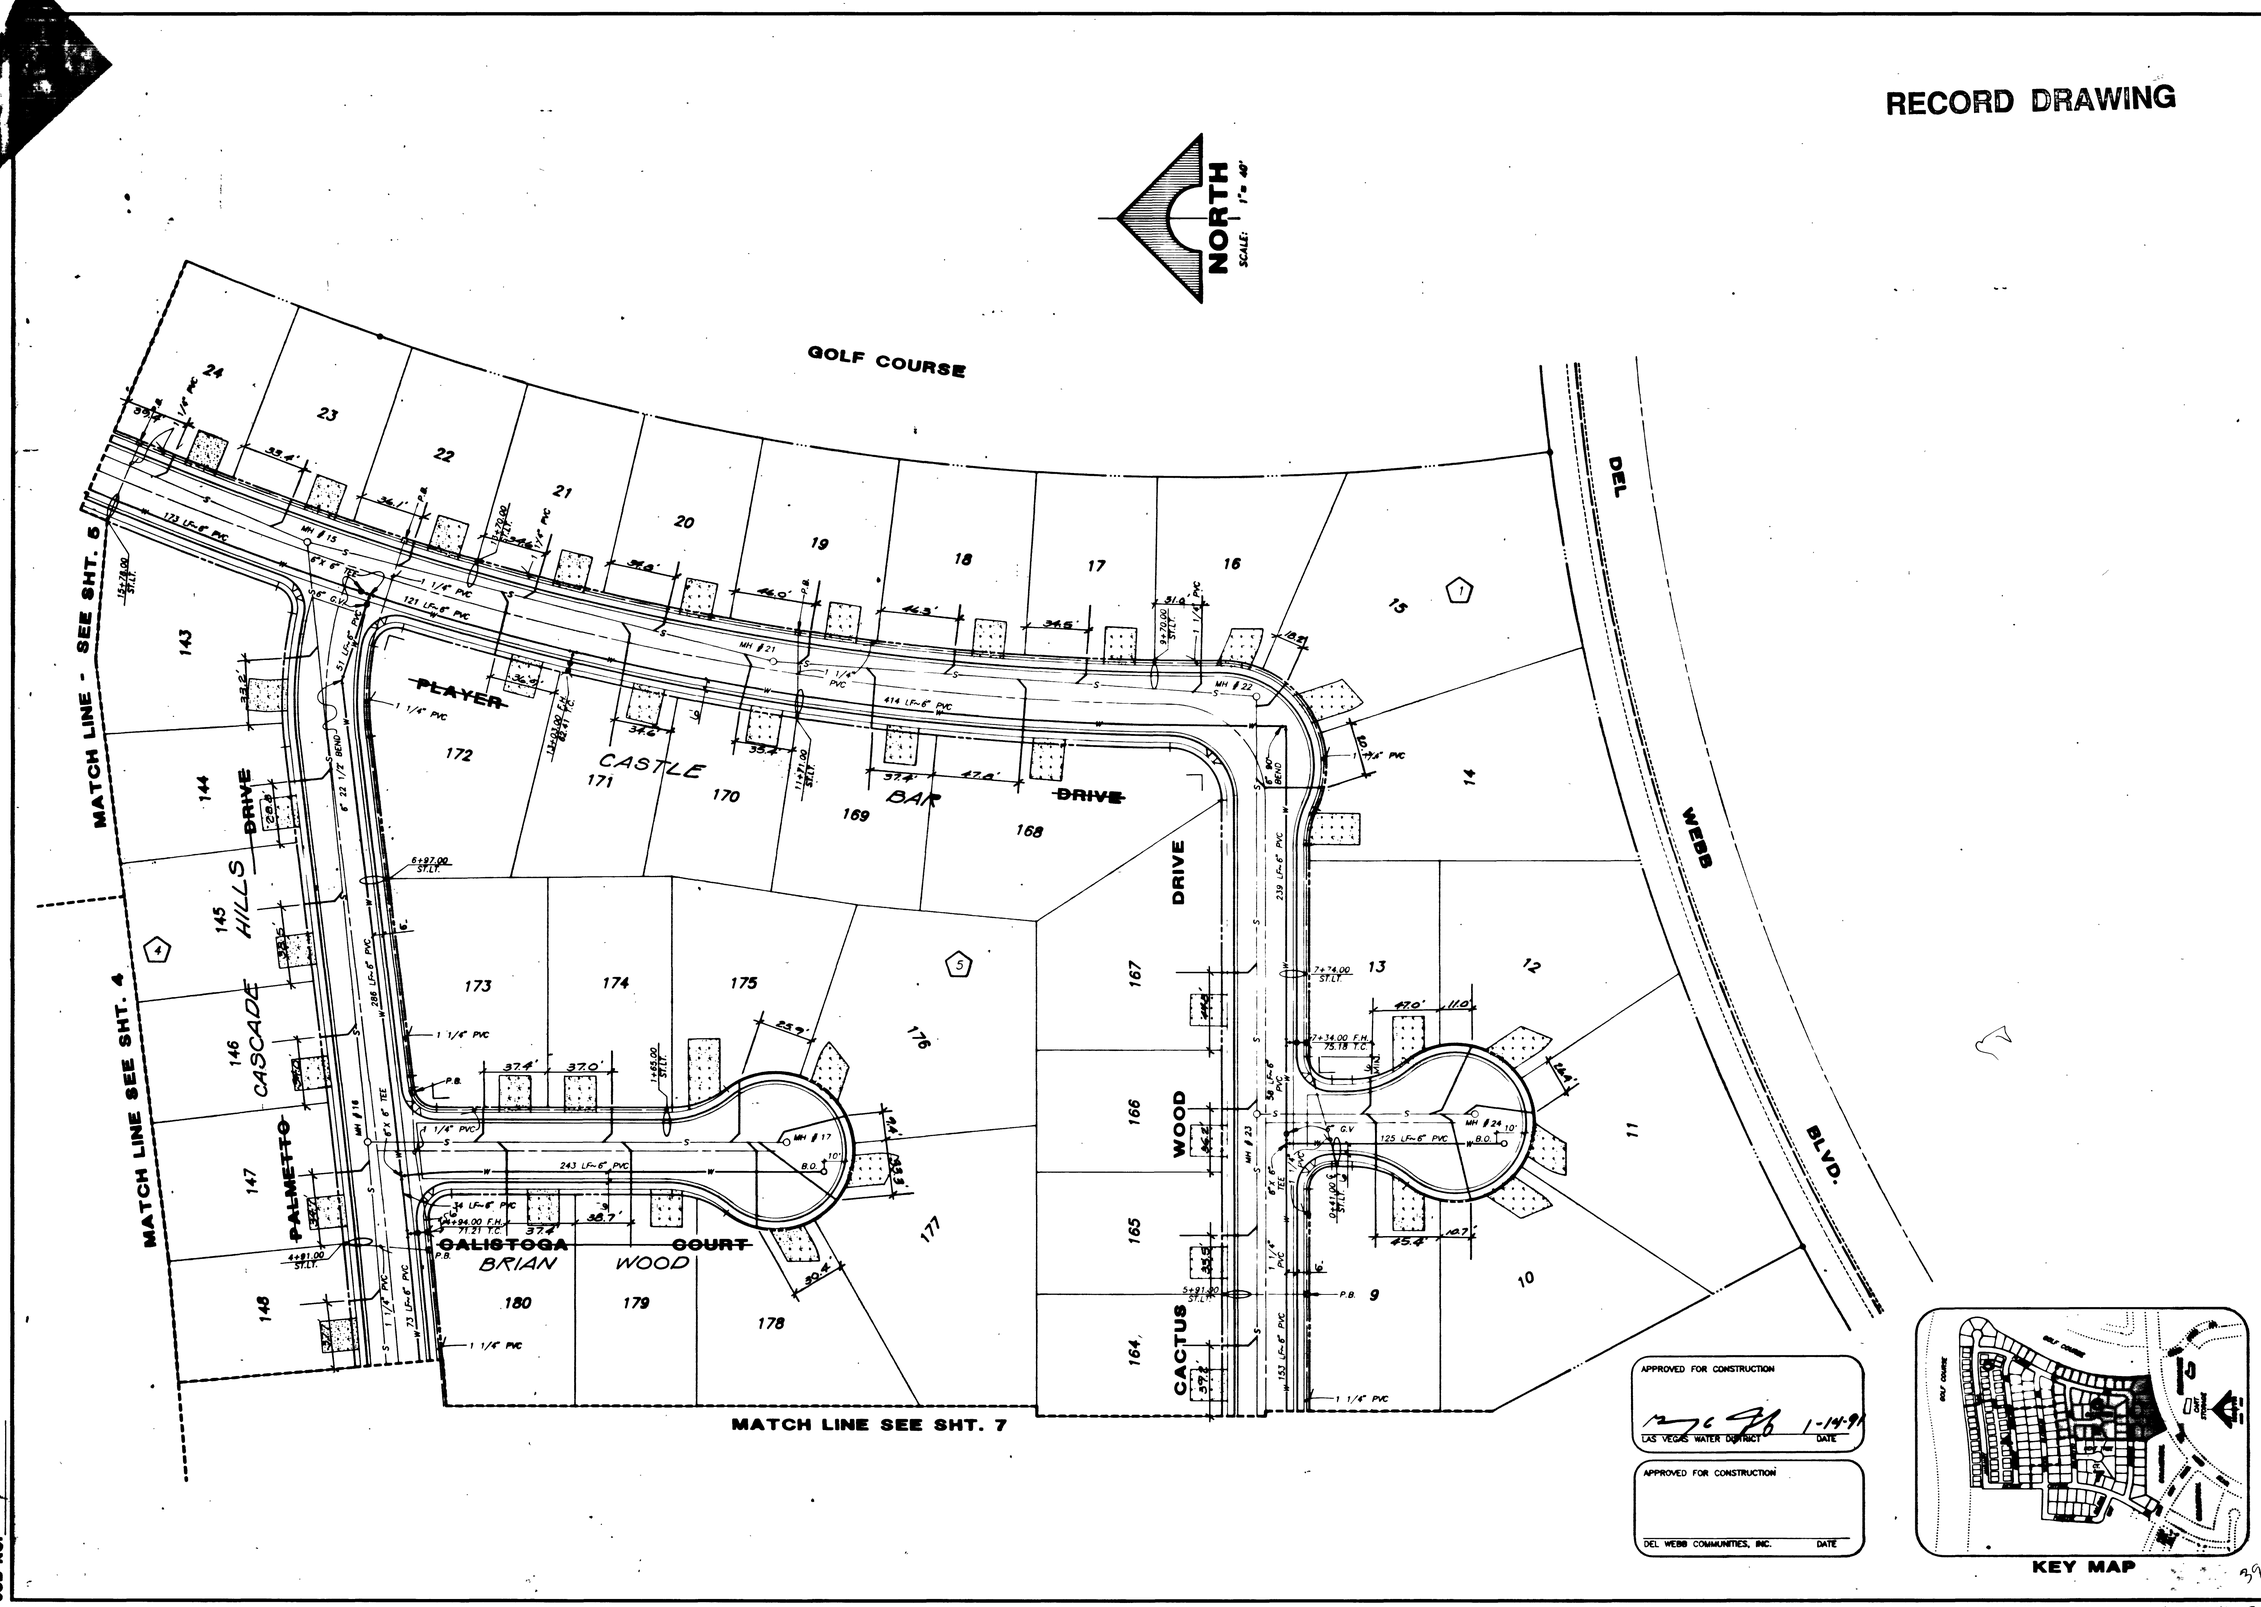

REV	DATE	DESCRIPTION

RECOMMENDED: RICHARD L. ROSS
P.E. NO. 6218
DATE 12-26-90

G.C. WALLACE, INC.
Engineering/Architecture
1555 SOUTH RAINBOW BLVD./LAS VEGAS, NEVADA 89102

DEL E. WEBB COMMUNITIES, INC.
SUN CITY LAS VEGAS UNIT NO. 24

UTILITY PLAN III

SHEET 6 OF 20 SHEETS

JOB NO. 701.096

"As Built" 807Y-4141-24

RECORD DRAWING

E.C. VALLACE, INC.

UTILITY PLAN II