RECORD OF SURVEY

A PORTION OF S.W. 1/4 OF S.W. 1/4 SEC 36
T 20 S R 60 E M. D. B. & M.

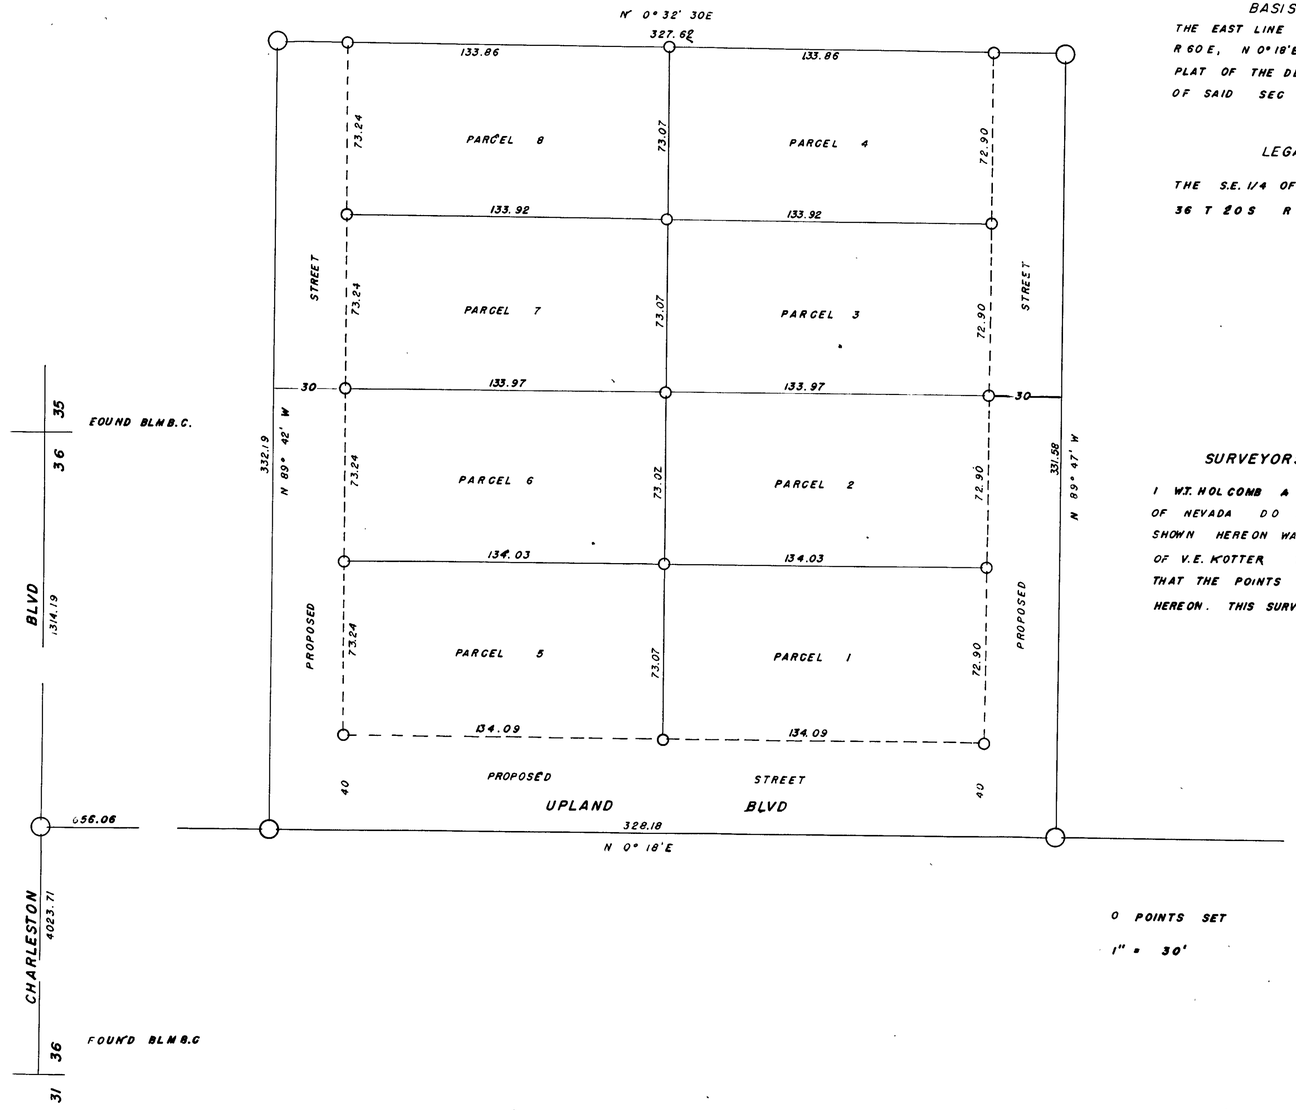

0 POINTS SET

1" = 30'

BASIS OF BEARING

THE EAST LINE OF GOVT LOT 20 SEC 36, T 20 S, R 60 E, N 0° 18'E AS SHOWN ON THE U.S.B.L.M. PLAT OF THE DEPENDENT RESURVEY AND SUBDIVISON OF SAID SEC 36 DATED JUNE 8, 1953

LEGAL DESCRIPTION

THE S.E. 1/4 OF N.E. 1/4 OF S.W. 1/4 OF S.W. 1/4 OF SEC 36 T 20 S R 60 E BEING LOT 20 OF SAID SEC 36

SURVEYORS CERTIFICATE

I W.T. HOLCOMB A DULY REGISTERED LAND SURVEYOR IN THE STATE OF NEVADA DO HEREBY CERTIFY THAT THE SURVEY OF THE LAND SHOWN HEREON WAS MADE UNDER MY DIRECT SUPERVISION AT INSTANCE OF V.E. KOTTER THE SURVEY WAS COMPLETED ON APRIL 1, 1962 AND THAT THE POINTS FOUND AND THE POINTS SET ARE CORRECTLY SHOWN HEREON. THIS SURVEY IS NOT INTENDED TO BE A SUBDIVISON

W.T. Holcomb 4-5-62

W.T. HOLCOMB R.E. NO. 181

NO 284383
FILED AT THE REQUEST OF
W.T. HOLCOMB
Date 4-5-62 at 12:50 P.M.
FILE 11 PAGE 21
of Surveys
OFFICIAL RECORDS 352
COUNTY OF CLARK
PAUL C. ROMANELLI, RECORDER
Fee $2.50 B.J.F. Deputy

055-202
FILE 11 PAGE 21