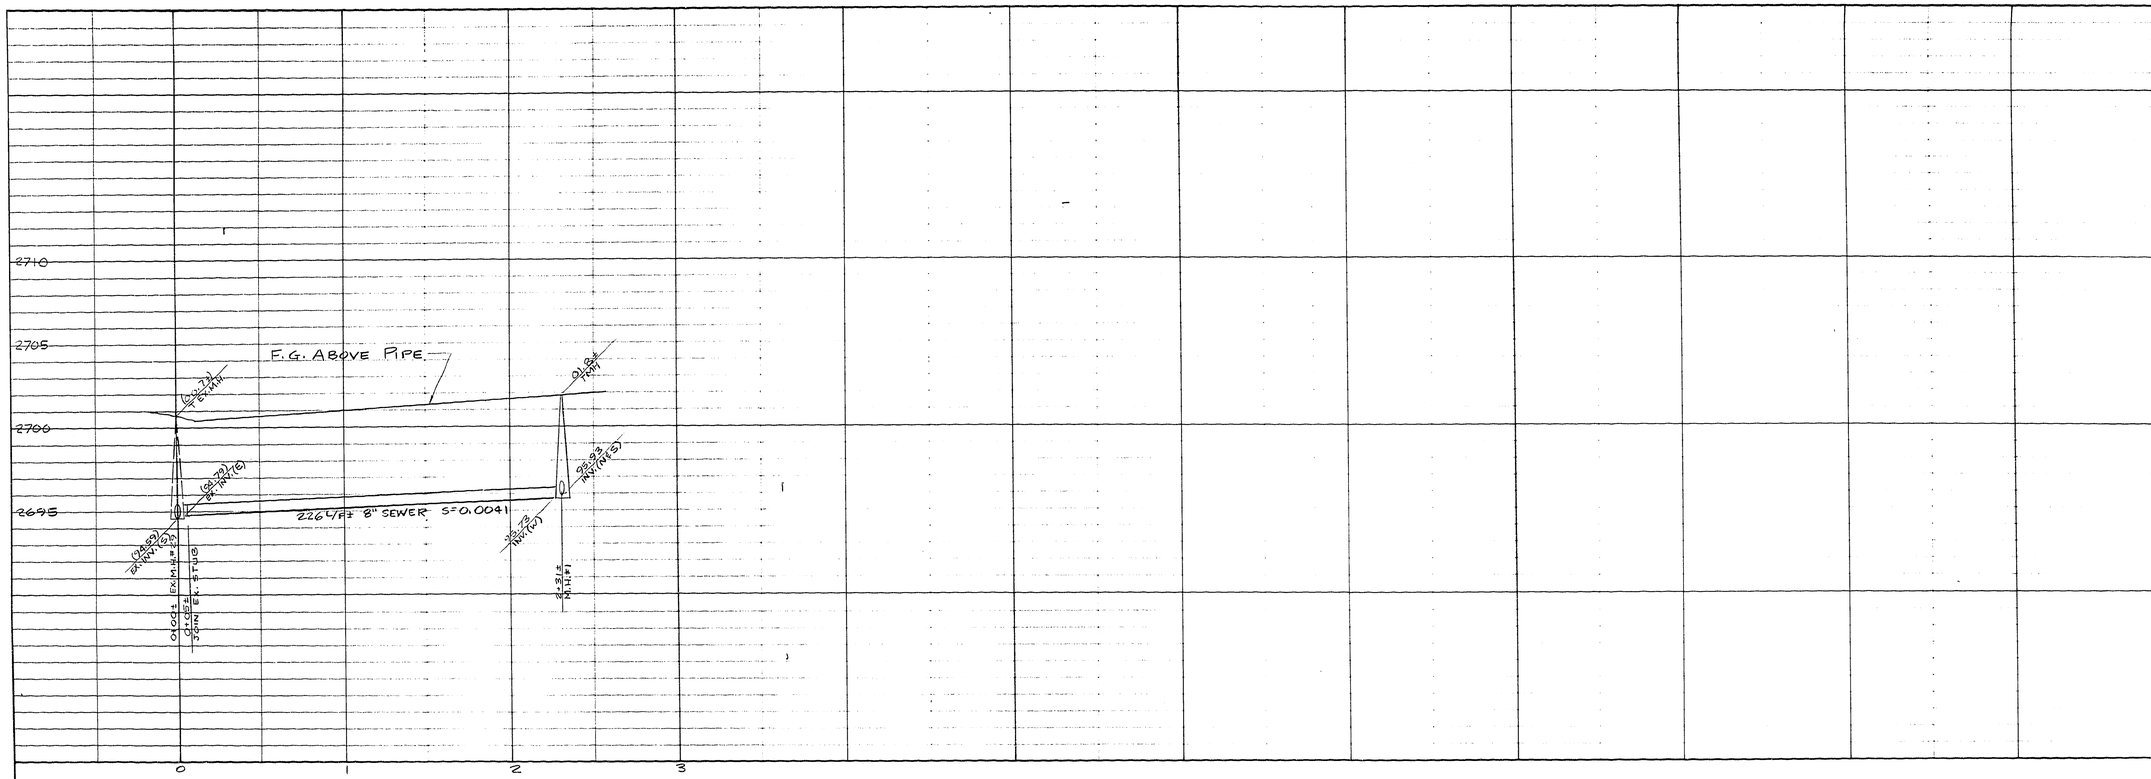

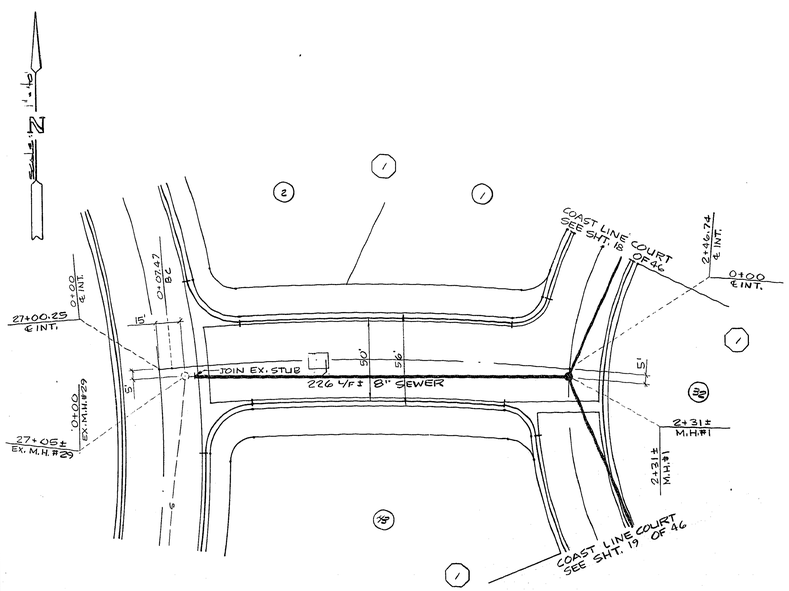

COAST LINE COURT

REV	DATE	BY	REVISION
1	9/14/15	BLM	ADD SUPER HOLES AT 2+31 & 2+44.74

ENGINEERS & SURVEYORS INCORPORATED
7022 W. CHARLESTON BLVD.
LAS VEGAS, NEVADA 89117
PHONE 702 / 363-6415

SUBMITTED BY:

TITLE: SEWER PLAN & PROFILE
COAST LINE COURT

PROJECT: THE LAKES at West Sahara Phase 1

WO NO.	830802
BY	D. REED
DATE	12/17/84
SCALE	VER 1" = 4 HOR 1" = 40'

SHEET 17 OF 46 SHEETS

APPROVAL

4/20/15

CLV CHIEF FLOOD CONTROL & LAND DEVELOPMENT — DATE

16-7-1111 307-Y-1933-1