


CANNOCK ST.


PLAN AND PROFILE
SCALE
HORIZ. 1" = 40'
VERT. 1" = 4'

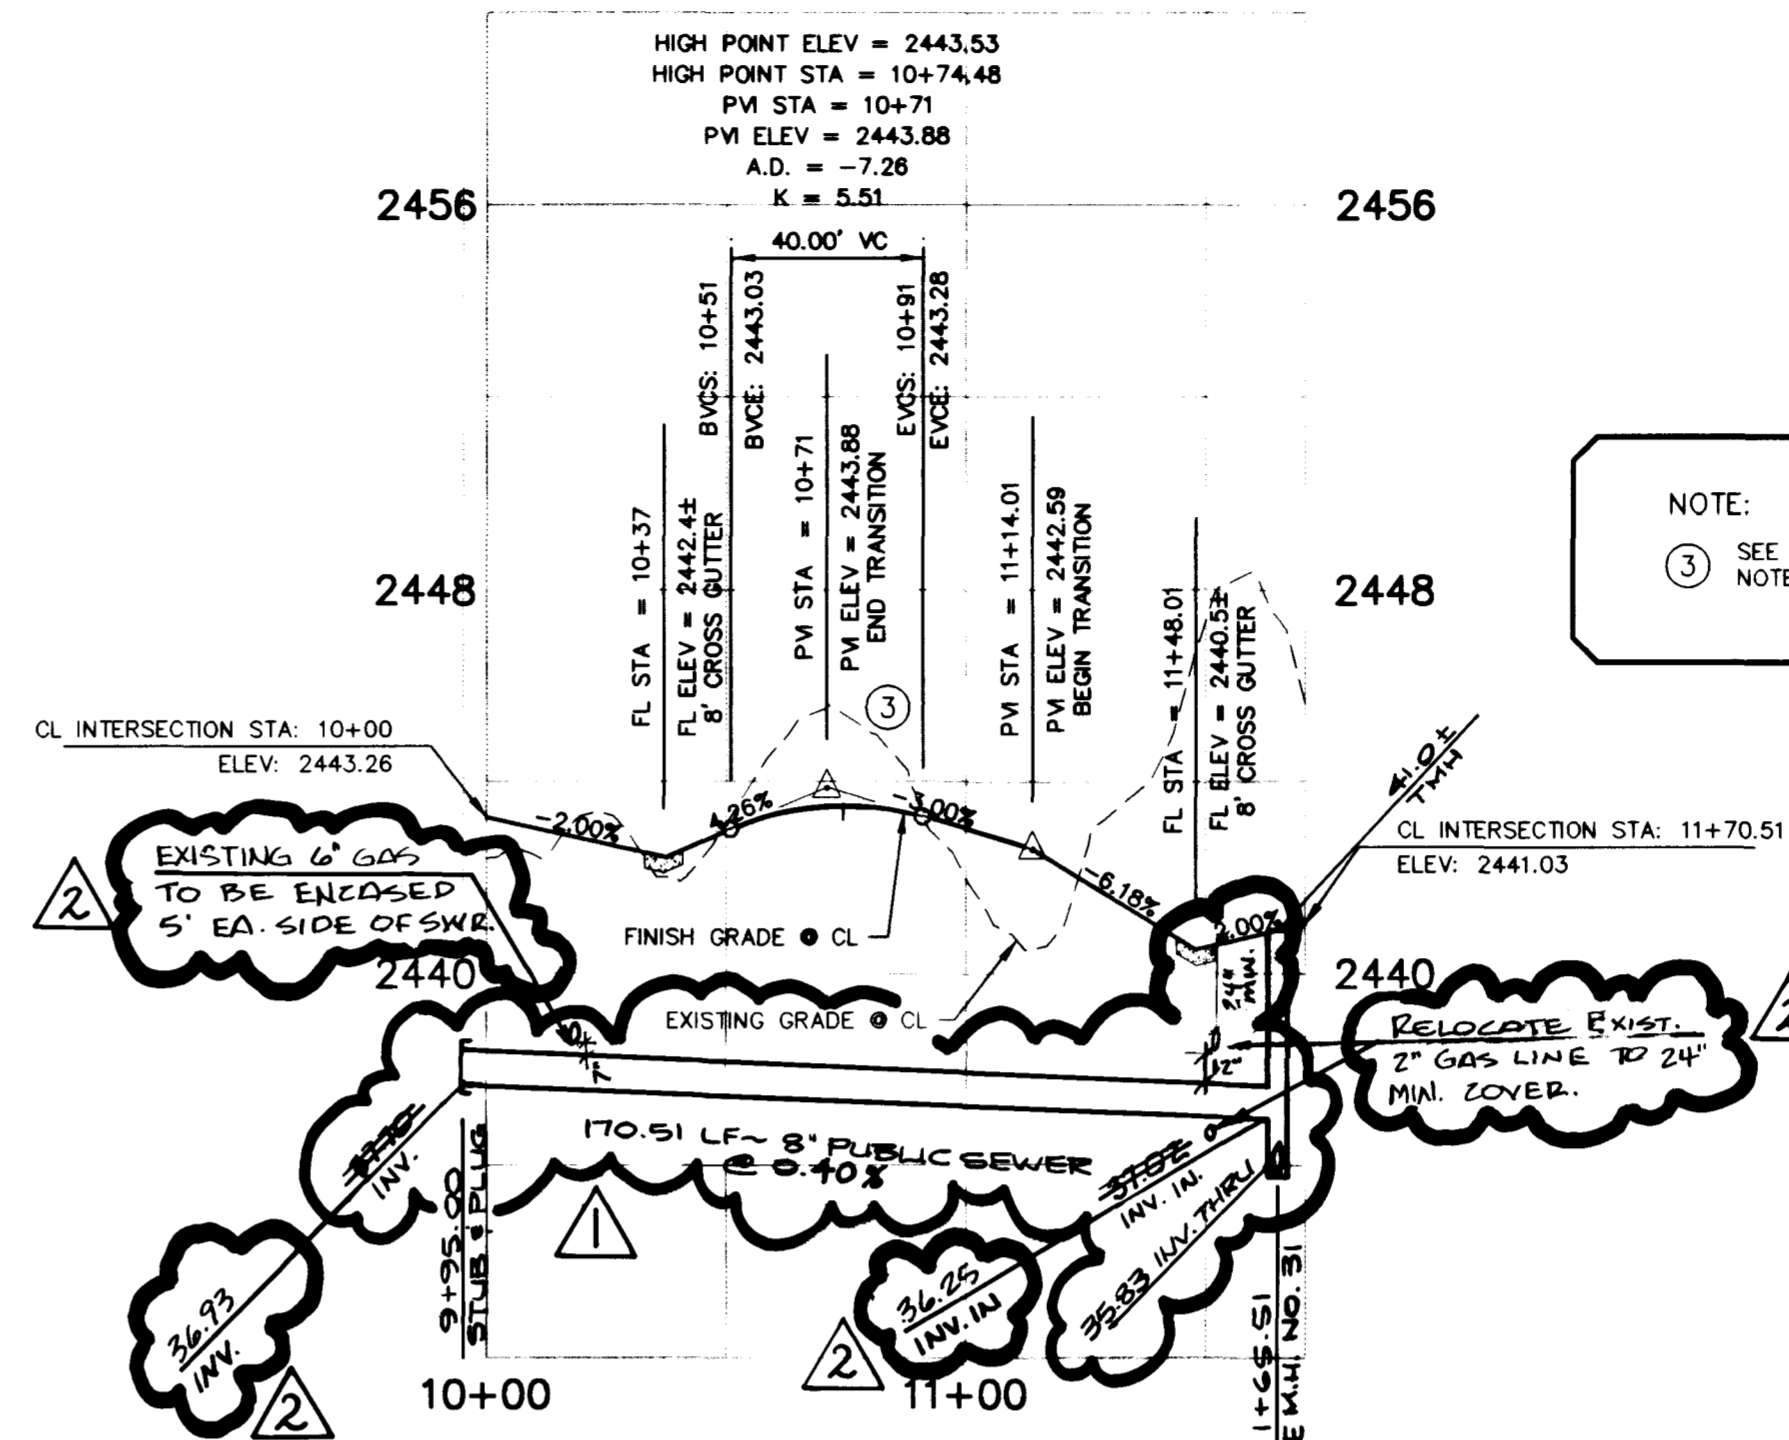

DARTFORD ST.


PLAN AND PROFILE
SCALE
HORIZ. 1" = 40'
VERT. 1" = 4'

NOTE:
③ SEE "DEVIATIONS FROM STANDARDS"
NOTE 2, SHEET 2 OF 10

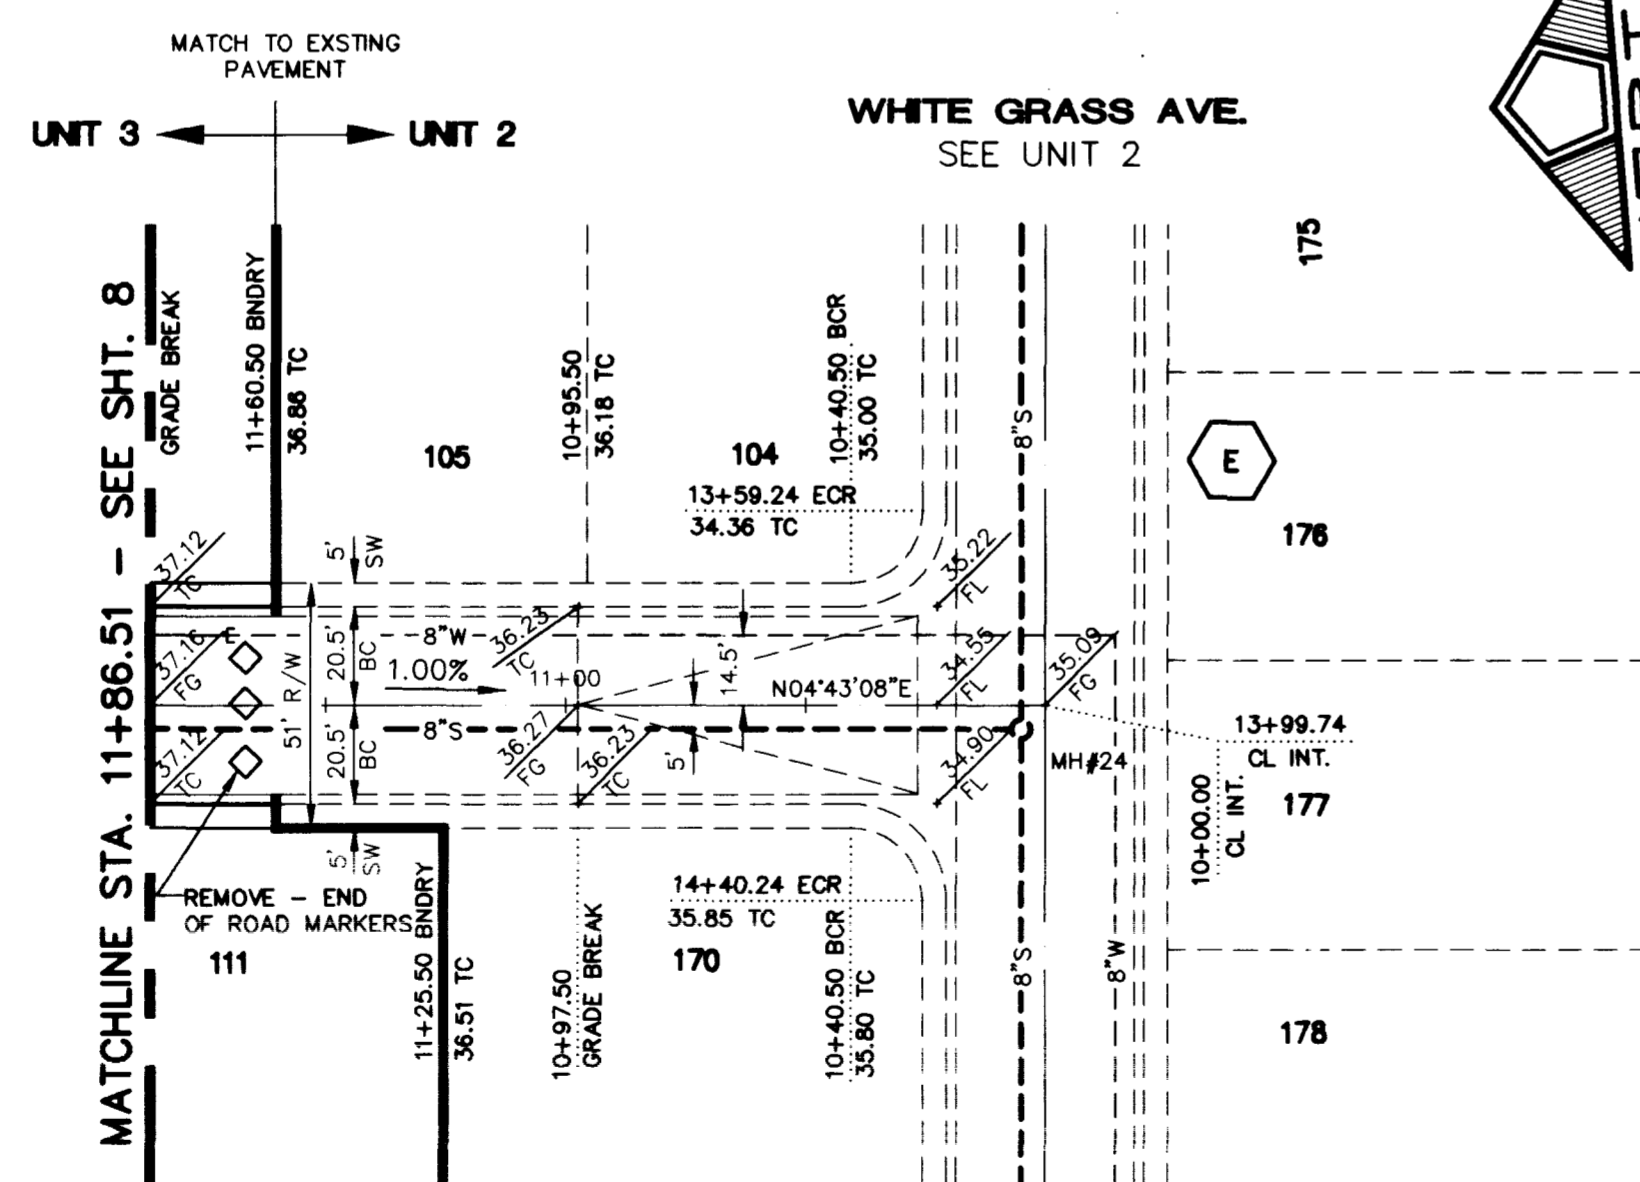


CANNOCK ST.

GRAPHIC SCALE
(IN FEET)
1 inch = 40 ft

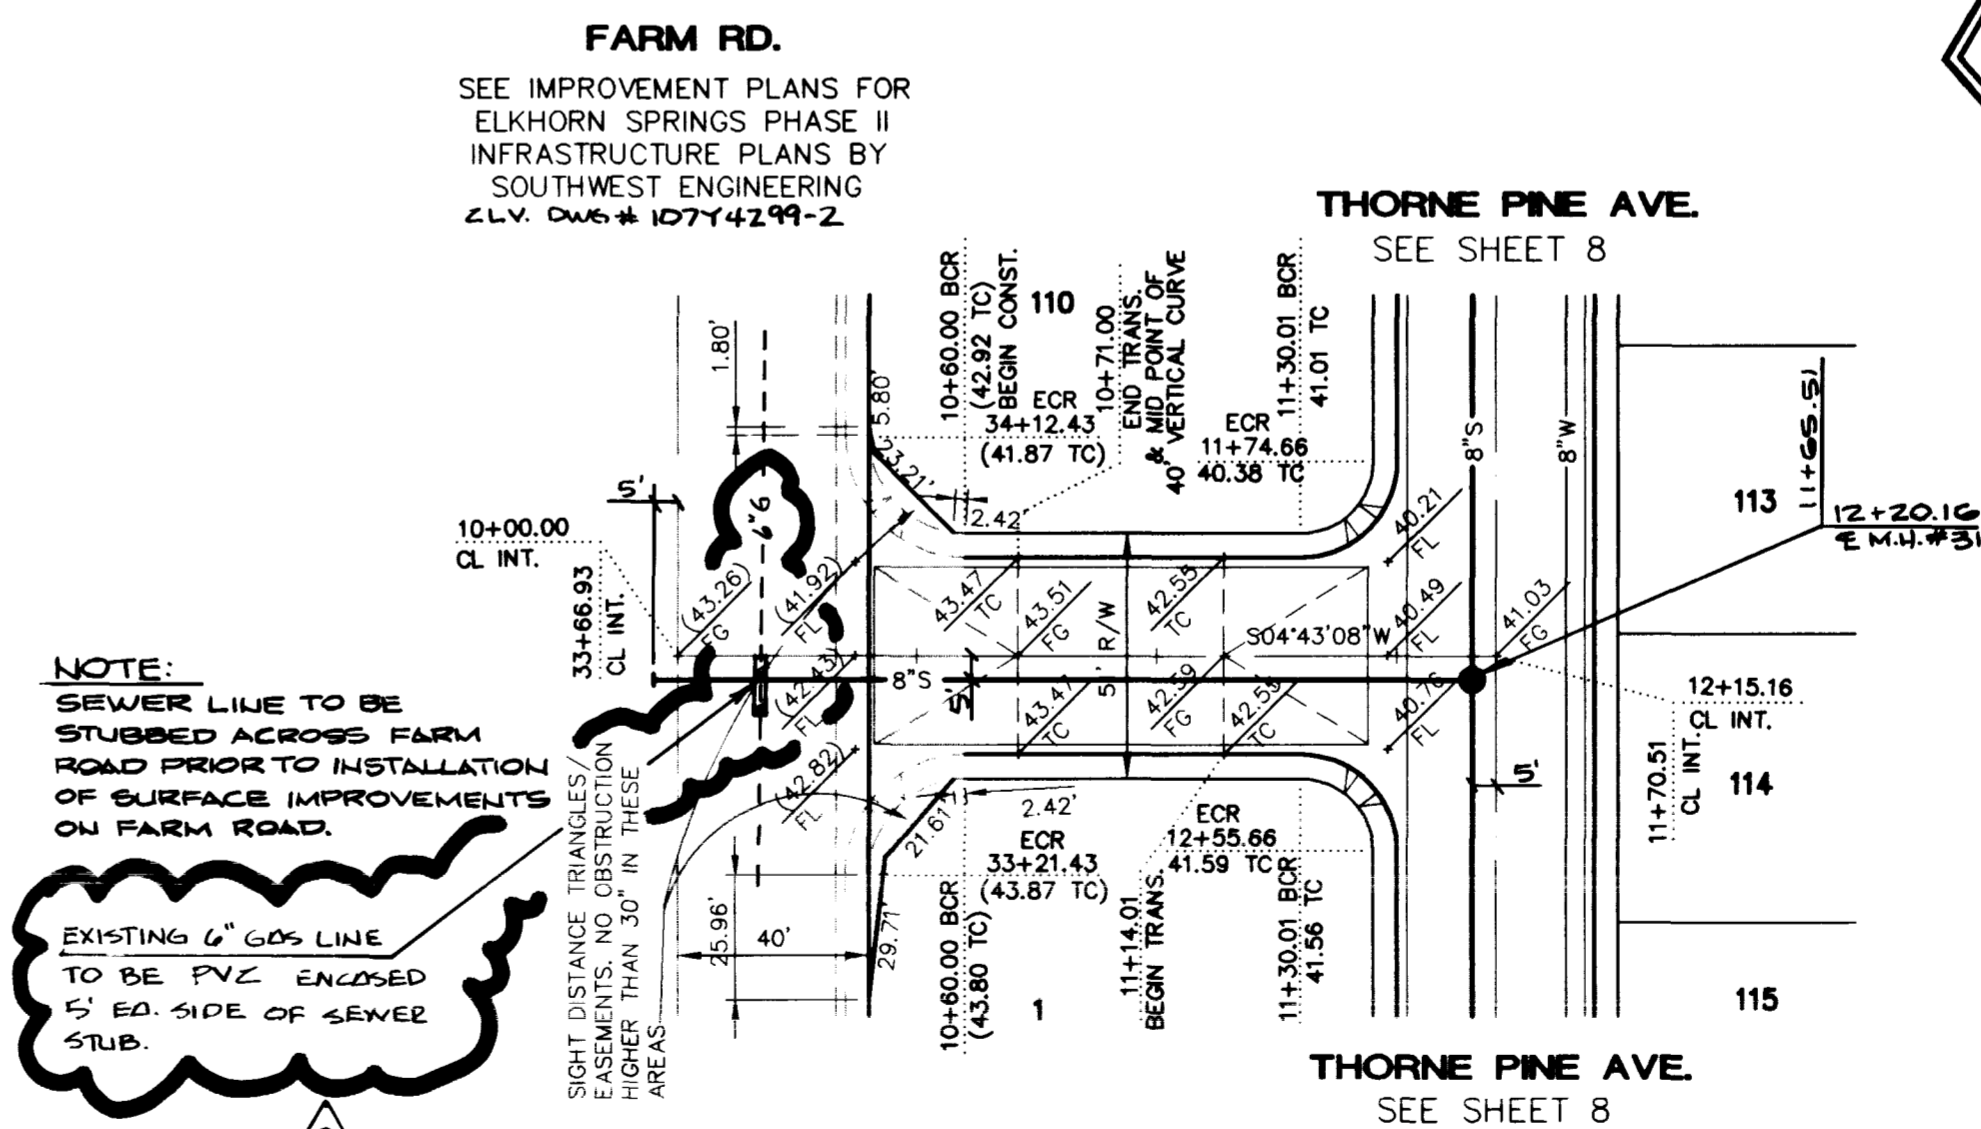


DARTFORD ST.

GRAPHIC SCALE
(IN FEET)
1 inch = 40 ft

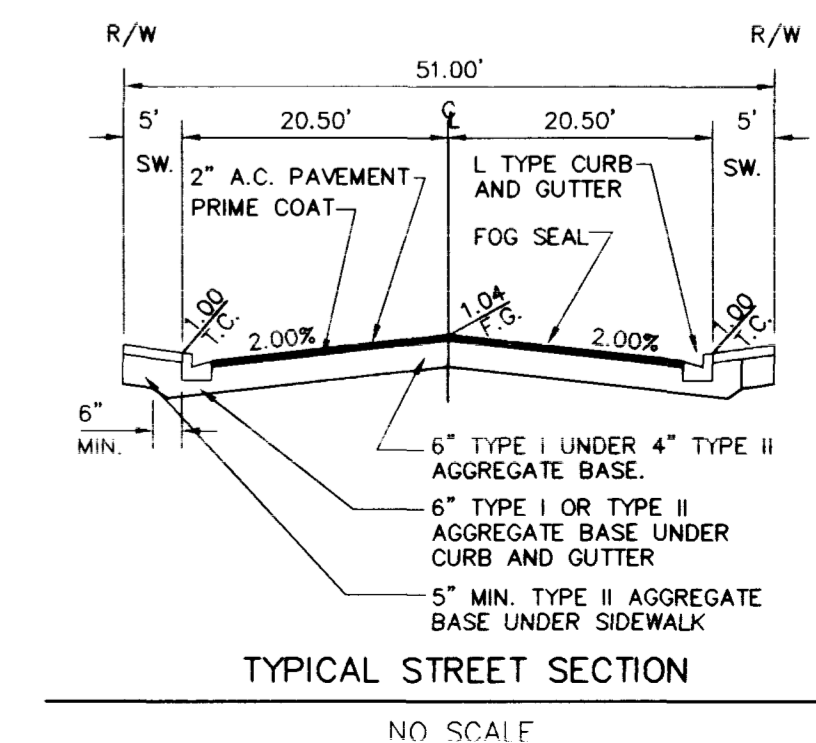

TYPICAL STREET SECTION
NO SCALE

REVISION	DATE	BY
1	11/29/99	...
2

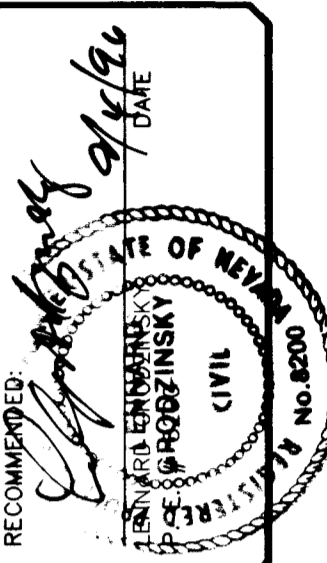

DATE	1/18/98
DRAWN BY	FC
CHECKED BY	...
JOB NO.	0168.090
SCALE	1" = 40'

PENTACORE
CIVIL ENGINEERING • LAND SURVEYING • PLANNING
CONSTRUCTION MANAGEMENT • ADA CONSULTING
6783 WEST CHARLESTON BOULEVARD
LAS VEGAS, NEVADA 89102 (702)258-0115

RHODES HOMES
THE MEADOWS AT ELKHORN SPRINGS - UNIT 3
CANNOCK ST. AND DARTFORD ST.
STREET PLAN AND PROFILE


5289

11-29-99


107Y-4457-3





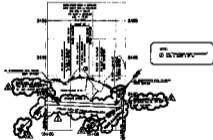


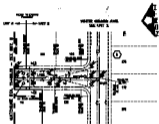


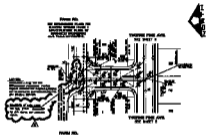





