




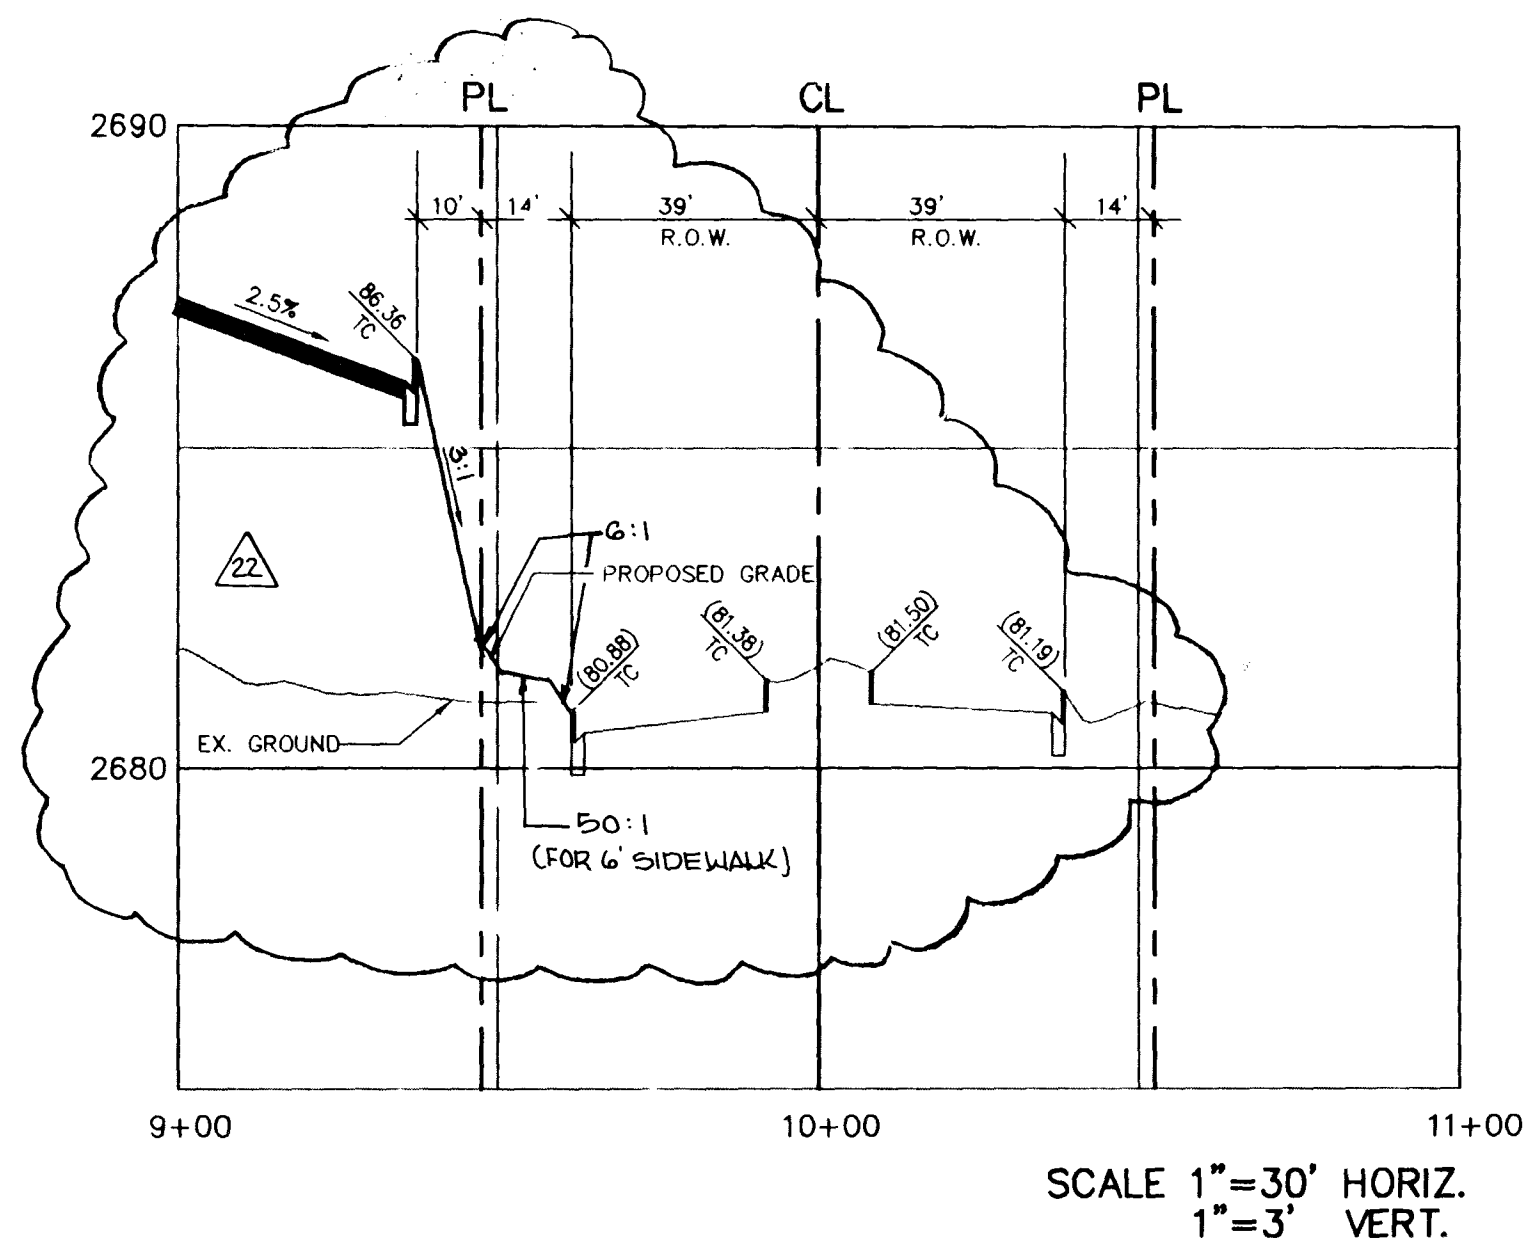


SECTION CANYON RUN DRIVE
STA. 21+00.00

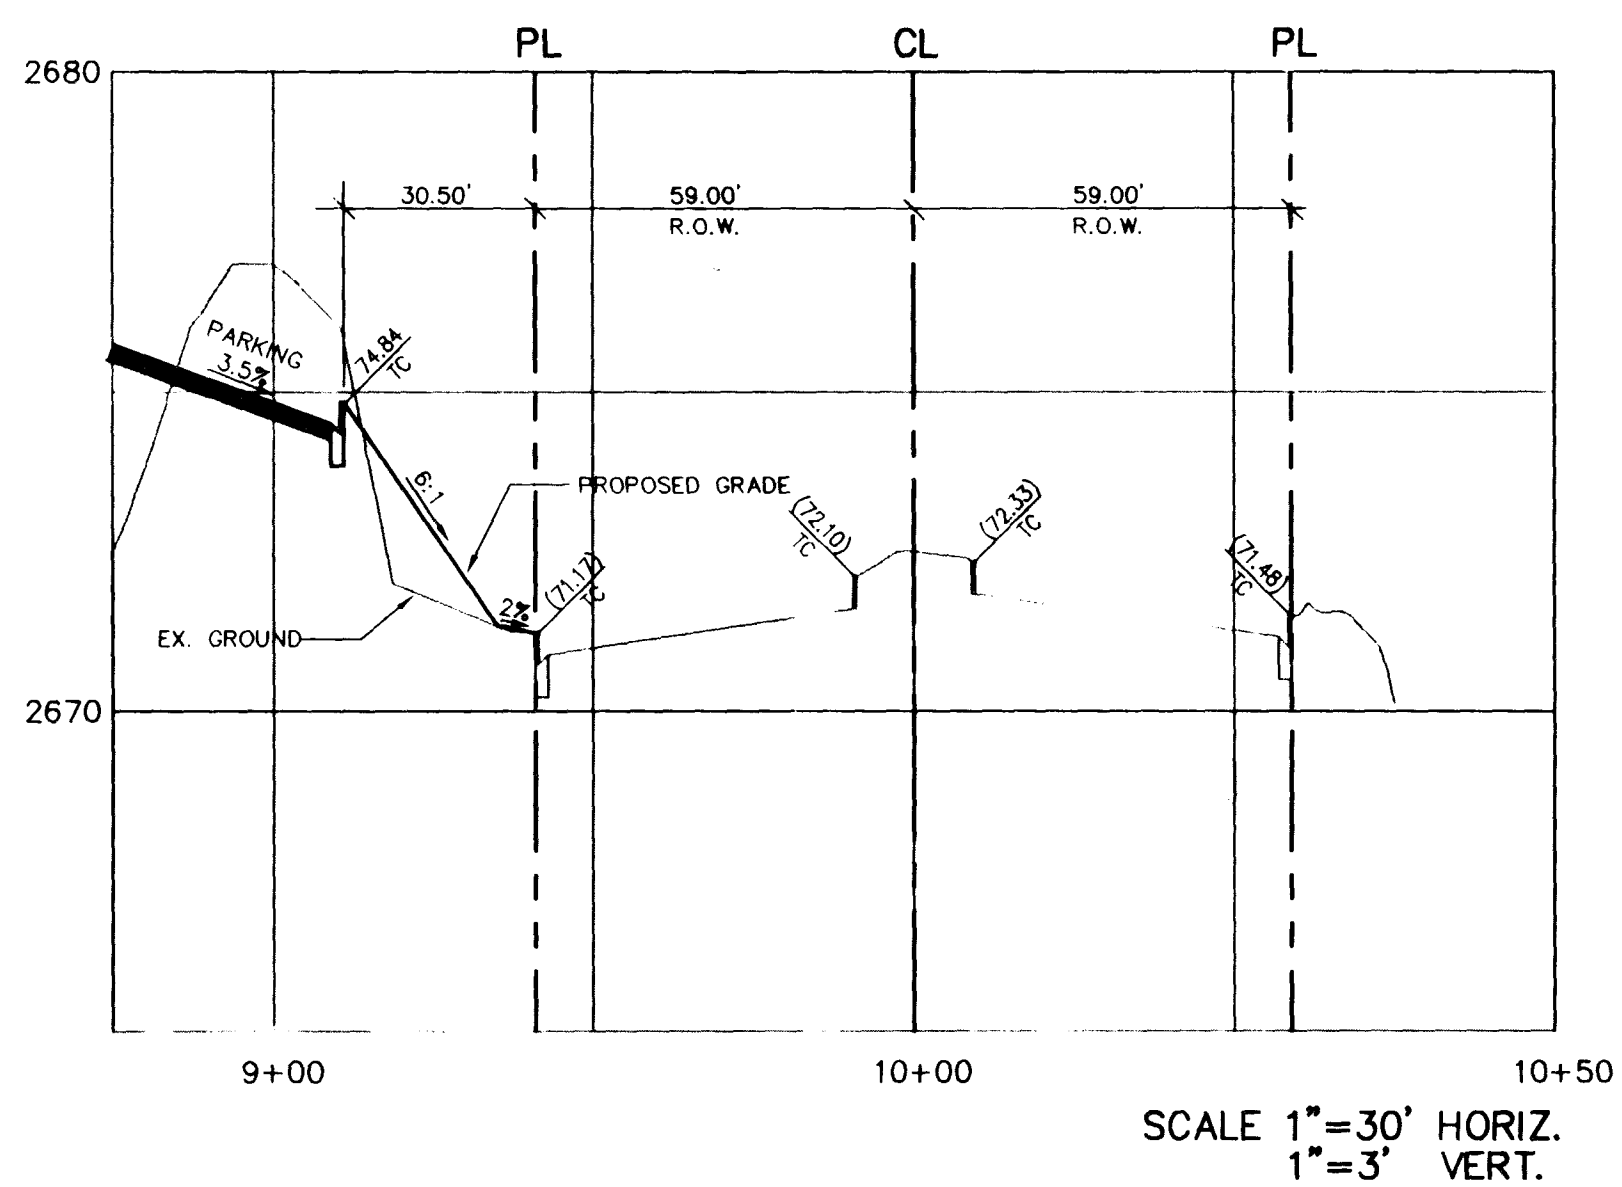


SECTION RAMPART BLVD.
STA. 16+25.00

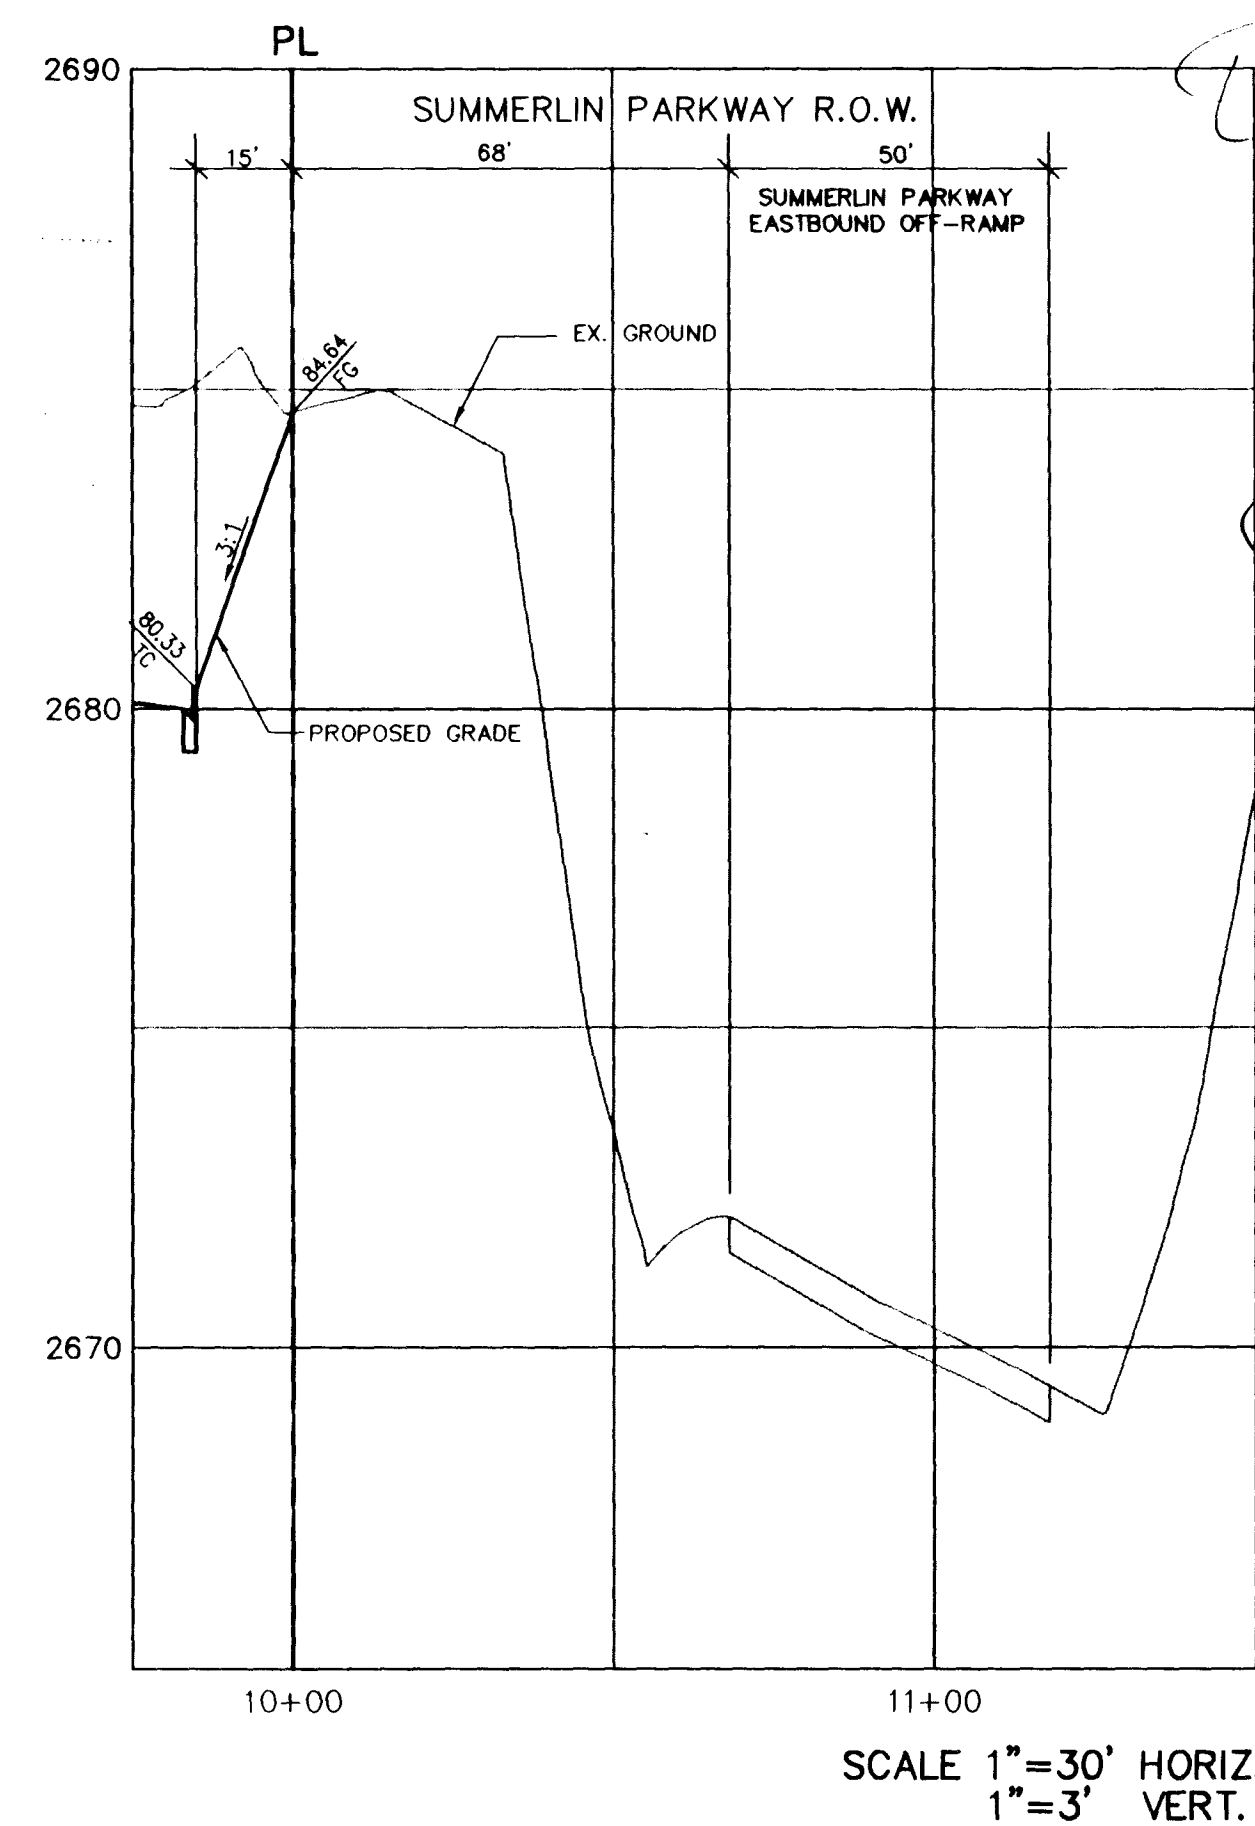


SECTION SUMMERLIN PKWY.
EAST BOUND OFF-RAMP

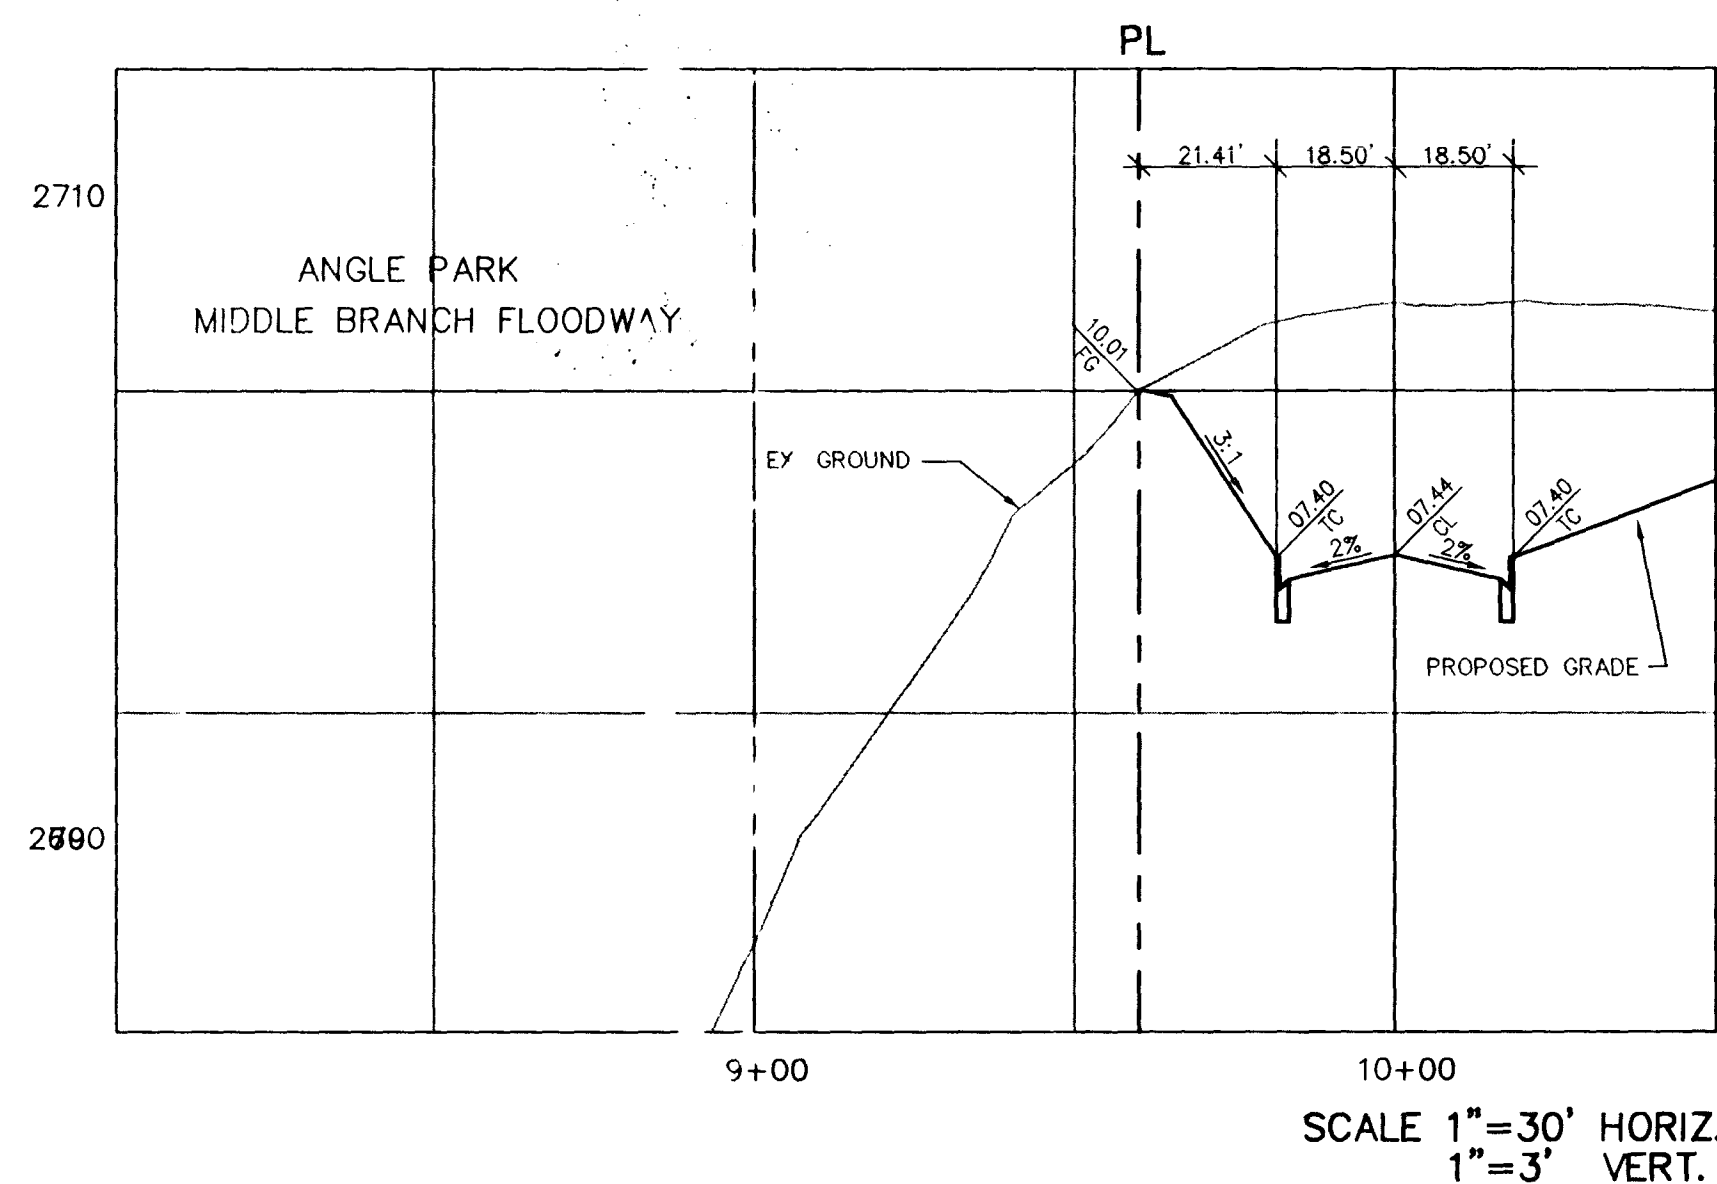


NORTH PROPERTY LINE

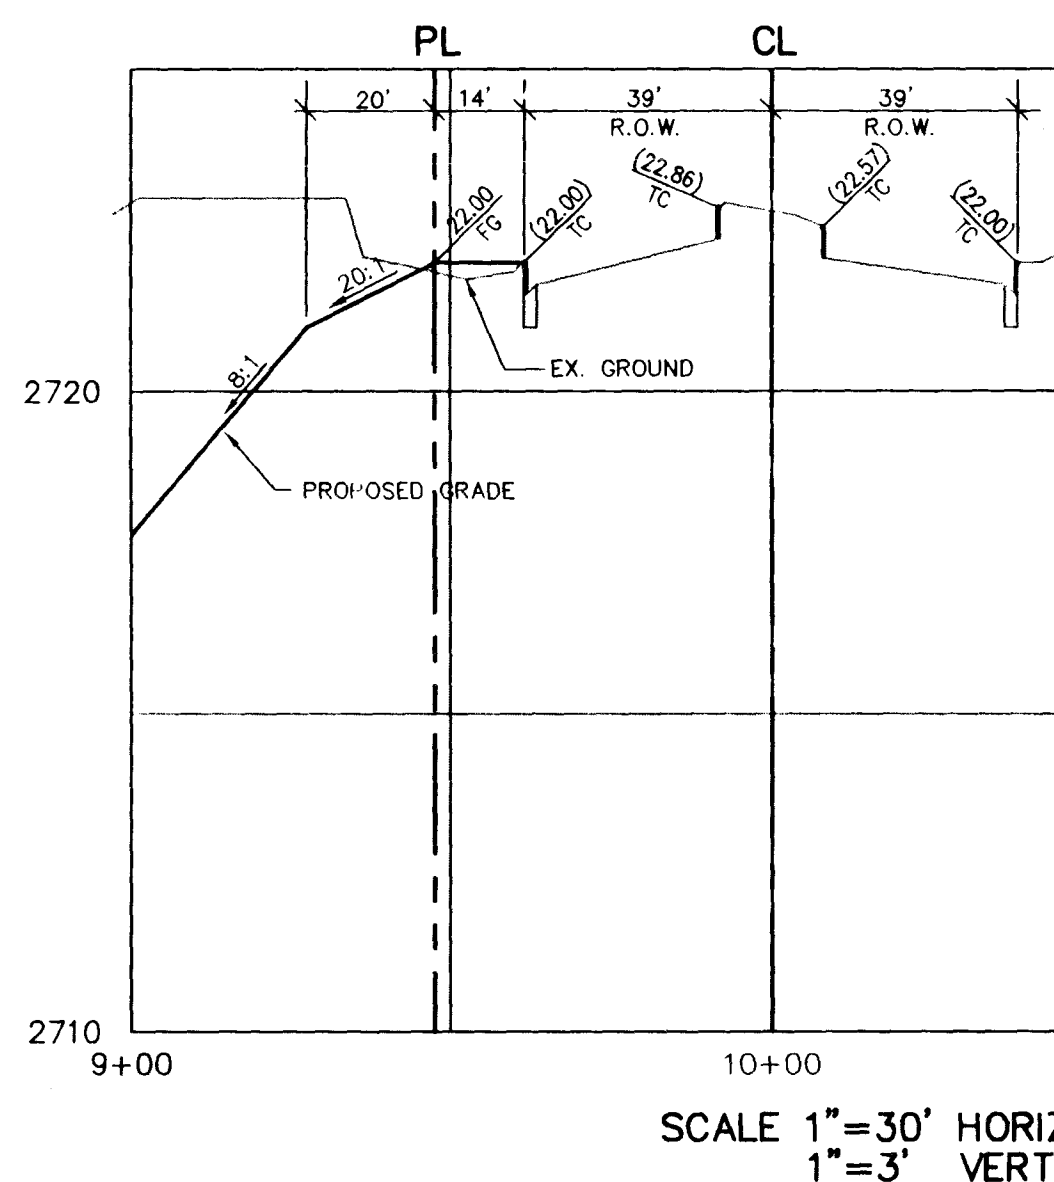


SECTION CANYON RUN DR.
STA. 8+27.63

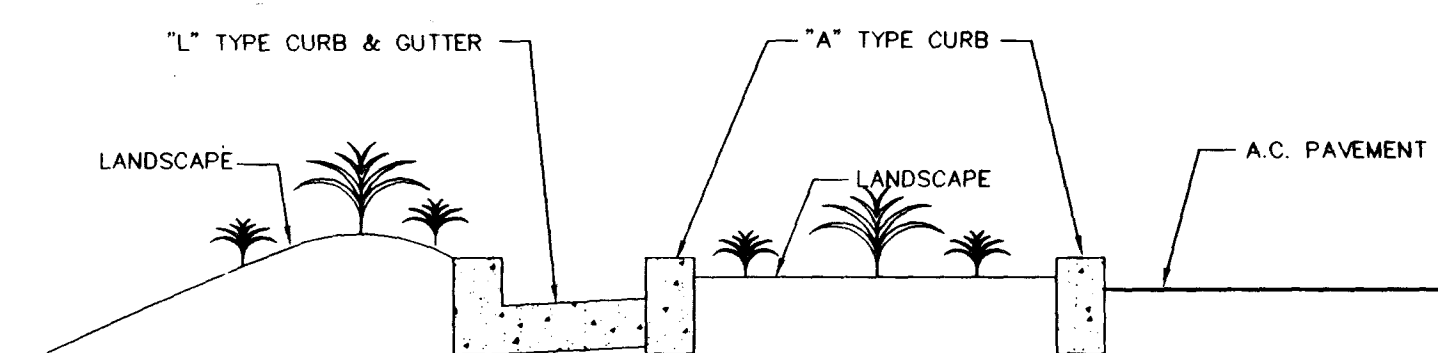


PARKING LOT MEDIAN ISLANDS

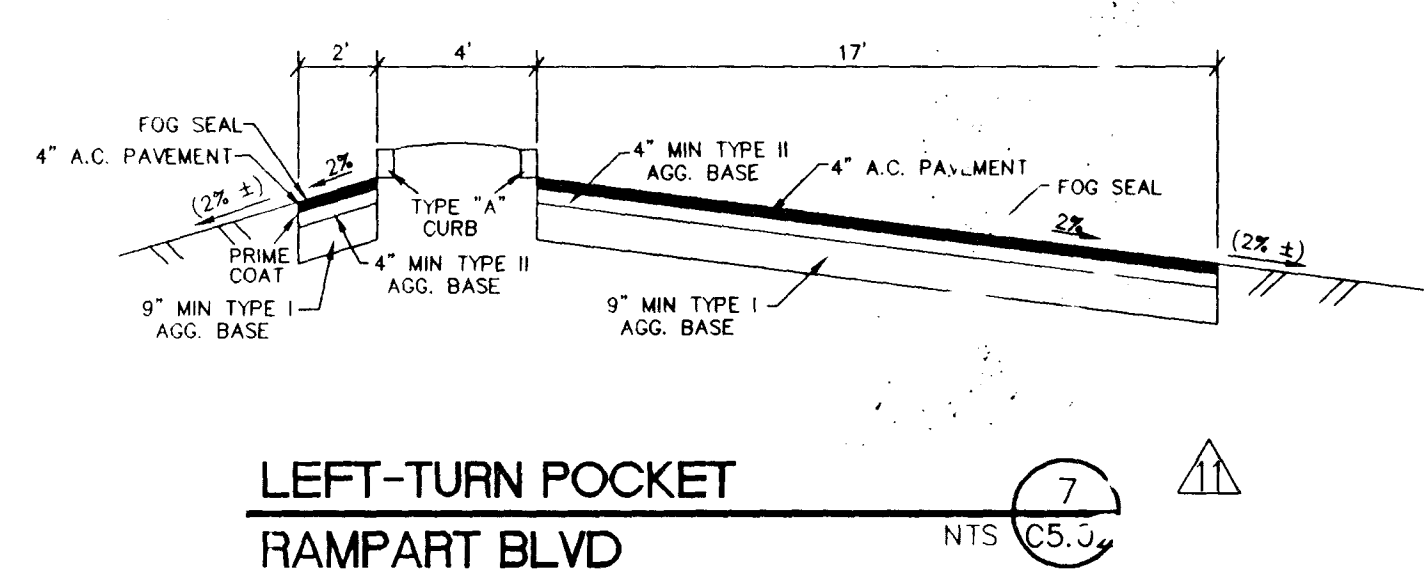


LEFT-TURN POCKET
RAMPART BLVD

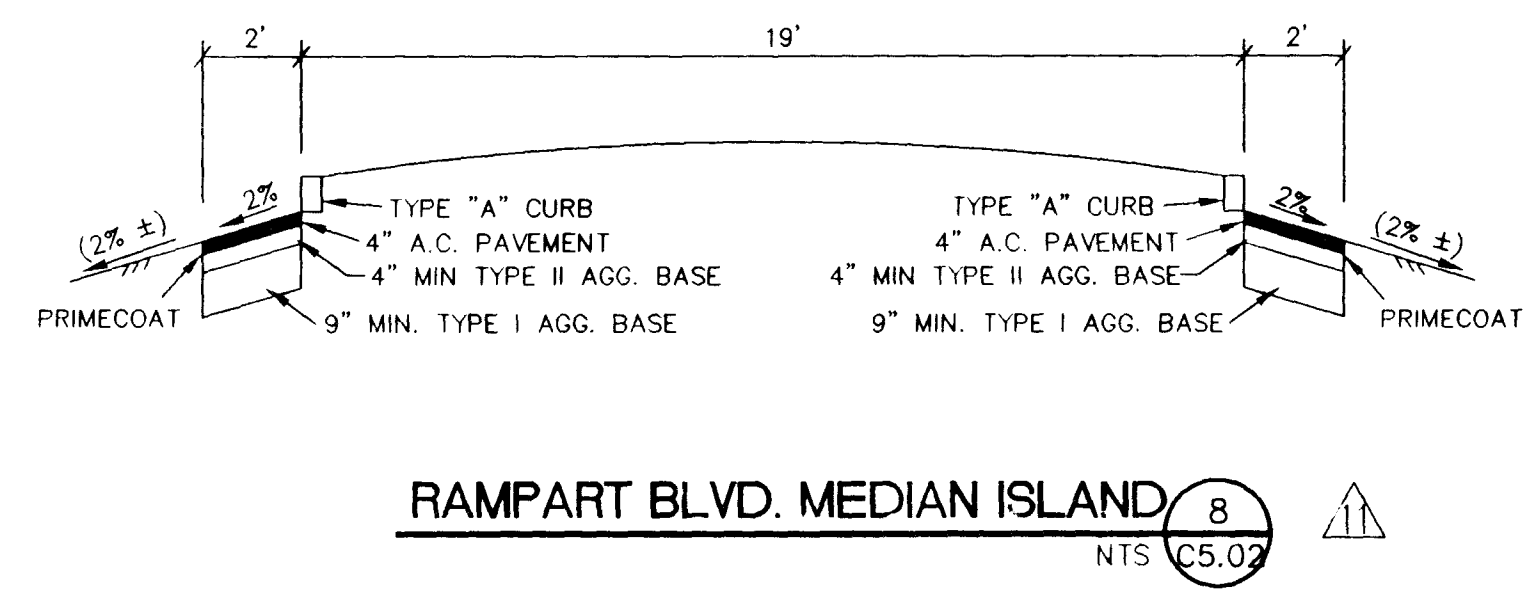


RAMPART BLVD. MEDIAN ISLAND

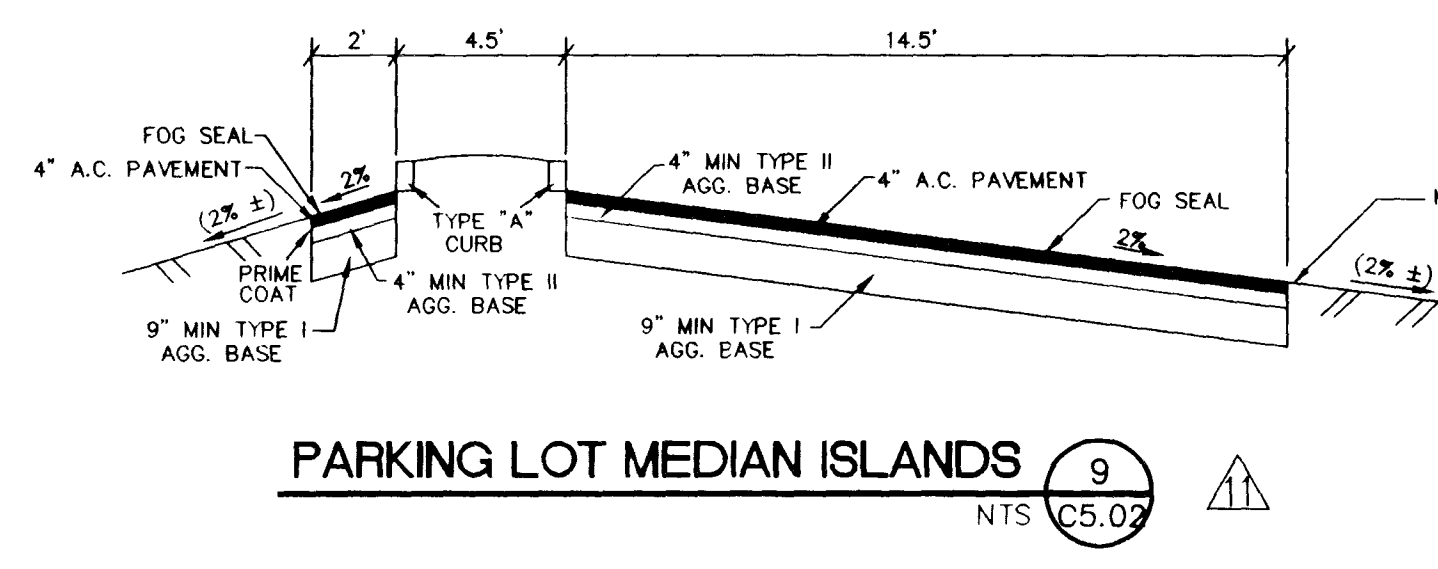

PARKING LOT MEDIAN ISLANDS

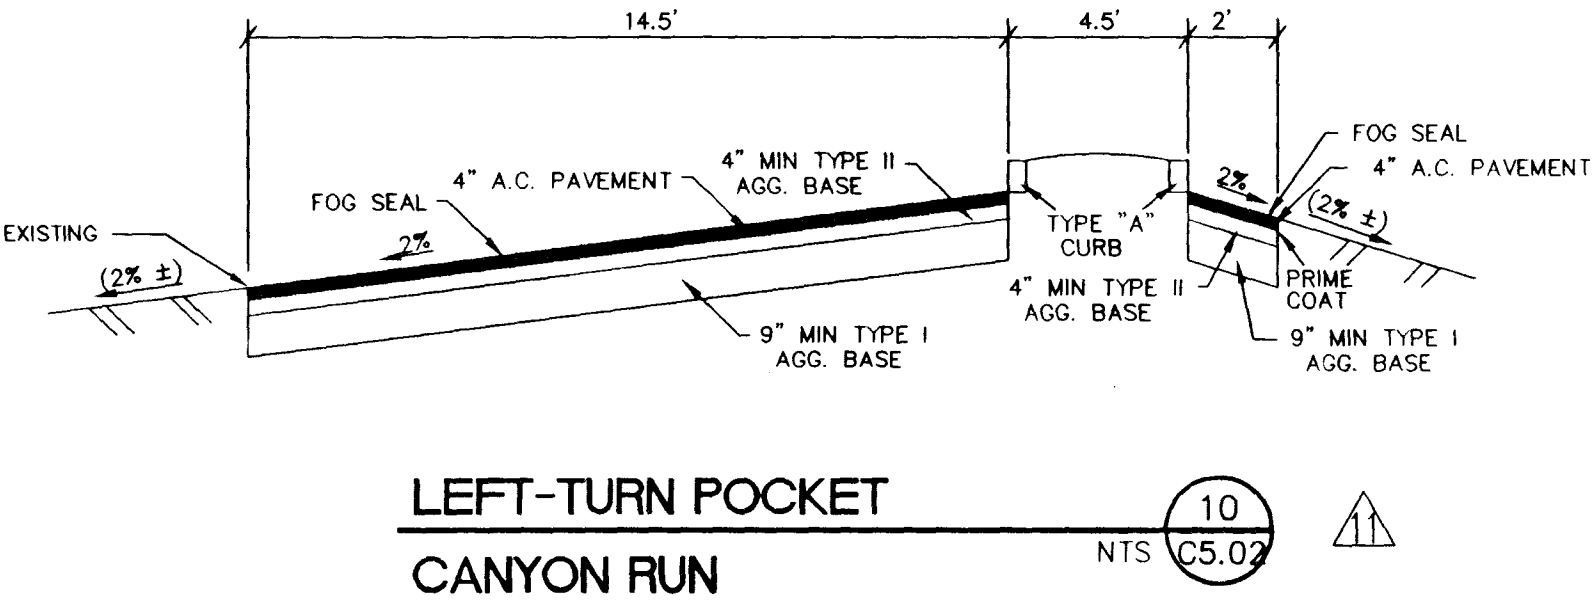

LEFT-TURN POCKET
CANYON RUN

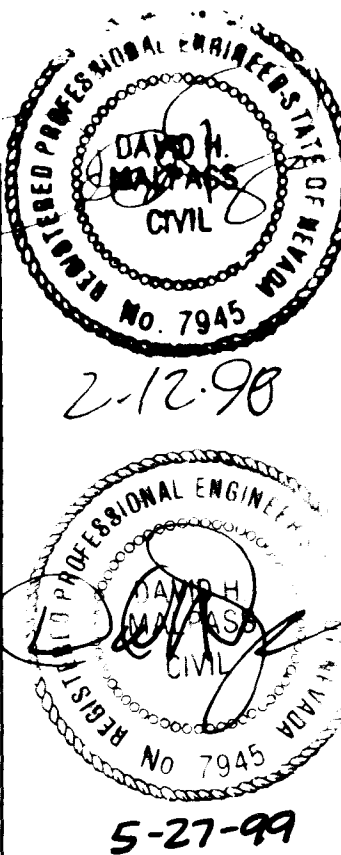

PAUL STEELMAN LTD
ARCHITECTURE PLANNING
1150 S. DESSERT BLVD. LAS VEGAS, NEVADA 89102
PHONE 702-873-0221 FAX 702-873-2105

MARTIN & MARTIN
CIVIL ENGINEERS
1809 SOUTH JONES BLVD.
SUITE B
LAS VEGAS, NEVADA 89103
PHONE (702) 248-8000

THE RESORT AT SUMMERLIN
HOTEL, CASINO & ENTERTAINMENT COMPLEX
LAS VEGAS, NEVADA
DRAWING NO. 107-42830-01
DATE 2-11-98
SCALE 1/4\"/>

DATE 2-11-98
SCALE 1/4\"/>

CROSS SECTIONS

SHEET NUMBER
C5.02
SHEET 28 OF 32
REVISION
ISSUED FOR
CONTRACT
BULLETIN #8
107-42830

