

LEGEND

Table with columns for EXISTING and PROPOSED, listing various utility lines (water, sewer, gas, power, etc.) and their symbols.

AVOID CUTTING UNDERGROUND UTILITY LINES. IT'S COSTLY. Call before you Dig- 1-800-227-2600


CITY OF LAS VEGAS FIRE MARSHALL DATE

AVOID OVERHEAD POWER LINE CONTACT Call before you OVERHEAD 1-702-593-6111

SUMMERLIN PARKWAY EASTBOUND OFF-RAMP

SUMMERLIN PARKWAY EASTBOUND ON-RAMP

REVISIONS 12-11-98 ADD SPEED HUMP N/A/B 2-11-99 SIDEWALK REVISION N/A/B

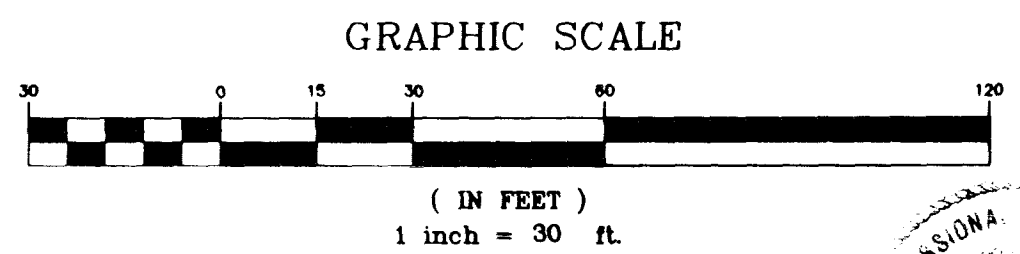

BASIS OF BEARING

NORTH 01°53'54" WEST, BEING THE CENTERLINE OF RAMPART BLVD. AS PER A MAP IN FILE 82, PAGE 6...

BENCHMARK

0LV00 30SEE6, BEING A RIVET AND PLATE, NEVADA POWER VAULT #UJ-795, 9201, SUMMERLIN PARKWAY.

ELEVATION CONSTRUCTION NOTES

- 1. INSTALL "L" TYPE CURB AND GUTTER PER SUMMERLIN STD. DWG. NO. S-47.
2. INSTALL "A" TYPE CURB PER SUMMERLIN STD. DWG. NO. S-52.
3. INSTALL 8" CROSS GUTTER PER SUMMERLIN STD. DWG. NO. S-64.
4. INSTALL 2" A.C. PAVEMENT OVER 4" TYPE II AGG. BASE COURSE, AND 6" TYPE I AGG. SUBGRADE. (COMPACTED 95%).
5. INSTALL 3" A.C. PAVEMENT OVER 4" TYPE II AGG. BASE COURSE AND 6" TYPE II AGG. SUBGRADE. (COMPACTED 95%).
6. INSTALL 2' CONCRETE CHANNEL PER DETAIL (C5.01)
7. INSTALL 10' WIDE GROUDED RIP RAP (RIVER ROCK, D50 = 6") CHANNEL WITH DEPRESSED CURB ON EITHER END. SEE DETAIL (C5.01)
8. INSTALL 3' CONCRETE VALLEY GUTTER PER DETAIL (C5.01)
9. INSTALL 4" CONCRETE SIDEWALK PER SUMMERLIN STD. DWG. NO. S-72. (MIN. CROSS SLOPE=2%).
10. INSTALL 20 LF OF DEPRESSED "L" TYPE CURB AND GUTTER PER SUMMERLIN STD. DWG. NO. S-47.
11. INSTALL 4" A.C. PAVEMENT, OVER 4" TYPE II AGG. BASE, OVER 9" TYPE I AGG. BASE PER SUMMERLIN STD. DWG. NO. S-5.
12. INSTALL CASE I SIDEWALK RAMP PER SUMMERLIN DWG. NO. S-77. (A&B DIMENSIONS AS SHOWN). SEE DETAIL (C5.01)
13. SAWCUT AND MATCH EXISTING A.C. PAVEMENT.
14. INSTALL 5'x5' TYPE "A" CURB PER SUMMERLIN STD. DWG. NO. S-52 FOR TREE PLANTER.
15. INSTALL SIDEWALK UNDERDRAIN PER CLARK COUNTY AREA STD. DWG. NO. 236.
16. INSTALL SIDEWALK RAMP (MAXIMUM SLOPE=12:1).
17. INSTALL 6" CONCRETE WITH 6"x6"-10/10 W.W.F. ON 6" TYPE II AGGREGATE BASE. (JOINT SPACING TO BE MAXIMUM 12').
18. CONSTRUCT FIRE LANE WITH NETLON ADVANCED TURF PER DETAIL (C5.01)

SIGNAGE AND STRIPING NOTES

- 1. INSTALL 4" WHITE PAINTED PARKING STALL LINES (TYPICAL PARKING STALL=9'x19')
2. INSTALL 10' WIDE CROSSWALK USING 12" WHITE COLD POLYMER FILM.
3. INSTALL 12" WHITE COLD POLYMER FILM STOP BAR.
4. INSTALL COLD POLYMER FILM PAVEMENT MARKING.
5. INSTALL R1-1 "STOP" SIGN (30"x30").
6. INSTALL R3-7(R) SIGN (30"x30").
7. INSTALL W4-2(R) SIGN (30"x30").
8. INSTALL TYPE 4 LANE LINE PER CLARK COUNTY AREA STD. DWG. NO. 244A.
9. INSTALL ADDED TURN LANE PER CLARK COUNTY AREA STD. DWG. NO. 246.
10. INSTALL TYPE I CENTERLINE PER CLARK COUNTY AREA STD. DWG. NO. 244.
11. INSTALL R4-7(R) SIGN (24"x30") AND R4-7P(R) (24"x18").
12. INSTALL TYPE II CENTERLINE PER CLARK COUNTY AREA STD. DWG. NO. 244.
13. INSTALL R6-1(R) SIGN (36"x12").
14. INSTALL R3-2A(L) SIGN (24"x30").
15. INSTALL 4" WHITE PAINTED MOTORCYCLE PARKING STALL LINES. (TYPICAL MOTORCYCLE PARKING STALL = 4'x8')
16. INSTALL RED PAINT ON CURB FOR FIRELANE.
17. INSTALL "FIRELANE-NO PARKING" SIGN (18"x24") REFER TO DETAIL. (C5.01)
18. INSTALL R3-4 SIGN (30"x30")
19. INSTALL R7-8 SIGN (12"x18") *\$100.00 IF USED BY OTHERS.*
20. INSTALL 8' WIDE AISLE WITH 4" WHITE PAINTED HATCH LINES 3' O.C. 45'.
21. INSTALL R8-3A SIGN (24"x24") EVER 150' MINIMUM.

SEE SHEET C2.04

MATCH LINE

SUMMERLIN PARKWAY R.O.W.

SEE SHEET C2.01

REFER TO C2.09 FOR CURVE TABLE

Handwritten signature and date 2/18/99



PAUL STEELMAN LTD ARCHITECTURE PLANNING ENGINEERING

MARTIN & MARTIN CIVIL ENGINEERS

THE RESORT AT SUMMERLIN HOTEL, CASINO & ENTERTAINMENT COMPLEX

Table with columns for DATE, SCALE, REVISION, and SHEET TITLE AND LOCATION.

HORIZONTAL CONTROL

SHEET NUMBER C2.02 SHEET 4 OF 32

