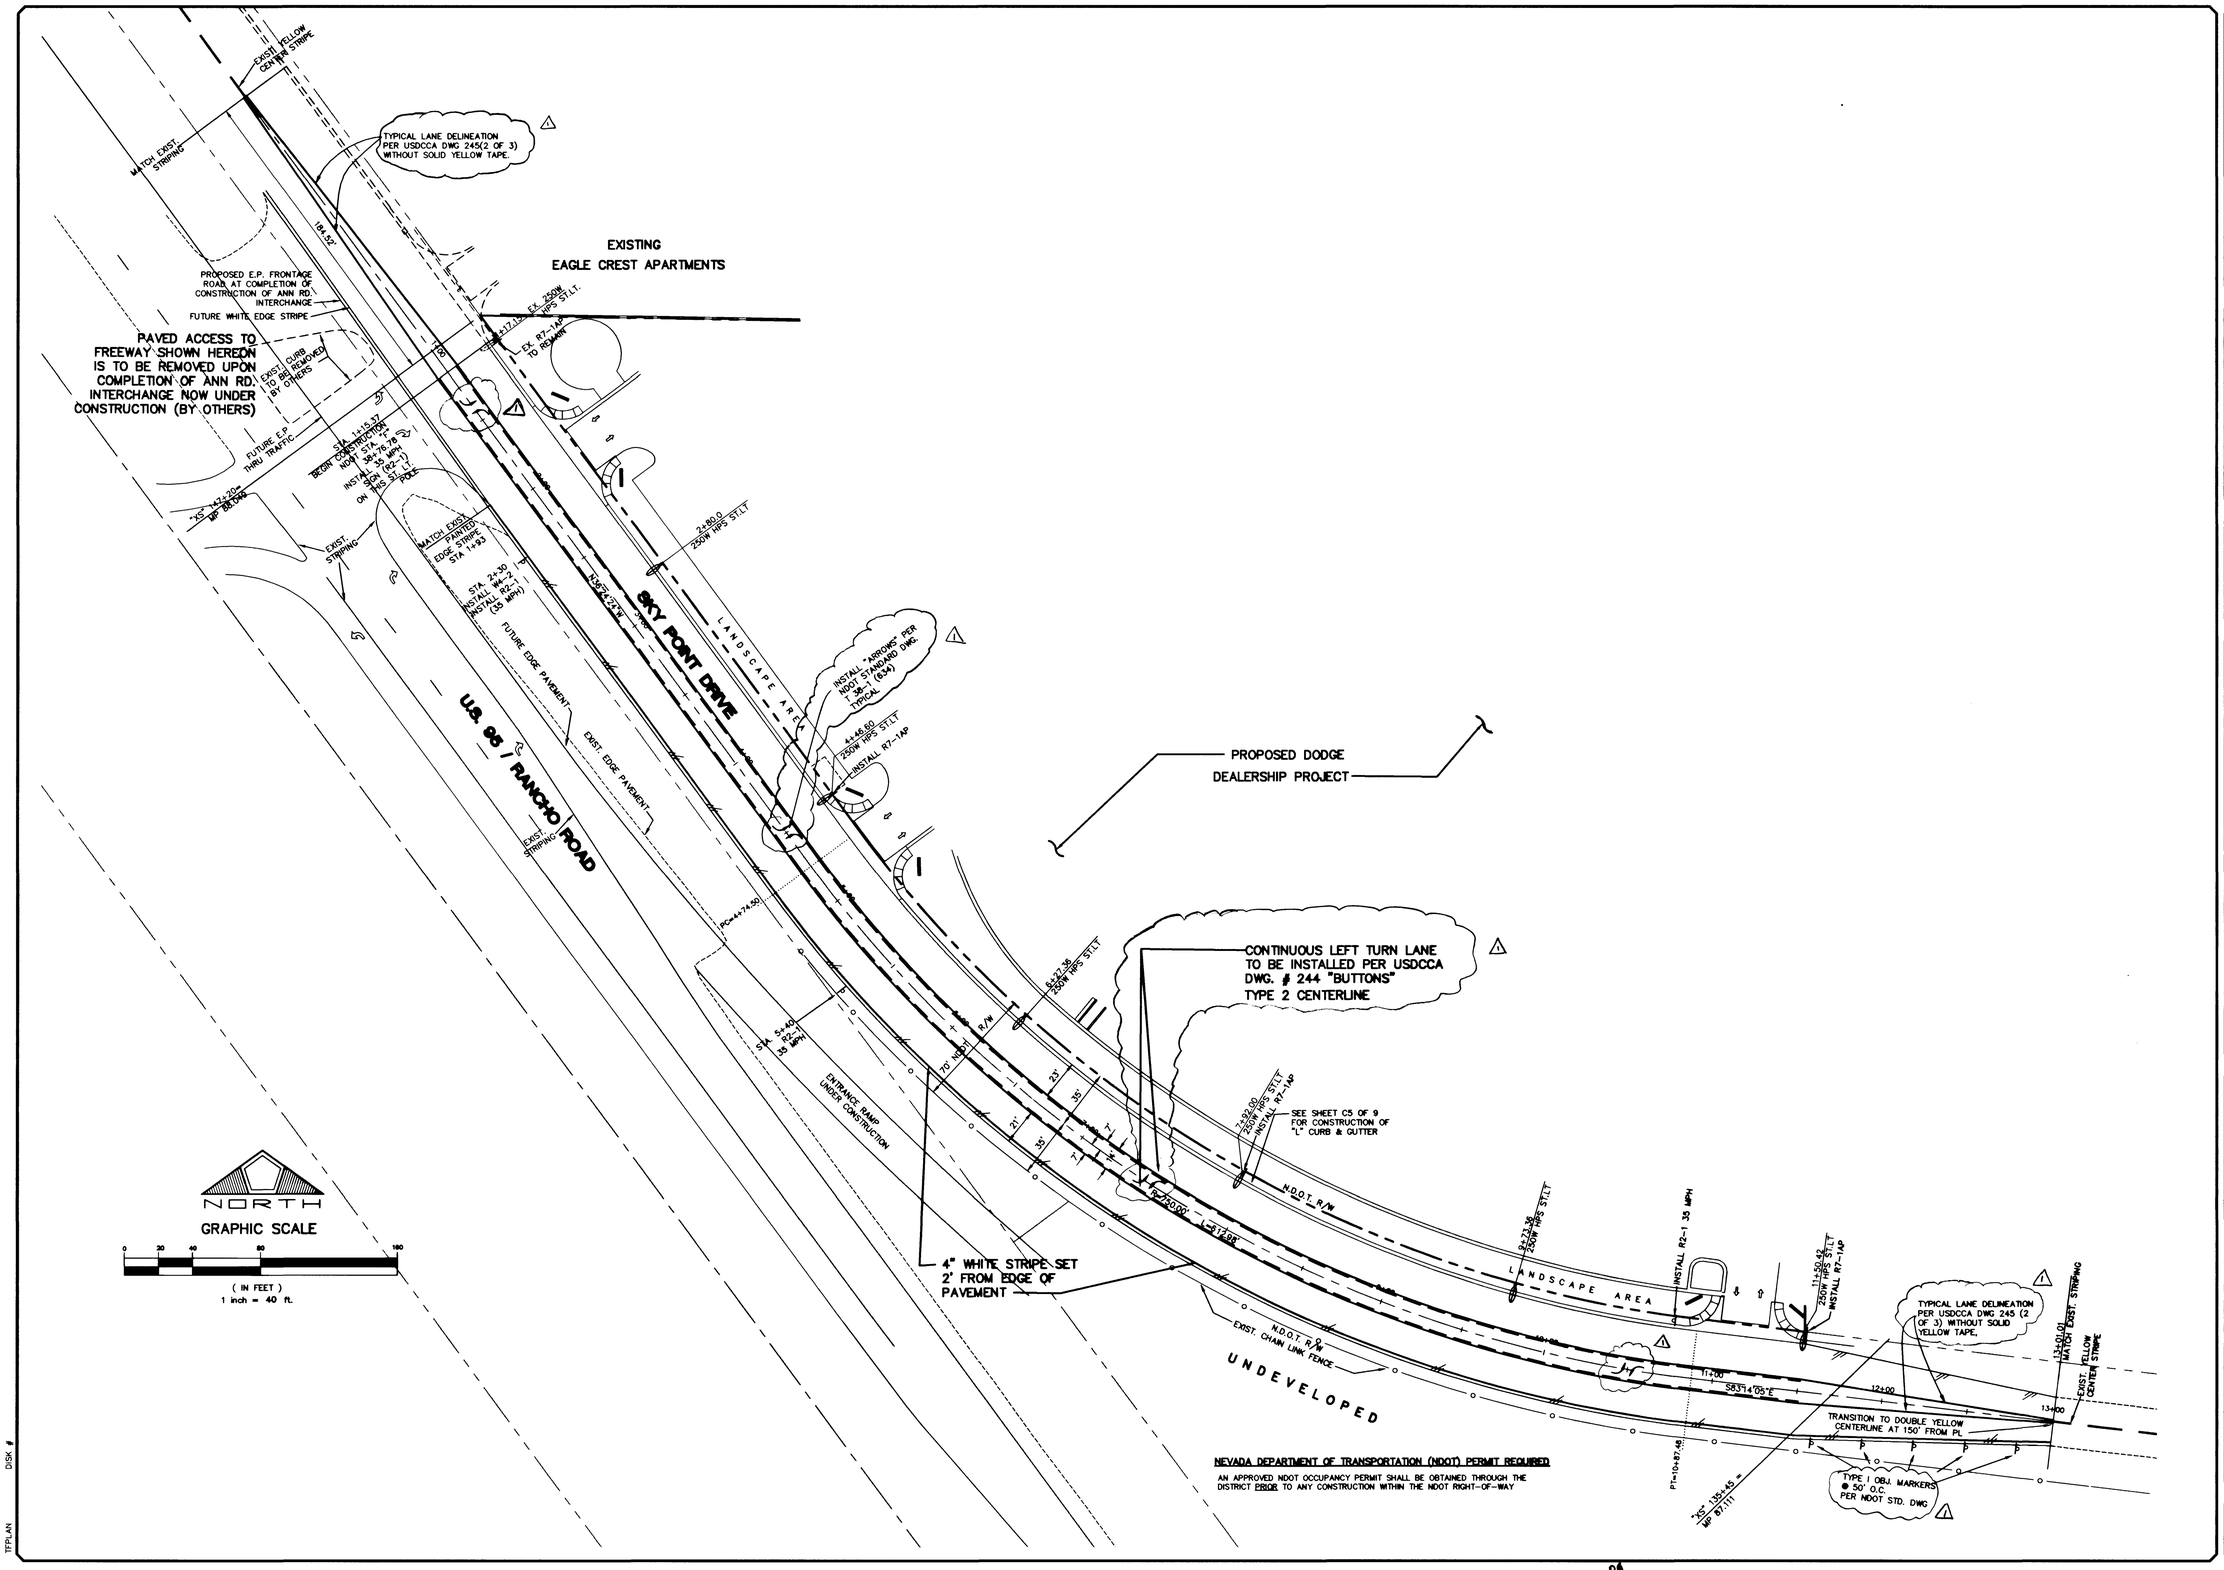

NEVADA DEPARTMENT OF TRANSPORTATION (NDOT) PERMIT REQUIRED

AN APPROVED NDOT OCCUPANCY PERMIT SHALL BE OBTAINED THROUGH THE DISTRICT PRIOR TO ANY CONSTRUCTION WITHIN THE NDOT RIGHT-OF-WAY

NO.	DESCRIPTION	DATE	APP'D
1	REVISED PER NDOT REQUIRE	8/13/97	
2	REVISED HORIZONTAL LAYOUT	5/9/97	

RECOMMENDED BY: ENGINEER, CITY OF LAS VEGAS — P. E. — DATE — CIVIL — NO. 10189

8/13/97

DATE :
DRAWN BY :
DESIGNED BY :
CHECKED BY :
JOB NO. : 0210.0010
SCALE : 1"=40'

PENTACORE
CIVIL ENGINEERING • LAND SURVEYING • PLANNING
CONSTRUCTION MANAGEMENT • COST ESTIMATING
6763 WEST CHARLESTON BOULEVARD
LAS VEGAS, NEVADA 89102 (702)258-0115

TOM SAITTA DODGE
DODGE DEALERSHIP
SIGNING AND STRIPING PLAN

SHEET C10 OF 10

1089

107-V2650

Q:\0210\0010\1MPPLANS\TFPLAN Wed Aug 13 10:51:03 1997 NANNY

TFPLAN DISK #

 
NORTH
GRAPHIC SCALE
PENTAGORE
C10