


70721\503 PLOTTED BY: DUANE DATE: 01/23/98 TIME: 14:43 SCALE FACTOR: 1=48 PLOTTED: APLLOT

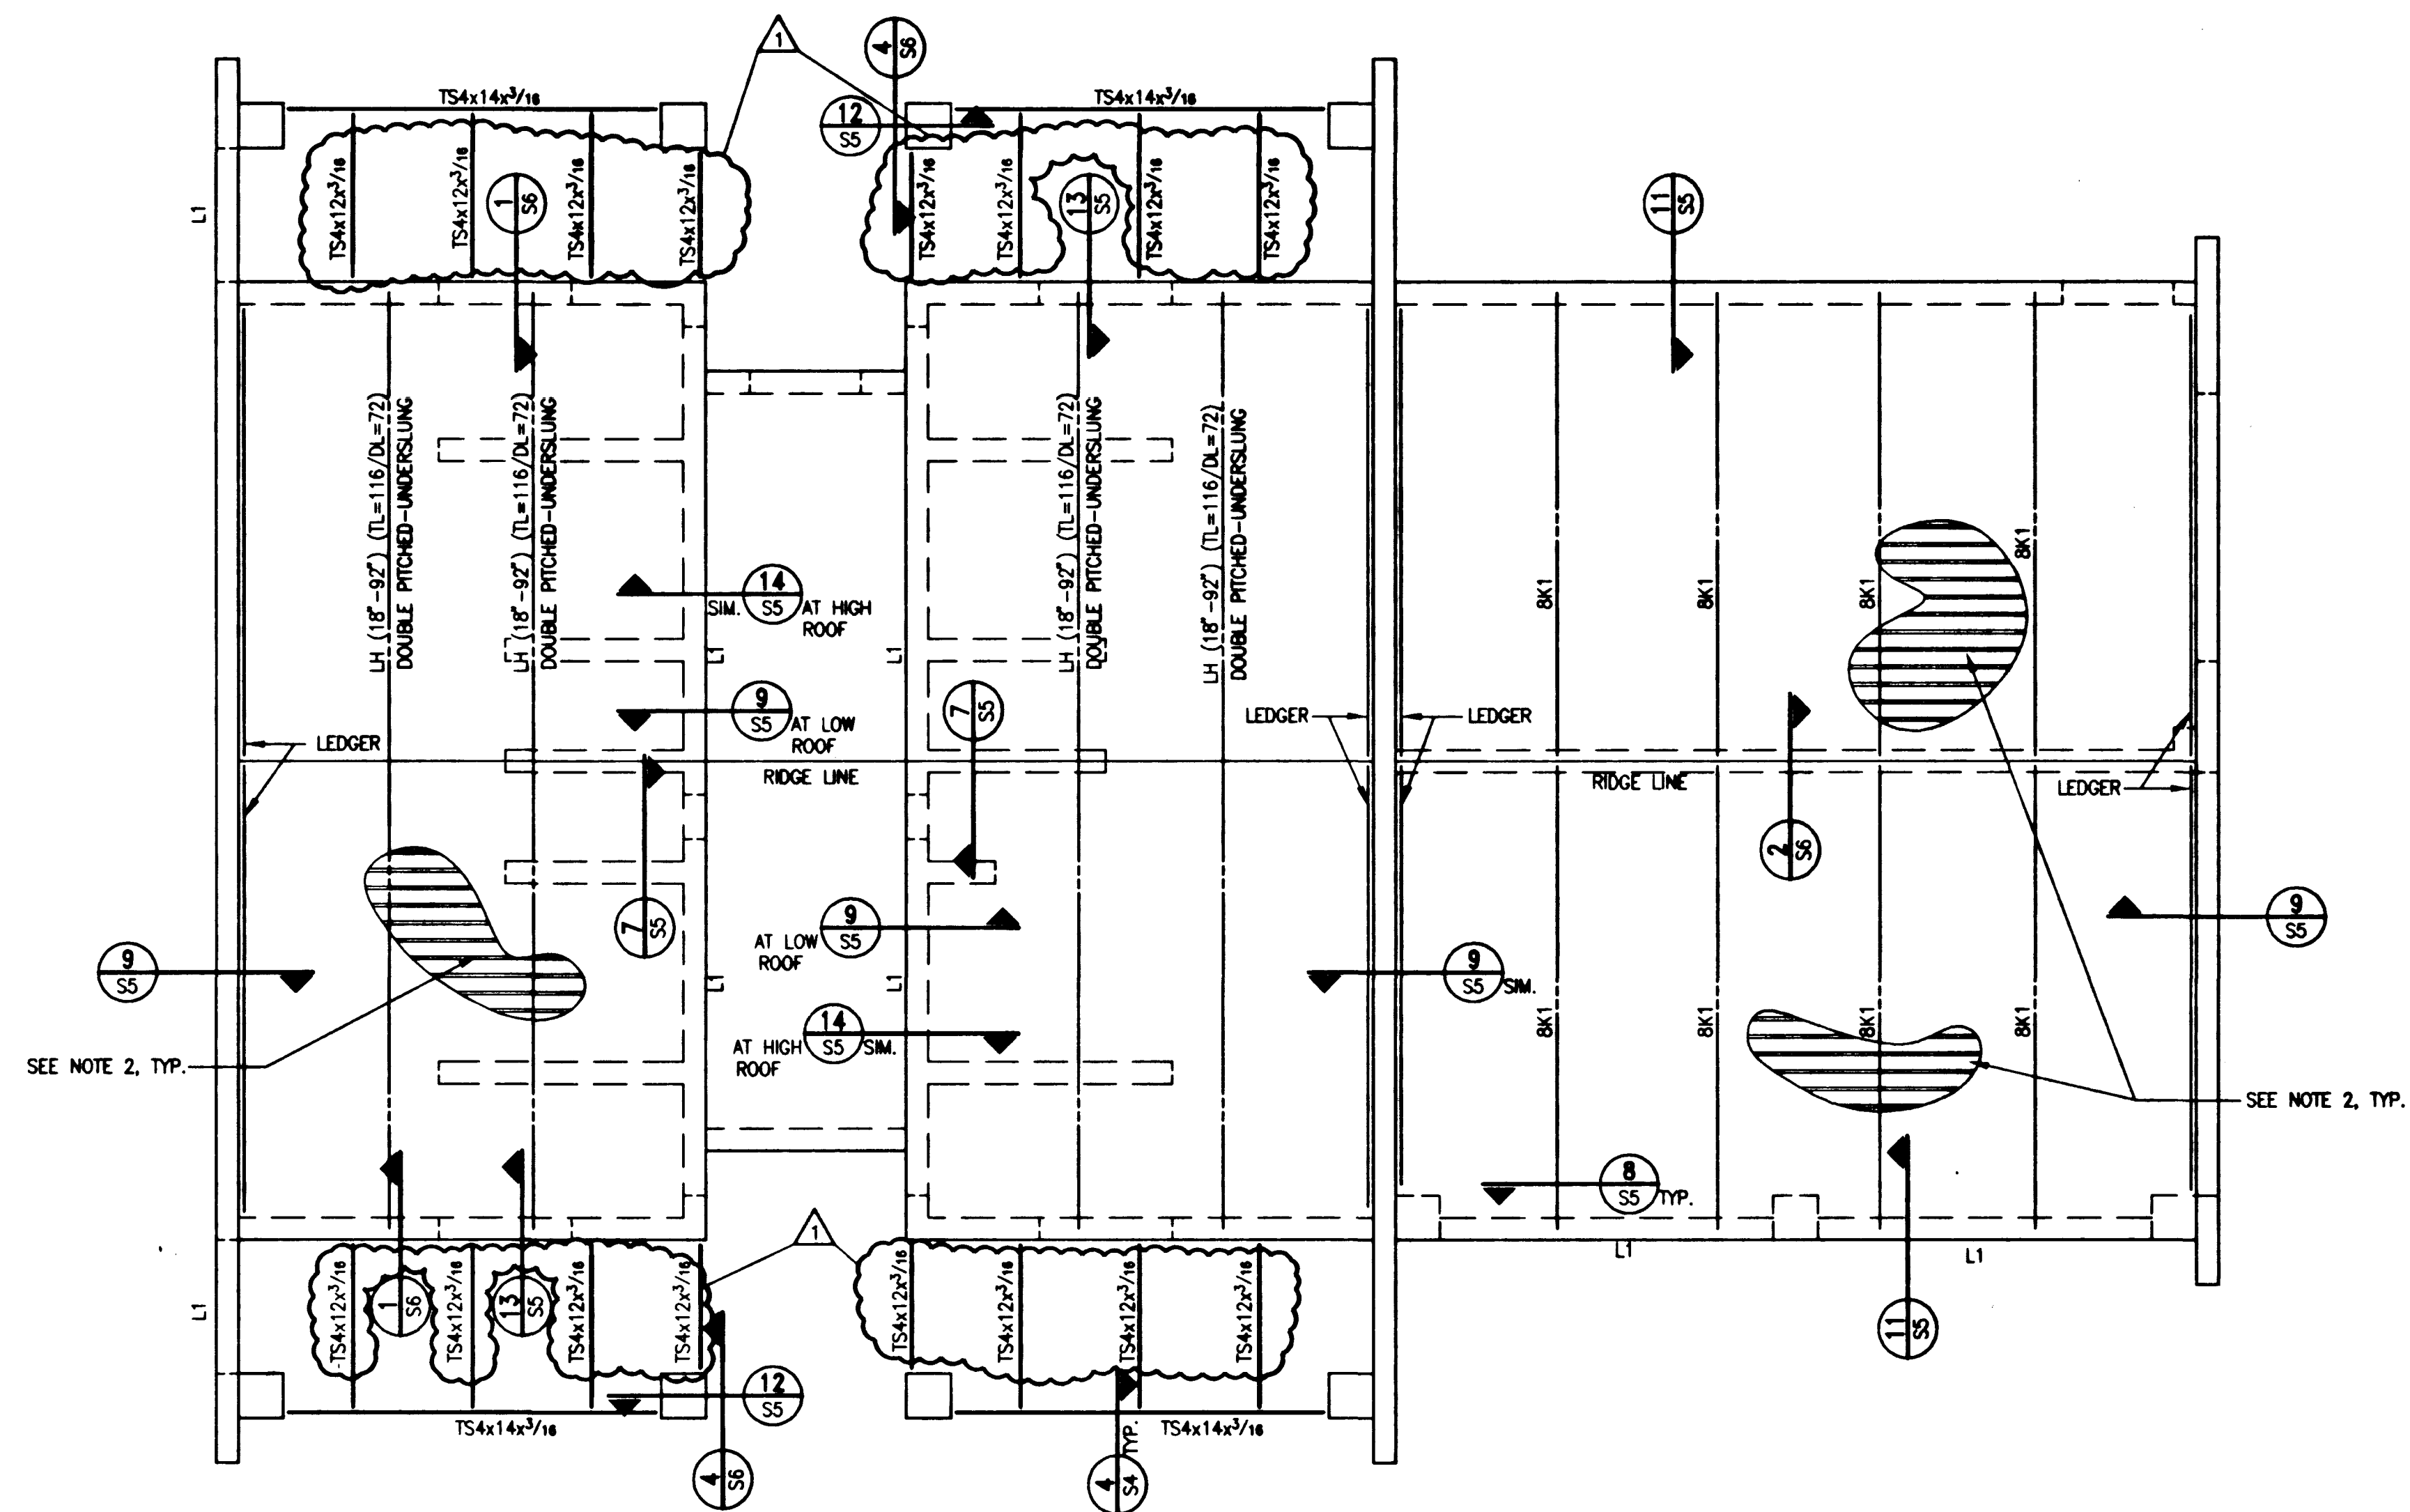

ROOF FRAMING PLAN

SCALE : 1/4" = 1'-0"

ROOF FRAMING NOTES:

1. BOTTOM OF STEEL DECK VARIES. REF ARCHITECTURAL DWGS. FOR ROOF ELEVATIONS.
2. ROOF SHALL BE 1 1/2" x 20 GA. TYPE "B" VERO DECK OR EQUAL. REF. ARCHITECTURAL DRAWINGS FOR ROOFING, ETC.
3. WELD DECK USING 1/2" DIA. NET EFFECTIVE PUDDLE WELDS:
 - a. PERPENDICULAR BEARINGS: (5)-WELD PER SHEET TO SUPPORT
 - b. PARALLEL BEARINGS AND EDGES: 24" O.C.
 - c. SEAMS: BUTTON PUNCH SIDE SEAMS AT 24" O.C.
4. FOR ROOF OPENINGS SEE DET. 10/SS.
5. LINTELS ARE PER STD. DET. 3/SS EXCEPT AS FOLLOWS:
 - L1 #5 J-BARS VERT. AT 8" O.C.




Alternate No. 1

BENNETT & JIMENEZ, INC.
 STRUCTURAL ENGINEERS
 B&J JOB NO.: 70721
 2481 N. Decatur Blvd., Suite B Phone (702) 631-0200
 Las Vegas, NV 89108 FAX (702) 631-0206


S3
 650.41
 DRAWING NO.

DEPARTMENT OF PUBLIC WORKS
 PROJECT: Torrey Pines Park & Ball Field
 SHEET TITLE: PARK-ROOF FRAMING PLAN
 SHEET NO.

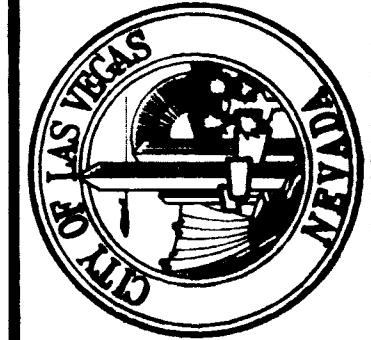

ARCHITECTURAL SERVICES
 DRAWN BY: DUANE
 DESIGN BY: JFJ
 DATE: 7/97

REVISIONS:	DATE:
REMOVED TS AT TRELIS	1/23/98

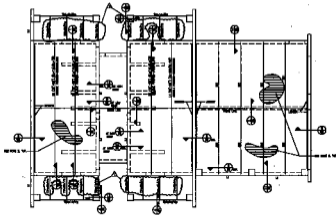







