


FIELD SATELLITE UNITS 'A, B, AND C'

INSTALL TWO (2) RAIN BIRD ESP-SAT-24-TU-86 PEDESTAL MOUNT FIELD SATELLITE UNITS 'A' & 'B' AND ONE (1) RAIN BIRD ESP-SAT-32-TU-86 PEDESTAL MOUNT FIELD SATELLITE UNIT 'C' AS DETAILED. EACH UNIT TO BE PROVIDED WITH ONE (1) MASTER VALVE RELAY AND ONE (1) A1026 TRANSFORMER. CONTRACTOR IS RESPONSIBLE FOR ELECTRICAL CONNECTION TO FIELD SATELLITE UNITS AND CONNECTION OF MAXI COMMUNICATION CABLE FROM CCU TO FIELD SATELLITE UNITS. 120 VOLT ELECTRICAL SERVICE IS LOCATED IN PULL BOX WITHIN 50' OF FIELD SATELLITE UNIT LOCATIONS. CONSTRUCTION PROJECT REPRESENTATIVE TO APPROVE FINAL LOCATION OF FIELD UNITS PRIOR TO INSTALLATION.

CLUSTER CONTROL UNIT (CCU)


INSTALL ONE (1) RAIN BIRD CCU-28-FH-TU-86 PEDESTAL MOUNT CLUSTER CONTROL UNIT (CCU) AS DETAILED. PROVIDE UNIT WITH ONE (1) A1026 TRANSFORMER AND ONE (1) DATA INDUSTRIAL MODEL 1800-011 PULSE OUTPUT TRANSMITTER. UNIT ALSO TO BE PROVIDED WITH AG24-1 120 VOL PROTECTION. CONTRACTOR IS RESPONSIBLE FOR ELECTRICAL AND PHONE CONNECTION TO CCU. 120 VOLT ELECTRICAL AND PHONE SERVICE IS LOCATED IN PULL BOX WITHIN 50' OF CCU LOCATION. CONSTRUCTION PROJECT REPRESENTATIVE TO APPROVE FINAL LOCATION OF CCU PRIOR TO INSTALLATION.

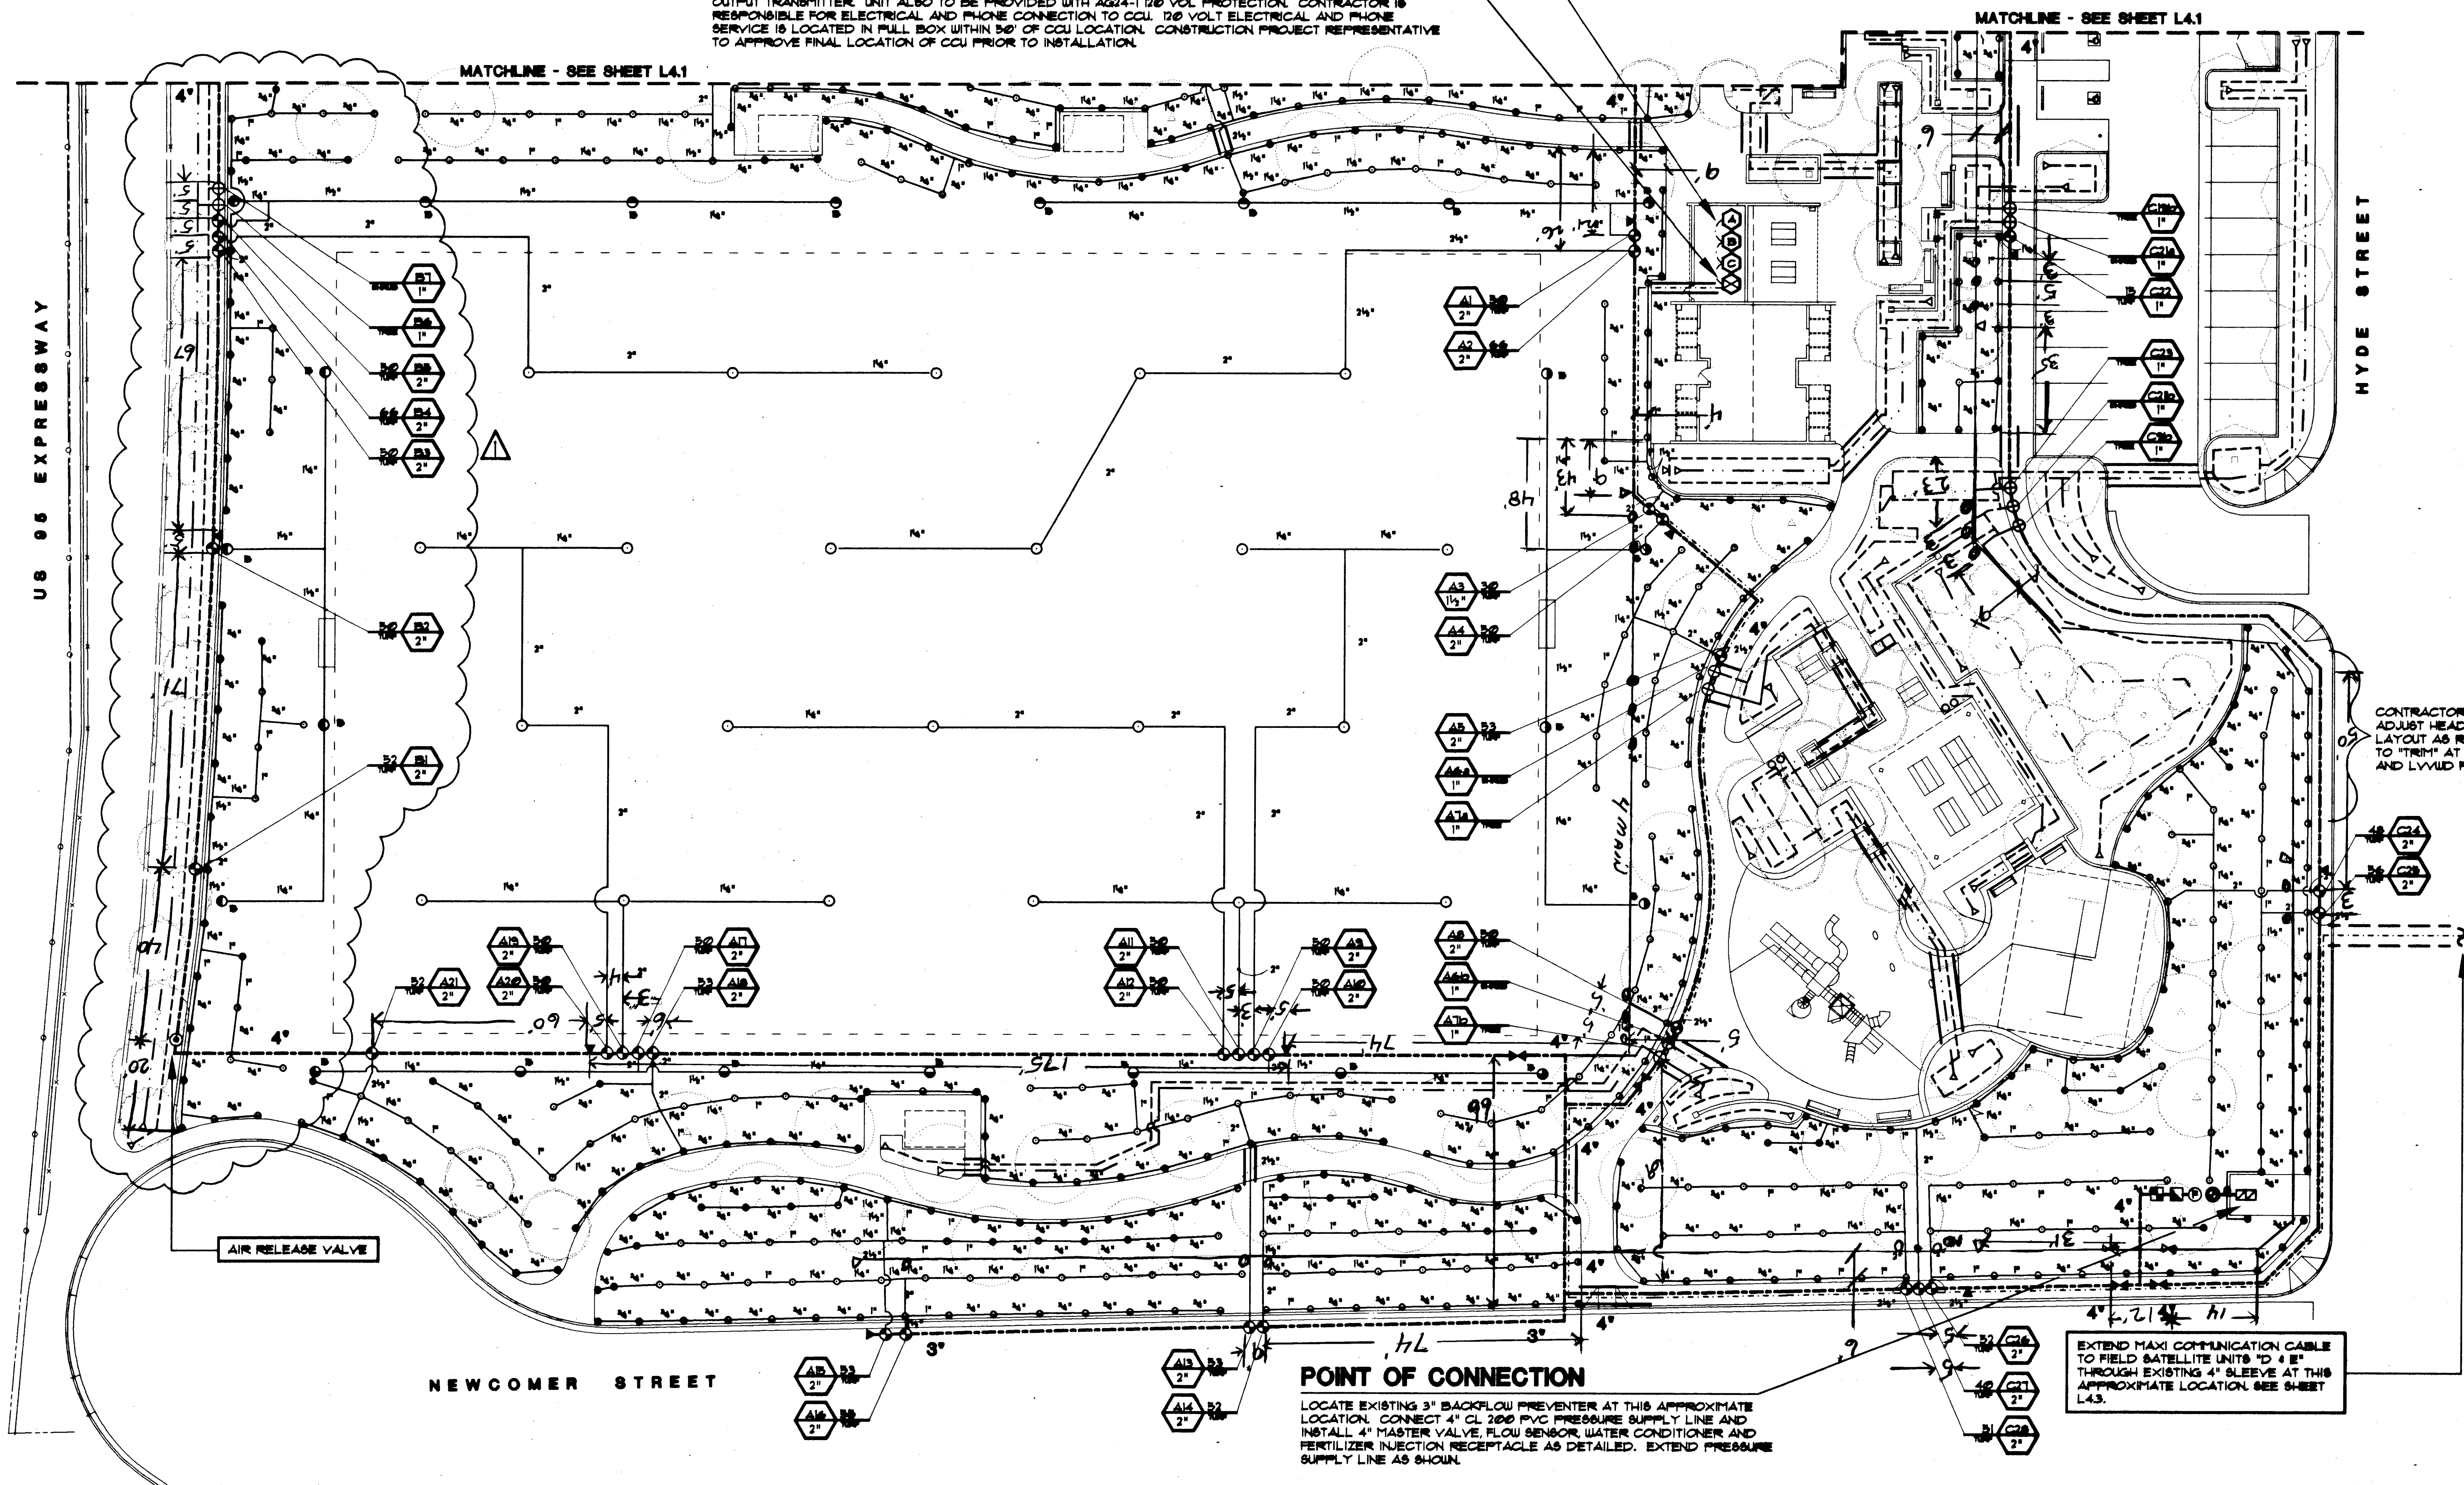

golf course irrigation design
irrigation/water resource
planning and design



18035 w. bernardo drive, #190 san diego, california 92127 (619) 451-1234

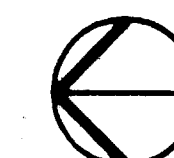


SCALE IN FEET
0 10 20 40 80
1" = 20'-0"

DEPARTMENT OF PARKS & LEISURE ACTIVITIES

ADD ALTERNATE #1
PARK
IRRIGATION PLAN

TORREY PINES PARK
& BALL FIELD

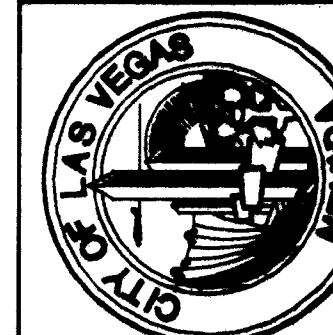






650.41
DRAWING NO. 34
L4.2AA 83














