


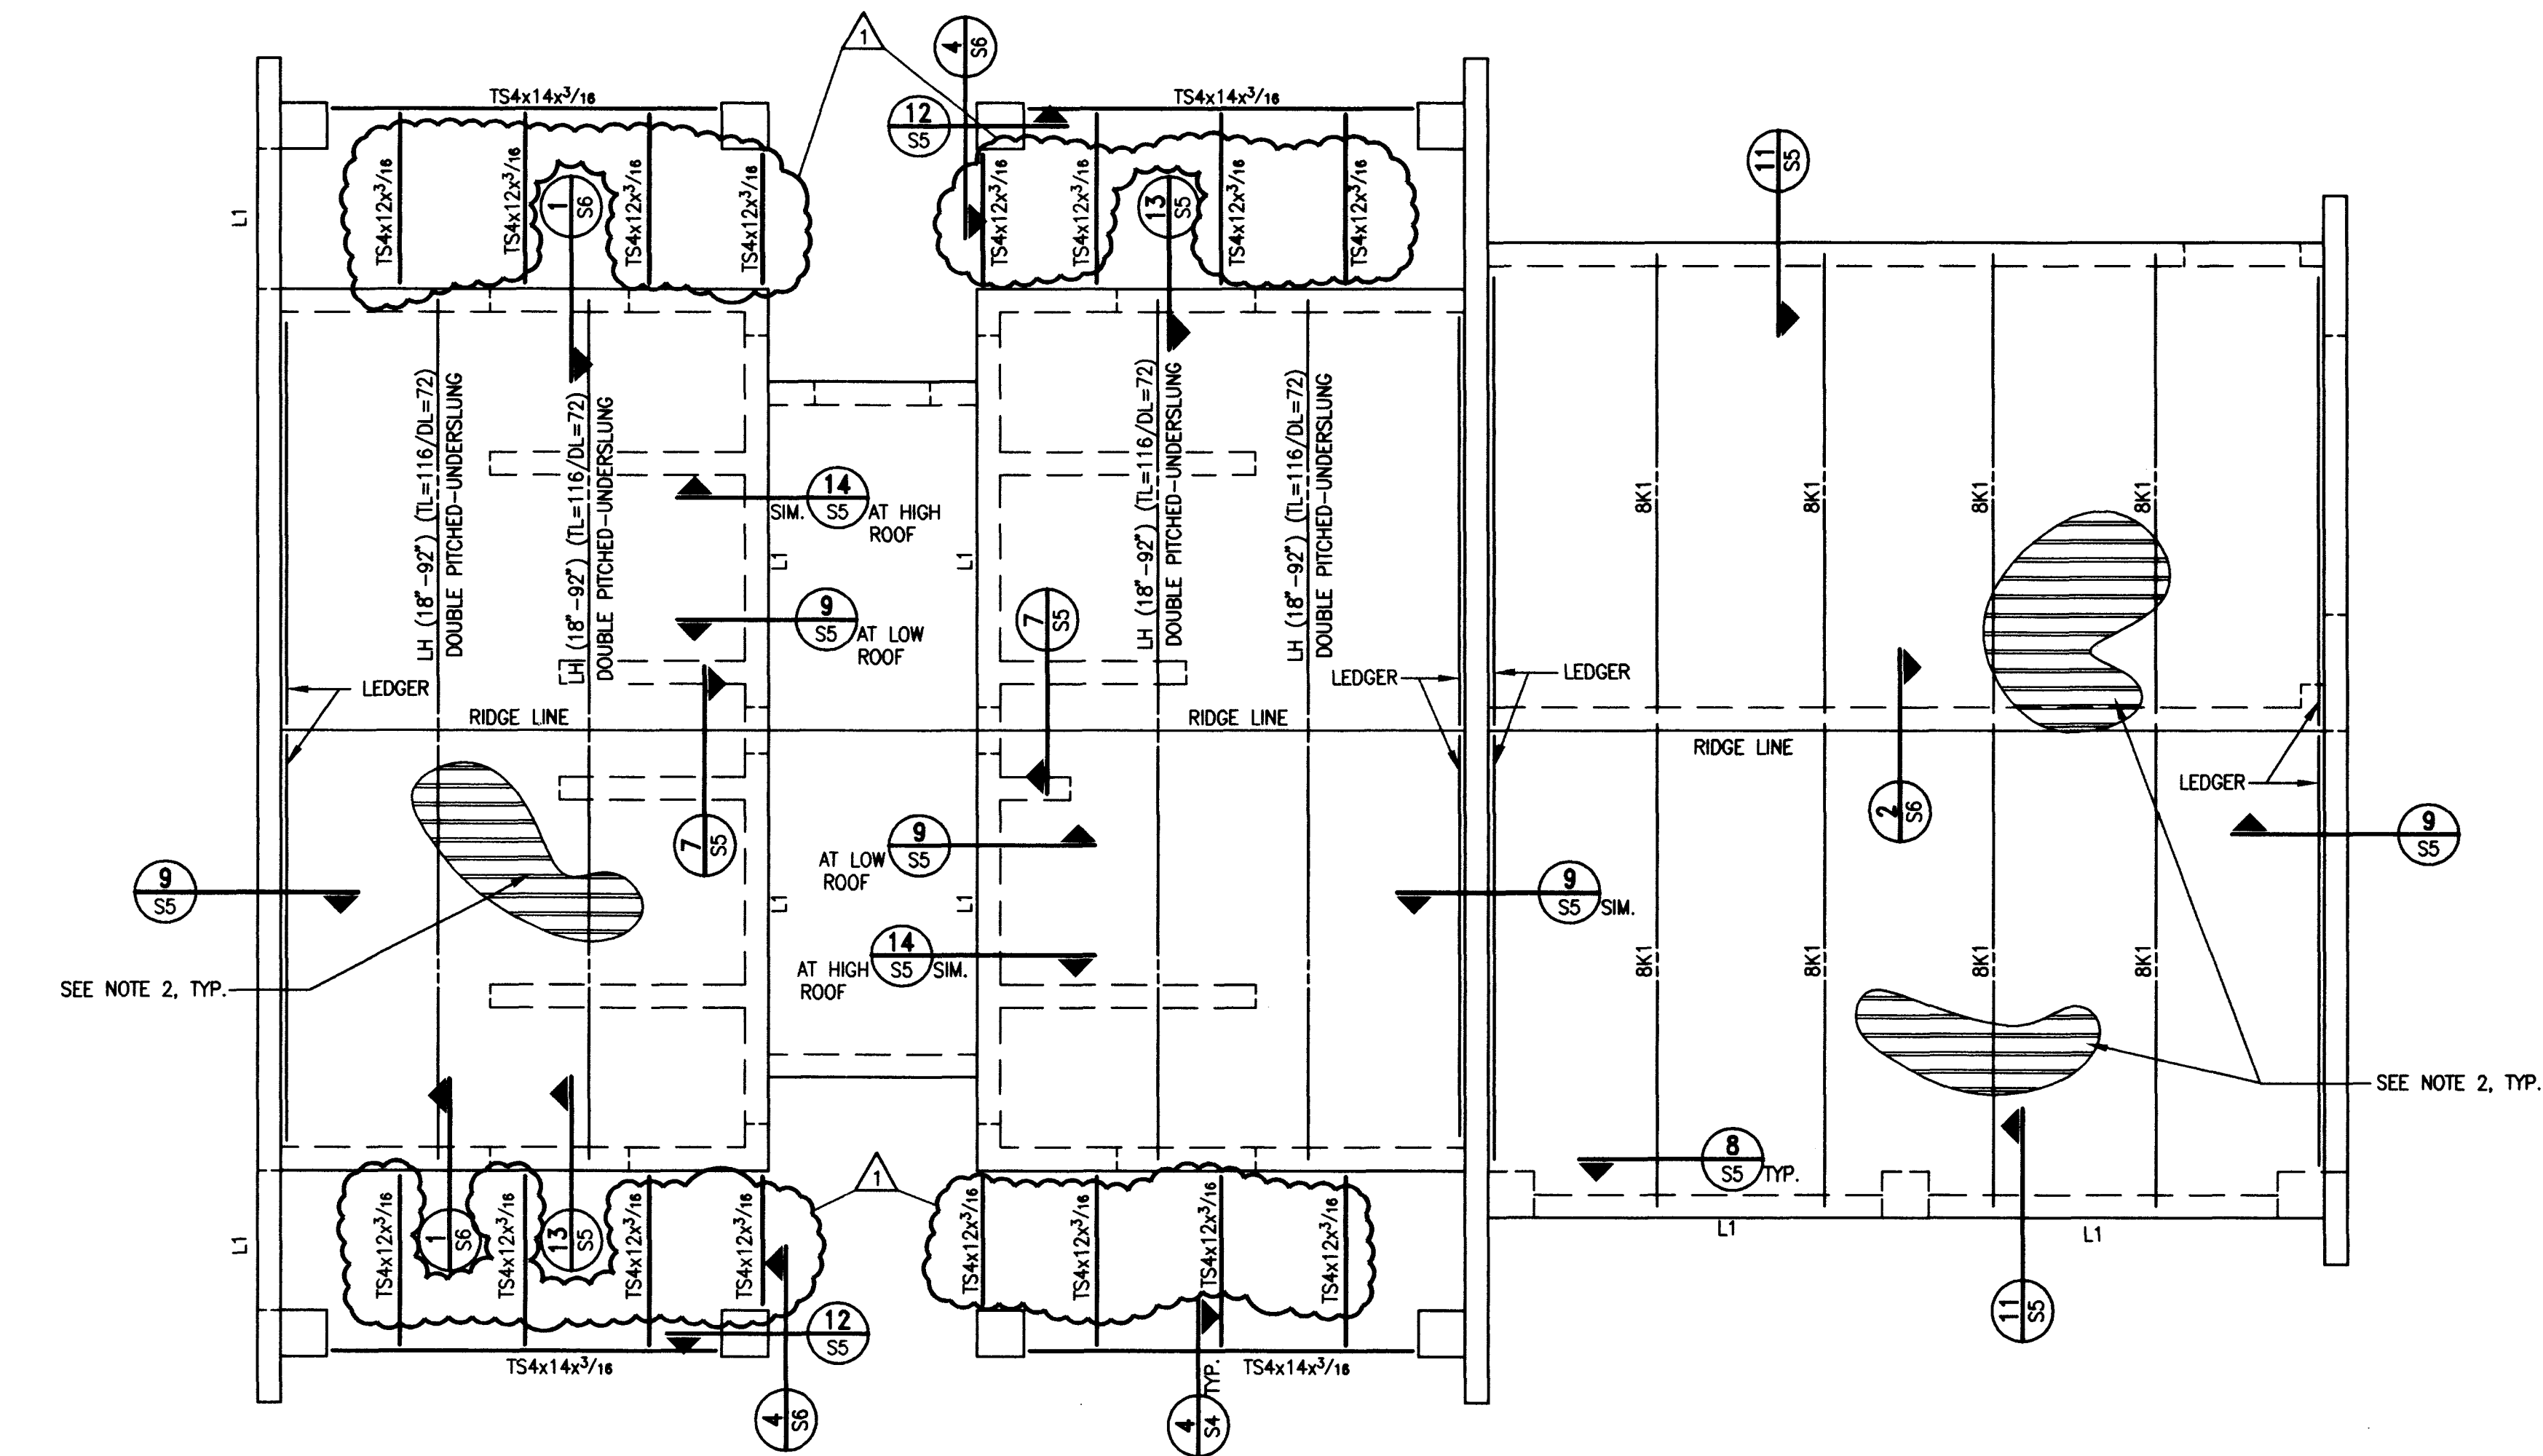


ROOF FRAMING PLAN

SCALE : 1/4" = 1'-0"

ROOF FRAMING NOTES:

1. BOTTOM OF STEEL DECK VARIES. REF ARCHITECTURAL DWGS. FOR ROOF ELEVATIONS.
2. ROOF SHALL BE 1 1/2" x 20 GA. TYPE "B" VERCO DECK OR EQUAL. REF. ARCHITECTURAL DRAWINGS FOR ROOFING, ETC.
3. WELD DECK USING 1/2" DIA. NET EFFECTIVE PUDDLE WELDS:
 - a. PERPENDICULAR BEARINGS: (5)-WELD PER SHEET TO SUPPORT
 - b. PARALLEL BEARINGS AND EDGES: 24" O.C.
 - c. SEAMS: BUTTON PUNCH SIDE SEAMS AT 24" O.C.
4. FOR ROOF OPENINGS SEE DET. 10/SS.
5. UNTELS ARE PER STD. DET. 3/SS EXCEPT AS FOLLOWS:

L1 #5 J-BARS VERT. AT 8" O.C.

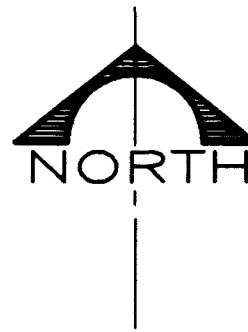

BENNETT & JIMENEZ, INC.
STRUCTURAL ENGINEERS

B&J JOB NO.: 70720

2481 N. Decatur Blvd., Suite B Phone (702) 631-0200
Las Vegas, NV 89108 FAX (702) 631-0206

DEPARTMENT OF PUBLIC WORKS

Torrey Pines Park
& Ball Field

SHEET TITLE:
BALL FIELD
ROOF FRAMING PLAN

SHEET NO.


S3

650.41

DRAWING NO.

75

83

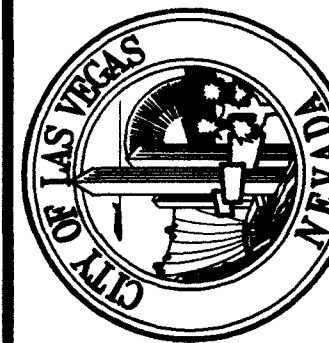

ARCHITECTURAL SERVICES

PLOT SCALE: 1/4" = 1'-0"
FIELD BOOK

DATE: 7/97

DESIGN BY: JFU

DRAWN BY: DUANE

REVISIONS:

REVISD TS AT TRELIS

DATE: 1/23/98

