

Call before you dig
1-800-227-2800

DATE 9/15/93
LAS VEGAS VALLEY WATER DISTRICT - PHASE 3

PHASE 3 CONSTRUCTION
WATER SERVICE LATERALS FOR LOTS 38-43 WILL BE TAPPED ON AN EXISTING WATER MAIN BY THE OWNER'S CONTRACTOR UNDER DIRECTION OF THE LAS VEGAS VALLEY WATER DISTRICT.

JONATHAN'S PLACE
NOT A PART


PHASE 3 PHASE 2

A 1" X 3/4" ANGLE METER STOP AND 3/4" METER BOX WILL BE REQUIRED WITH THE 1" SERVICE LATERALS FOR ALL SERVICES WITH 5/8" OR 3/4" SERVICES. DETAILS OF THE ABOVE INSTALLATION ARE AVAILABLE FROM THE ENGINEERING SERVICES DIVISION AND FROM THE DISTRICT'S INSPECTORS.

PHASE 2 PHASE 1

JONATHAN'S GLEN III
NOT A PART

SEE SHEET 11 FOR LOCATION MAP OF NEAREST SANITARY INTERCEPTOR (12").

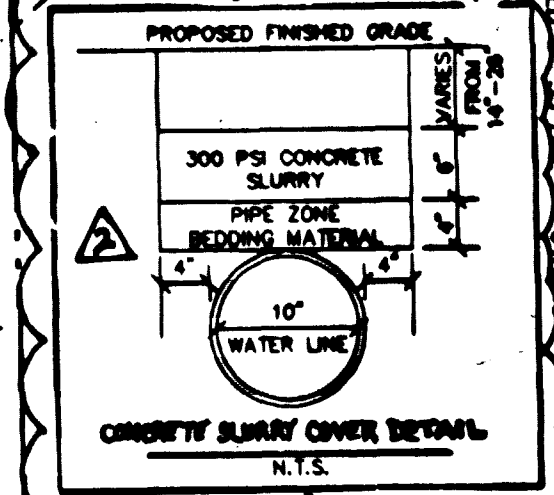


ALLURE TOWNHOMES I
NOT A PART

CL.V. FIRE DEPARTMENT
FIRE FLOW REQUIREMENT IS 1500 GALLONS PER MINUTE AT 20 POUNDS PER SQUARE INCH RESIDUAL.

BASED ON:
SQUARE FOOTAGE
LARGEST AREA BETWEEN AREA SEPARATION WALLS
HEIGHT 2 STORY
TYPE OF CONSTRUCTION V
EXPOSURES 10' MIN.
SPRINKLER SYSTEM NONE
OCCUPANCY SINGLE FAMILY
ROOF CONSTRUCTION TILE

PROJECT NAME: TROPICS
This project water plan complies with the Las Vegas Valley Water District's technical requirements. However, this plan is NOT APPROVED FOR CONSTRUCTION at this time and this signature does not provide a warranty or commitment.

DATE 5-13-93
DATE 11/3/93

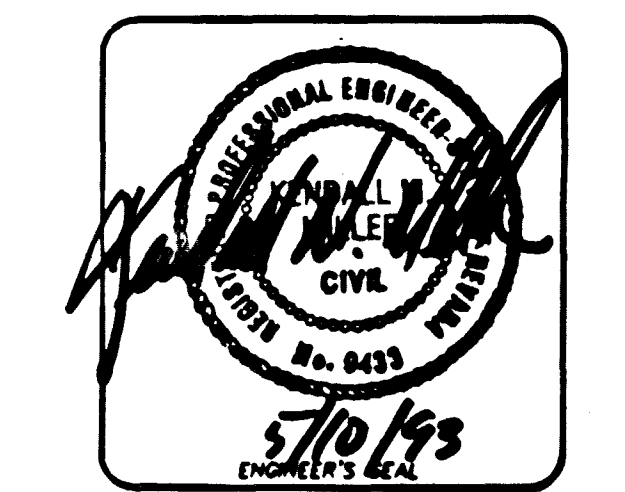

NOTE: WATER SERVICES SHALL BE INSTALLED PER LOT PHASING.

UNDEVELOPED
NOT A PART

PHASE 3 CONSTRUCTION
CLOSE VALVE PRIOR TO REMOVAL OF CAP








REMOVE CAP & CONNECT NEW 8" WATERLINE

PROPOSED 8" WATER LINE PER RIDGEVIEW WEST II, UNIT 10

PROPOSED 8" WATER LINE PER RIDGEVIEW WEST II, UNIT 10

