


Twin Lakes Country Club Estates


POR. E 1/2 OF THE SW 1/4 OF THE NE 1/4 OF SEC. 30

T20S, R. 60E. M.D.B.M.
CITY OF LAS VEGAS, CLARK CO. NEVADA

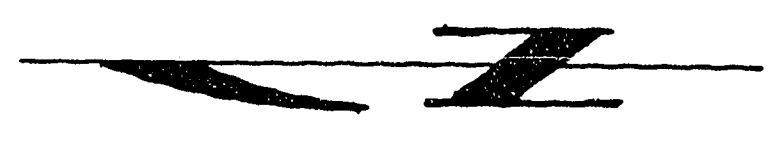

SCALE 1 IN. = 100 FT.

WATER DISTRIBUTION SYSTEM

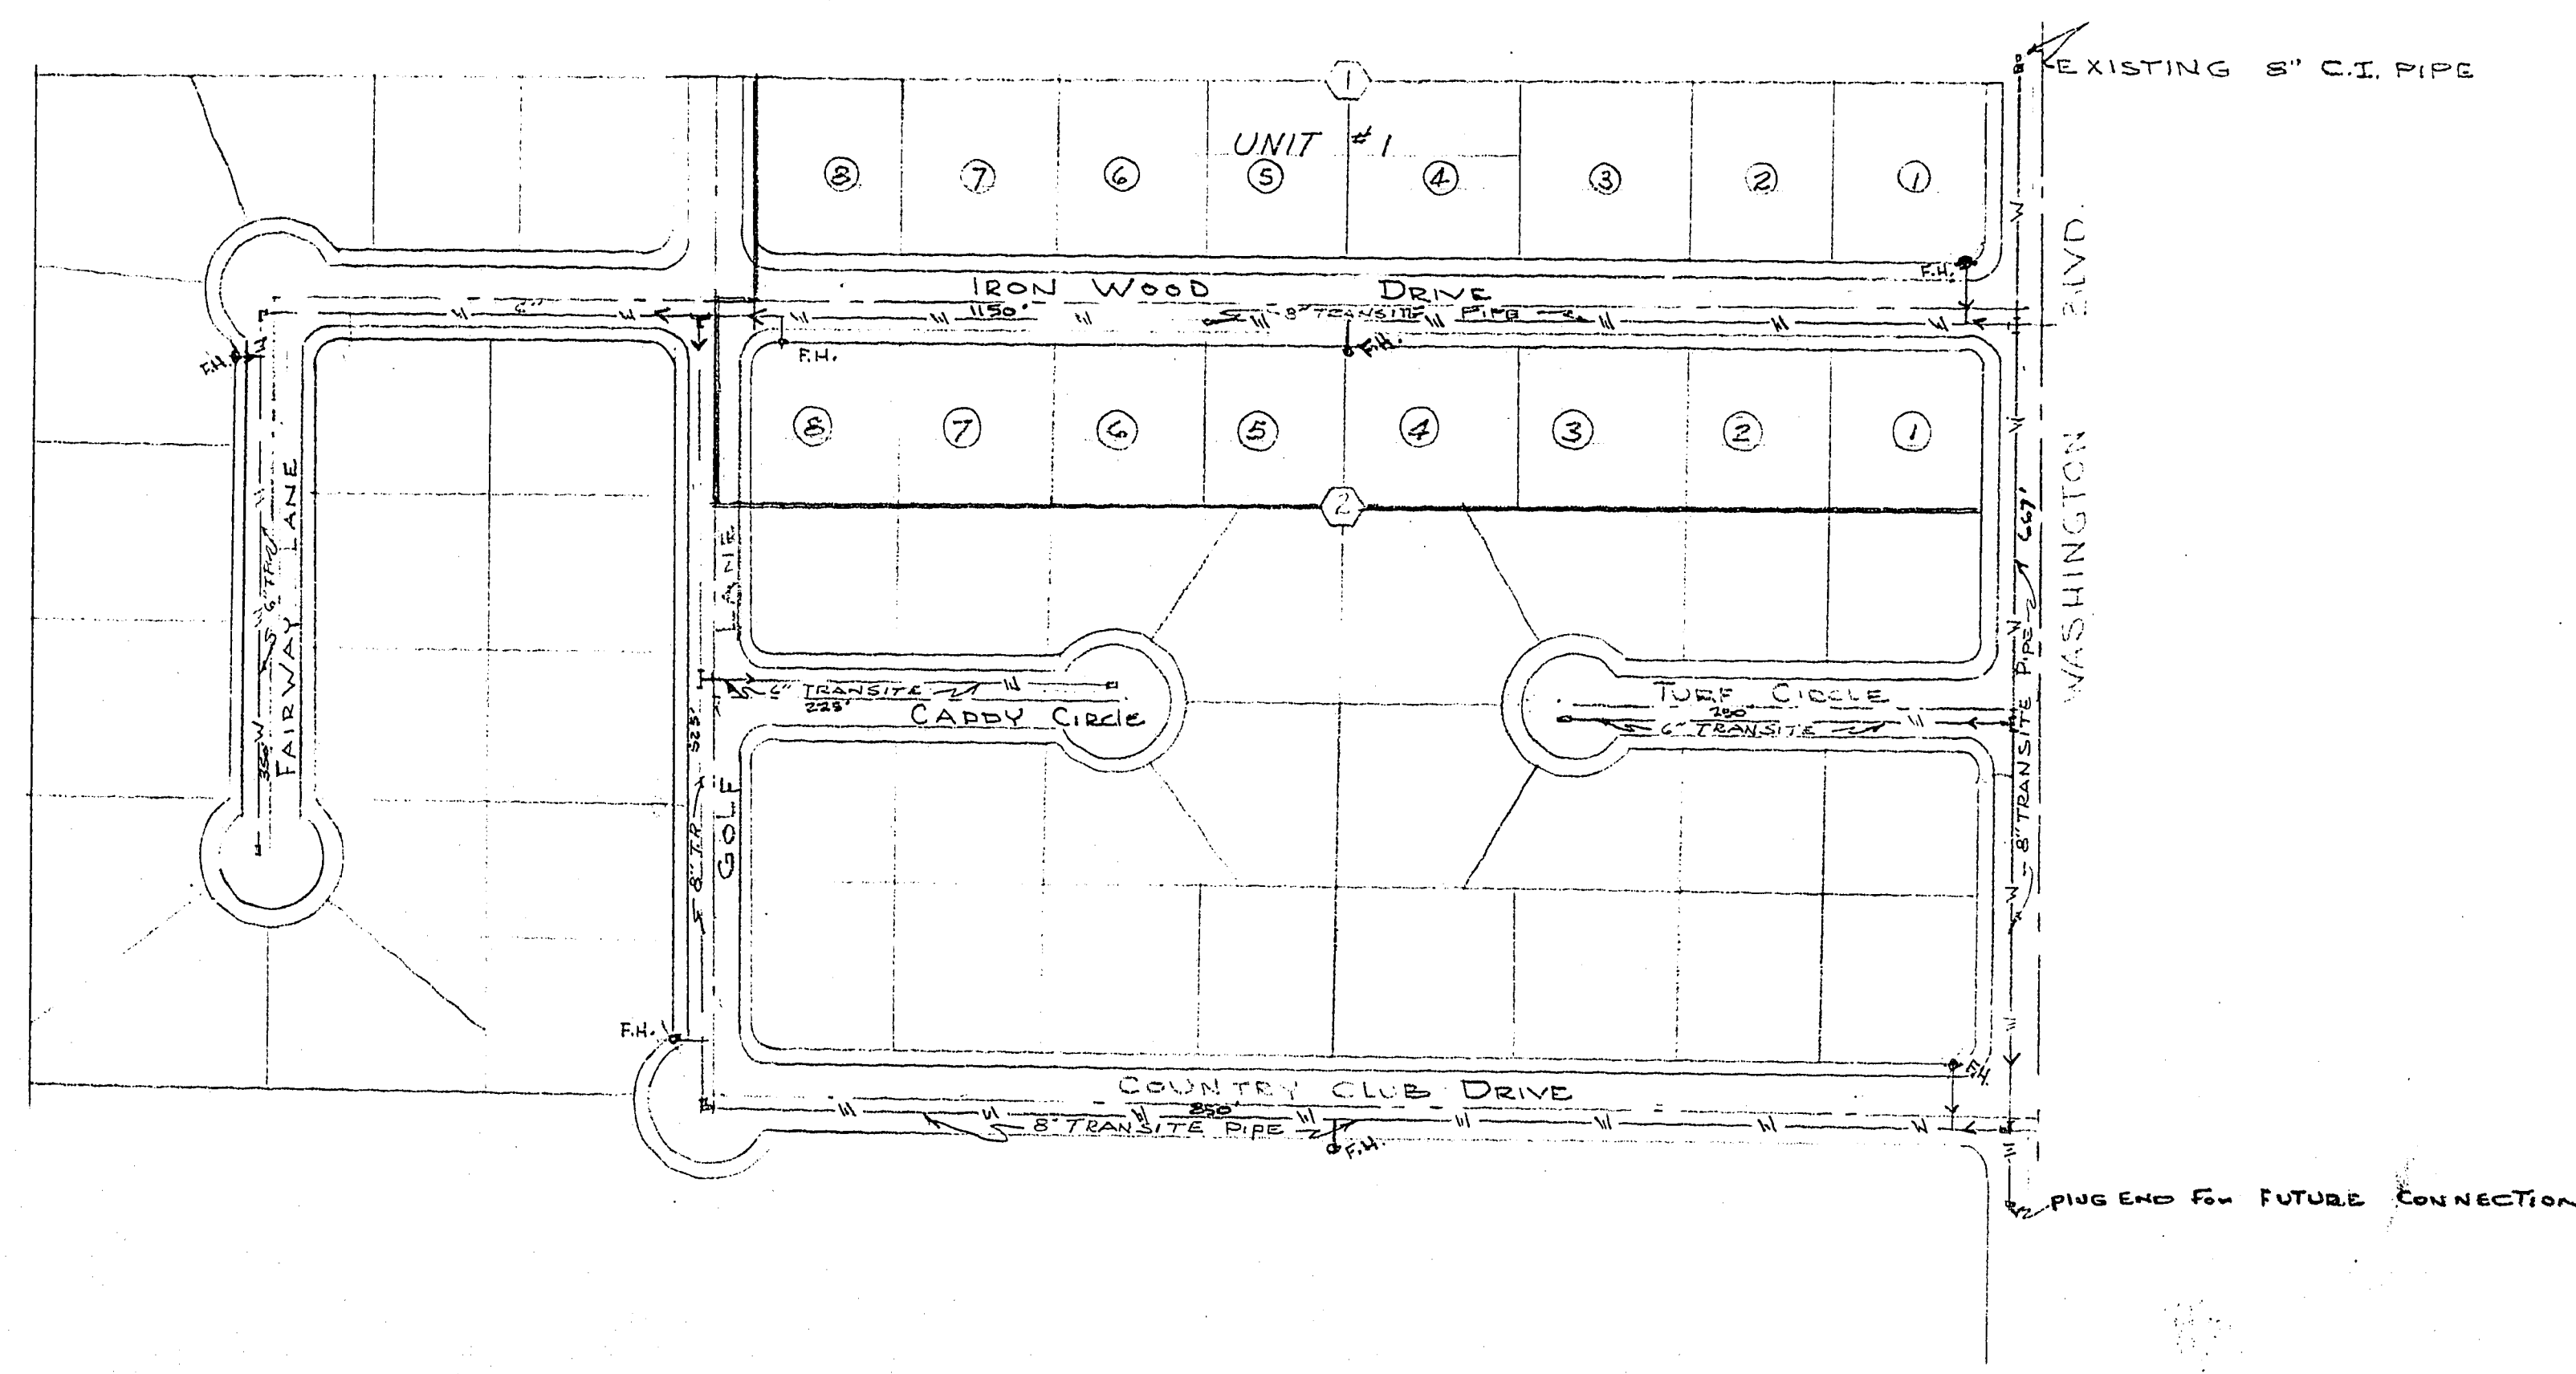

NOTES:

ALL PIPE AND CONNECTIONS AND THE PLACEMENT THEREOF SHALL CONFORM TO THE LAS VEGAS VALLEY WATER DISTRICT STANDARDS AND SPECIFICATIONS.

... DENOTES VALVE
F.H. FIRE HYDRANT

APPROVALS

LAS VEGAS VALLEY WATER DISTRICT: _____
C.L.V. FIRE CHIEF: Ch. Williams 10/4/60
DIRECTOR OF PUBLIC WORKS: R. J. Lauer 11/20/60

Approved subject to extension of 10" main from 14" outlet at NE corner Twin Lakes Village #7 to Bonanza and Twin Lakes Dr. No services to be activated until 10" main installed.

LAS VEGAS VALLEY WATER DISTRICT
— APPROVED —

SUBJECT TO CORRECTIONS NOTED AND TO THE PROVISIONS OF RULE 6 RELATIVE TO CANCELLATION, ALL WORK TO CONFORM TO APPLICABLE DISTRICT STANDARD SPECIFICATIONS.

BY [Signature] DATE 7-12-60
CHIEF ENGINEER & MANAGER

Approval of this plan by the City of Las Vegas, Nevada, does not relieve the Subdivider of responsibility for errors in calculation, design, or planning by the Subdivider, Engineer or Surveyor.

24-8-16 5674-30801