
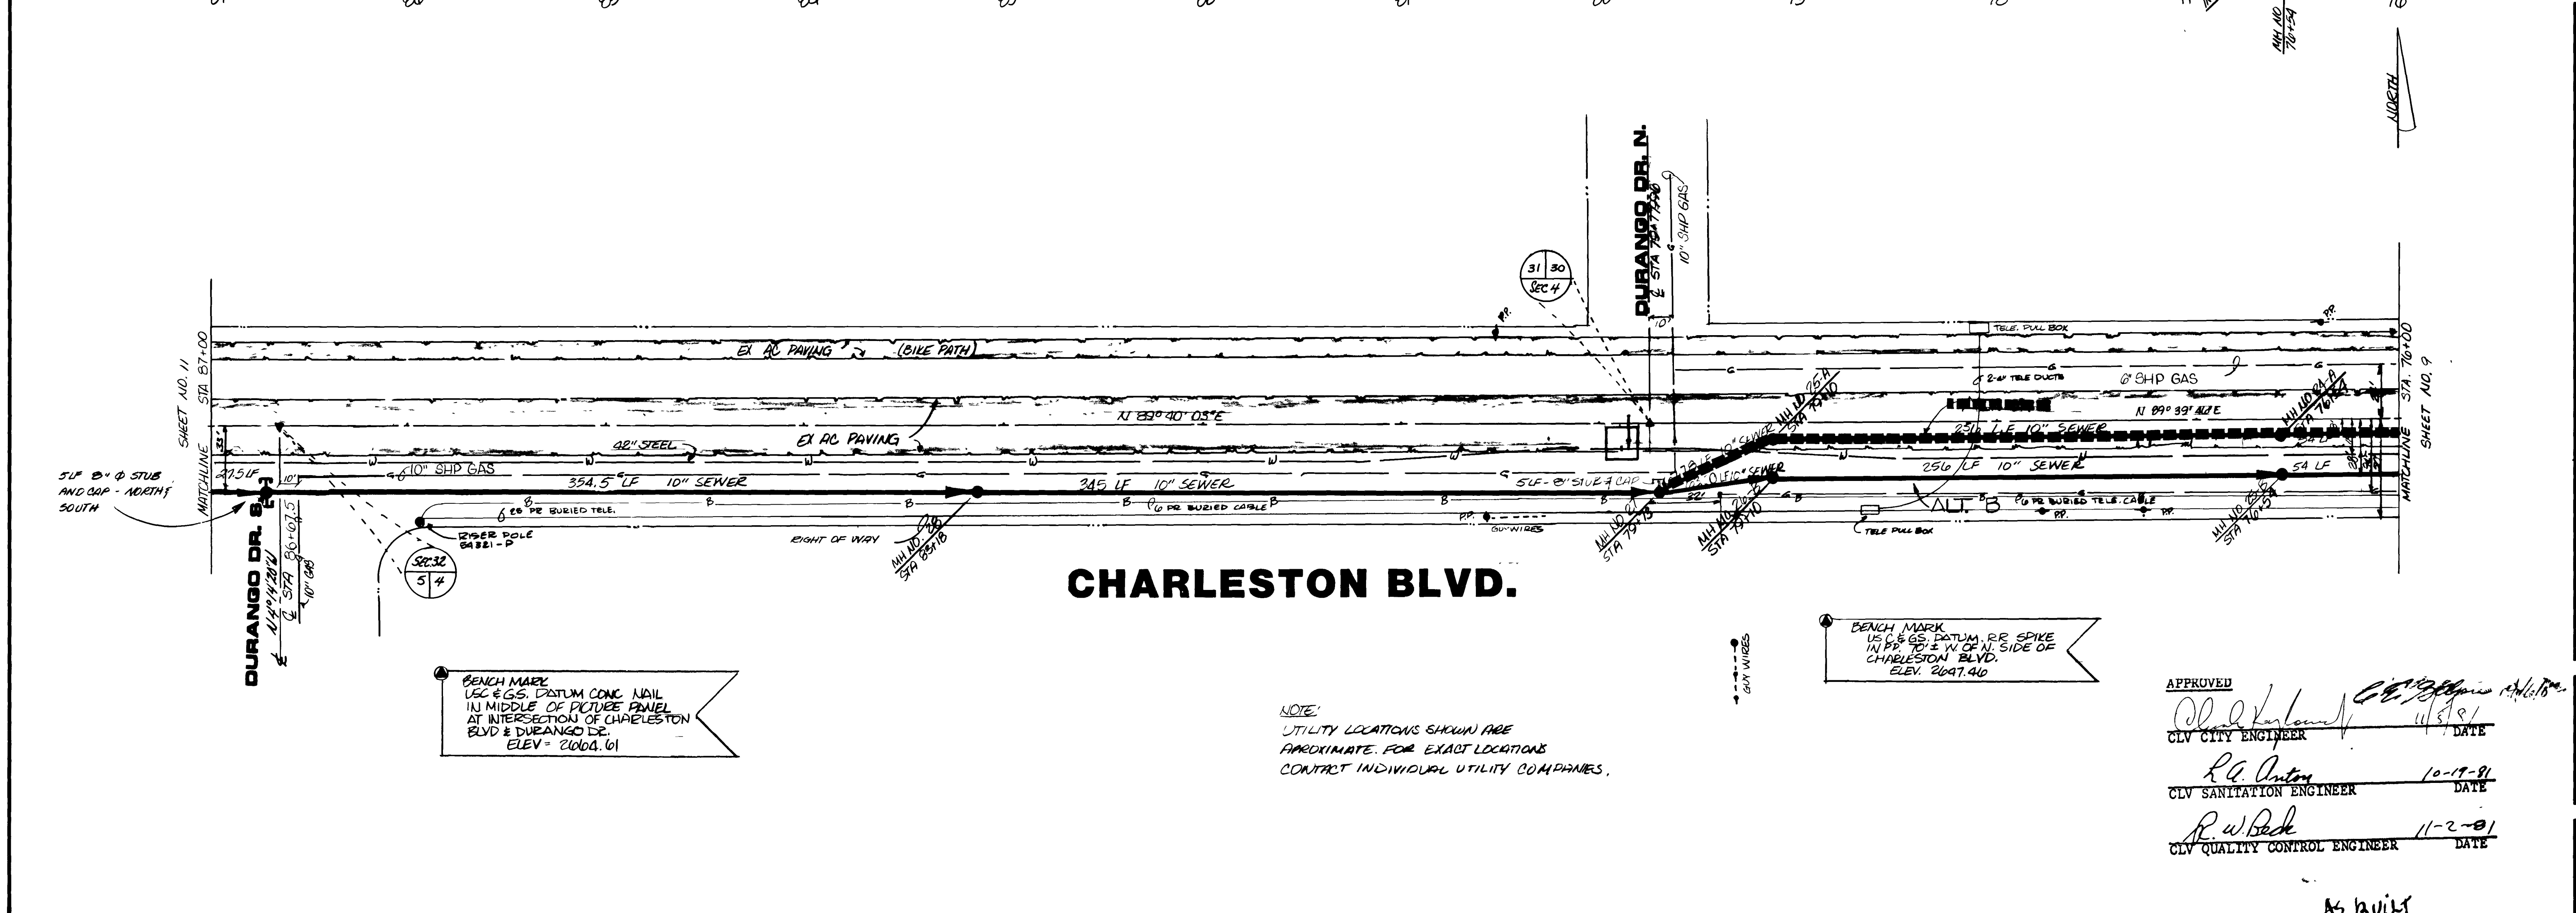


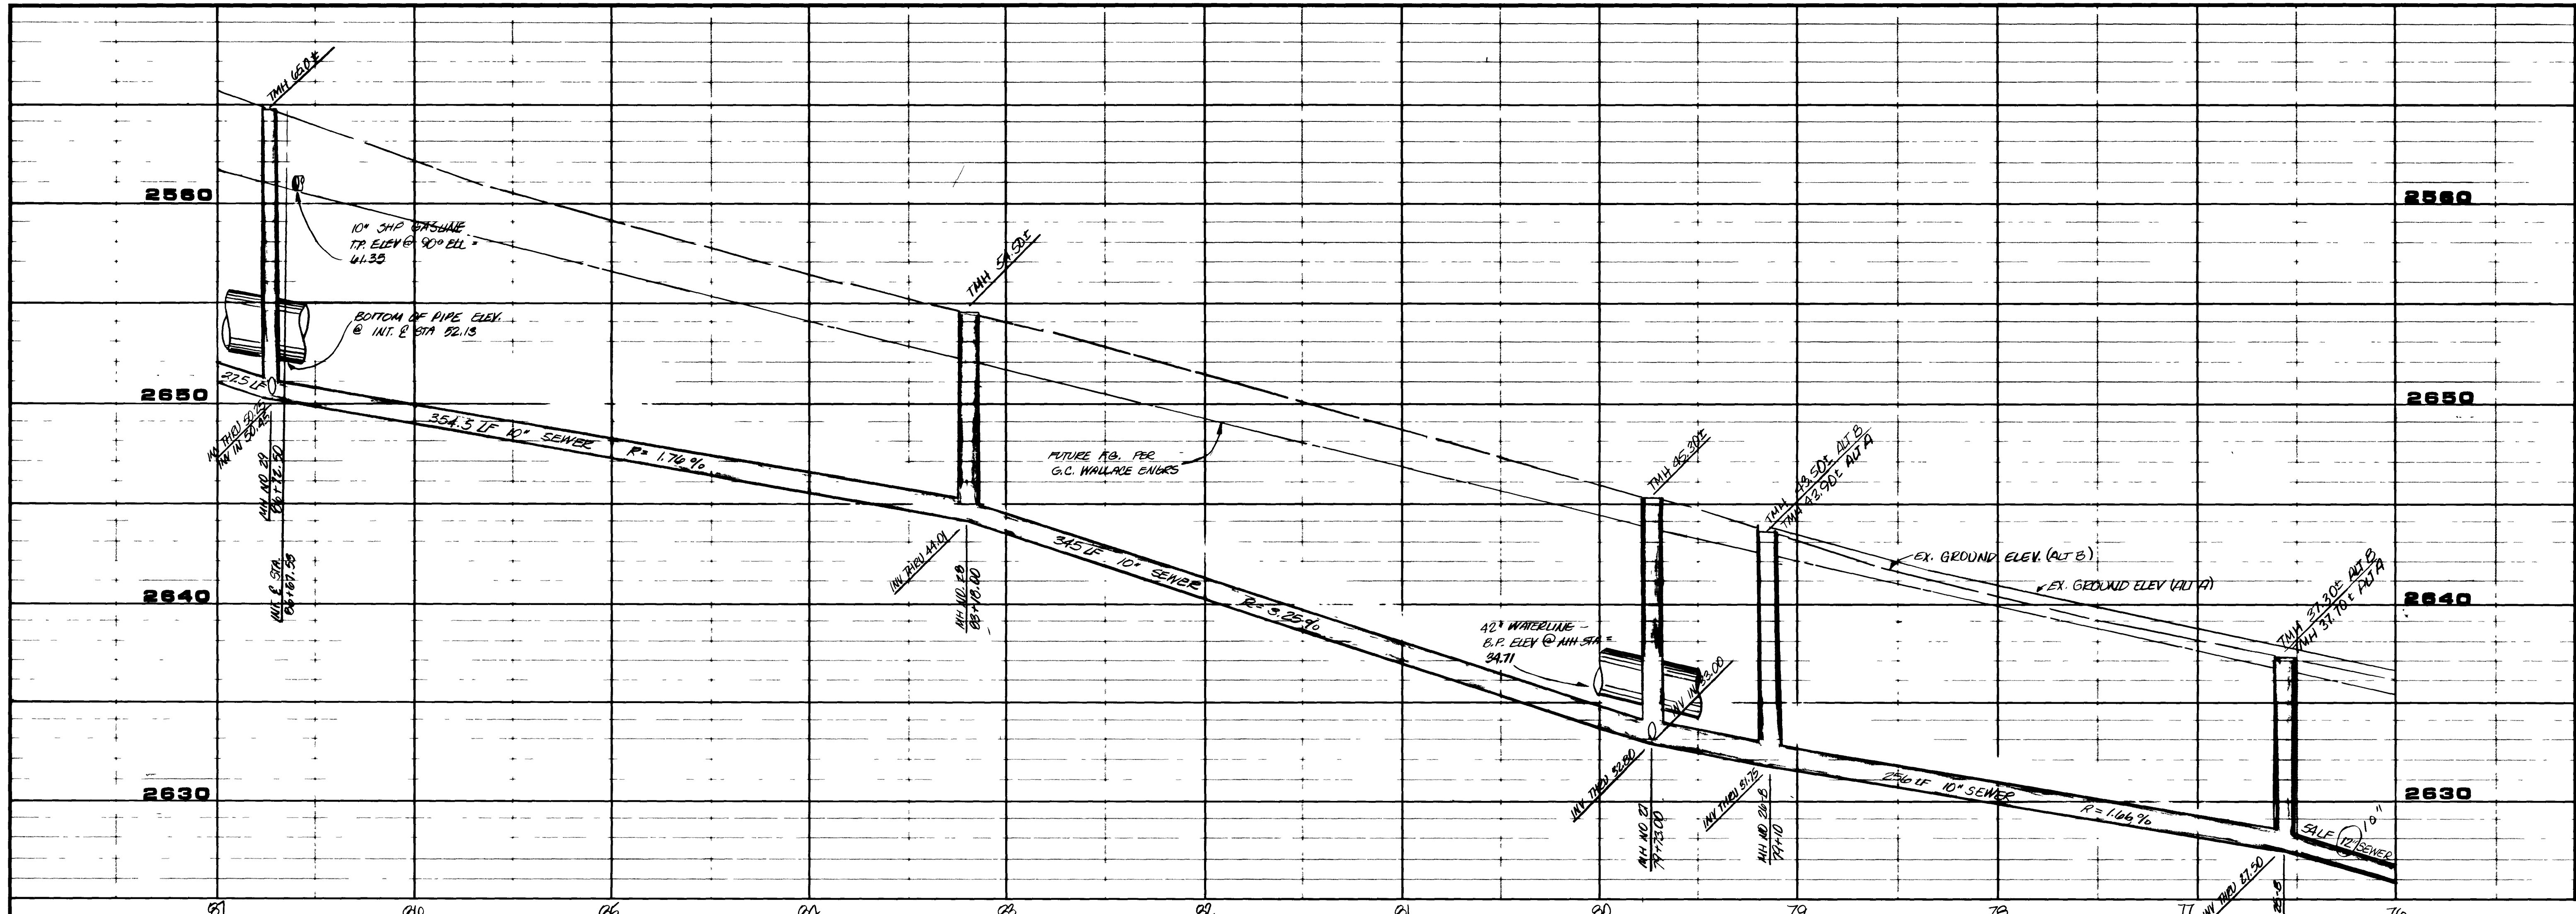

REVISION	DATE	BY	REVISION	DATE	BY
1	3/10/92	VEB	1	3/10/92	VEB
2	4/22/92	MJS	2	4/22/92	MJS
3			3		

SUBMITTED BY: CHARLEY R. JOHNSON PE
DATE: 11/2/91
PROJECT: VALLEY WEST VIII OFF-SITE SEWER

PLANNERS: 2800 WEST SAHARA AVENUE
LAS VEGAS, NEVADA 89102
PHONE (702) 873-7550

TITLE	PROJECT
PLAN & PROFILE	VALLEY WEST VIII OFF-SITE SEWER
STA. 76+00 TO STA. 87+00	

NO. 2580-3
BY: VE BAX
DATE: 11-2-91
SCALE: 1"=40'
SHEET: 10
OF 12 SHEETS

NOTE:
UTILITY LOCATIONS SHOWN ARE
APPROXIMATE. FOR EXACT LOCATIONS
CONTACT INDIVIDUAL UTILITY COMPANIES.

APPROVED
CLV CITY ENGINEER
CLV SANITATION ENGINEER
CLV QUALITY CONTROL ENGINEER

DATE: 11-2-91
DATE: 11-2-91
DATE: 11-2-91

