


8:10:43:V:\JUN17\B\OAKLEY-PP.dwg Mon Feb 10 16:00:18 1997 Dwayne


OAKLEY-PP DSK #

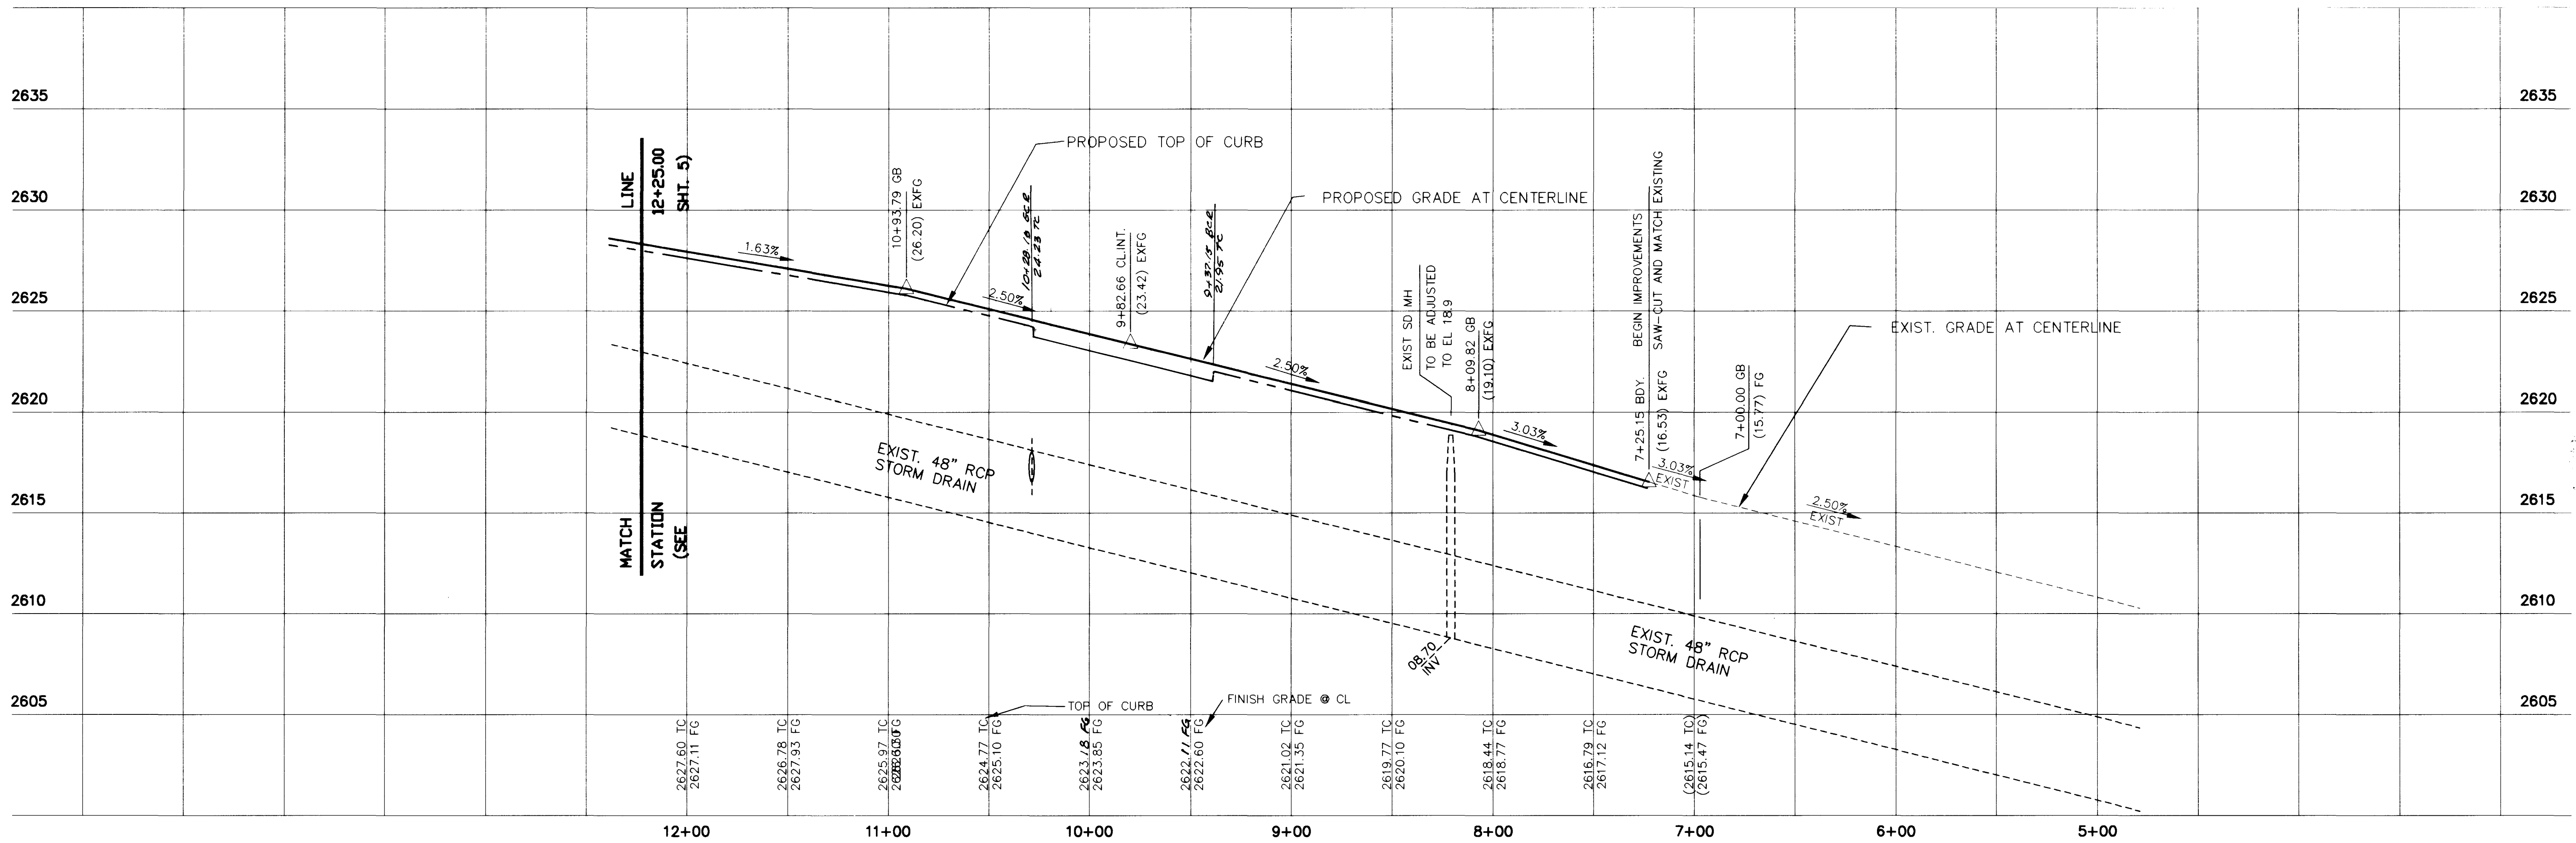

OAKLEY BOULEVARD


PROFILE
SCALE: HORIZ 1" = 40'
VERT. 1" = 4'

PULLMAN DRIVE
SEE SHEET 7

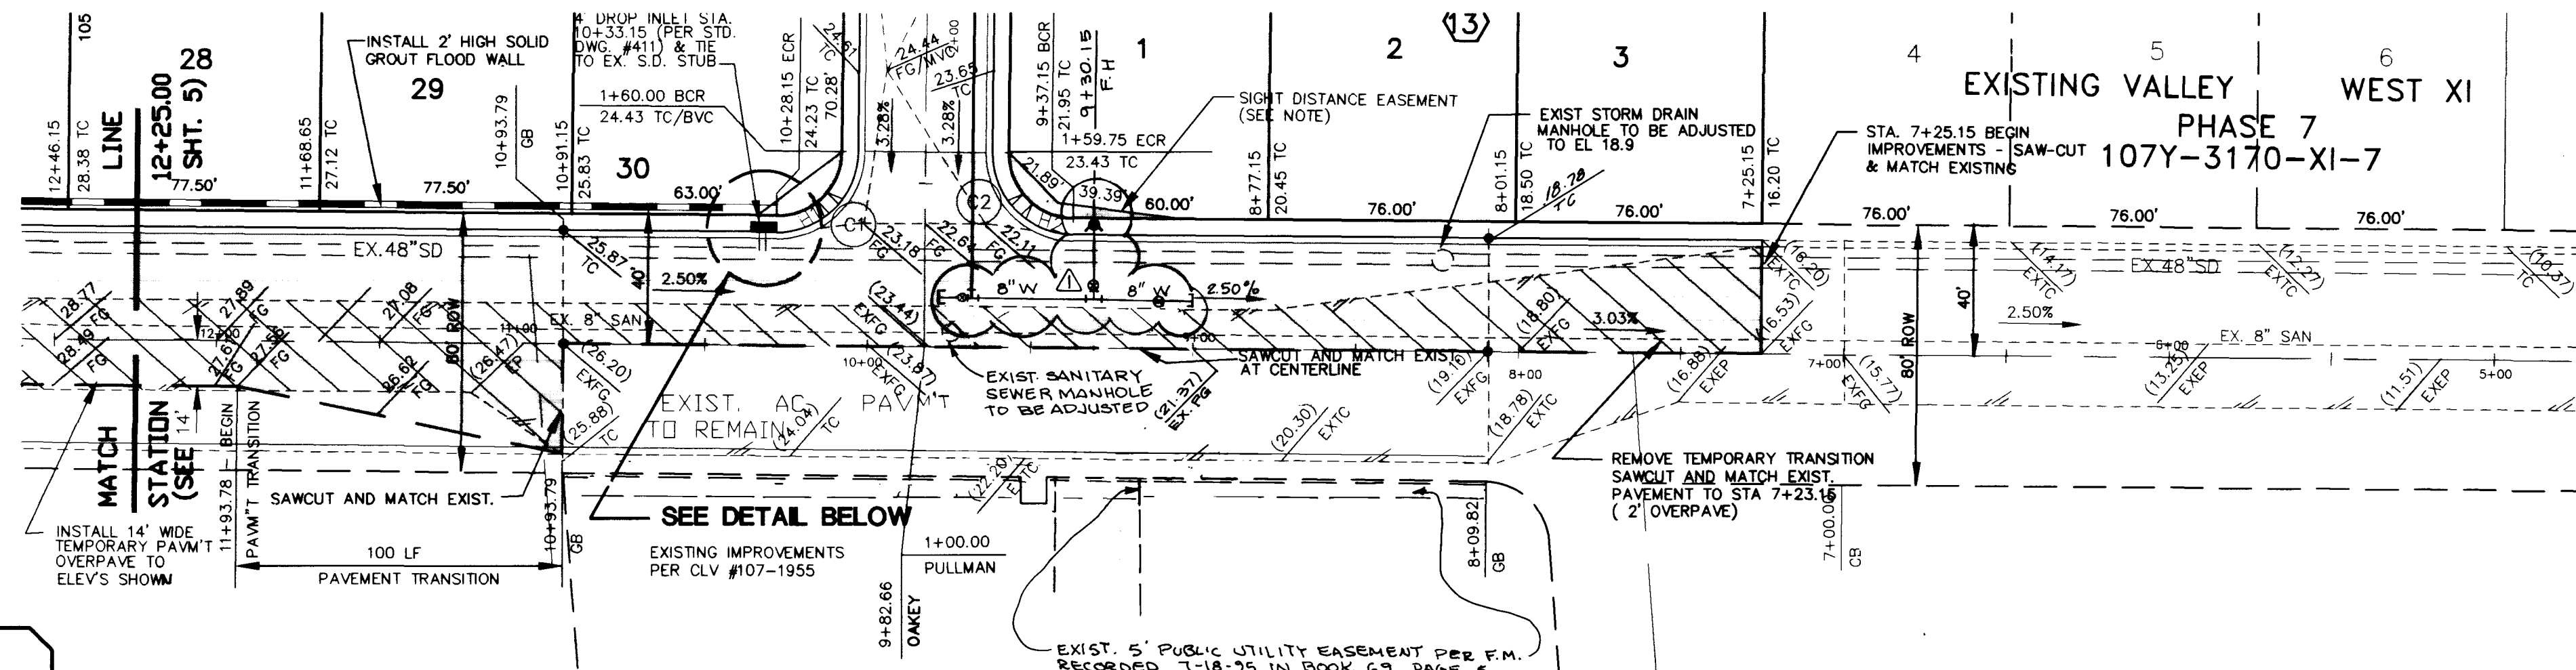

OAKLEY BOULEVARD (PUBLIC STREET)

TOMSIK STREET

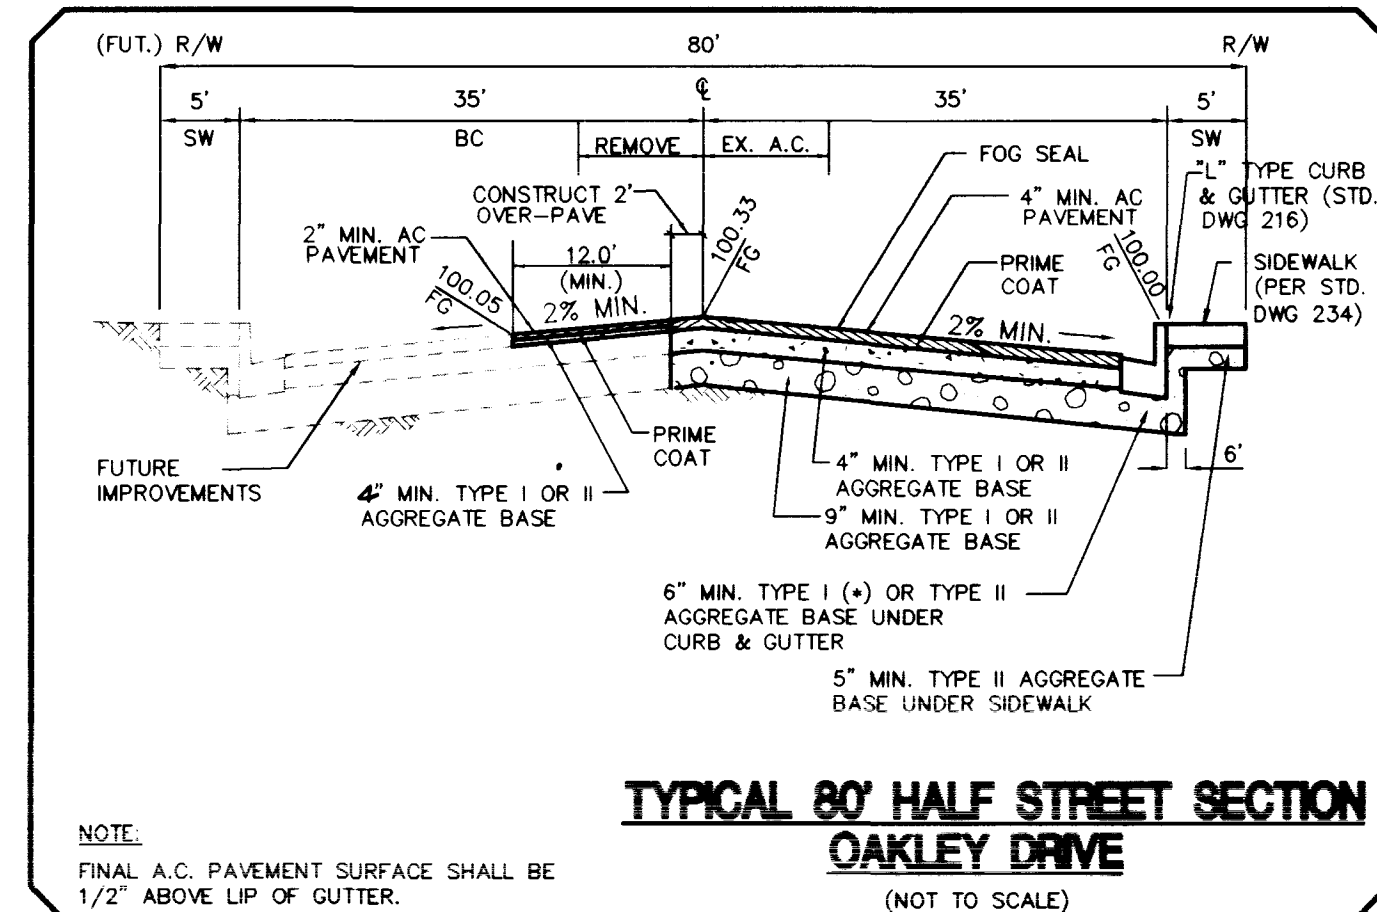


SIDEWALK RAMP DATA		
PER CLV STD DWG NO. 235, CASE 1		
NO.	A	B
H1	8.0'	8.0'
H2	12.0'	4.5'

BACK OF CURB DATA				
CURVE	DELTA	RADIUS	LENGTH	TANGENT
C1	89°58'58"	25.00'	39.26'	24.99'
C2	90°01'02"	25.00'	39.28'	25.01'


SIGHT DISTANCE EASEMENT
NO VIEW OBSTRUCTION
OVER 30' ABOVE TOP
OF CURB ALLOWED IN
SHADE AREA (TYP.)
PER STD. DWG #404.1600

BENCHMARK

NATIONAL GEODETIC VERTICAL DATUM OF 1929 (USED)
1LV10 5E4, RIVET AND PLATE IN TOP OF CURB AT
AT OAKLEY BLVD. AND DURANGO DRIVE, NORTH
CURB LINE, CITY OF LAS VEGAS DATUM
- ELEVATION = 2664.811 FEET
(FOR 1988 DATUM ADD 2.447 FEET.)

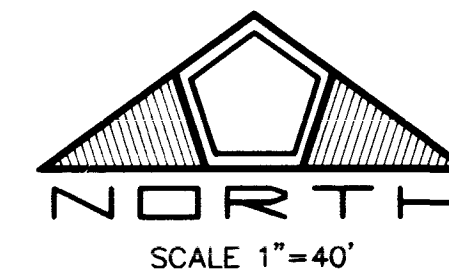

Avoid cutting underground
utility lines. It's costly.
**Call
before you
Dig.**
1-800-227-2600
UNDERGROUND SERVICE ALERT (USA)

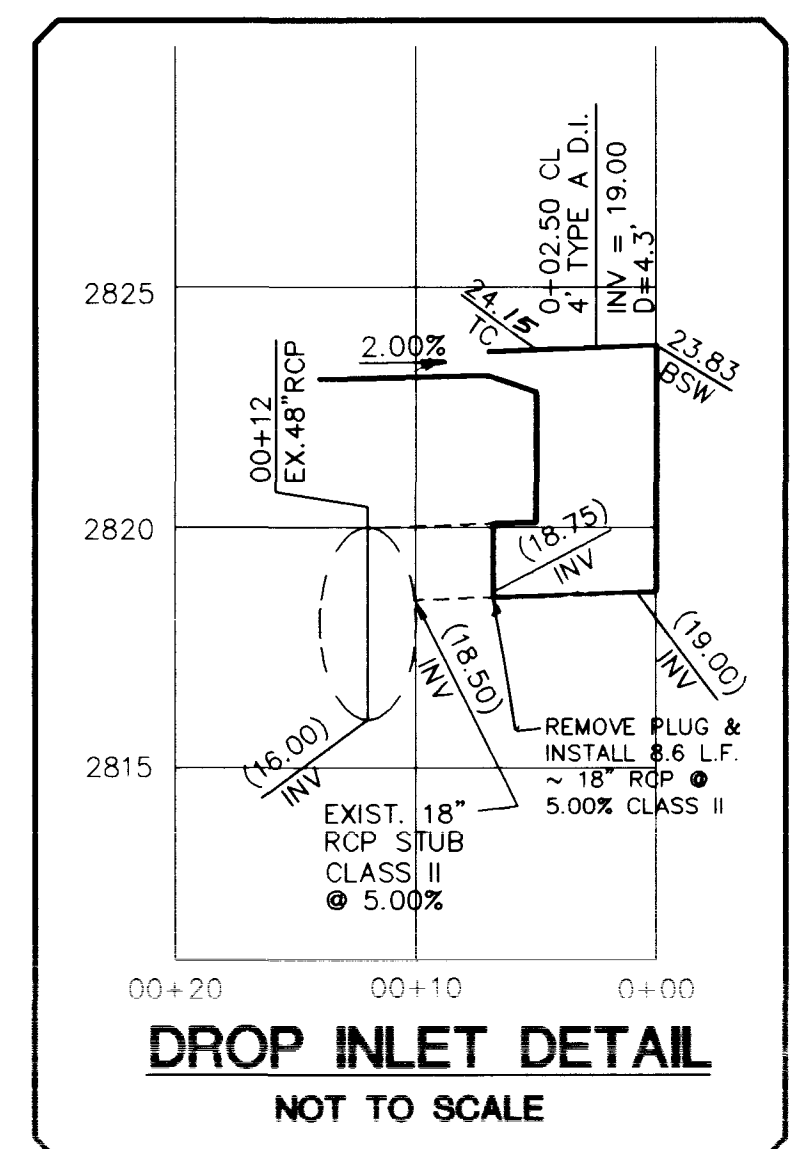

PENTACORE
CIVIL ENGINEERING - LAND SURVEYING - PLANNING
CONSULTING
6763 WEST CHARLESTON BOULEVARD
LAS VEGAS, NEVADA 89102 (702)258-0115

BAILEY AND MCGAH
VALLEY WEST XI, PHASE 8
OAKLEY BOULEVARD
PLAN AND PROFILE

4
OF 9

107Y-3170-XI-8

