


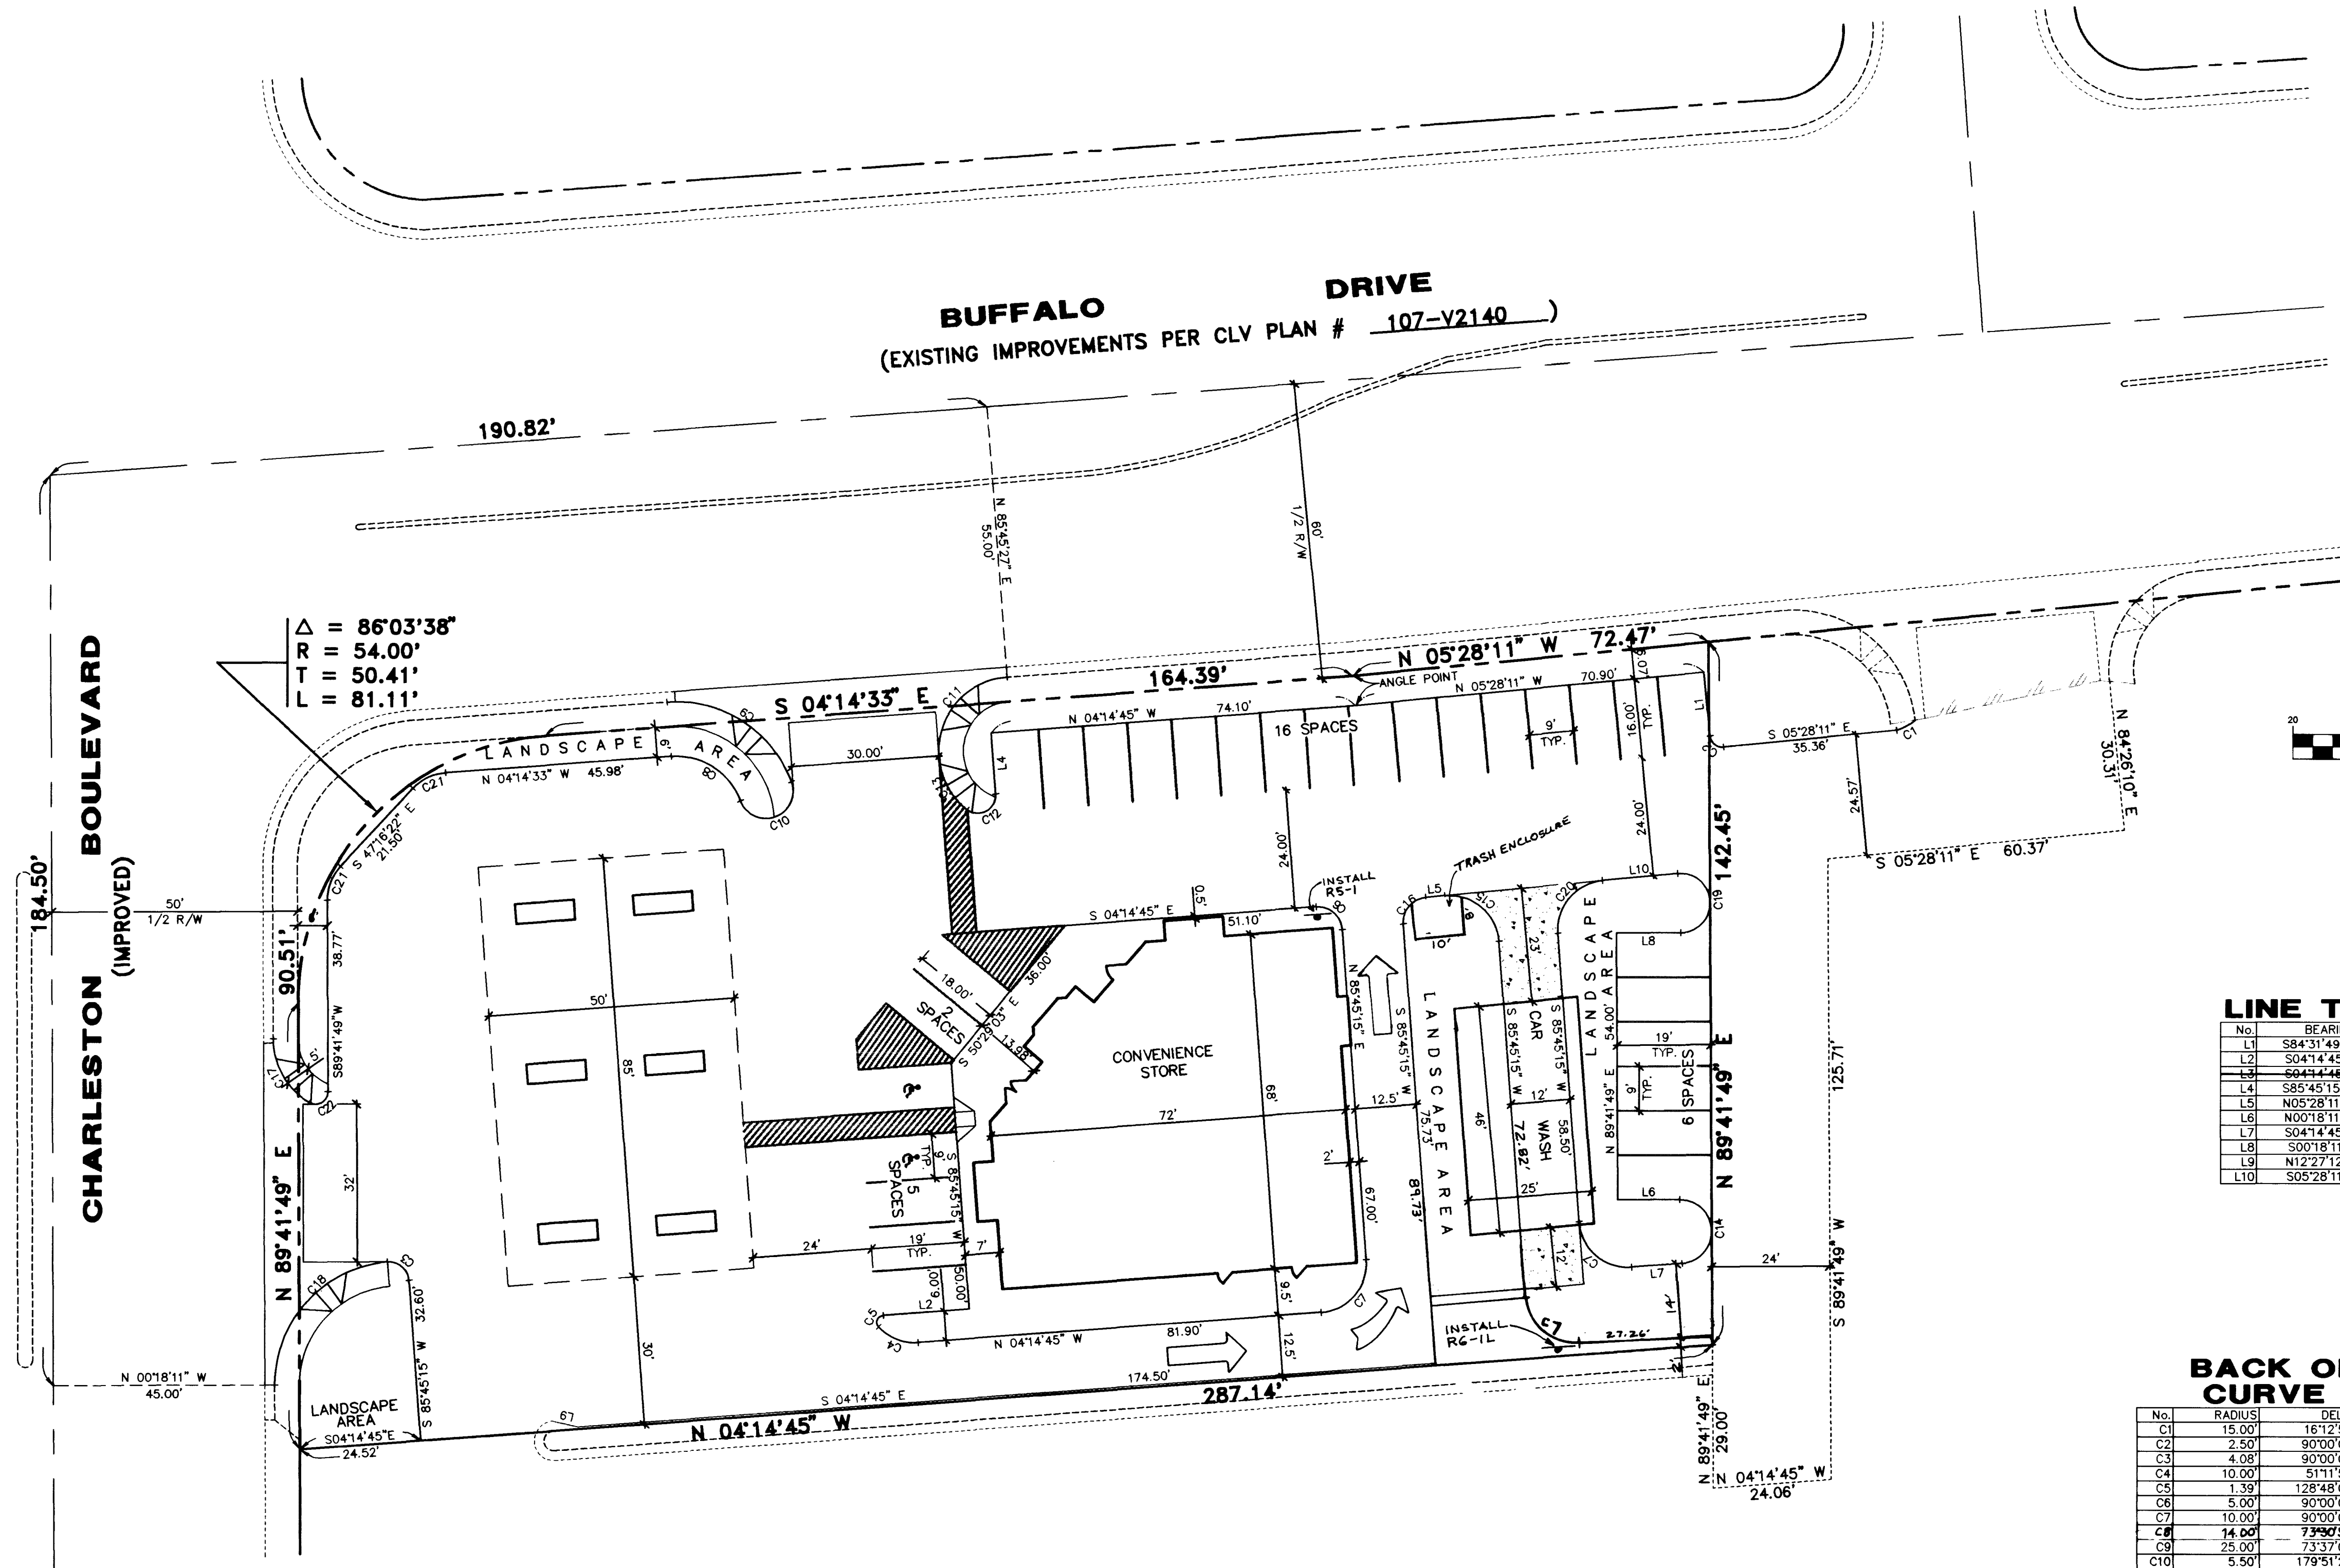

Δ = 86°03'38"
R = 54.00'
T = 50.41'
L = 81.11'

No.	BEARING	DISTANCE
L1	S84°31'49" W	12.93
L2	S04°14'45" E	17.61
L3	S04°14'45" E	6.60
L4	S85°45'15" W	12.38
L5	N05°28'11" W	3.89
L6	N00°18'11" W	12.52
L7	S04°14'45" E	10.24
L8	S00°18'11" E	12.98
L9	N12°27'12" E	5.22
L10	S05°28'11" E	15.36

BACK OF CURB
CURVE TABLE


No.	RADIUS	DELTA	LENGTH	TANGENT
C1	15.00	161°25'57"	4.25	2.14
C2	2.50	90°00'00"	3.93	2.50
C3	4.08	90°00'00"	6.41	4.08
C4	10.00	51°11'57"	8.94	4.79
C5	1.39	128°48'03"	3.13	2.91
C6	5.00	90°00'00"	7.85	5.00
C7	10.00	90°00'00"	15.71	10.00
C8	14.00	73°30'50"	17.96	10.46
C9	25.00	73°37'02"	32.12	18.71
C10	5.50	179°51'22"	17.26	4379.35
C11	15.00	90°00'00"	23.56	15.00
C12	3.62	132°03'00"	8.35	8.14
C13	15.00	47°59'38"	12.56	6.68
C14	6.48	176°03'26"	19.92	188.38
C15	10.00	91°13'25"	15.92	10.22
C16	5.00	88°46'55"	7.75	4.69
C17	15.00	59°05'51"	15.47	8.50
C18	25.00	85°05'16"	37.13	22.94
C19	6.02	185°10'00"	19.47	---
C20	10.00	88°46'55"	15.49	9.79
C21	10.00	43°01'49"	7.51	3.94
C22	2.50	120°53'38"	5.27	4.41

NOTE

ALL DIMENSIONING IS FROM BACK OF CURB.

NOTE

CIVILTEC SHALL BE NOTIFIED IMMEDIATELY OF ANY DISCREPANCIES IN THE PLANS OR CONDITIONS IN THE FIELD.

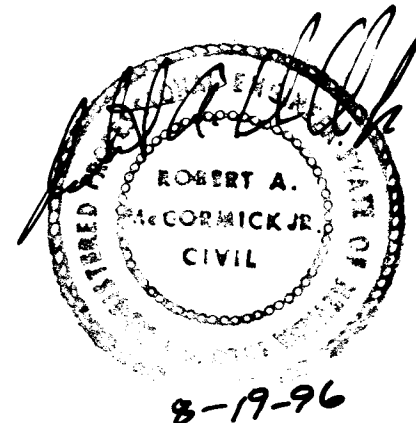

VILLAGE SHOPPE
BUFFALO CHARLESTON CENTER
CITY OF LAS VEGAS, NEVADA


HORIZONTAL CONTROL

SCALE(H): 1" = 20'
SCALE(V): 1" = 1'
DES. BY: RAM
DWN. BY: AJG
CHK. BY: RAM
DATE: 10-95
PROJECT NO. 2882
FILE NO. 2882CSHC
SHEET 2
OF 5

Avoid cutting underground utility lines. It's costly before you dig.
1-800-227-2600
UNDERGROUND SERVICE (USA)



NO.	DESCRIPTION	BY	DATE	REVISIONS
1	MODIFIED WALL & PLANTER W.E. OF CAR WASH	JO	01/23/97	1
2				
3				
4				
5				
6				
7				
8				
9				
10				

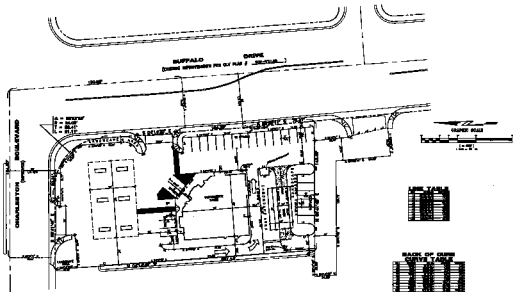









