


23-12-141

00625

BOOK 870224 BOOK 880216

VISTA DEL LAGO UNIT NO. 1

A PORTION OF THE EAST ONE-HALF (E. 1/2) OF SEC. 7, T. 21 S., R. 60 E., M.D.M.

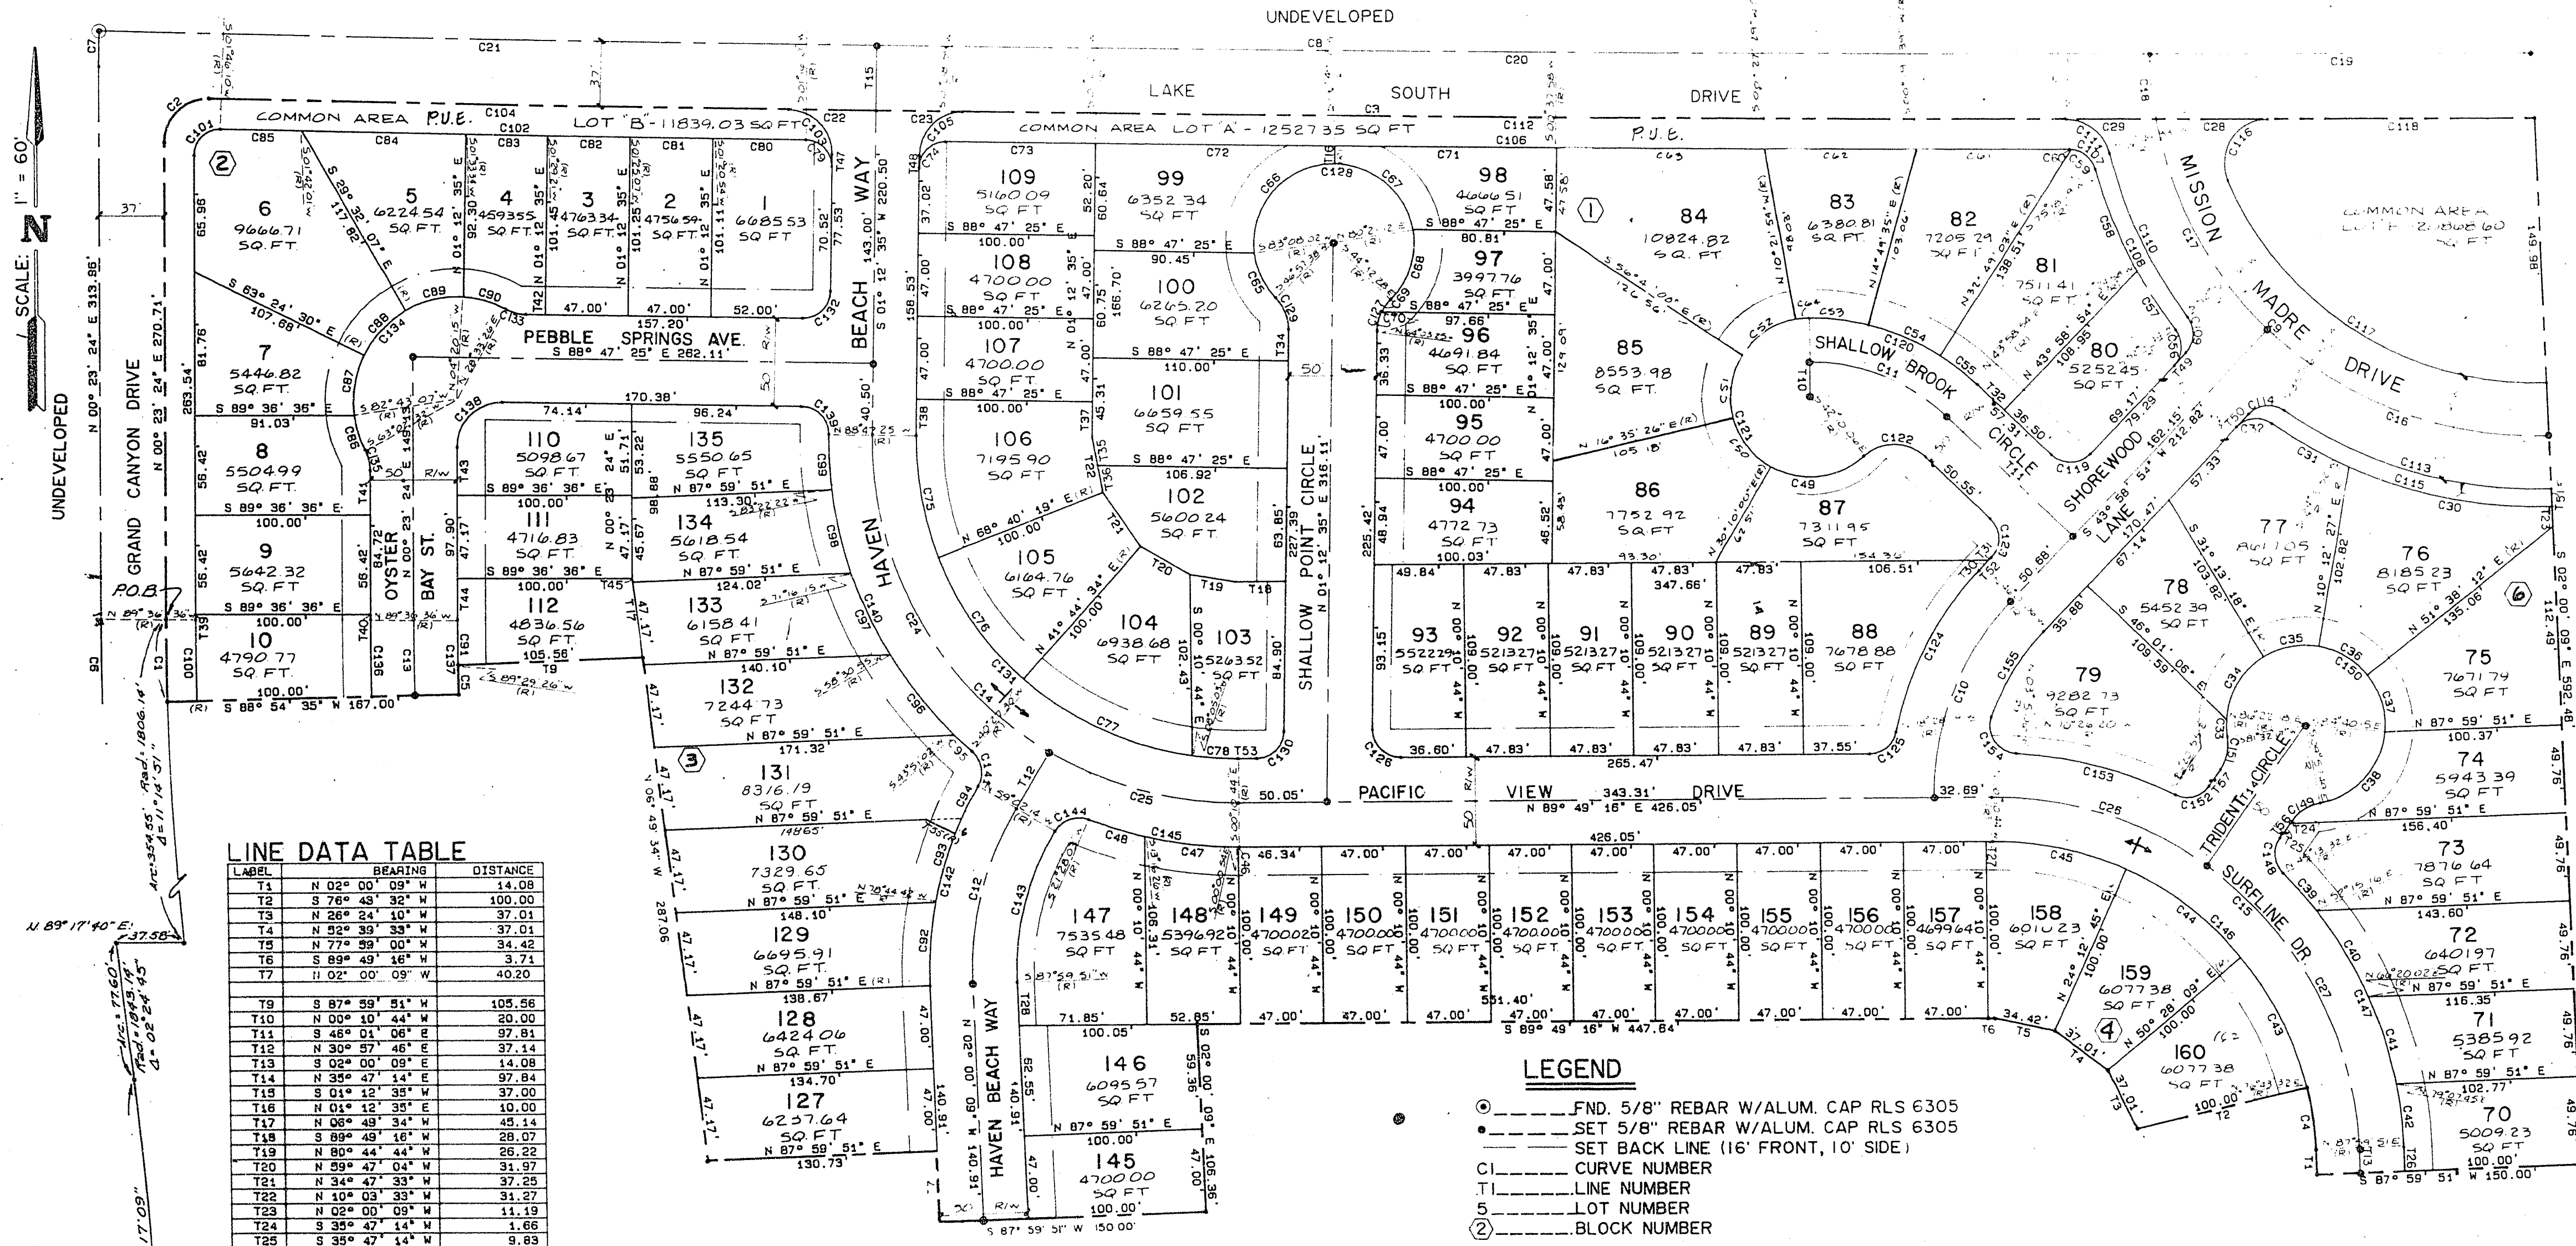

LINE DATA TABLE		
LABEL	BEARING	DISTANCE
T1	N 02° 00' 09" W	14.08
T24	S 02° 00' 09" E	14.08
T25	S 89° 48' 16" W	3.71
T26	S 02° 00' 09" E	24.56
T27	N 43° 58' 54" E	8.01
T28	N 43° 58' 54" E	2.17
T29	S 48° 01' 06" E	20.81
T30	N 80° 48' 16" W	11.54
T31	N 01° 12' 35" E	17.89
T32	S 10° 03' 33" E	15.75
T33	S 10° 03' 33" E	15.51
T34	N 01° 12' 35" E	20.50
T35	S 01° 12' 35" W	20.50
T36	S 00° 23' 24" W	2.98
T37	N 00° 23' 24" E	2.98
T38	N 00° 23' 24" E	23.32
T39	S 88° 47' 16" W	11.20
T40	S 00° 23' 24" W	27.28
T41	S 00° 23' 24" W	23.46
T42	S 06° 48' 34" W	2.03
T43	S 01° 59' 22" E	0.09
T44	N 01° 12' 35" E	7.01
T45	N 43° 58' 54" E	10.12
T46	N 43° 58' 54" W	10.12
T47	N 02° 00' 09" W	10.00
T48	S 43° 58' 54" W	10.18
T49	S 89° 48' 16" W	10.32
T50	S 67° 10' 02" E	18.66
T51	N 35° 47' 14" E	11.49
T52	S 35° 47' 14" W	11.49

FUTURE "VISTA DEL LAGO UNIT NO 2"

CURVE DATA TABLE

LABEL	RADIUS	CENTRAL ANGLE	ARC LENGTH	TAN. LENGTH
C1	1805.14	01° 28' 49"	30.66	23.33
C2	25.00	91° 23' 25"	39.88	25.61
C3	38225.75	01° 58' 43"	1320.12	680.13
C4	181.47	11° 16' 10"	29.70	13.34
C5	1639.14	00° 34' 51"	16.61	6.31
C6	1843.14	01° 28' 49"	47.61	23.81
C7	1846.96	00° 42' 25"	20.32	10.16
C8	38188.75	00° 04' 20"	1381.12	680.64
C9	217.00	91° 58' 06"	348.32	224.59
C10	159.10	44° 09' 39"	122.63	64.54
C11	111.26	44° 09' 39"	85.76	45.13
C12	180.35	32° 57' 55"	103.77	53.36
C13	1684.14	01° 28' 49"	42.98	21.50
C14	205.00	91° 23' 19"	326.96	210.03
C15	206.47	88° 10' 36"	317.78	200.00
C16	217.00	45° 59' 03"	174.16	92.08
C17	217.00	36° 09' 52"	136.97	70.85
C18	217.00	00° 49' 11"	37.19	18.64
C19	38188.75	00° 15' 32"	217.00	108.50
C20	38188.75	01° 04' 51"	720.45	360.24
C21	38188.75	00° 38' 56"	443.67	221.84
C22	38225.75	00° 04' 20"	49.97	24.98
C23	38225.75	00° 04' 30"	49.97	24.98
C24	205.00	60° 14' 48"	215.56	118.95
C25	205.00	11° 08' 31"	111.42	57.13
C26	206.47	35° 57' 58"	129.61	67.00
C27	206.47	52° 12' 37"	188.14	101.17
C28	38225.75	00° 05' 47"	64.74	32.13
C29	38225.75	00° 04' 35"	50.86	25.46
C30	257.00	28° 16' 01"	117.82	59.96
C31	257.00	11° 10' 12"	50.10	25.13
C32	15.50	11° 27' 01"	25.04	12.34
C33	45.00	12° 05' 25"	9.50	4.77
C34	45.00	55° 09' 00"	43.31	23.50
C35	45.00	11° 25' 15"	32.14	16.12
C36	45.00	41° 25' 45"	32.54	17.02
C37	45.00	43° 41' 33"	34.32	18.04
C38	45.00	74° 42' 26"	58.67	34.35
C39	231.47	07° 01' 44"	38.40	14.32
C40	231.47	14° 04' 45"	56.88	28.88
C41	231.47	12° 47' 43"	51.69	25.95
C42	231.47	08° 52' 07"	35.83	17.85
C43	181.47	26° 15' 23"	83.16	42.32
C44	181.47	26° 15' 23"	83.16	42.32
C45	181.47	24° 23' 50"	71.26	36.22
C46	230.00	00° 09' 51"	0.68	0.33
C47	230.00	13° 17' 20"	53.34	26.79
C48	230.00	08° 11' 37"	32.89	16.47
C49	45.00	74° 24' 24"	92.92	47.37
C50	45.00	46° 25' 24"	34.46	14.30
C51	45.00	46° 49' 54"	36.70	14.44
C52	45.00	46° 14' 06"	36.38	14.25

LEGEND

- ① --- FND. 5/8" REBAR W/ALUM. CAP RLS 6305
- ② --- SET 5/8" REBAR W/ALUM. CAP RLS 6305
- ③ --- SET BACK LINE (16' FRONT, 10' SIDE)
- ④ --- CURVE NUMBER
- ⑤ --- LINE NUMBER
- ⑥ --- LOT NUMBER
- ⑦ --- BLOCK NUMBER

CURVE DATA TABLE

LABEL	RADIUS	CENTRAL ANGLE	ARC LENGTH	TAN. LENGTH
C53	136.26	01° 28' 49"	30.66	23.33
C54	136.26	17° 54' 26"	42.11	21.67
C55	136.26	11° 09' 51"	26.55	13.32
C56	15.50	81° 27' 10"	22.04	11.66
C57	257.00	08° 53' 13"	39.86	19.97
C58	257.00	13° 53' 21"	62.30	31.30
C59	15.00	71° 09' 11"	18.63	10.73
C60	15.00	03° 57' 17"	1.04	0.52
C61	38242.75	00° 07' 41"	86.44	43.52
C62	38242.75	00° 07' 51"	87.20	43.53
C63	38242.75	00° 10' 21"	110.62	56.37
C64	45.00	01° 11' 04"	8.02	4.01
C65	45.00	38° 10' 24"	28.41	14.70
C66	45.00	98° 04' 33"	42.03	21.84
C67	45.00	79° 08' 37"	62.18	37.19
C68	45.00	55° 06' 20"	43.28	23.48
C69	25.50	19° 30' 57"	8.89	4.39
C70	25.50	24° 44' 00"	11.01	5.59
C71	38242.75	00° 11' 14"	125.00	62.50
C72	38242.75	00° 12' 08"	135.00	67.50
C73	38242.75	00° 07' 39"	95.02	42.51
C74	15.00	09° 56' 24"	23.85	14.98
C75	180.00	22° 32' 16"	70.80	35.87
C76	180.00	26° 55' 44"	84.60	43.10
C77	180.00	33° 39' 31"	105.74	54.45
C78	180.00	08° 15' 48"	28.98	13.00
C79	15.00	88° 56' 24"	23.58	14.98
C80	38242.75	00° 04' 43"	26.25	13.12
C81	38242.75	00° 04' 13"	47.00	23.50
C82	38242.75	00° 04' 13"	47.00	23.50
C83	38242.75	00° 04' 14"	47.00	23.50
C84	38242.75	00° 08' 26"	83.60	46.55
C85	38242.75	00° 04' 09"	46.19	23.09
C86	99.50	19° 40' 35"	20.43	10.32
C87	99.50	39° 52' 23"	35.18	18.12
C88	99.50	33° 52' 23"	35.18	18.12
C89	99.50	33° 52' 23"	35.18	18.12
C90	99.50	24° 13' 11"	25.15	12.77
C91	1639.14	00° 59' 58"	28.73	12.67
C92	205.35	13° 15' 27"	47.52	23.85
C93	205.35	11° 34' 40"	47.49	23.82
C94	205.35	08° 07' 48"	29.47	14.94
C95	230.00	08° 15' 32"	13.62	6.81
C96	230.00	14° 39' 53"	58.87	29.60
C97	230.00	12° 42' 50"	38.23	19.14
C98	230.00	12° 05' 08"	45.88	24.38
C99	230.00	07° 50' 13"	31.46	15.75
C100	1799.14	01° 28' 49"	46.22	23.11
C101	15.00	51° 22' 48"	12.37	6.20
C102	38242.75	00° 29' 59"	333.61	166.80
C103	25.50	89° 58' 30"	38.24	24.87
C104	38225.75	00° 29' 44"	330.62	165.31

CURVE DATA TABLE

LABEL	RADIUS	CENTRAL ANGLE	ARC LENGTH	TAN. LENGTH
C104	38225.75	00° 29' 44"	330.62	165.31
C105	25.00	89° 58' 30"	38.24	24.87
C106	38242.75	00° 27' 06"	635.56	317.79
C107	25.00	78° 06' 28"	13.66	6.86
C108	257.00	22° 46' 35"	102.16	51.77
C109	15.50	81° 07' 29"	21.95	11.37
C110	247.00	23° 59' 08"	103.33	52.43
C111	25.00	76° 37' 32"	33.43	19.75
C112	38225.75	00° 56' 04"	623.51	311.76
C113	247.00	37° 06' 32"	158.91	82.91
C114	15.50	81° 07' 29"	21.95	11.37
C115	257.00	37° 26' 13"	167.92	87.08
C116	25.00	112° 36' 51"	49.14	27.50
C117	187.00	69° 24' 57"	226.56	129.62
C118	38225.75	00° 13' 34"	150.86	75.43
C119	15.50	90° 00' 00"	24.35	15.50
C120	136.26	44° 09' 39"	105.02	55.28
C121	45.00	221° 59' 22"	174.35	87.18
C122	25.50	86° 09' 01"	38.34	23.84
C123	15.50	90° 00' 00"	24.35	15.50
C124	184.10	32° 27' 14"	104.28	53.58
C125	15.50	78° 17' 35"	21.18	12.62
C126	15.50	91° 23' 19"	24.72	15.88
C127	25.50	44° 14' 57"	19.69	10.37
C128	45.00	268° 29' 54"	210.88	107.37
C129	25.50	44° 14' 57"	19.69	10.37
C130	15.50	88° 36' 41"	23.97	15.13
C131	180.00	00° 23' 19"	287.11	143.56
C132	15.50	90° 00' 00"	24.35	15.50
C133	25.50	27° 20' 52"	12.17	6.20
C134	15.50	145° 30' 54"	151.71	75.86
C135	25.50	27° 20' 52"	12.17	6.20
C136	1689.14	01° 28' 49"	43.64	21.82
C137	1639.14	01° 28' 49"	42.34	21.17
C138	25.50	44° 14' 57"	19.69	10.37
C139	15.50	90° 00' 00"	24.35	15.50
C140	230.00	50° 45' 05"	203.73	109.09
C141	15.50	80° 30' 15"	21.78	11.12
C142	205.35	32° 57' 55"	110.15	60.75
C143	155.35	32° 57' 55"	89.38	45.97
C144	15.50	90° 30' 16"	21.78	11.12
C145	15.50	80° 33' 41"	21.78	11.12
C146	181.47	88° 10' 36"	279.27	175.78
C147	231.47	42° 46' 19"	172.79	90.65
C148	231.47	42° 46' 19"	172.79	90.65
C149	25.50	44° 14' 57"	19.69	10.37
C150	45.00	268° 29' 54"	210.88	107.37
C151	15.50	44° 14' 57"	19.69	10.37
C152	15.50	80° 33' 41"	21.78	11.12
C153	231.47	23° 05' 50"	93.31	47.30
C154	15.50	105° 18' 34"	28.76	20.89
C155	134.10	24° 25' 14"	57.16	29.02

NOTE: DIRECT VEHICULAR ACCESS TO LAKE SOUTH DR. & GRAND CANYON DR. FROM THE ABUTTING LOTS IS PROHIBITED.

FUTURE "VISTA DEL LAGO UNIT NO 2"