


D:\DRAWINGS\KUBICEK\WALGREENS\WAL-SHT2.dwg Mon Jun 14 09:11:40 1999 DRK

06803

16567

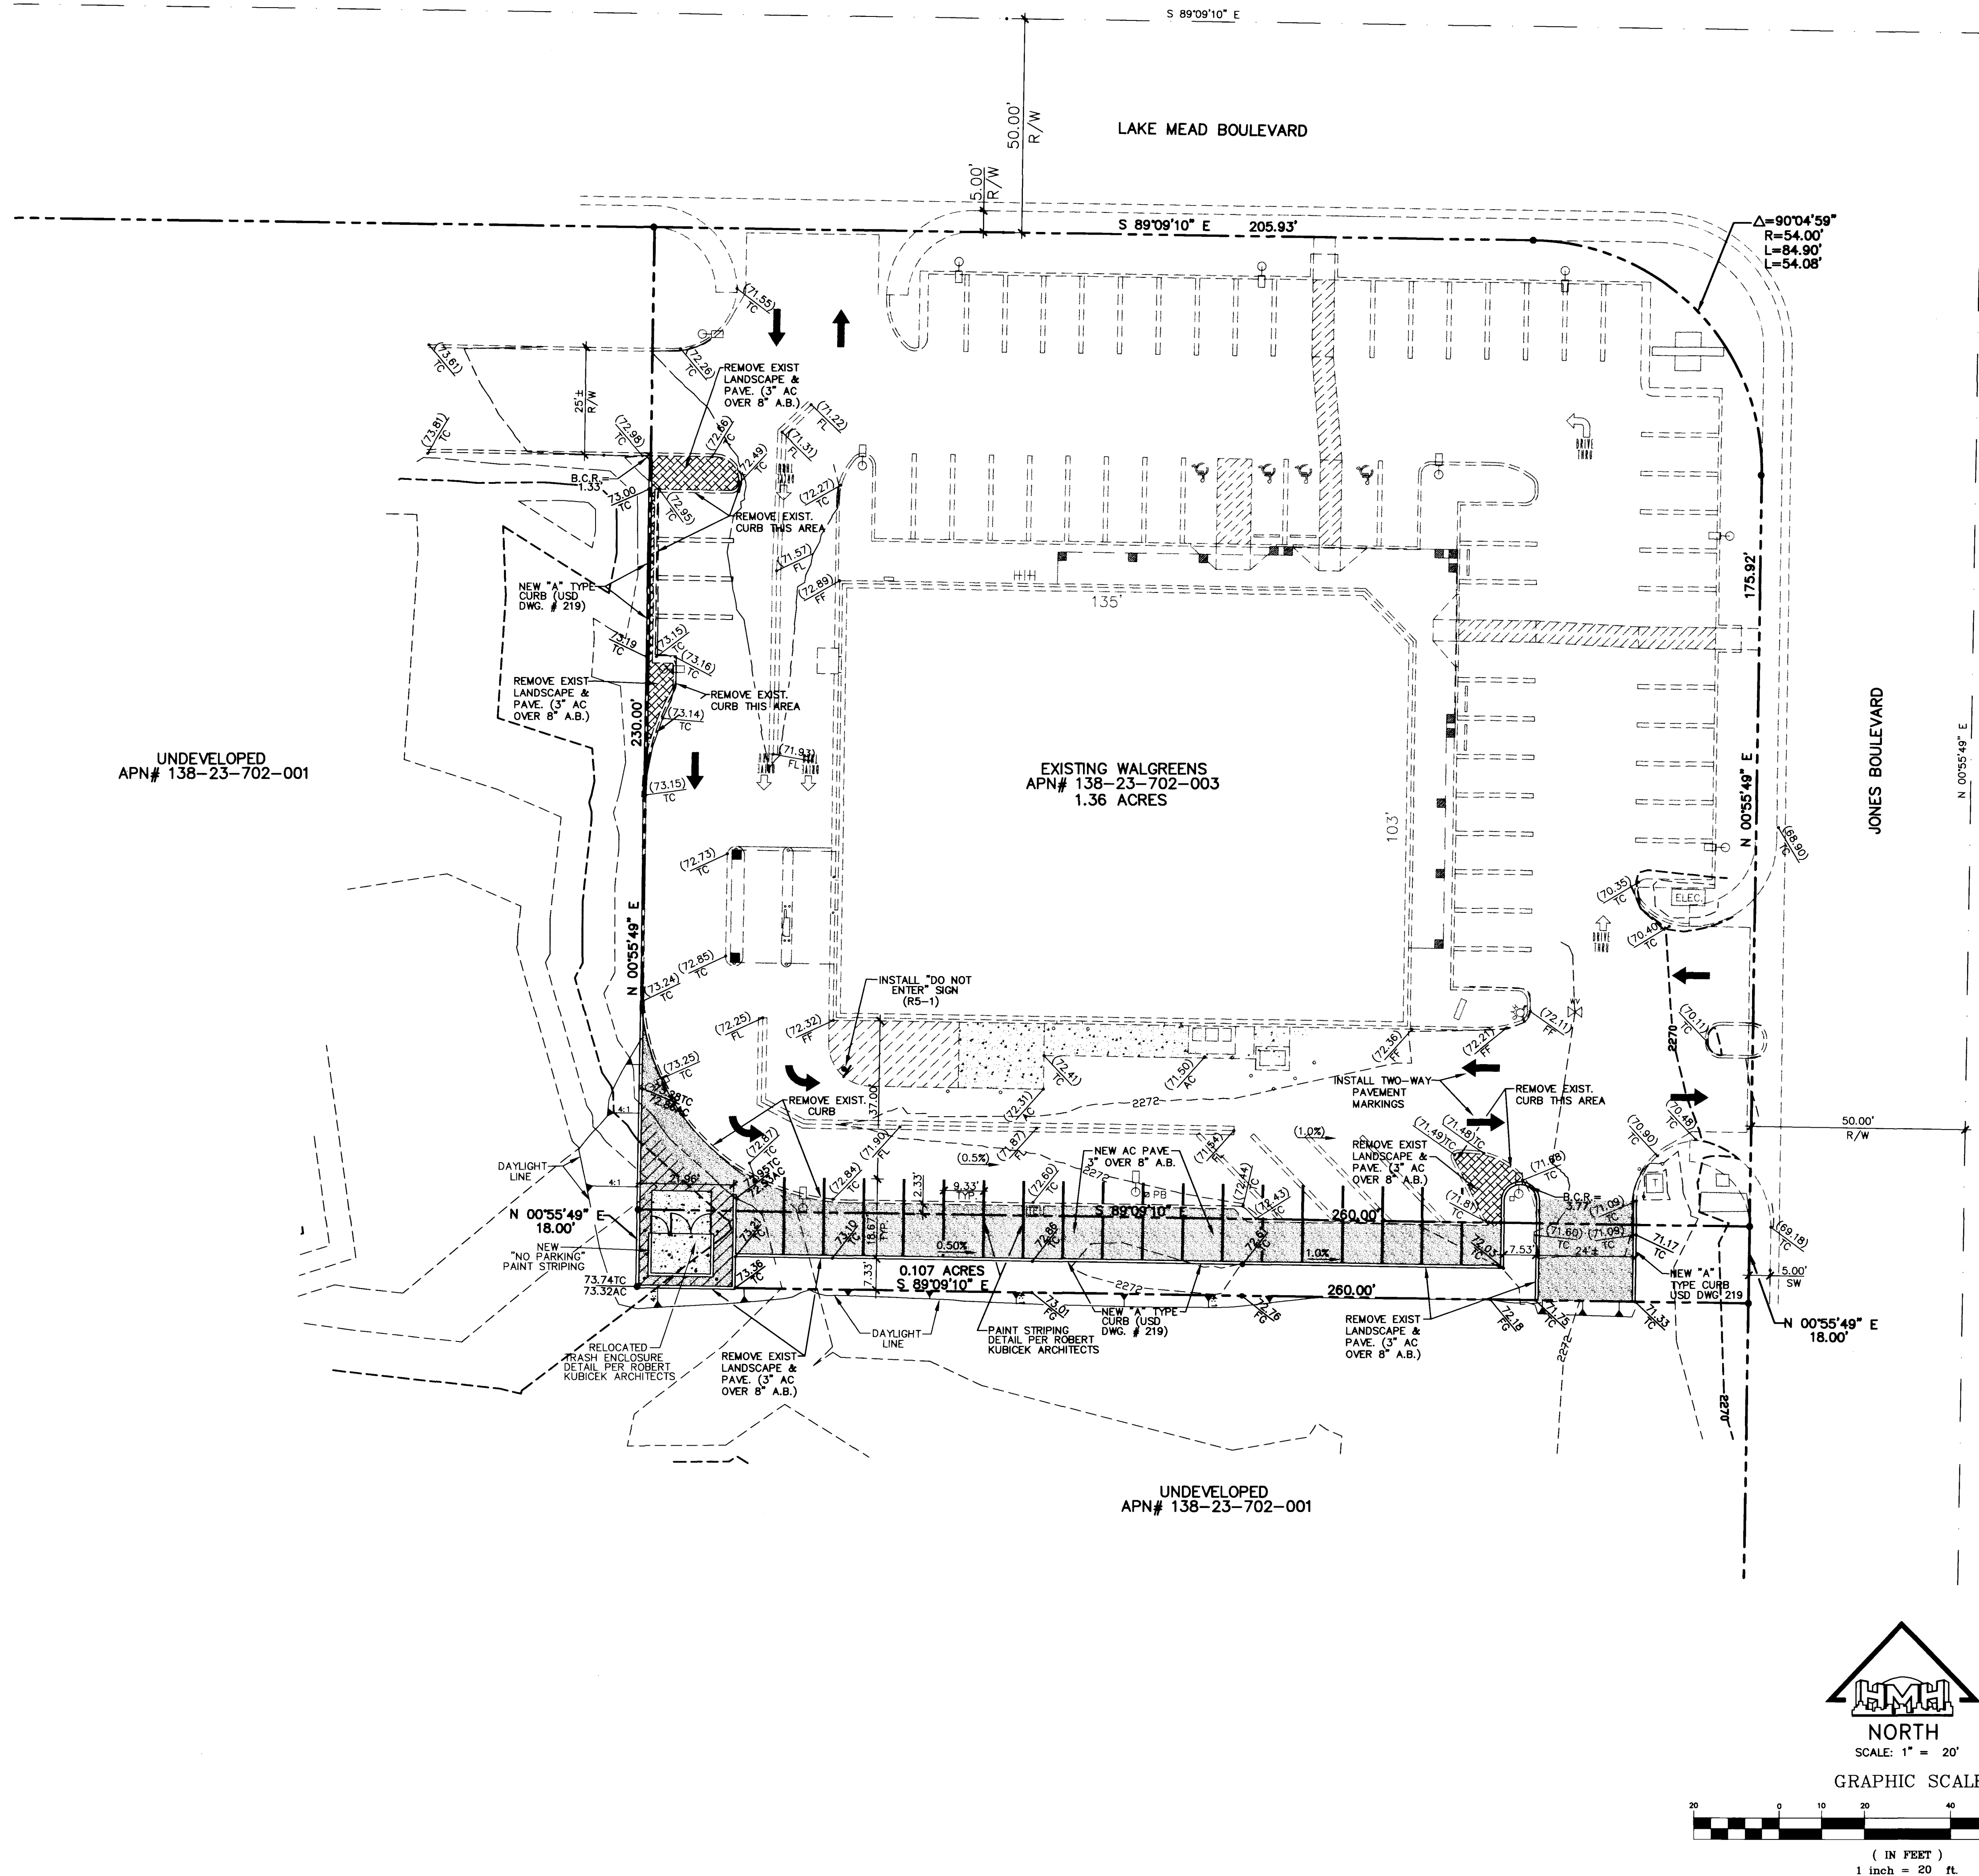

AVOID CUTTING OVERHEAD
UTILITY LINES. IT'S COSTLY

**Call
before you
Dig.**

1-800-227-2600
UNDERGROUND SERVICE (USA)


AVOID HITTING OVERHEAD
UTILITY LINES. IT'S COSTLY

**CALL BEFORE
YOU DO
OVERHEAD**

1-702-593-6111

BENCHMARK
CLARK COUNTY BENCHMARK NUMBER 7C00-23C4
BEING A RIVET AND SQUARE ALUMINUM PLATE IN
TOP OF CURB, SOUTHWEST CORNER OF TORREY
PINES DR. AND LAKE MEAD BLVD. NEAR THE PC OF
TORREY PINES DR.
ELEV. = 2304.78 FT. (702.499 METERS), NAVD 88.

BASIS OF BEARINGS
SOUTH 89°09'10" EAST BEING THE BEARING OF THE
EAST/WEST 1/4 LINE OF SECTION 23, TOWNSHIP 20 SOUTH,
RANGE 60 EAST, M.D.M., CLARK COUNTY NEVADA, AS
SHOWN IN FILE 100, PAGE 25 OF RECORD OF SURVEYS IN
THE CLARK COUNTY RECORDER'S OFFICE.

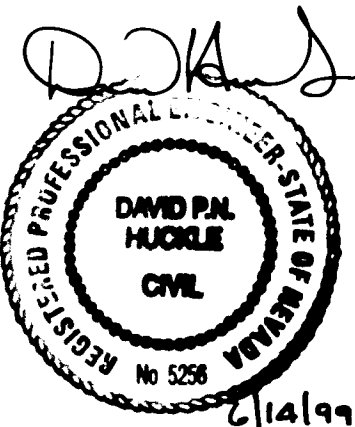

WALGREENS COMPANY
WALGREENS- LAKE MEAD BLVD & JONES BLVD.
GRADING PLAN

8080 WEST SAHARA AVENUE, SUITE D
LAS VEGAS, NEVADA 89117
PHONE: (702) 256-7850
FAX: (702) 256-1710

REV	DATE	APPROVAL	DESCRIPTION
1	6/14/99	[Signature]	REVISION - ADD TWO PARKING STALLS, REDUCE PARKING STALL STRIPING WIDTH, REDUCE TRASH CONTAINER AREA AND REDUCED CURB RETURN EAST OF NEW STALLS

SHEET
2A
SHEET NO. 2A
OF 7 SHEETS

PLOTTED: NONE

107-V2506

