


D:\DRAWINGS\KUBICKI\WALGREENS\WAL-5HT3.dwg Mon May 24 10:22:01 1999 CRK

06803  
NONE

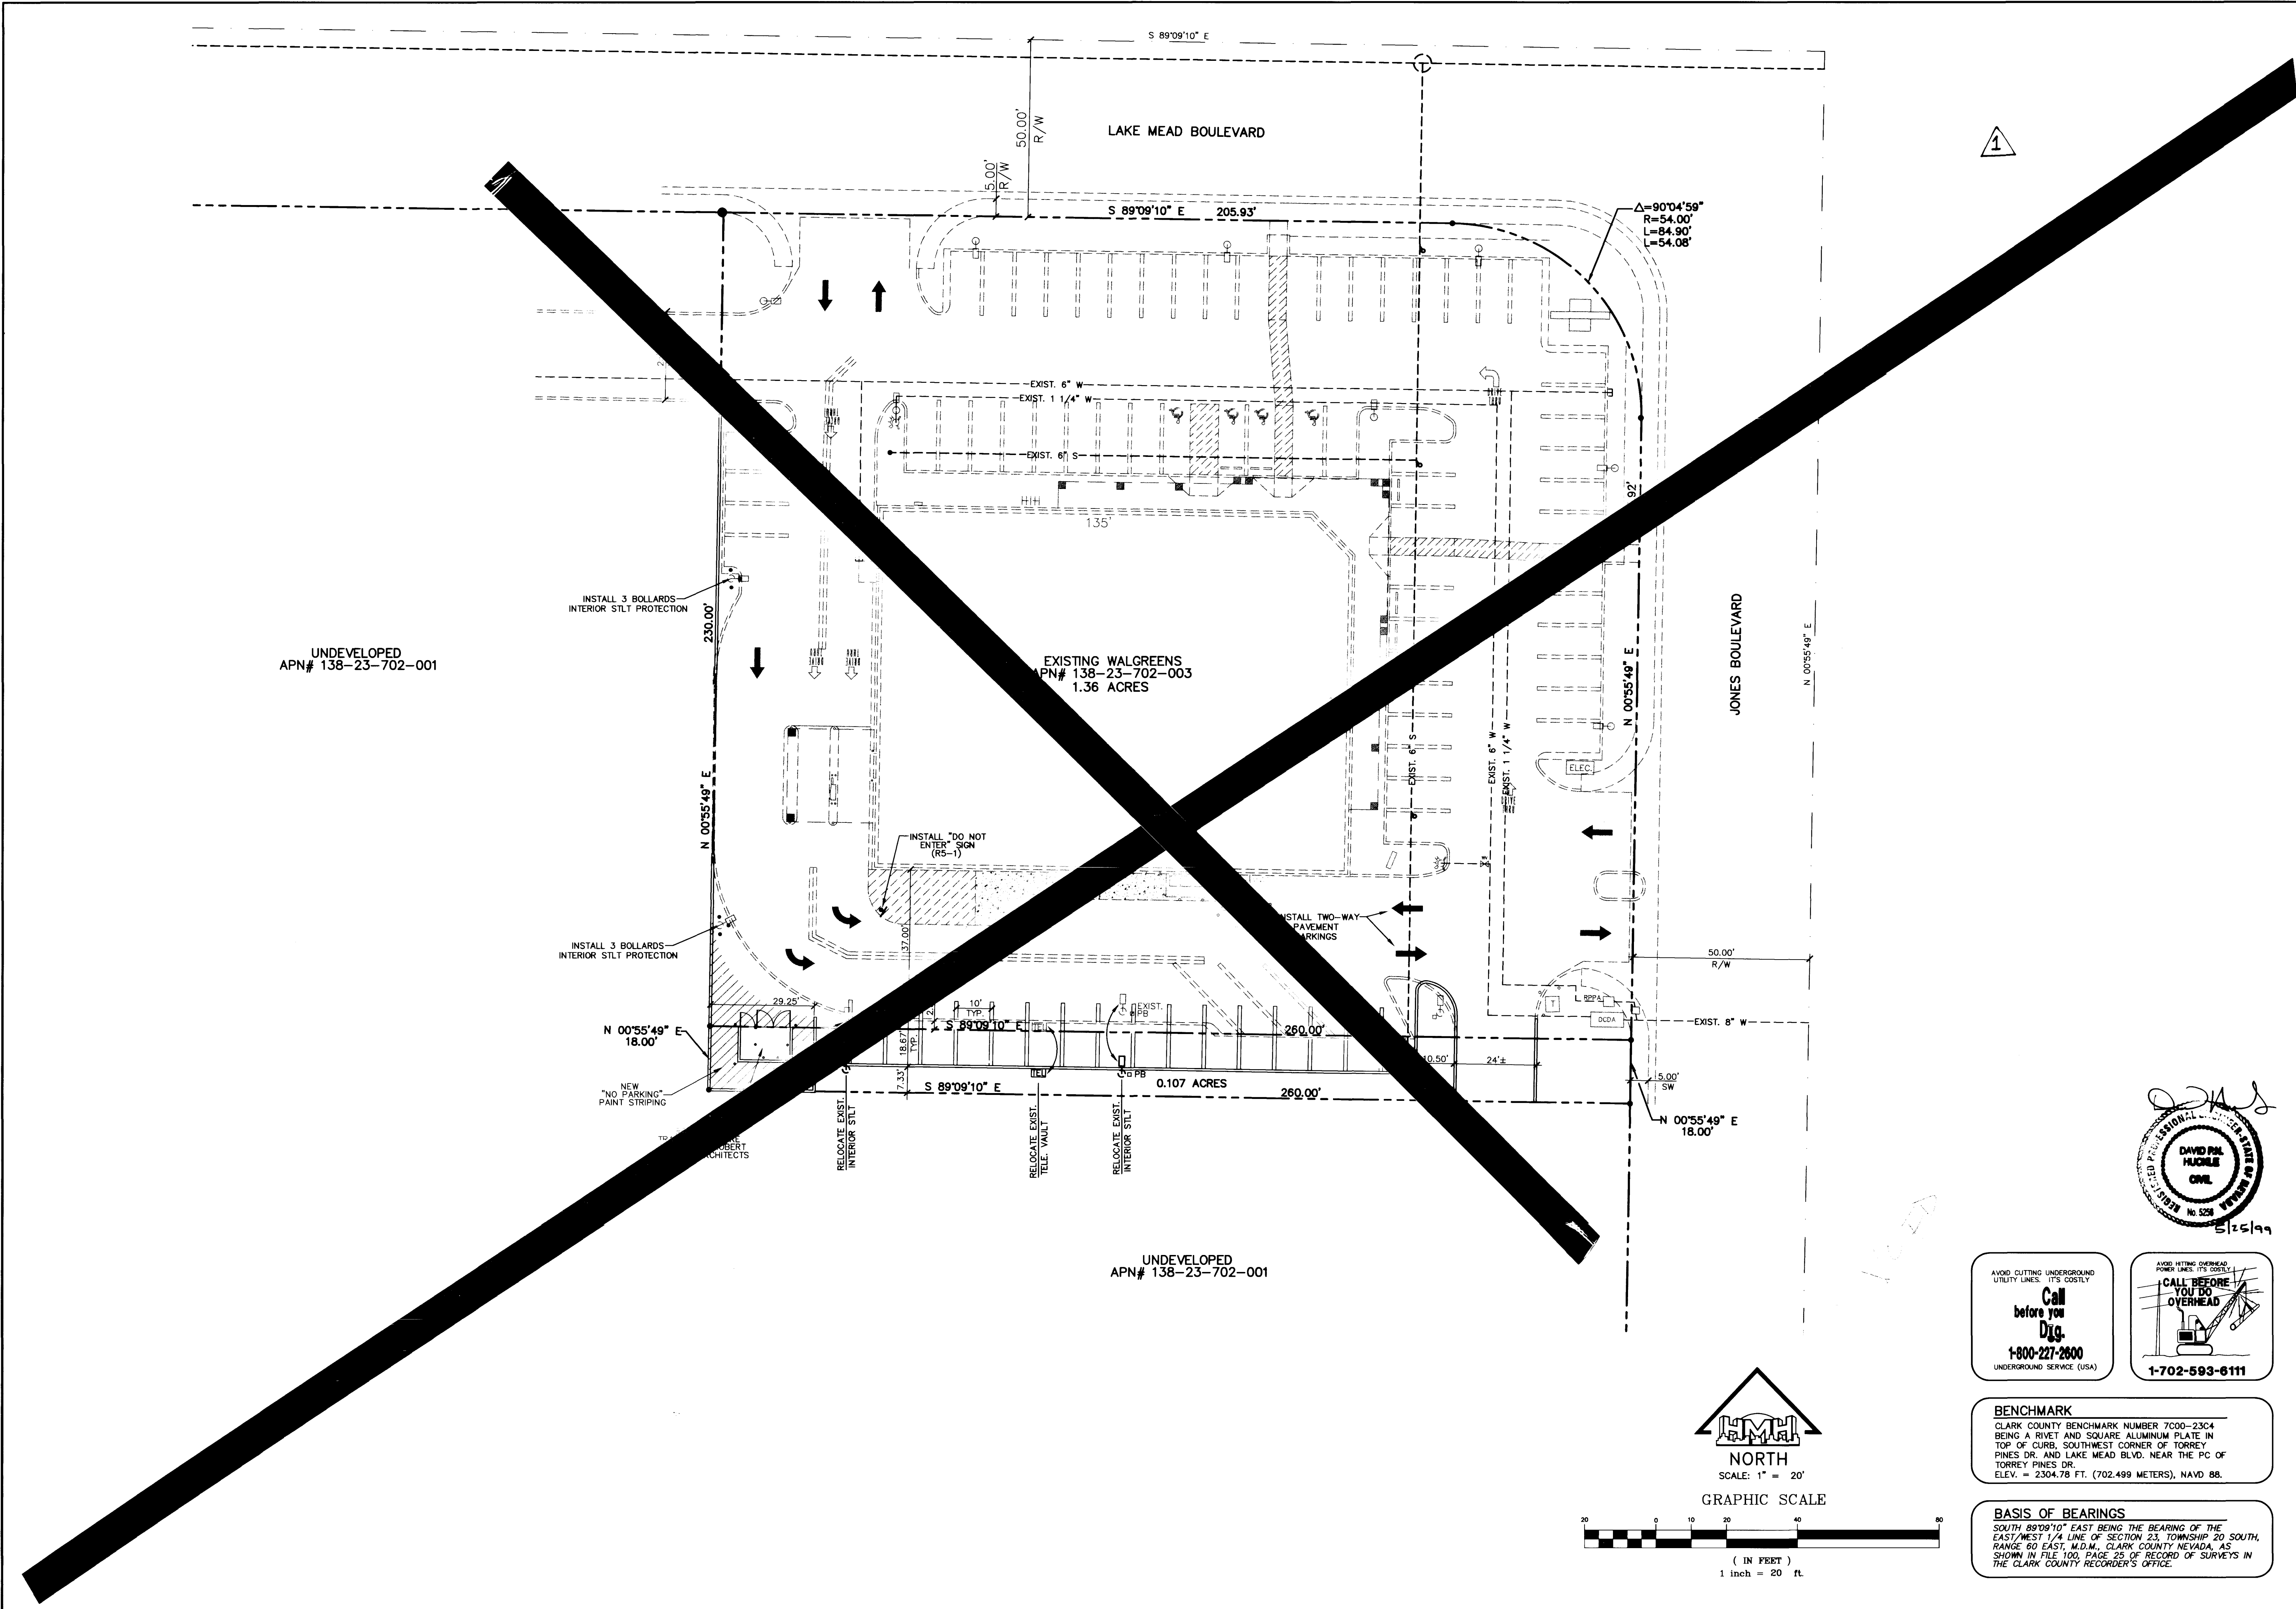

1





AVOID CUTTING UNDERGROUND UTILITY LINES. IT'S COSTLY.  
**Call before you Dig.**  
1-800-227-2600  
UNDERGROUND SERVICE (USA)



**BENCHMARK**  
CLARK COUNTY BENCHMARK NUMBER 7000-2304 BEING A RIVET AND SQUARE ALUMINUM PLATE IN TOP OF CURB, SOUTHWEST CORNER OF TORREY PINES DR. AND LAKE MEAD BLVD. NEAR THE PC OF TORREY PINES DR.  
ELEV. = 2304.78 FT. (702.499 METERS), NAVD 88.

**BASIS OF BEARINGS**  
SOUTH 89°09'10" EAST BEING THE BEARING OF THE EAST/WEST 1/4 LINE OF SECTION 23, TOWNSHIP 20 SOUTH, RANGE 60 EAST, M.D.M., CLARK COUNTY NEVADA, AS SHOWN IN FILE 100, PAGE 25 OF RECORD OF SURVEYS IN THE CLARK COUNTY RECORDER'S OFFICE.

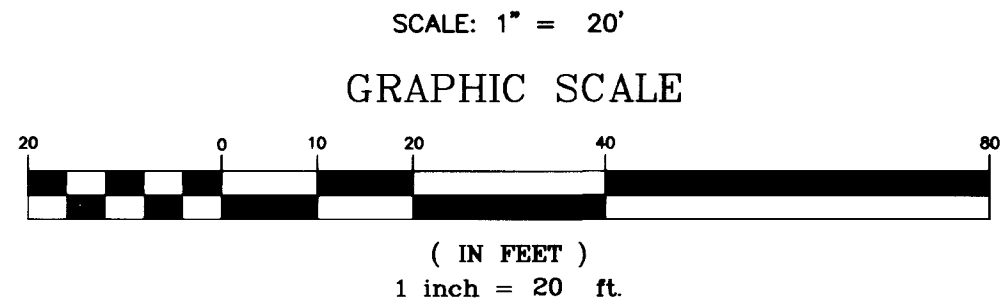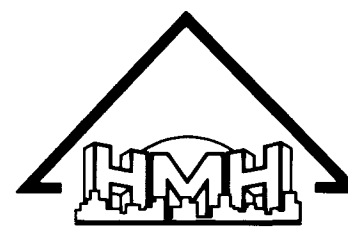

| REV | DATE    | APPROVAL        | DESCRIPTION                                        |
|-----|---------|-----------------|----------------------------------------------------|
| 1   | 5/25/99 | DAVID R. HUCKLE | VOID DWG. See Revised sheets 3A f 3a Dated 6-11-99 |

8080 WEST SAHARA AVENUE, SUITE D  
LAS VEGAS, NEVADA 89117  
PHONE: (702) 256-7850  
FAX: (702) 256-1710

**WALGREENS COMPANY**  
**WALGREENS- LAKE MEAD BLVD & JONES BLVD.**  
**UTILITY PLAN**

SHEET  
**3A**  
SHEET NO. 3A  
OF 7 SHEETS  
PLOTTED: NONE

