


01-81



1"=40'

DUCHARME AVENUE N 88°56'22" E

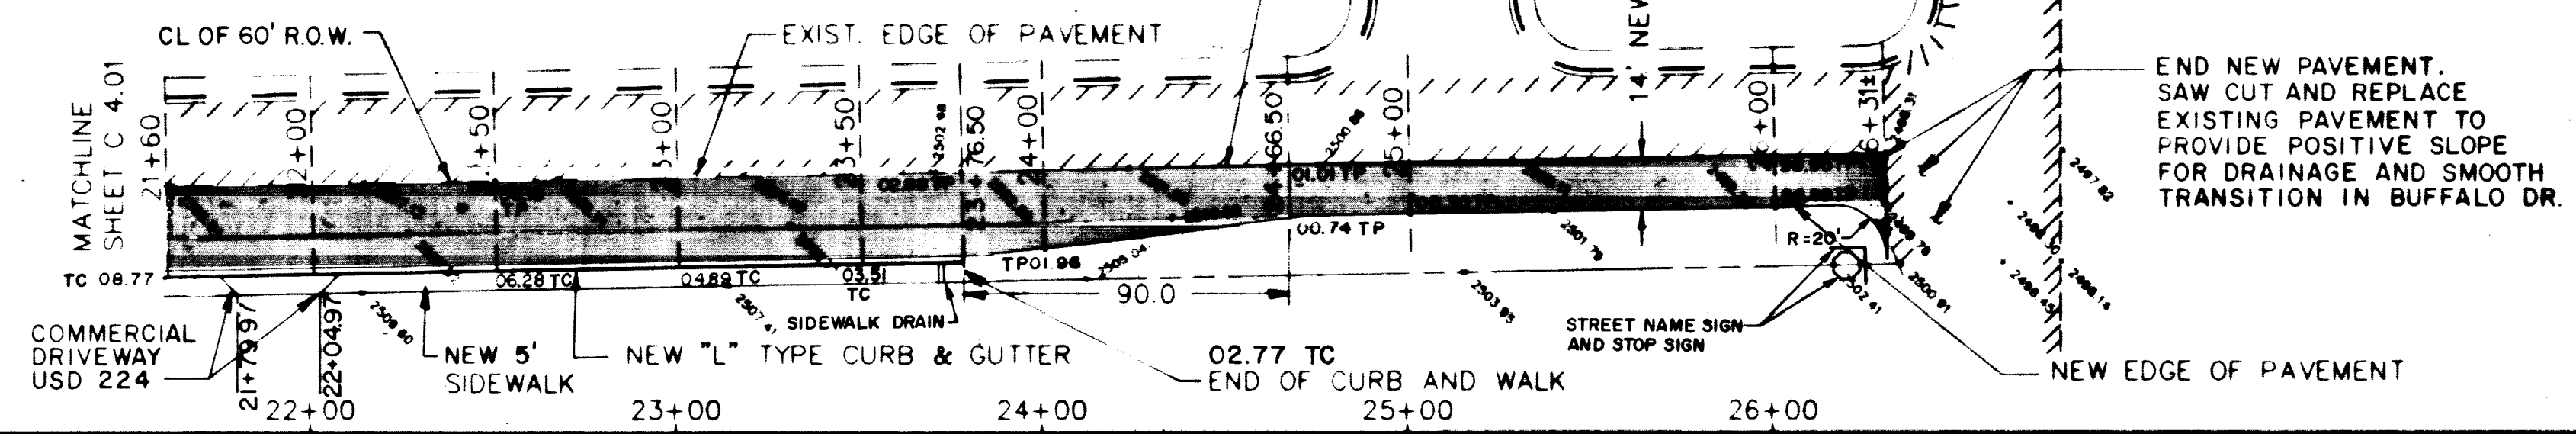




CONSTRUCT ALL OFF-SITE IMPROVEMENTS IN ACCORDANCE WITH THE UNIFORM STANDARD SPECIFICATIONS FOR PUBLIC WORKS CONSTRUCTION OFF-SITE IMPROVEMENTS, CLARK COUNTY AREA, NEVADA, LATEST ISSUE AND THE 'UNIFORM STANDARD DRAWINGS' (USD).

REVISIONS		
REV.	DESCRIPTION	DATE
1	REVISED SIDEWALK WIDTH IN ALTA DRIVE	11/20/20

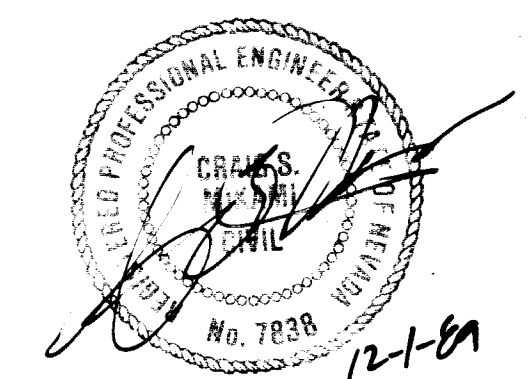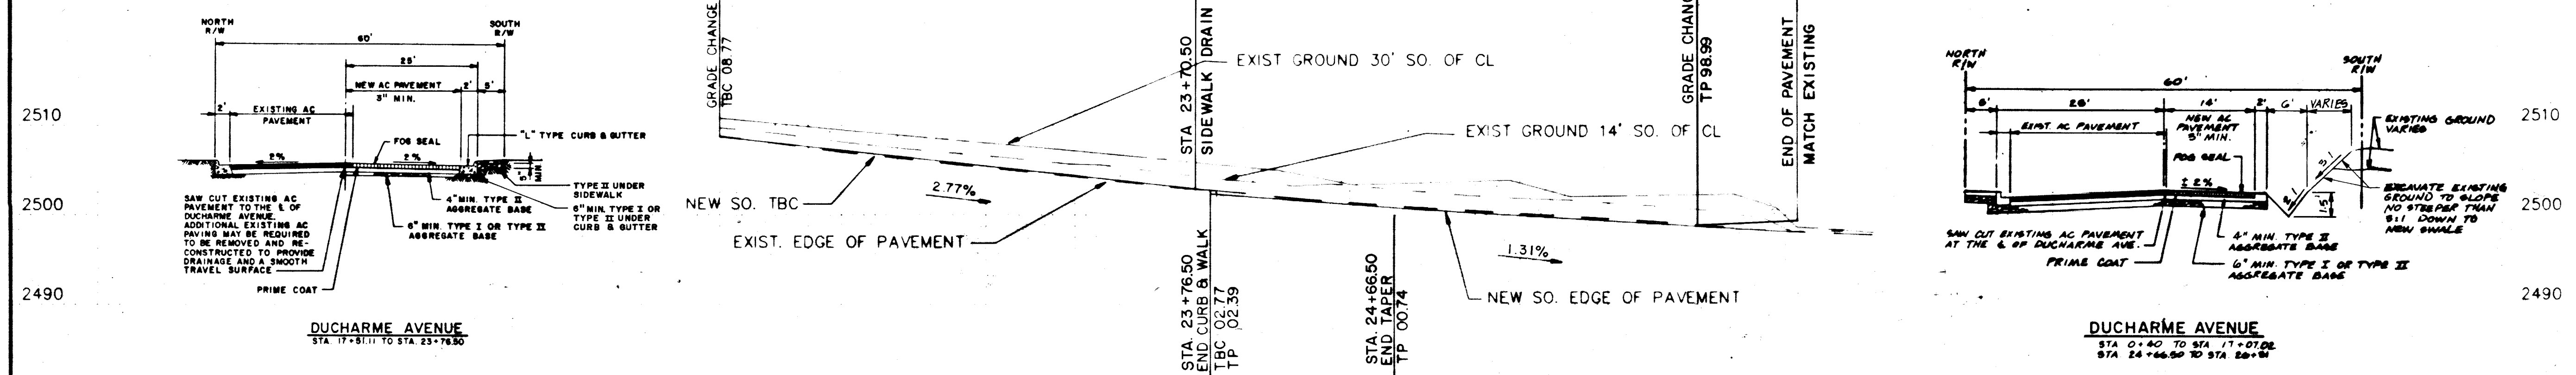

1"=40'

ALTA DRIVE S 89°05'18" W

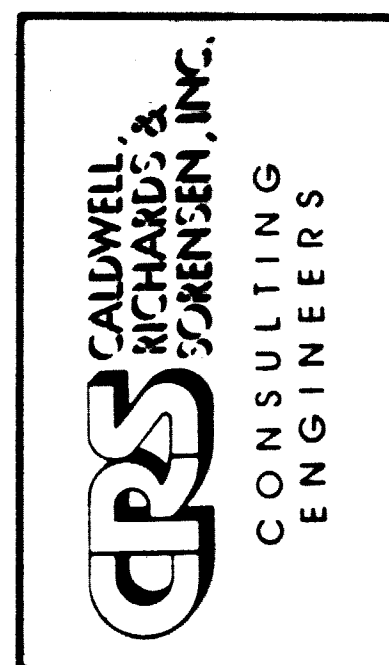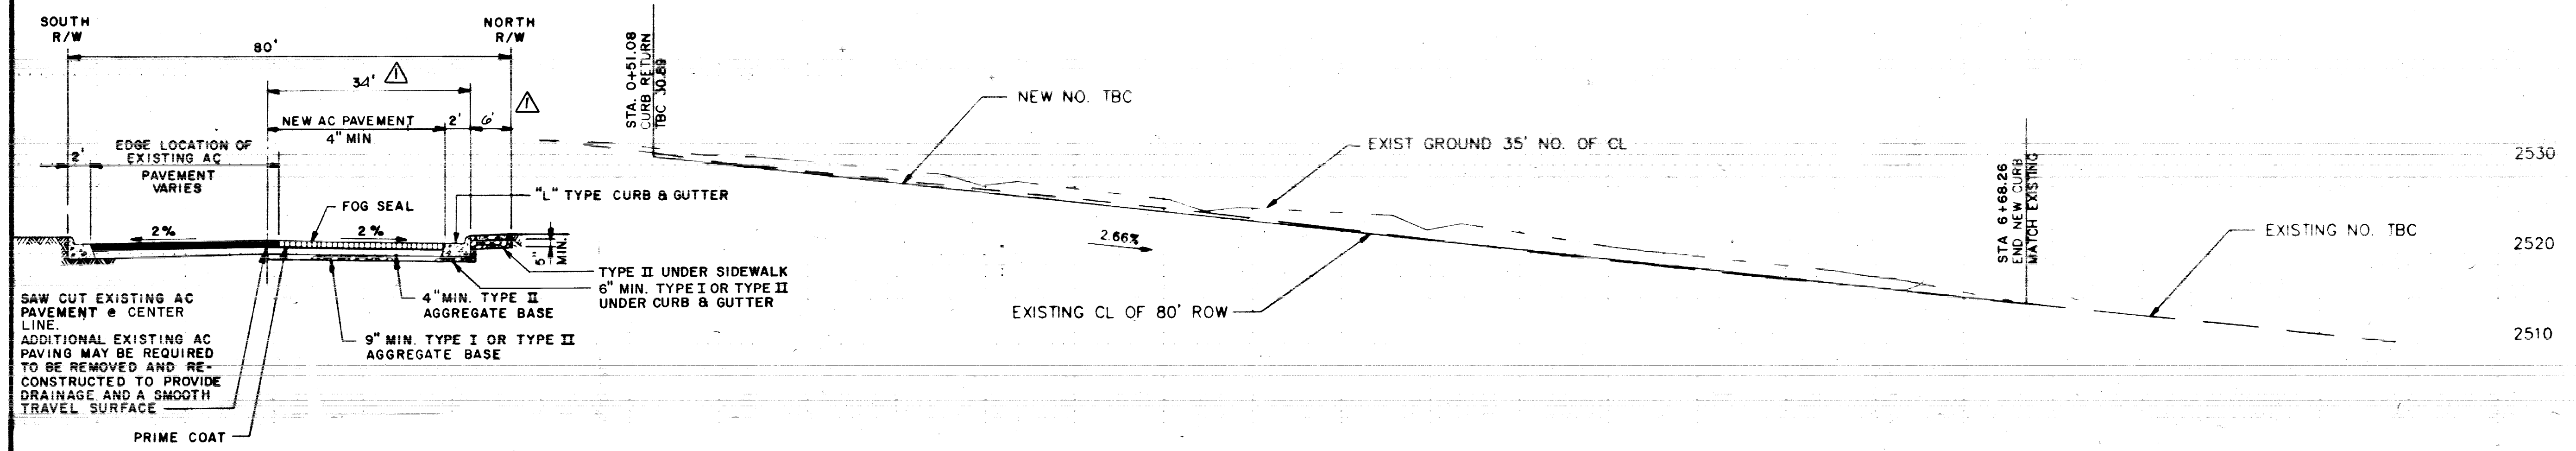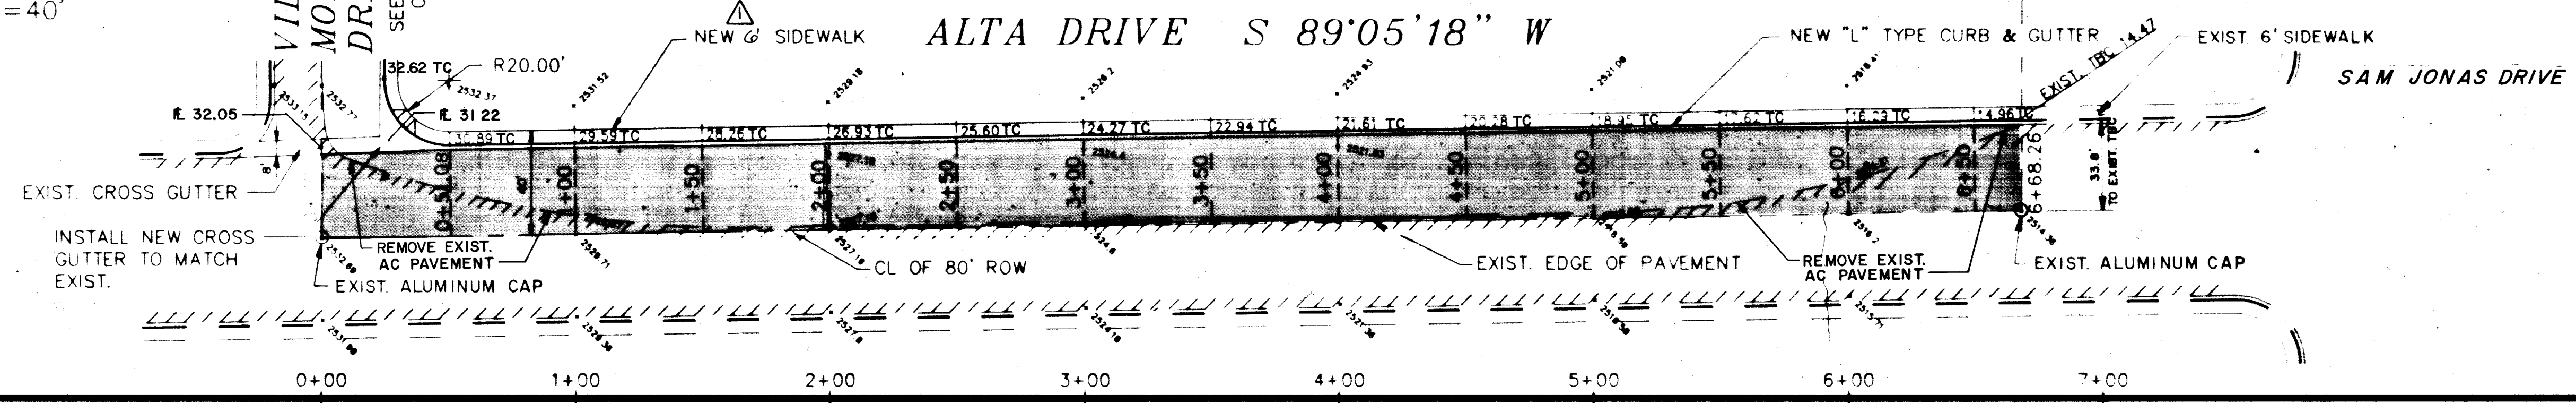

CLARK COUNTY SCHOOL DISTRICT

WALTER D. JOHNSON
JUNIOR HIGH SCHOOL
OFF-SITE IMPROVEMENTS

C 4.02




10



DUCHARME AVENUE N 88°56'22" E



ALTA DRIVE S 89°05'18" W

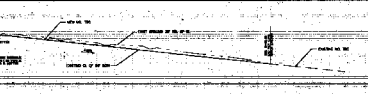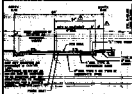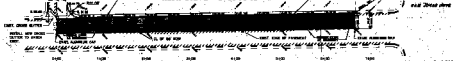

CLARK COUNTY SCHOOL DISTRICT

WALTER D. JOHNSON

JUNIOR HIGH SCHOOL

OFF-SITE IMPROVEMENTS

C 4.02

112-12