
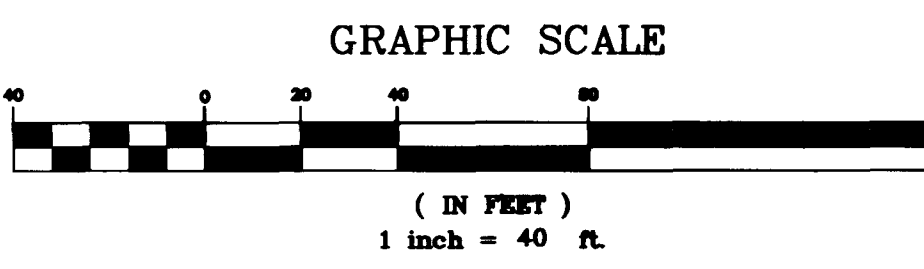
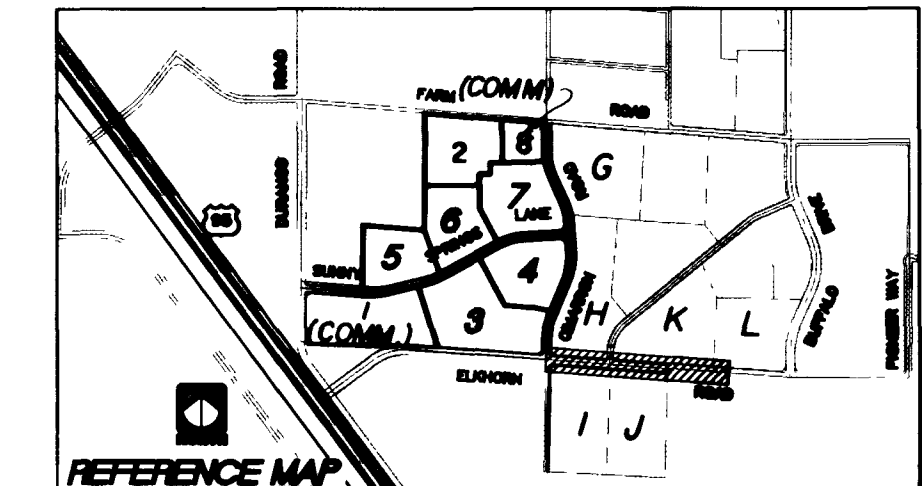


0: ELKHORNSW-10.dwg TUE JUN 16 16:24:30 1994 SHARED 1-S WATTEOUT 10, SOLID 11 & UP- 486-5041
HP DesignPlot 0001: HP-GL/2 ADI 4.2 PLOTTER DRIVER BY MARKET-BOARD 1.0

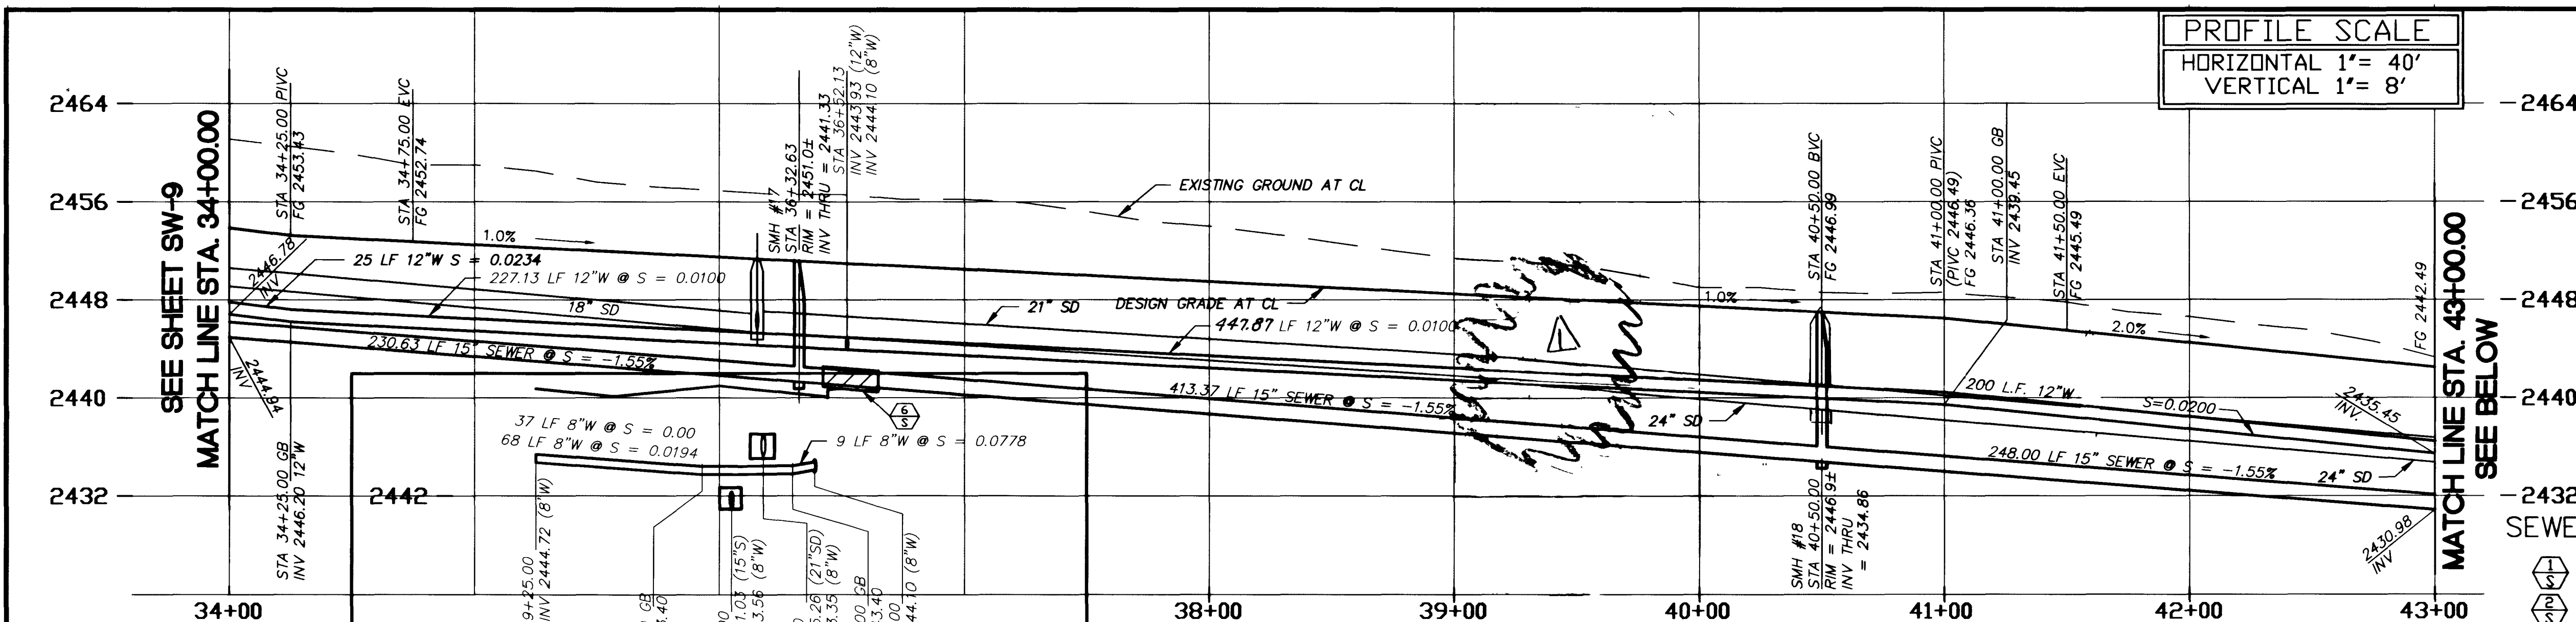

SEWER NOTES



- 1. INSTALL STANDARD 4' DIA. SEWER MANHOLE
- 2. INSTALL 8" PVC (SDR-35) SEWER LINE.
- 3. INSTALL SEWER PLUG.
- 5. INSTALL 15" SEWER LINE.
- 6. INSTALL CONCRETE ENCASEMENT

WATER NOTES


- 1. INST 8" WATER MAIN PER LVVWD STDs
- 2. INST END CAP AND 2" MANUAL BLOW-OFF ASSEMBLY WITH THRUST BLOCK PER LVVWD STD PLATE NO 4
- 3. INST FIRE HYDRANT ASSEMBLY PER LVVWD STD PLATE NO 7
- 4. INST 2" BLOW-OFF VALVE PER LVVWD STD PLATE NO 4
- 5. INST 12" WATER MAIN PER LVVWD STDs
- 6. INST 12"x8" TEE WITH (1) 8" GATE VALVE WITH THRUST BLOCK PER LVVWD STDs
- 7. INST 12" GATE VALVE WITH THRUST BLOCK PER LVVWD STDs.
- 8. INST 12"x8" TEE WITH (1) 12" GATE VALVE AND WITH (1) 8" GATE VALVE WITH THRUST BLOCK PER LVVWD STDs
- 9. INST 45' 12" ELBOW WITH THRUST BLOCK PER LVVWD STDs
- 10. INST 45' 8" ELBOW WITH THRUST BLOCK PER LVVWD STDs

BENCHMARK:

BM NO. 1LV9020NES
ALUMINUM TAG AT THE CENTERLINE
INTERSECTION OF ELKHORN ROAD AND
DURANGO DRIVE.
ELEVATION = 2528.49

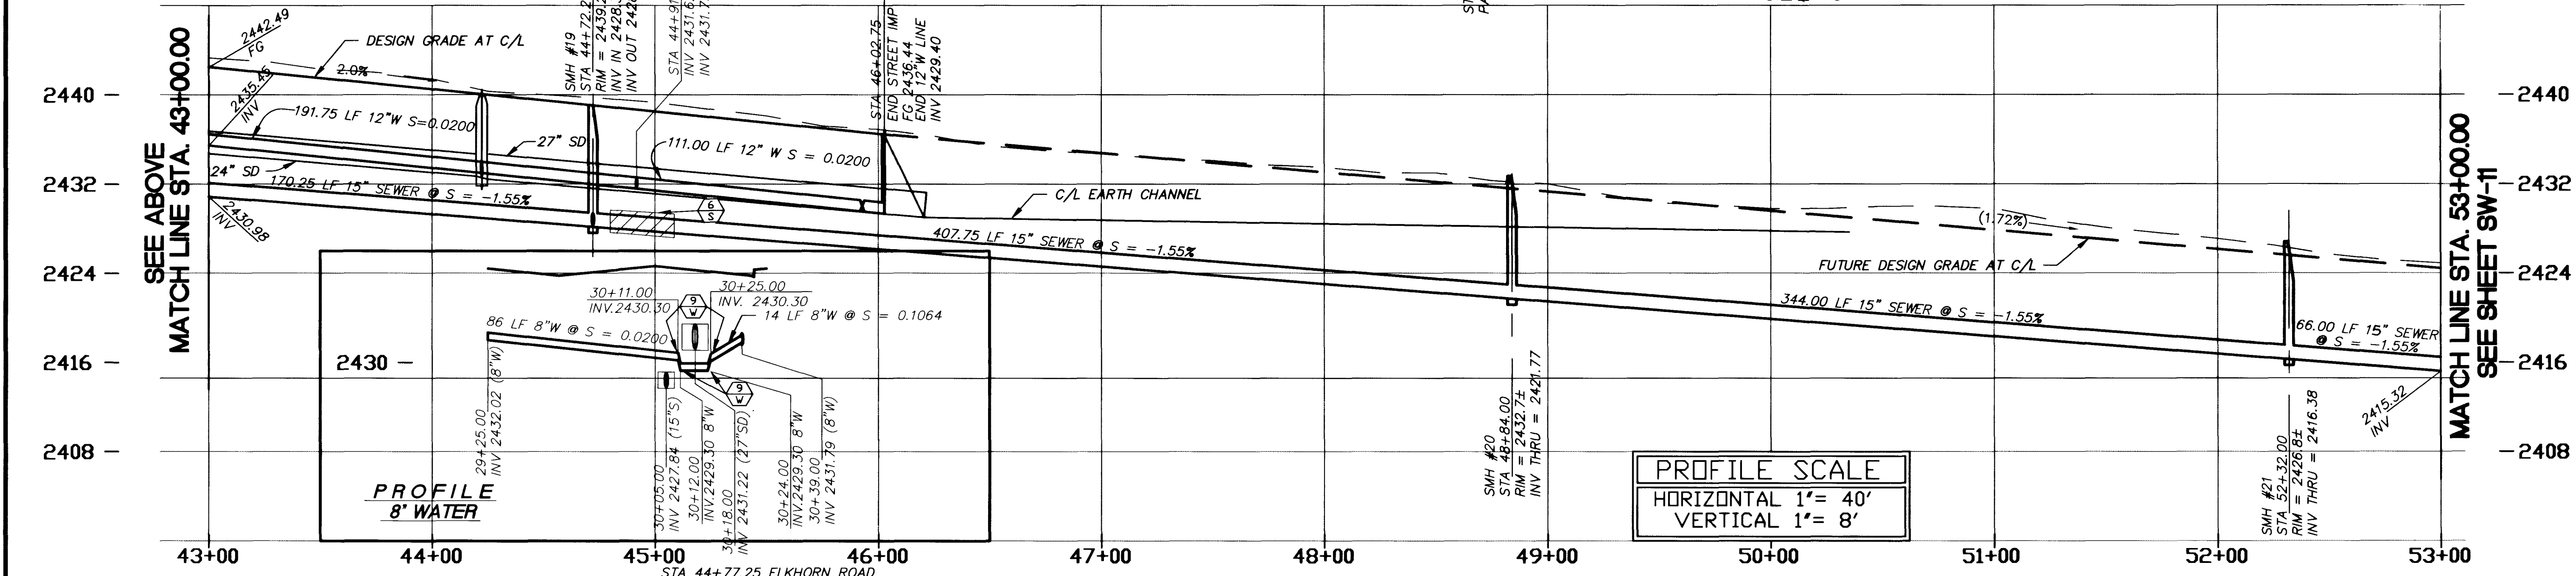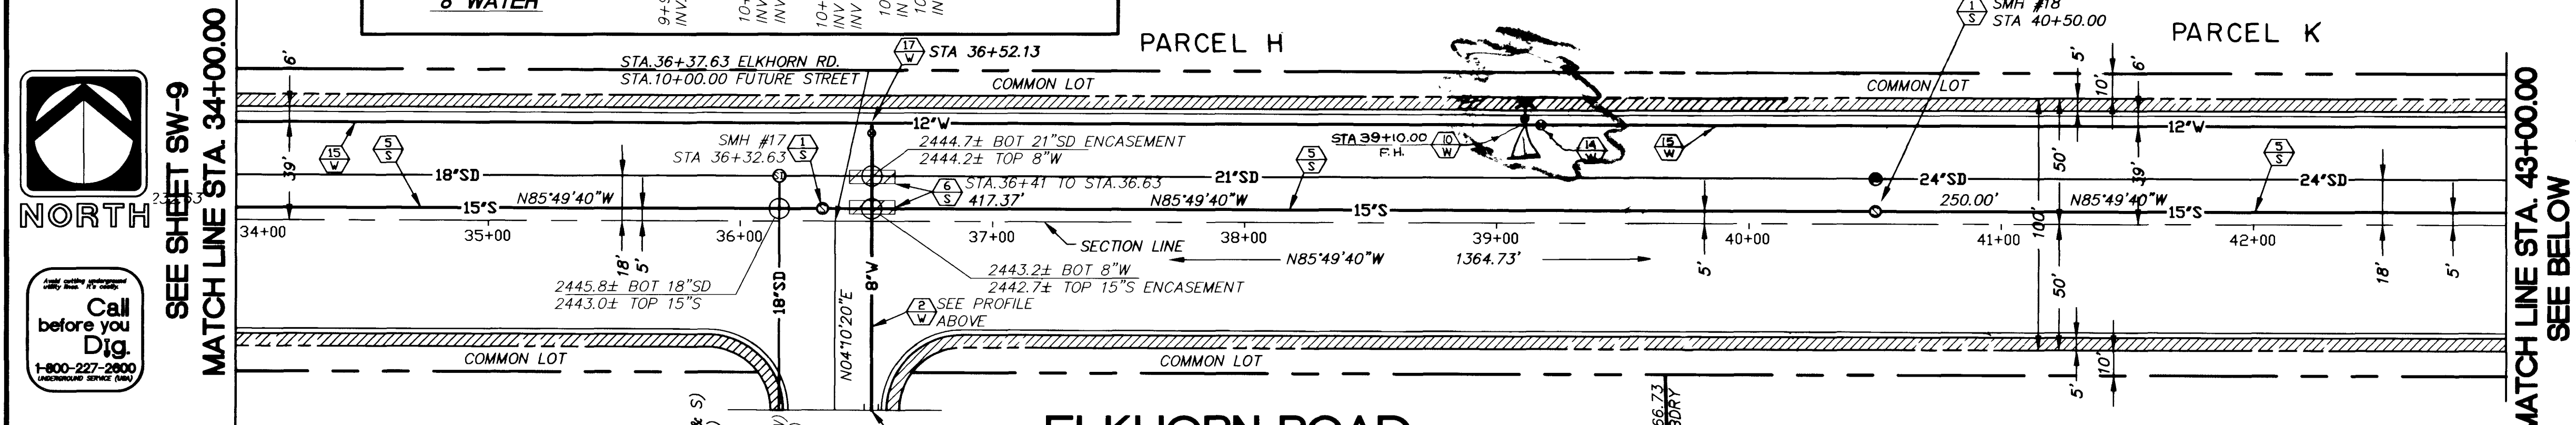

SEE SHEET SW-11

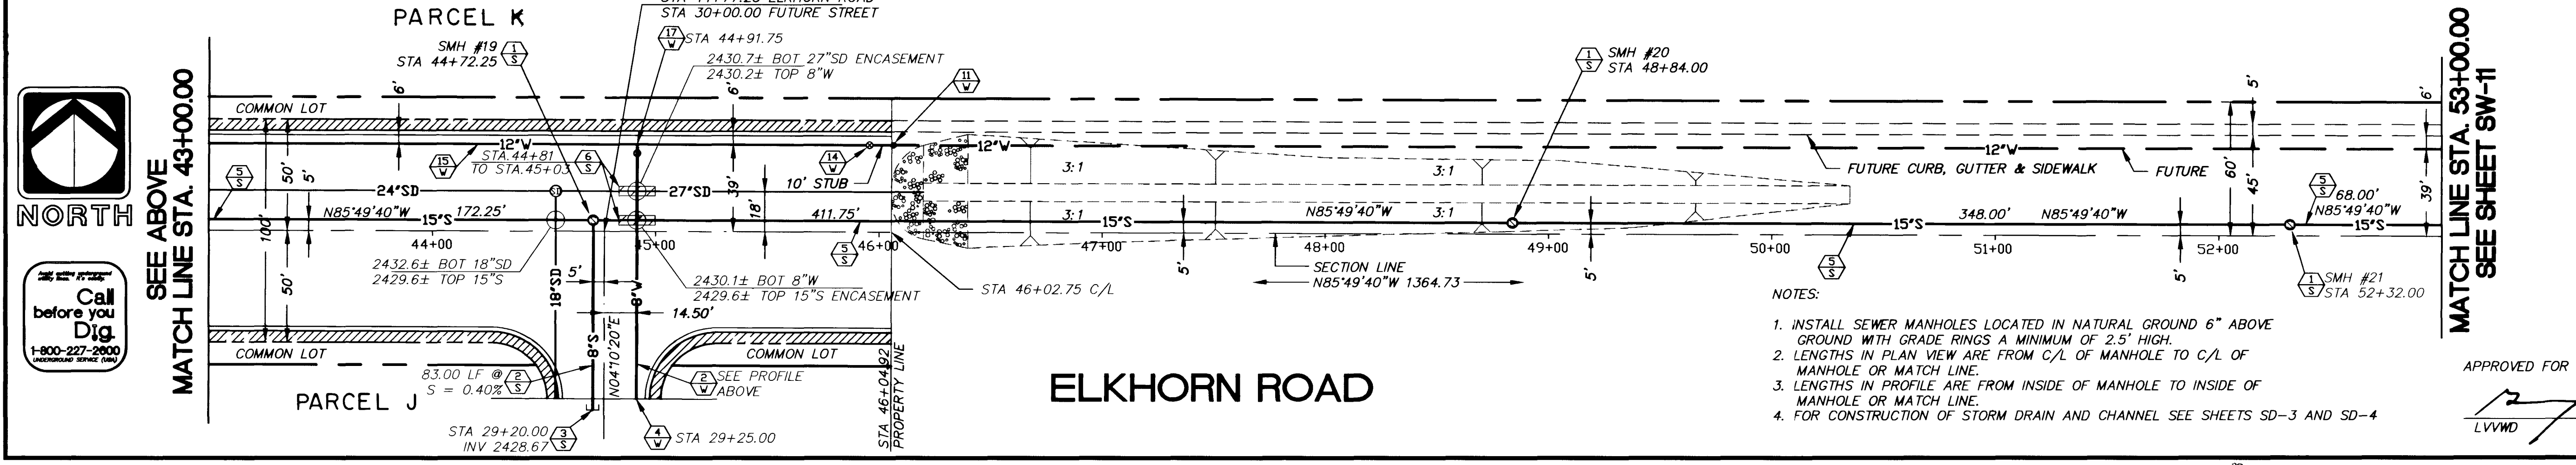

- NOTES:
- 1. INSTALL SEWER MANHOLES LOCATED IN NATURAL GROUND 6" ABOVE GROUND WITH GRADE RINGS A MINIMUM OF 2.5' HIGH.
 - 2. LENGTHS IN PLAN VIEW ARE FROM C/L OF MANHOLE TO C/L OF MANHOLE OR MATCH LINE.
 - 3. LENGTHS IN PROFILE ARE FROM INSIDE OF MANHOLE TO INSIDE OF MANHOLE OR MATCH LINE.
 - 4. FOR CONSTRUCTION OF STORM DRAIN AND CHANNEL SEE SHEETS SD-3 AND SD-4

APPROVED FOR CONSTRUCTION:

LVVWD


1-75-94

DATE


SHEET
SW-10
SHT 25 OF 38

WATT/MORADI CO.
ELKHORN SPRINGS - PHASE I
ELKHORN ROAD
PLAN AND PROFILE
STA. 34+00.00 TO STA. 53+00.00

THE KEITH COMPANIES
4032 SO. INDUSTRIAL RD. LAS VEGAS, NEVADA 89103 702-733-0350
PLANNING
ENGINEERING
SURVEYING
WATER RESOURCES
LANDSCAPE ARCHITECTURE

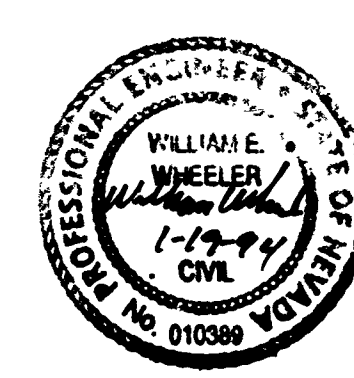

11-8-150 307Y-4299-1

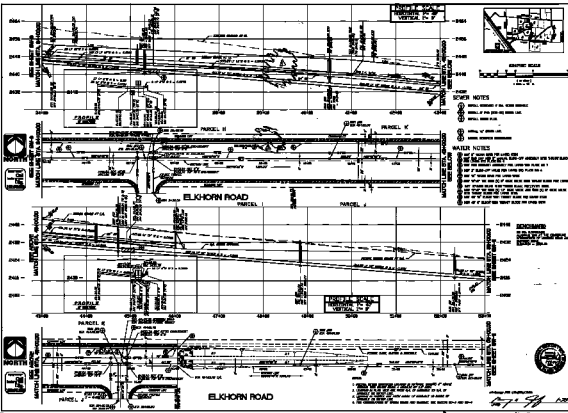
















