

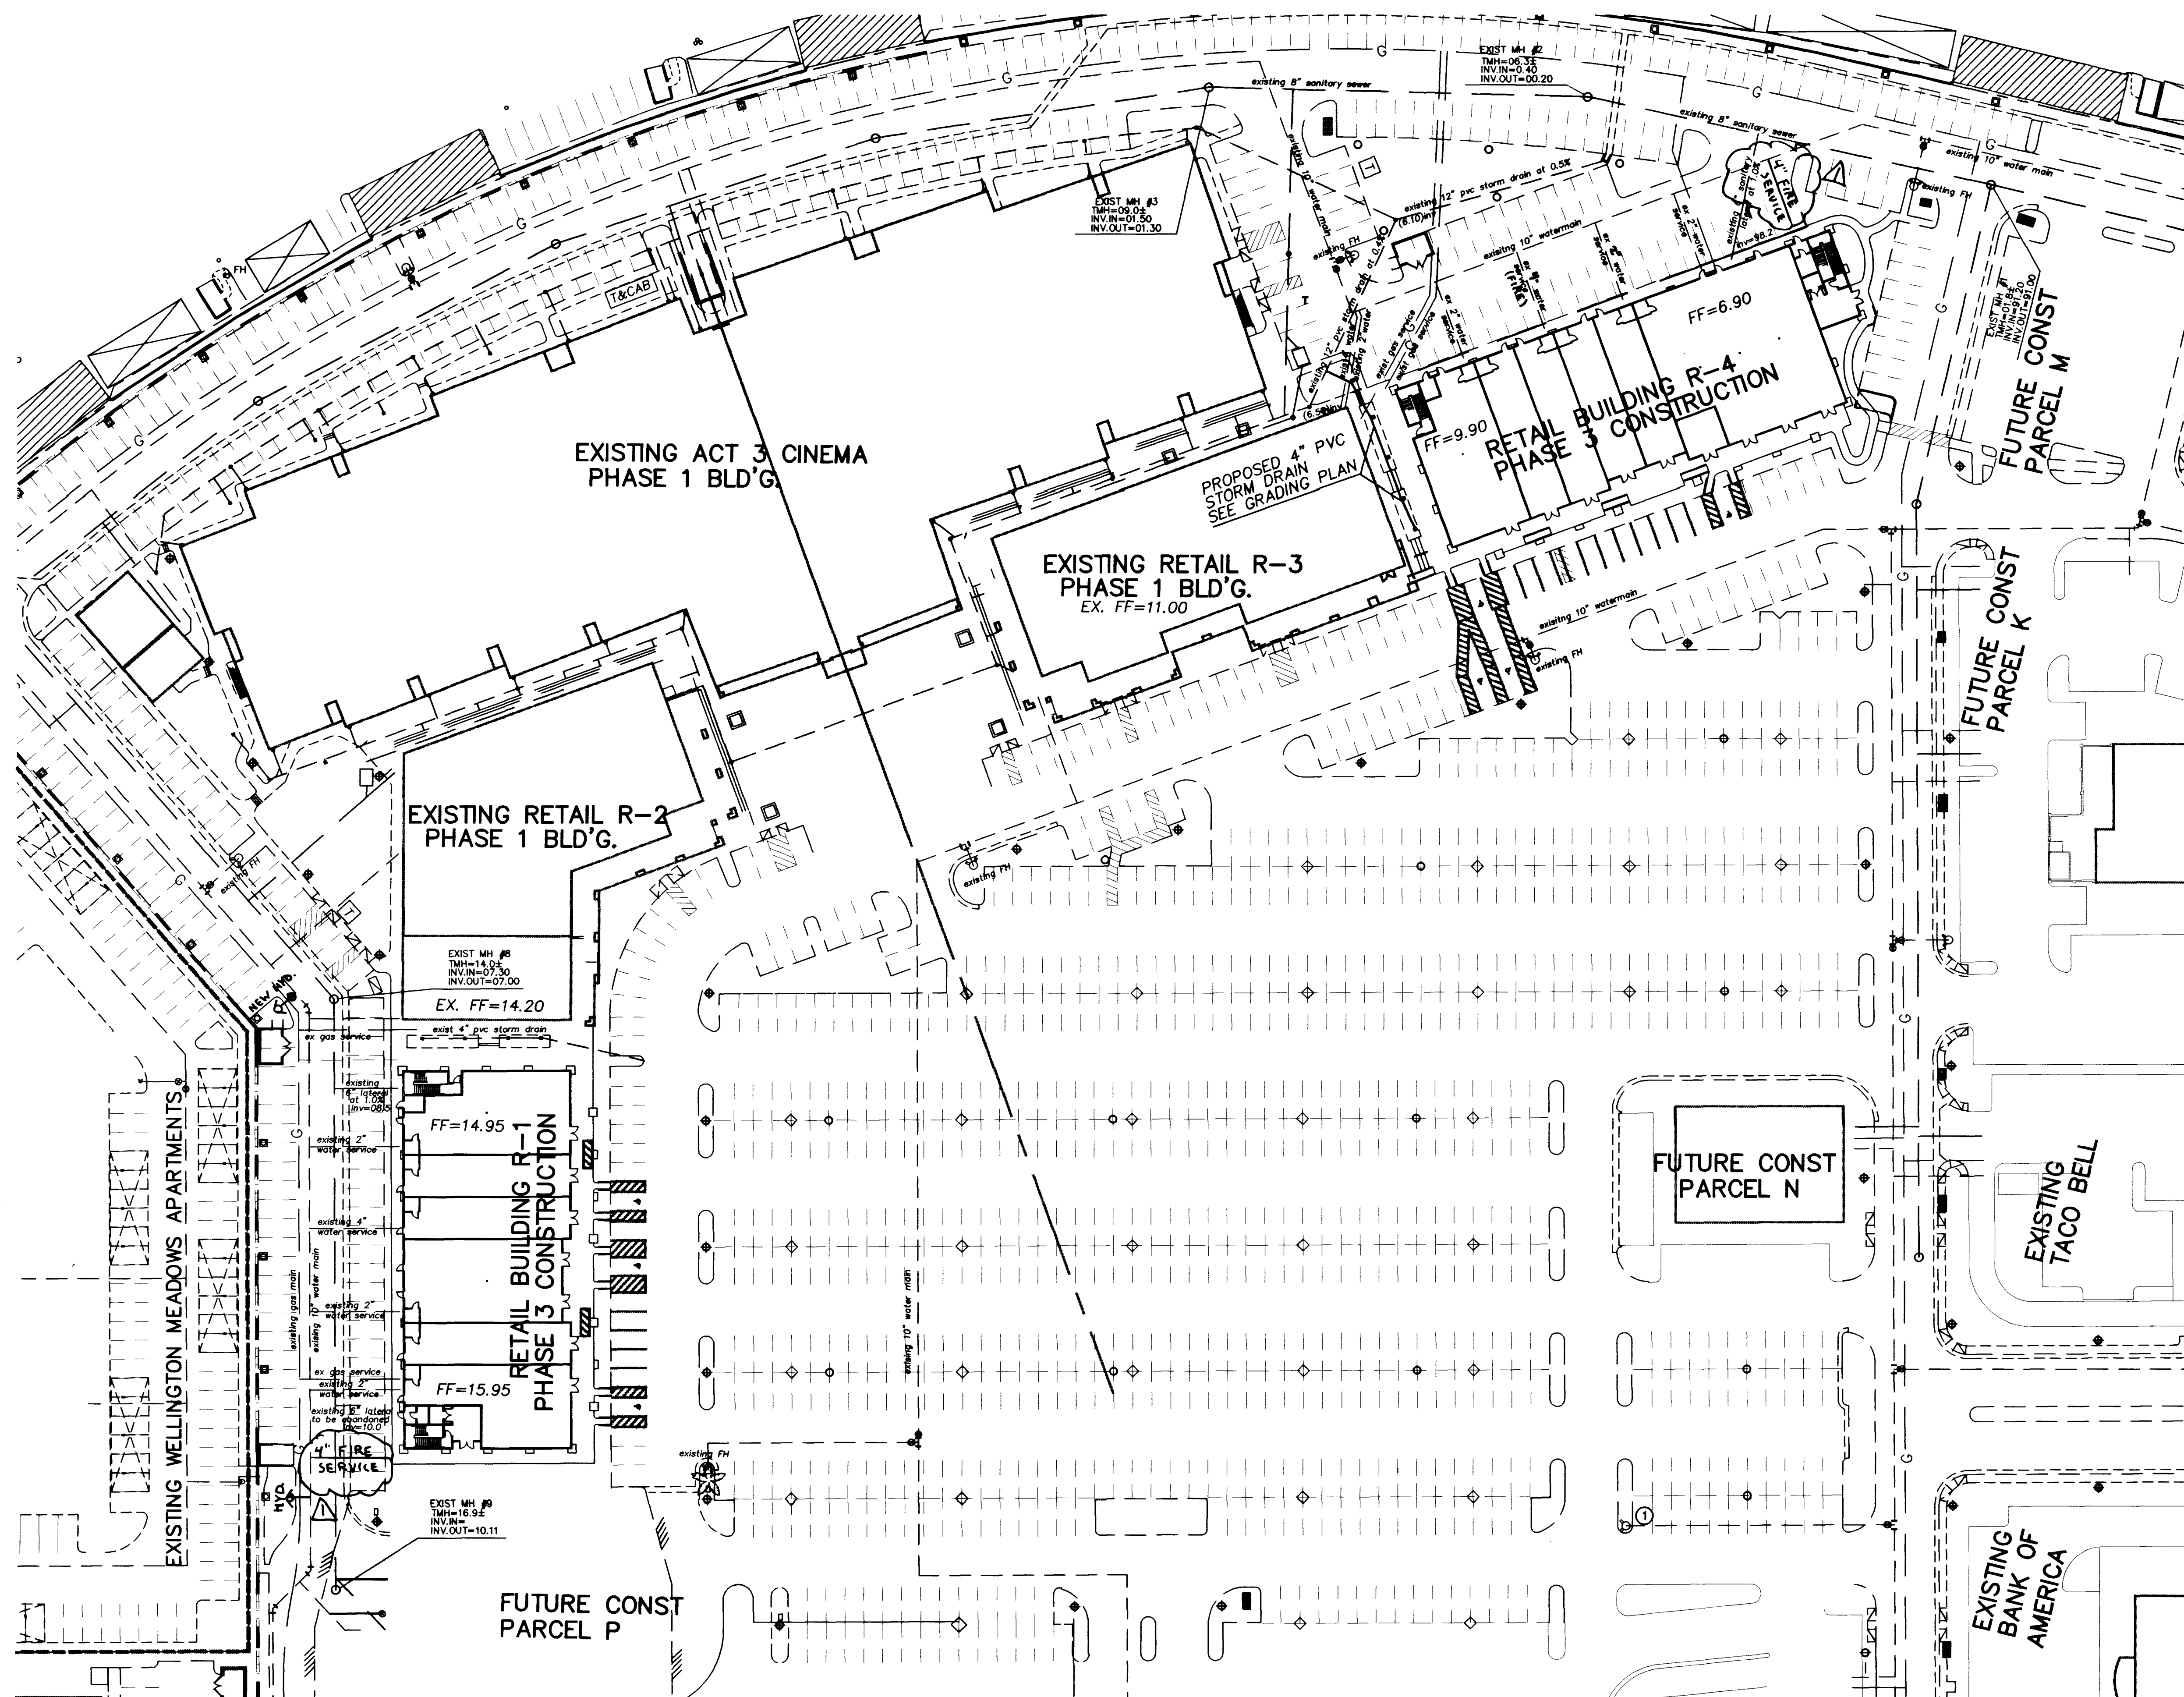


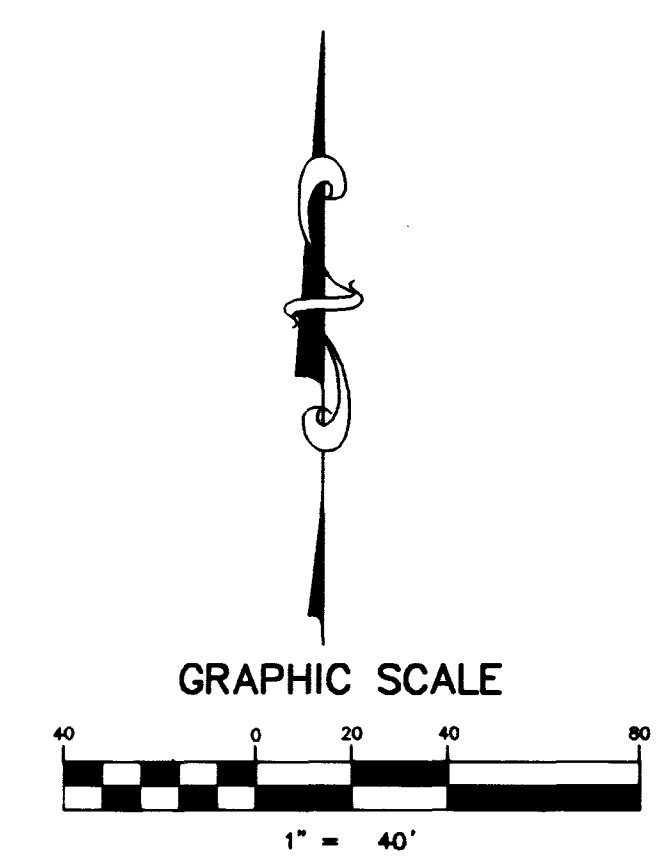

BENCHMARK
CLV BENCHMARK #1LV-108588
RIVET & PLATE IN TOP OF NORTH CURB
LINE AT 9501 W. SAHARA AVENUE
ELEVATION = 860.879 METERS (NAVD 88)
= 2824.401 FEET (NAVD 88)

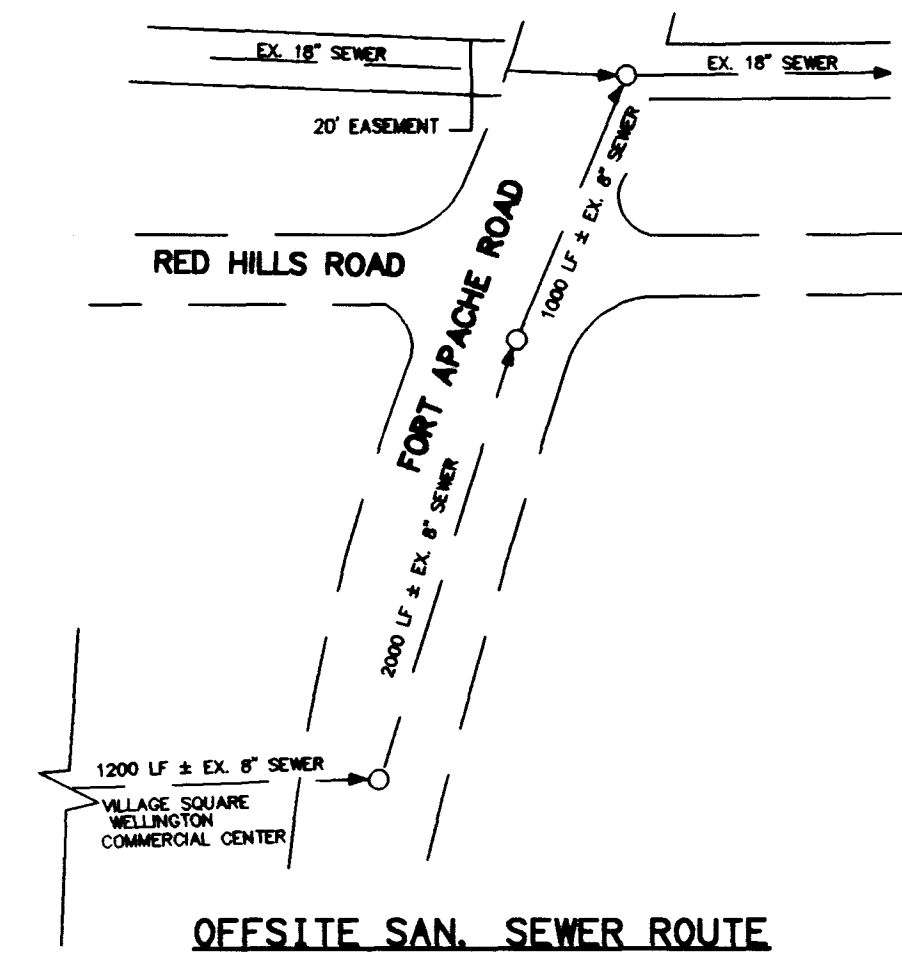

Call
before you
Dig
1-800-227-2600

[Signature]
CLV FIRE DEPT.
7-28-98
DATE

ONSITE SEWER NOTES:
ALL ONSITE SANITARY SEWERS ARE
PRIVATELY OWNED AND MAINTAINED.
ALL ONSITE SAN. SEWER AND WATER SHALL
SHALL BE CONSTRUCTED TO C.L.V. STANDARDS
UNLESS SHOWN OTHERWISE IN THE PLANS.

TRIPLE FIVE NEVADA DEVELOPMENT CORP. 9510 WEST SAHARA LAS VEGAS, NEVADA 89117 702-277-0654		CONSULTING ENGINEERS • PLANNERS • LAND SURVEYORS 2727 SOUTH RAINBOW BOULEVARD LAS VEGAS, NEVADA 89102-5148 PHONE (702) 873-7550 FAX (702) 362-2597	
REV	DATE	BY	ADD
1	10-13-98	IKJ	FIRE SERVICE & HYD.
REVISION 10-23-98			

PROJECT WELLINGTON COMMERCIAL CENTER AT PECCOLE RANCH	
TITLE PHASE 3 MASTER UTILITY PLAN BUILDINGS R-1 AND R-4	
SEAL 	
WO NO. 5065-3	
BY	ps
DATE	JULY 1998
SCALE HORIZ	AS SHOWN
VERT.	N/A
SHEET	5
OF 5 SHEETS	

Plotted by :
R:\cad\LANDEV\5065-3\5065-3.dwg Thu Jul 16 15:42:18 1998

