
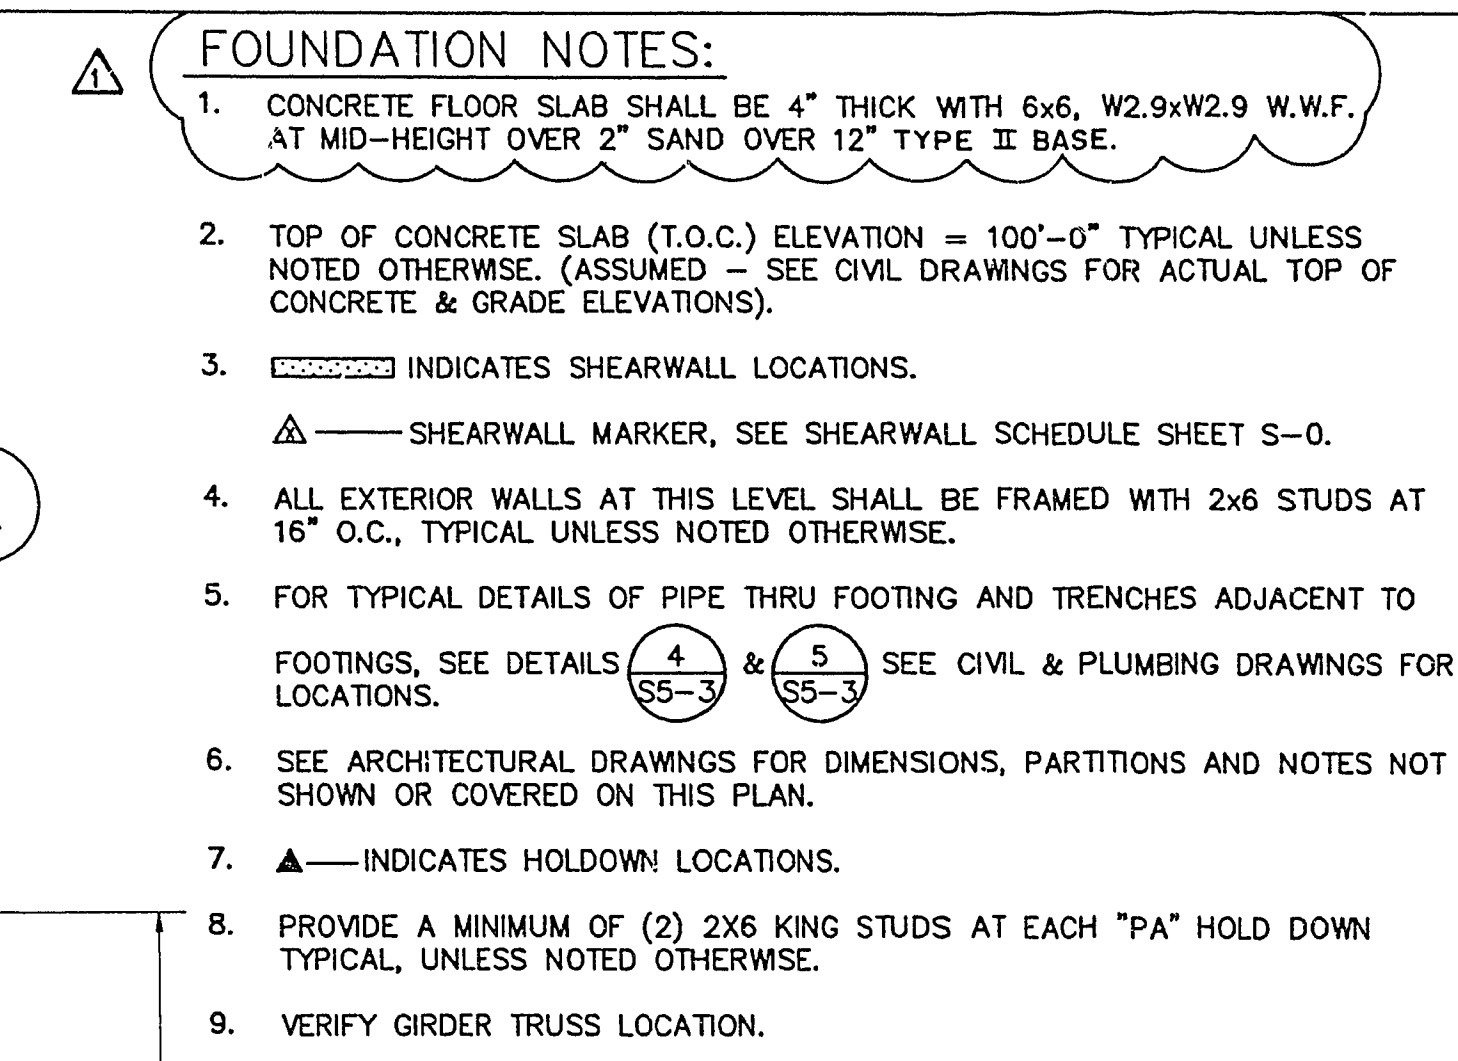
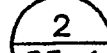


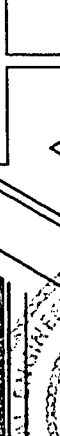

FOOTING SCHEDULE			
MARK	DIMENSIONS	REINFORCING	DETAIL
F1	3'-0" SQ. x 1'-0" THICK	(4) #4 BARS E.W. BOT.	
F2	NOT USED		
F3	4'-0" SQ. x 1'-0" THICK	(5) #4 BARS E.W. BOT.	

			
FOUNDATION PLAN—QUALITY CONTROL		WEST SERVICE CENTER PHASE I	
B. & S., Q.C. & SANT. SITES		POGGEMEYER DESIGN GROUP	
ENGINEERS		PLANNERS	
SURVEYORS		PLANNERS	
1140 ALMOND TREE LANE, SUITE 306 LAS VEGAS, NEVADA 89104 (702) 735-5108		1140 ALMOND TREE LANE, SUITE 306 LAS VEGAS, NEVADA 89104 (702) 735-5108	

JOB NUMBER	91012
DESIGNED BY	MS
DRAWN BY	JDS
CHECKED BY	MS
DATE	1/15/92
SHEET NUMBER	42 of 78

62-1

OF 11