


23-12-69

# WHISPERING PINES - UNIT 2

A PORTION OF THE SE 1/4 OF SECTION 36, T. 19 S., R. 60 E., M.D.M., CITY OF LAS VEGAS, CLARK COUNTY, NEVADA.

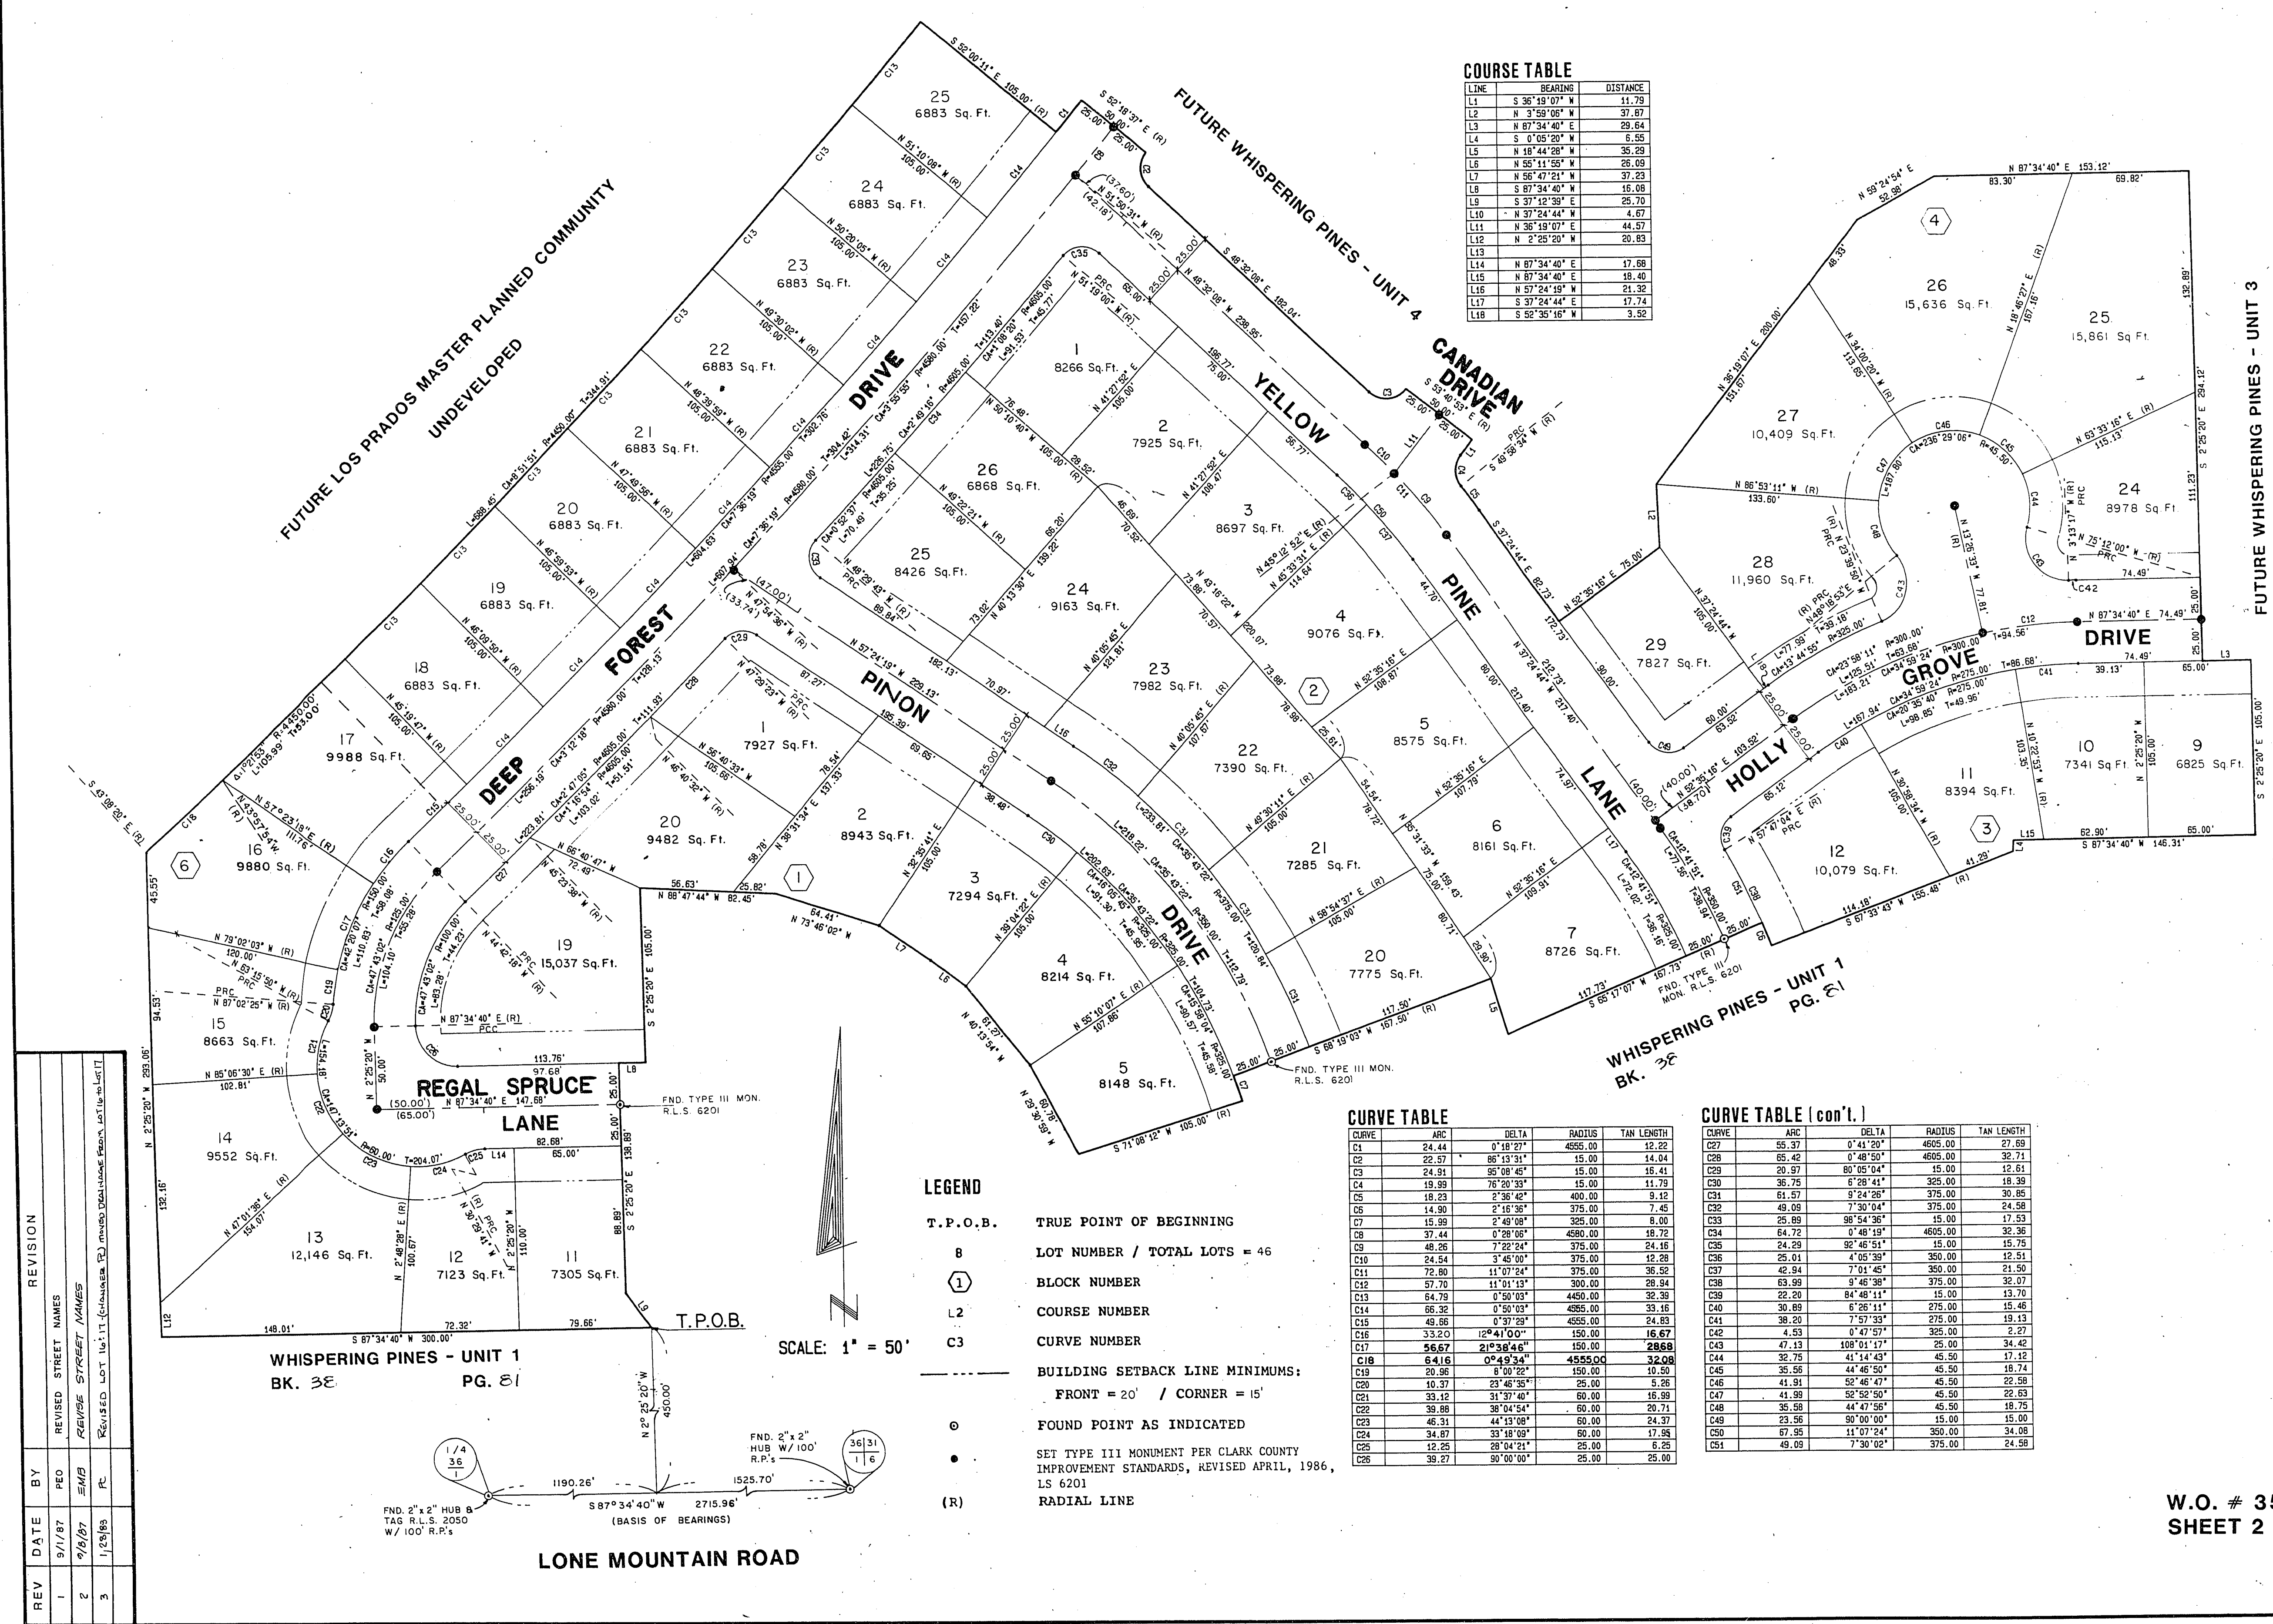

| COURSE TABLE |               |          |
|--------------|---------------|----------|
| LINE         | BEARING       | DISTANCE |
| L1           | S 36°19'07" W | 11.79    |
| L2           | N 3°58'06" E  | 37.87    |
| L3           | N 87°34'40" E | 29.84    |
| L4           | S 0°05'20" W  | 6.55     |
| L5           | N 18°44'28" W | 35.29    |
| L6           | N 65°11'55" W | 28.09    |
| L7           | N 58°47'21" W | 37.23    |
| L8           | S 87°34'40" W | 15.38    |
| L9           | S 37°12'58" E | 25.70    |
| L10          | N 37°24'44" W | 4.67     |
| L11          | N 36°19'07" E | 44.57    |
| L12          | N 2°25'20" W  | 20.83    |
| L13          |               |          |
| L14          | N 87°34'40" E | 17.88    |
| L15          | N 87°34'40" E | 18.40    |
| L16          | N 87°34'40" W | 21.32    |
| L17          | S 37°24'44" E | 17.74    |
| L18          | S 52°35'16" W | 3.32     |

CURVE TABLE

| CURVE | ARC   | DELTA     | RADIUS  | TAN LENGTH |
|-------|-------|-----------|---------|------------|
| C1    | 24.44 | 0°18'27"  | 4555.00 | 12.22      |
| C2    | 22.57 | 86°13'31" | 15.00   | 14.04      |
| C3    | 24.51 | 95°00'45" | 15.00   | 16.41      |
| C4    | 19.59 | 76°20'33" | 15.00   | 11.79      |
| C5    | 18.23 | 2°36'42"  | 400.00  | 9.12       |
| C6    | 14.90 | 2°16'38"  | 375.00  | 7.45       |
| C7    | 15.99 | 2°48'08"  | 325.00  | 8.00       |
| C8    | 37.44 | 0°28'08"  | 4580.00 | 16.72      |
| C9    | 48.26 | 7°22'24"  | 375.00  | 24.16      |
| C10   | 24.54 | 3°45'00"  | 375.00  | 12.28      |
| C11   | 72.80 | 0°10'24"  | 375.00  | 30.52      |
| C12   | 57.70 | 11°01'13" | 300.00  | 26.84      |
| C13   | 64.79 | 0°50'03"  | 4450.00 | 32.38      |
| C14   | 68.32 | 0°50'03"  | 4555.00 | 33.15      |
| C15   | 48.86 | 0°37'29"  | 4555.00 | 24.83      |
| C16   | 33.50 | 12°41'00" | 150.00  | 16.67      |
| C17   | 56.67 | 21°38'46" | 150.00  | 28.68      |
| C18   | 64.16 | 0°49'24"  | 4555.00 | 32.08      |
| C19   | 20.36 | 8°00'22"  | 150.00  | 10.50      |
| C20   | 10.37 | 2°45'35"  | 25.00   | 5.26       |
| C21   | 33.12 | 31°37'40" | 60.00   | 16.99      |
| C22   | 39.88 | 38°04'54" | 60.00   | 20.71      |
| C23   | 45.31 | 44°13'00" | 60.00   | 24.37      |
| C24   | 34.87 | 53°18'00" | 60.00   | 17.88      |
| C25   | 12.25 | 28°04'21" | 25.00   | 6.25       |
| C26   | 39.27 | 90°00'00" | 25.00   | 25.00      |

CURVE TABLE (con't.)

| CURVE | ARC   | DELTA      | RADIUS  | TAN LENGTH |
|-------|-------|------------|---------|------------|
| C27   | 55.37 | 0°41'20"   | 4605.00 | 27.89      |
| C28   | 60.40 | 0°48'50"   | 4605.00 | 32.71      |
| C29   | 20.97 | 80°05'04"  | 15.00   | 12.61      |
| C30   | 36.75 | 6°28'41"   | 325.00  | 18.39      |
| C31   | 61.57 | 9°24'28"   | 375.00  | 30.85      |
| C32   | 48.08 | 7°30'04"   | 375.00  | 24.58      |
| C33   | 29.89 | 98°54'38"  | 15.00   | 17.53      |
| C34   | 64.72 | 0°48'19"   | 4605.00 | 32.36      |
| C35   | 24.29 | 92°46'51"  | 15.00   | 15.75      |
| C36   | 25.01 | 4°05'38"   | 350.00  | 12.51      |
| C37   | 45.94 | 7°01'45"   | 350.00  | 21.50      |
| C38   | 63.99 | 9°46'38"   | 375.00  | 32.07      |
| C39   | 22.20 | 84°48'11"  | 15.00   | 13.70      |
| C40   | 30.89 | 6°26'11"   | 275.00  | 15.46      |
| C41   | 38.29 | 7°57'23"   | 275.00  | 19.13      |
| C42   | 4.53  | 0°47'57"   | 325.00  | 2.27       |
| C43   | 47.13 | 108°01'17" | 25.00   | 34.42      |
| C44   | 32.75 | 41°14'43"  | 45.50   | 17.12      |
| C45   | 35.55 | 44°45'00"  | 45.50   | 19.74      |
| C46   | 41.91 | 52°46'47"  | 45.50   | 22.58      |
| C47   | 41.99 | 52°52'50"  | 45.50   | 22.63      |
| C48   | 35.58 | 44°47'58"  | 45.50   | 18.75      |
| C49   | 23.55 | 90°00'00"  | 15.00   | 15.00      |
| C50   | 67.95 | 11°07'24"  | 350.00  | 34.08      |
| C51   | 49.03 | 7°30'02"   | 375.00  | 24.58      |

W.O. # 3522-2  
SHEET 2 OF 2

Book 39, Pg 15  
3333-1