Book 52 p.28 (28-3333-A)

3/8/10

WHISPERING PINES - UNIT 4

A PORTION OF THE SE1/4 OF SECTION 36, T. 19 S., R. 60 E., M.D.M., CITY OF LAS VEGAS, CLARK COUNTY, NEVADA.

MONUMENT TIE MAP

FUTURE LOS PRADOS MASTER PLANNED COMMUNITY
UNDEVELOPED

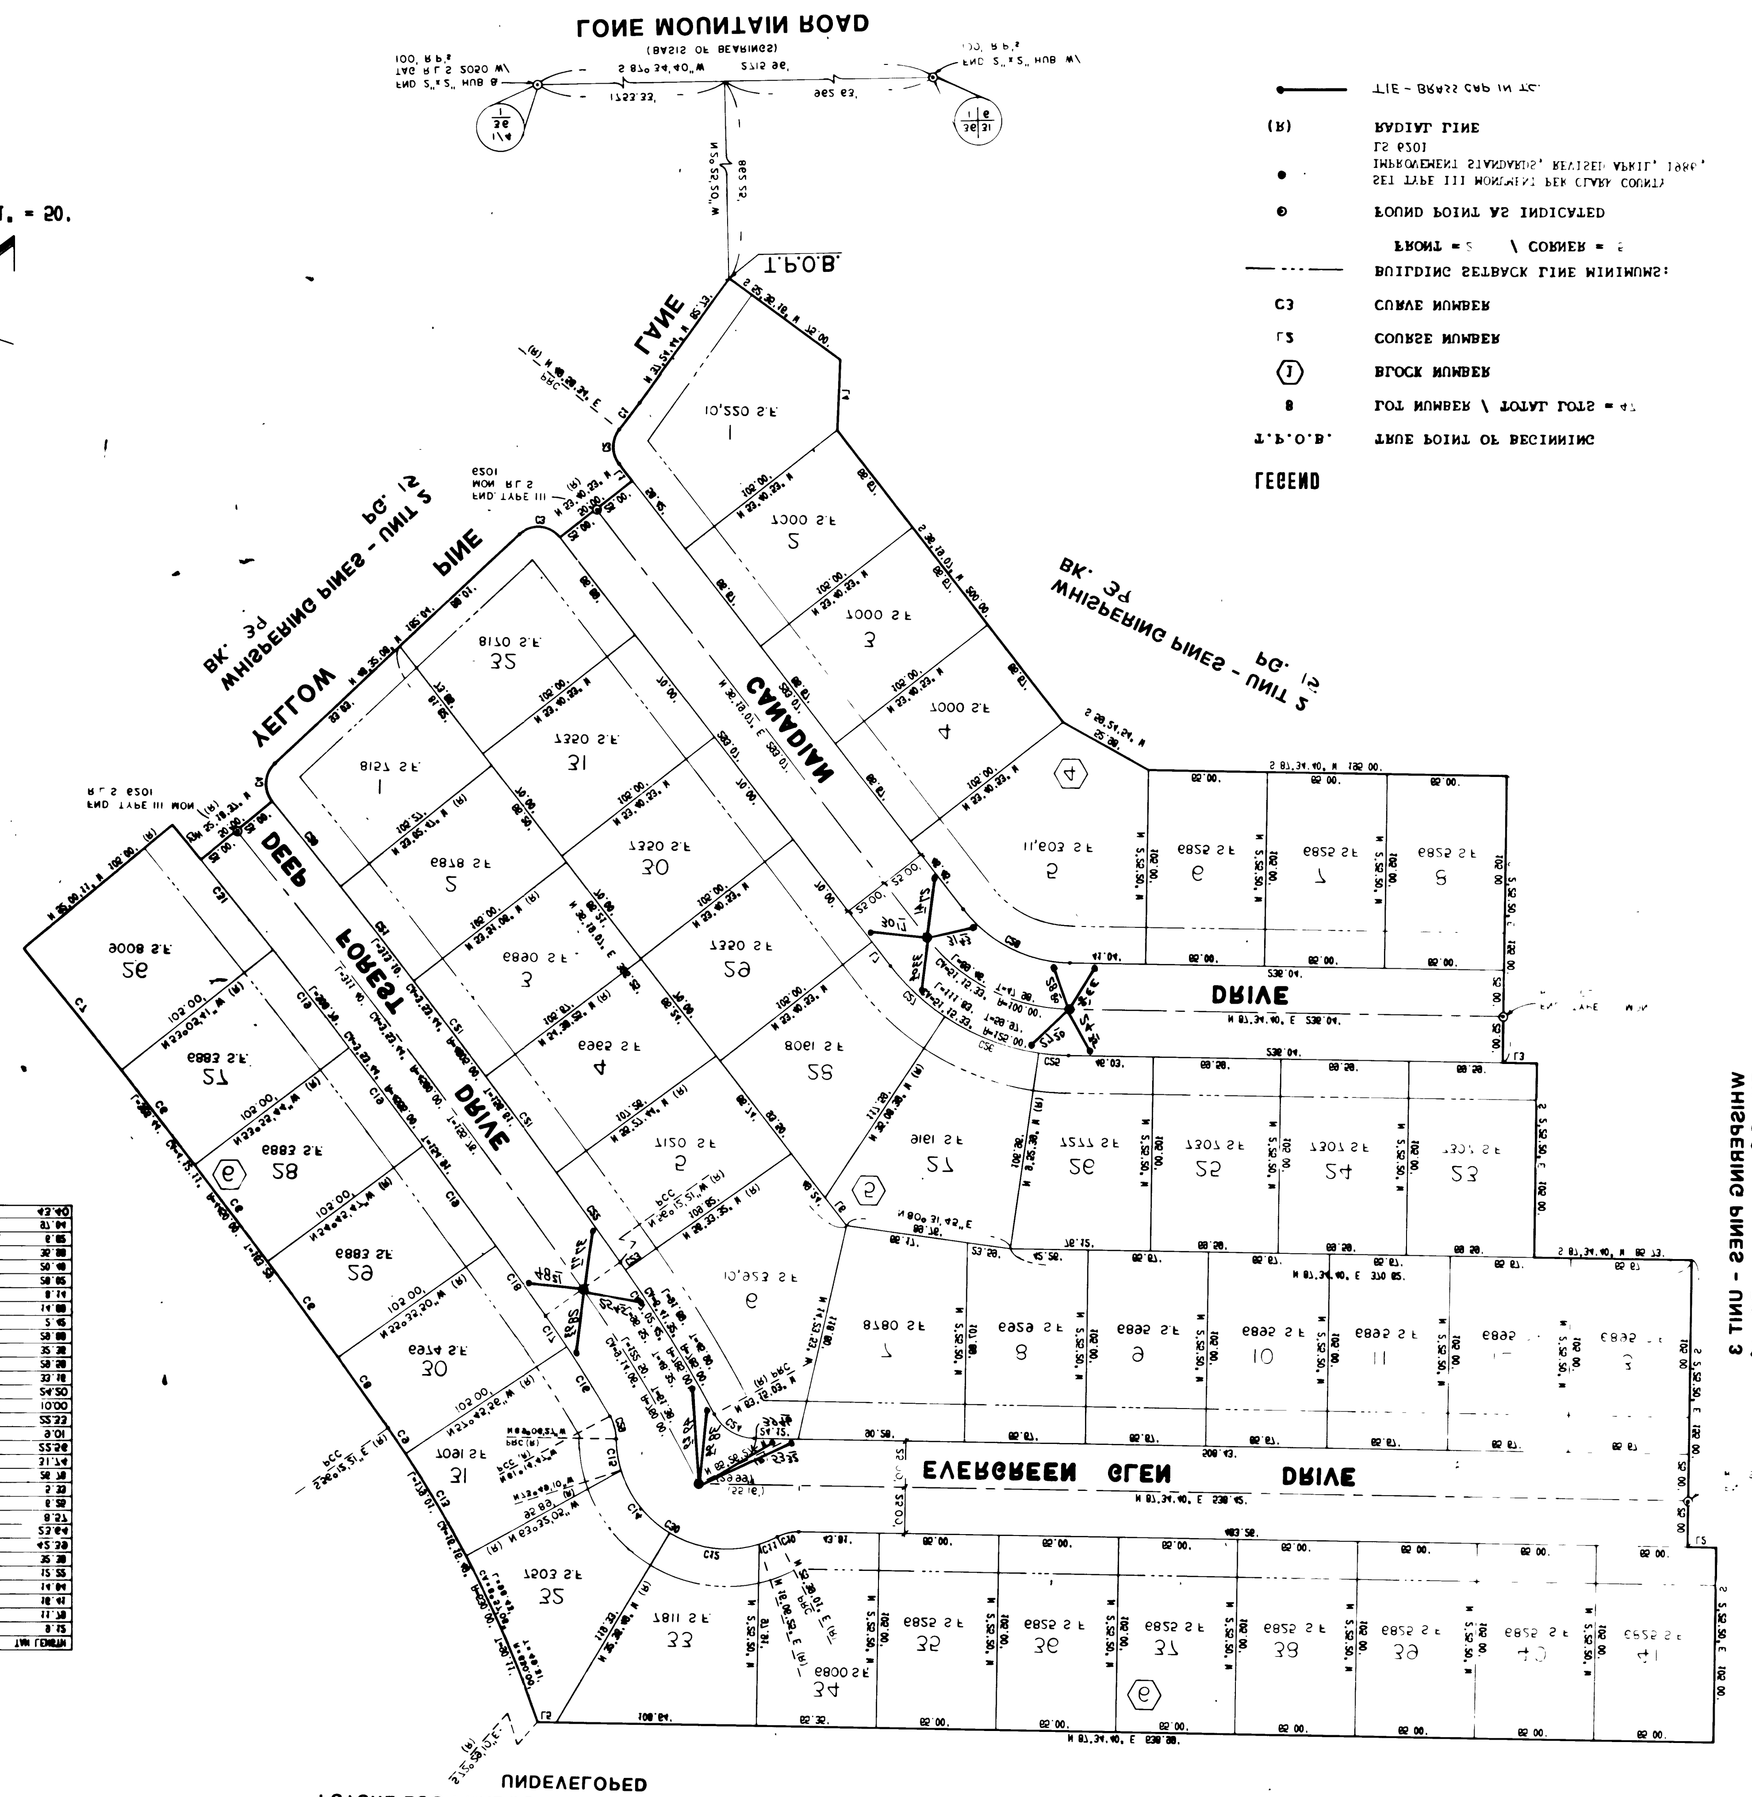
LONE MOUNTAIN ROAD
(BASIS OF BEARINGS)
T.P.O.B.
WELLOW PINE
DEER FOREST DRIVE
CANADIAN DRIVE
EVERGREEN GLEN DRIVE

