

APPROVAL

C.L.V. FIRE MARSHALL _____ DATE _____

C.L.V. CHIEF LAND DEVELOPMENT _____ DATE _____


Shane Miller 9/15/87
LAS VEGAS VALLEY WATER DIST. DATE

Name of Plan: *Whispering Pines - Unit 1*

Water plan as shown will be acceptable.
It is NOT approved for construction.

Shane Miller 9/15/87
LVWD Date


WHISPERING PINES - UNIT 1
MATCH TO SHEET 20

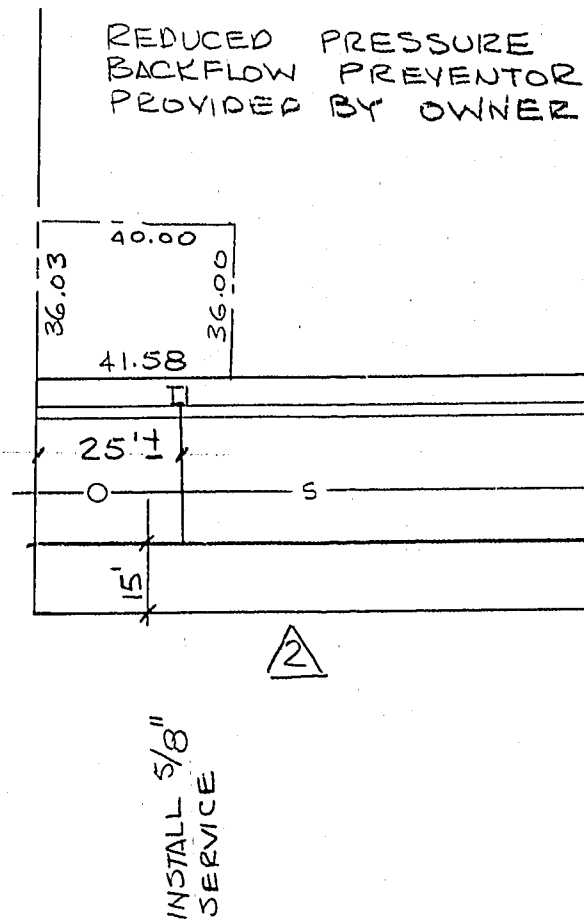

LONE MOUNTAIN ROAD

NOT - A - PART

WHISPERING PINES - UNIT 3

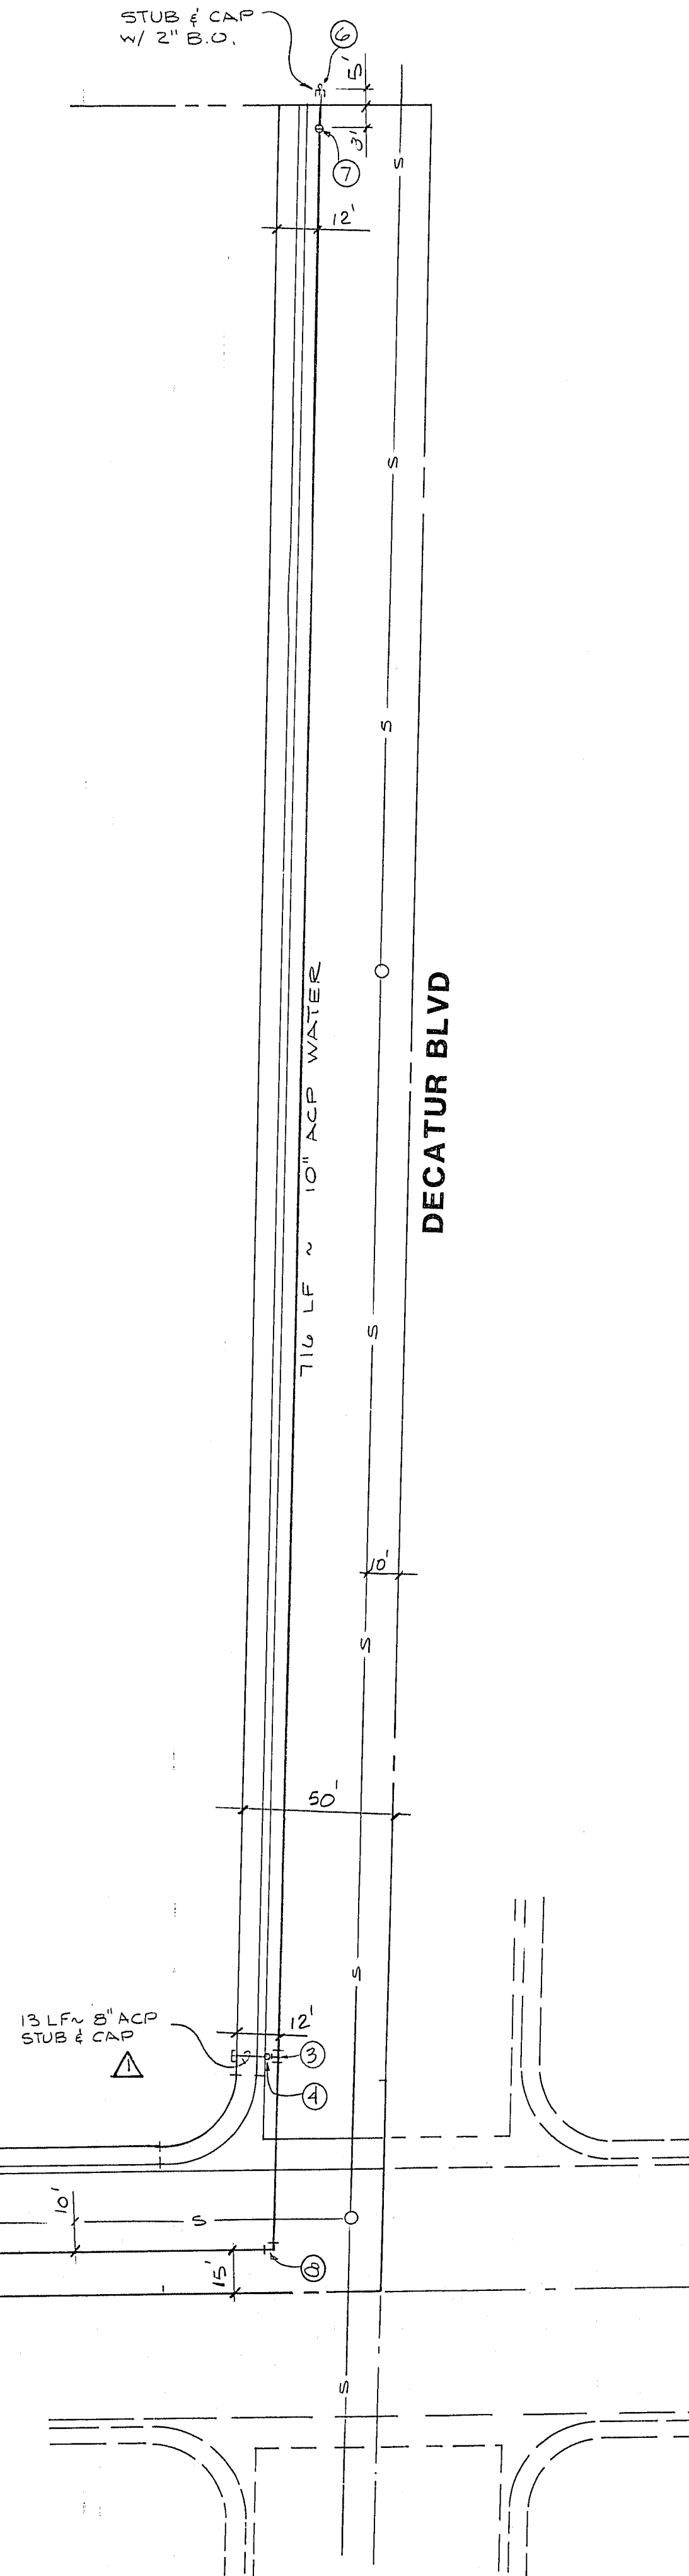

4-9-107

4/15/88
4/17/88

REV	DATE	BY	REVISION
1	1/1/88	MM	ADDED 8\"/>
2	4/1/88	MM	ADDED SERJ TO LIFT STA SITE

MASTER WATER PLAN

WHISPERING PINES - UNIT 1

WO NO. 3522-1
BY RPF
DATE
SCALE 1\"/>

SHEET
21
OF 22 SHEETS

5674-3333-1

CONSULTING ENGINEERS - PLANNERS
2300 PASEO DEL PRADO BUILDING A SUITE 100
LAS VEGAS, NEVADA 89102 PHONE (702) 873-7550

