


MONUMENT TIE MAP
WILLOW BEND NO. 3 IN THE TRAILS AT SUMMERLIN
BY LEWIS HOMES

BEING A PORTION OF LOT 2 OF AMENDED SUMMERLIN VILLAGE 7 – THE TRAILS – UNIT NO. 1 AS SHOWN IN BOOK 62, PAGE 29 OF PLATS
– LYING WITHIN SECTION 19, TOWNSHIP 20 SOUTH, RANGE 60 EAST, M.D.M., CITY OF LAS VEGAS, CLARK COUNTY, NEVADA.

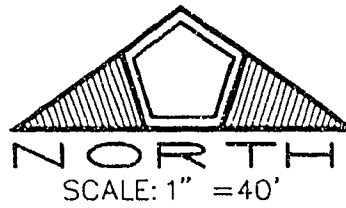

WILLOW BEND NO. 3
IN THE TRAILS AT SUMMERLIN
BY LEWIS HOMES
BOOK 62, PAGE 29
OF PLATS

LINE	BEARING	DISTANCE
L1	S02°31'00"W	11.10'
L2	S87°29'00"E	48.00'
L3	N81°04'00"W	1.34'

CURVE	DELTA	RADIUS	LENGTH	TANGENT
1	03°41'15"	1412.00'	90.87'	45.45'
2	05°32'29"	1412.00'	136.58'	68.33'
3	10°37'37"	54.00'	10.02'	5.02'
4	38°45'50"	54.00'	36.53'	19.00'
5	19°56'54"	46.00'	16.02'	8.09'
6	36°25'12"	54.00'	34.33'	17.76'
7	01°51'14"	1412.00'	45.69'	22.85'
8	123°28'49"	54.00'	116.38'	100.46'
9	37°40'10"	54.00'	35.50'	18.42'
10	02°02'08"	792.00'	28.14'	14.07'
11	12°21'59"	46.00'	9.93'	4.98'
12	83°35'00"	26.00'	37.93'	23.24'
13	03°38'06"	792.00'	50.25'	25.13'
14	07°34'56"	46.00'	6.09'	3.05'
15	03°35'13"	792.00'	49.58'	24.80'
16	01°22'42"	766.00'	18.43'	9.21'
17	04°58'22"	742.00'	64.40'	32.22'
18	26°01'20"	792.00'	359.71'	183.01'
19	04°28'36"	718.00'	56.10'	28.06'
20	01°22'42"	868.00'	20.88'	10.44'
21	04°58'22"	718.00'	62.32'	31.18'
22	04°58'22"	766.00'	66.48'	33.26'
23	03°21'52"	766.00'	44.98'	22.50'
24	03°39'15"	792.00'	50.51'	25.26'
25	04°58'22"	868.00'	75.33'	37.69'
26	00°29'46"	718.00'	6.22'	3.11'
27	03°21'52"	868.00'	50.97'	25.49'
28	00°13'48"	766.00'	3.07'	1.54'
29	00°58'38"	2507.00'	42.76'	21.38'
30	01°07'50"	2459.00'	48.52'	24.26'
31	00°13'48"	868.00'	3.48'	1.74'
32	03°40'58"	792.00'	50.91'	25.46'
33	01°07'50"	2357.00'	46.51'	23.25'
34	07°30'22"	2483.00'	325.29'	162.88'
35	01°04'48"	2507.00'	47.26'	23.83'
36	08°02'40"	2483.00'	348.62'	174.60'
37	06°34'25"	2507.00'	287.63'	143.97'
38	01°05'39"	2459.00'	46.96'	23.48'
39	03°49'47"	792.00'	52.94'	26.48'
40	08°02'40"	2459.00'	345.25'	172.91'
41	01°05'39"	2357.00'	45.01'	22.51'
42	01°10'41"	2507.00'	51.55'	25.77'


NOTES:

- ALL REAR PROPERTY CORNERS ARE REBAR AND ALUMINUM CAP P.L.S. 4541 UNLESS WALL IS BUILT THEN NAIL AND BRASS TAG P.L.S. 4541 SET IN WALL DENOTES SIDE PROPERTY LINE. SET SAWCUT IN THE TOP OF CURB ON THE SIDE PROPERTY LINES EXTENDED.
- ALL STREETS ARE PUBLIC STREETS HEREBY DEDICATED.
- COMMUNITY SEWERS ARE TO BE PROVIDED BY THE CITY OF LAS VEGAS.

LEGEND

- PROPERTY LINE
--- STREET CENTERLINE
D BLOCK NUMBER
46 LOT NUMBER
TOTAL LOTS IN SUBDIVISION = 50
• SET TYPE III MONUMENT P.L.S. 4541 AND TYPE IV MONUMENTS IN TOP OF CURB (UNLESS OTHERWISE NOTED)

LOT 1
SUMMERLIN VILLAGE 7
THE TRAILS - UNIT NO. 1
BOOK 62, PAGE 11
OF PLATS

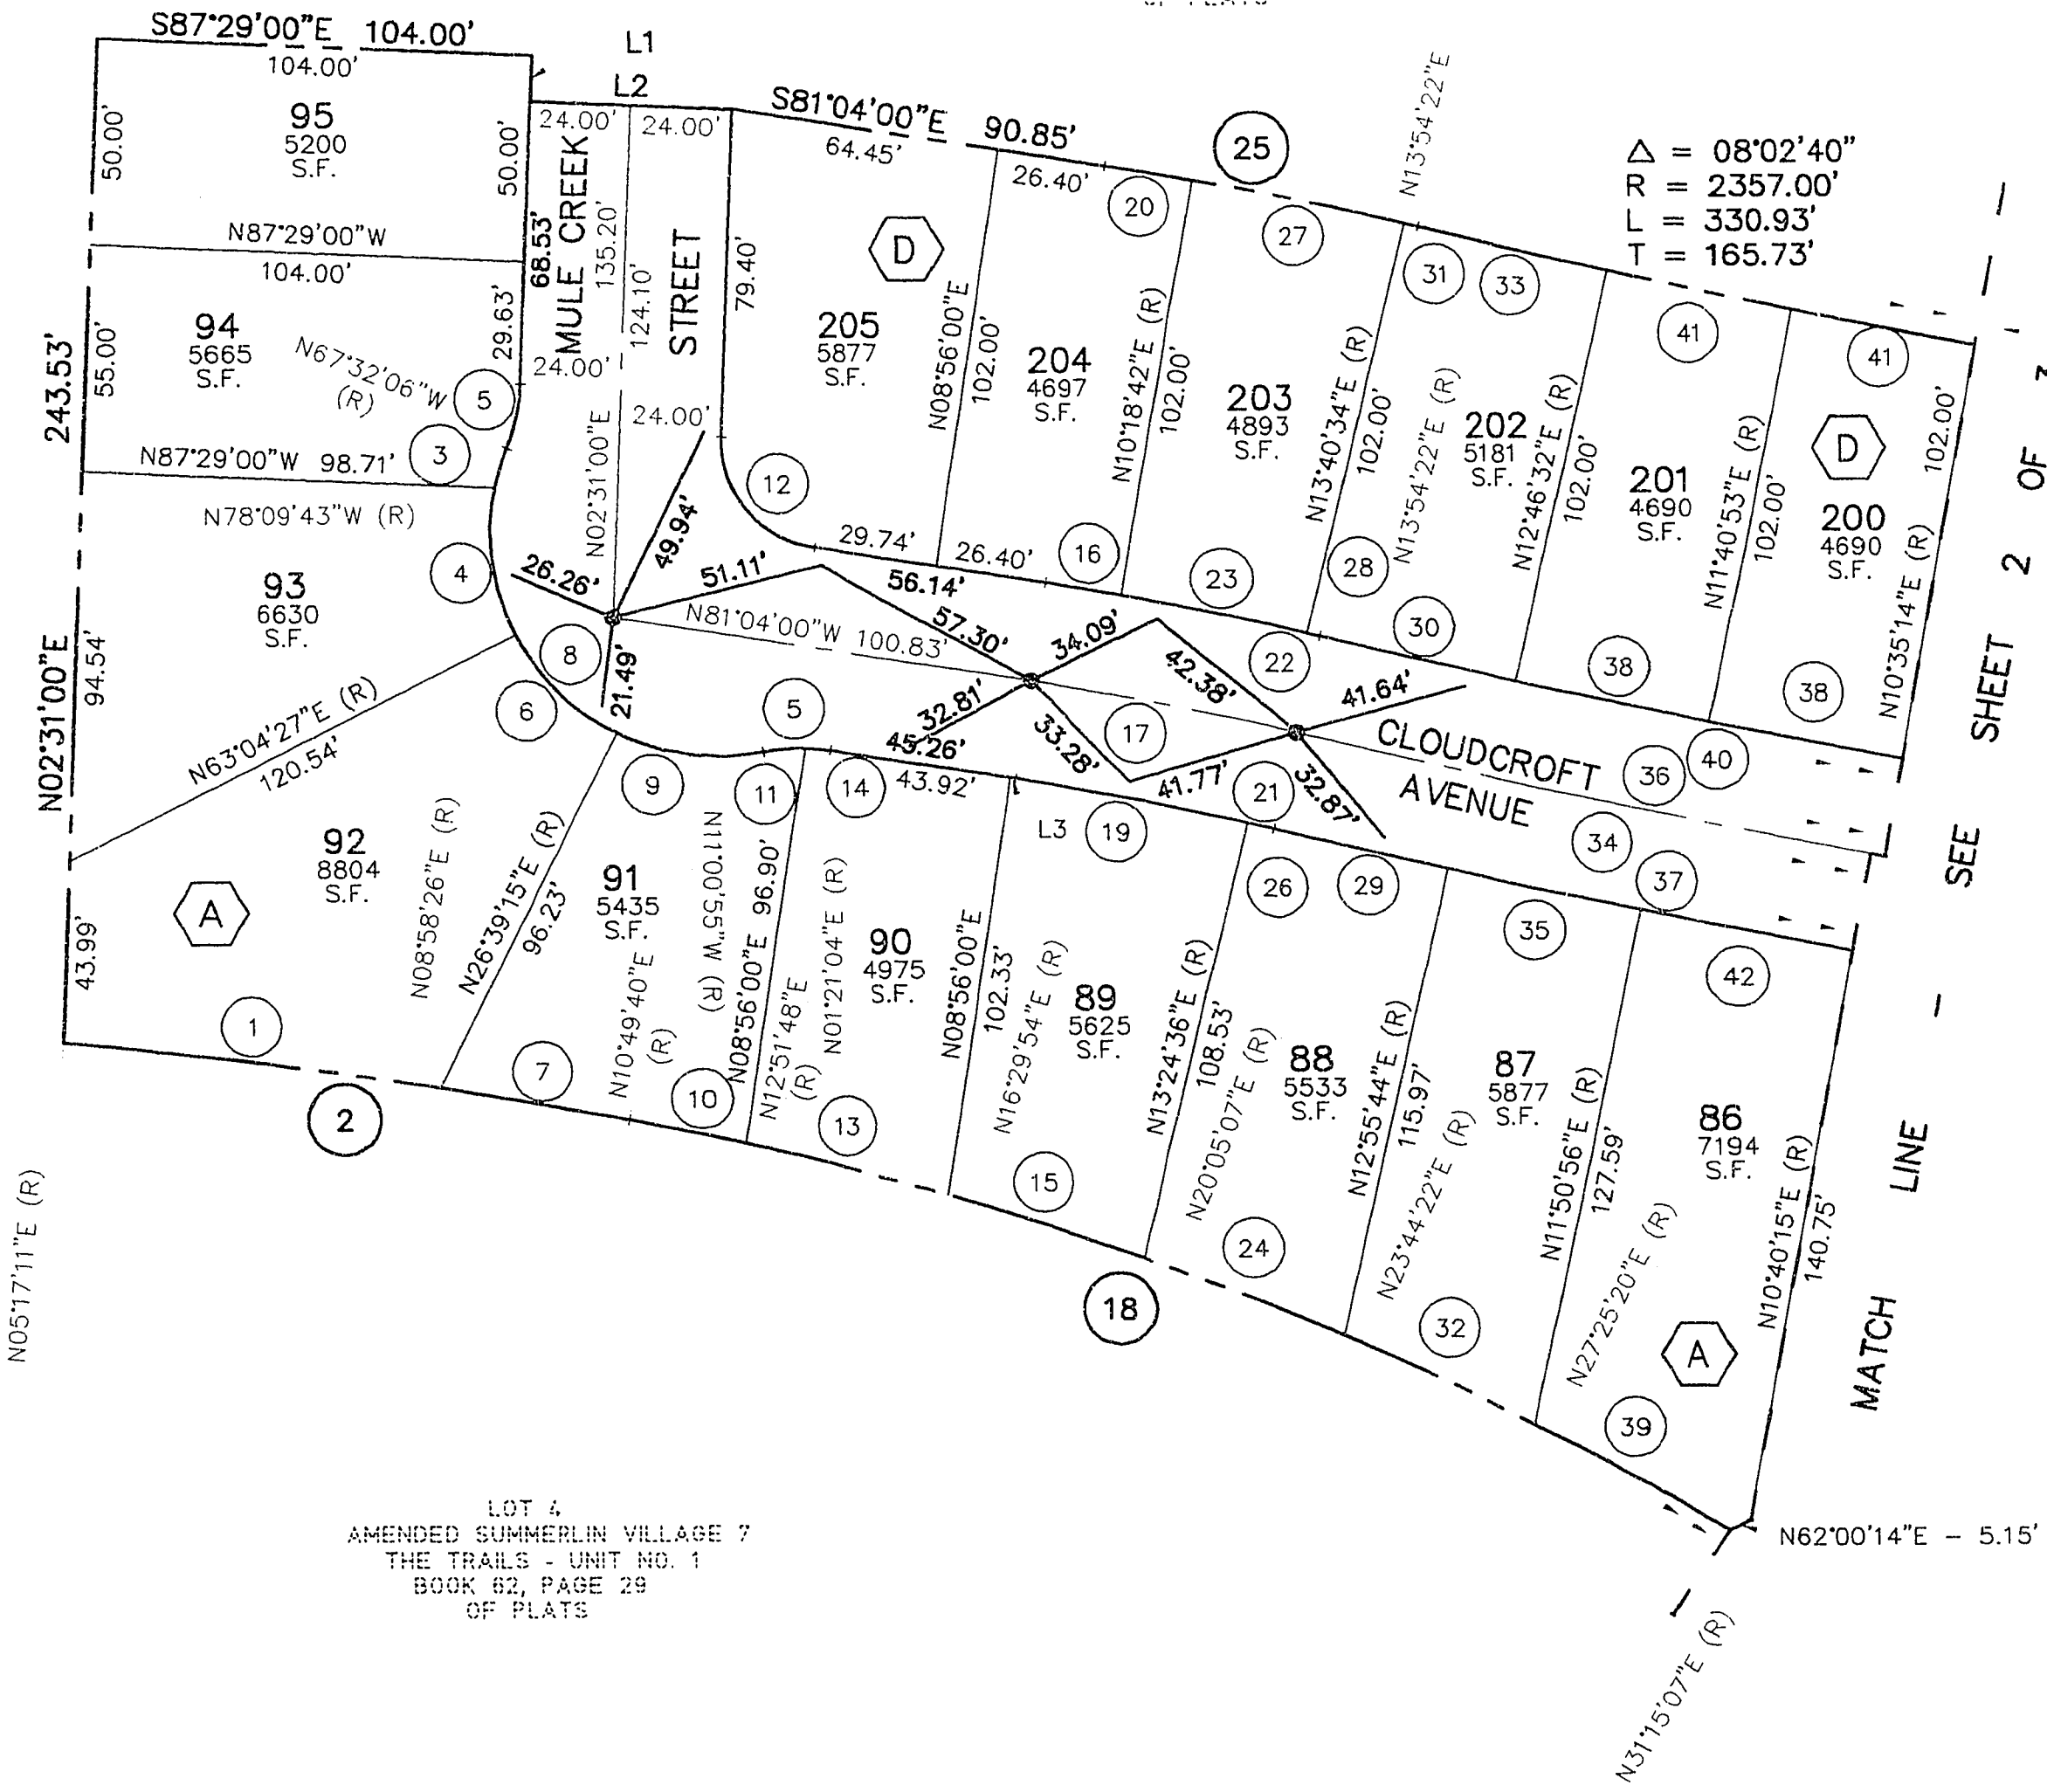

LOT 4
AMENDED SUMMERLIN VILLAGE 7
THE TRAILS - UNIT NO. 1
BOOK 62, PAGE 29
OF PLATS