
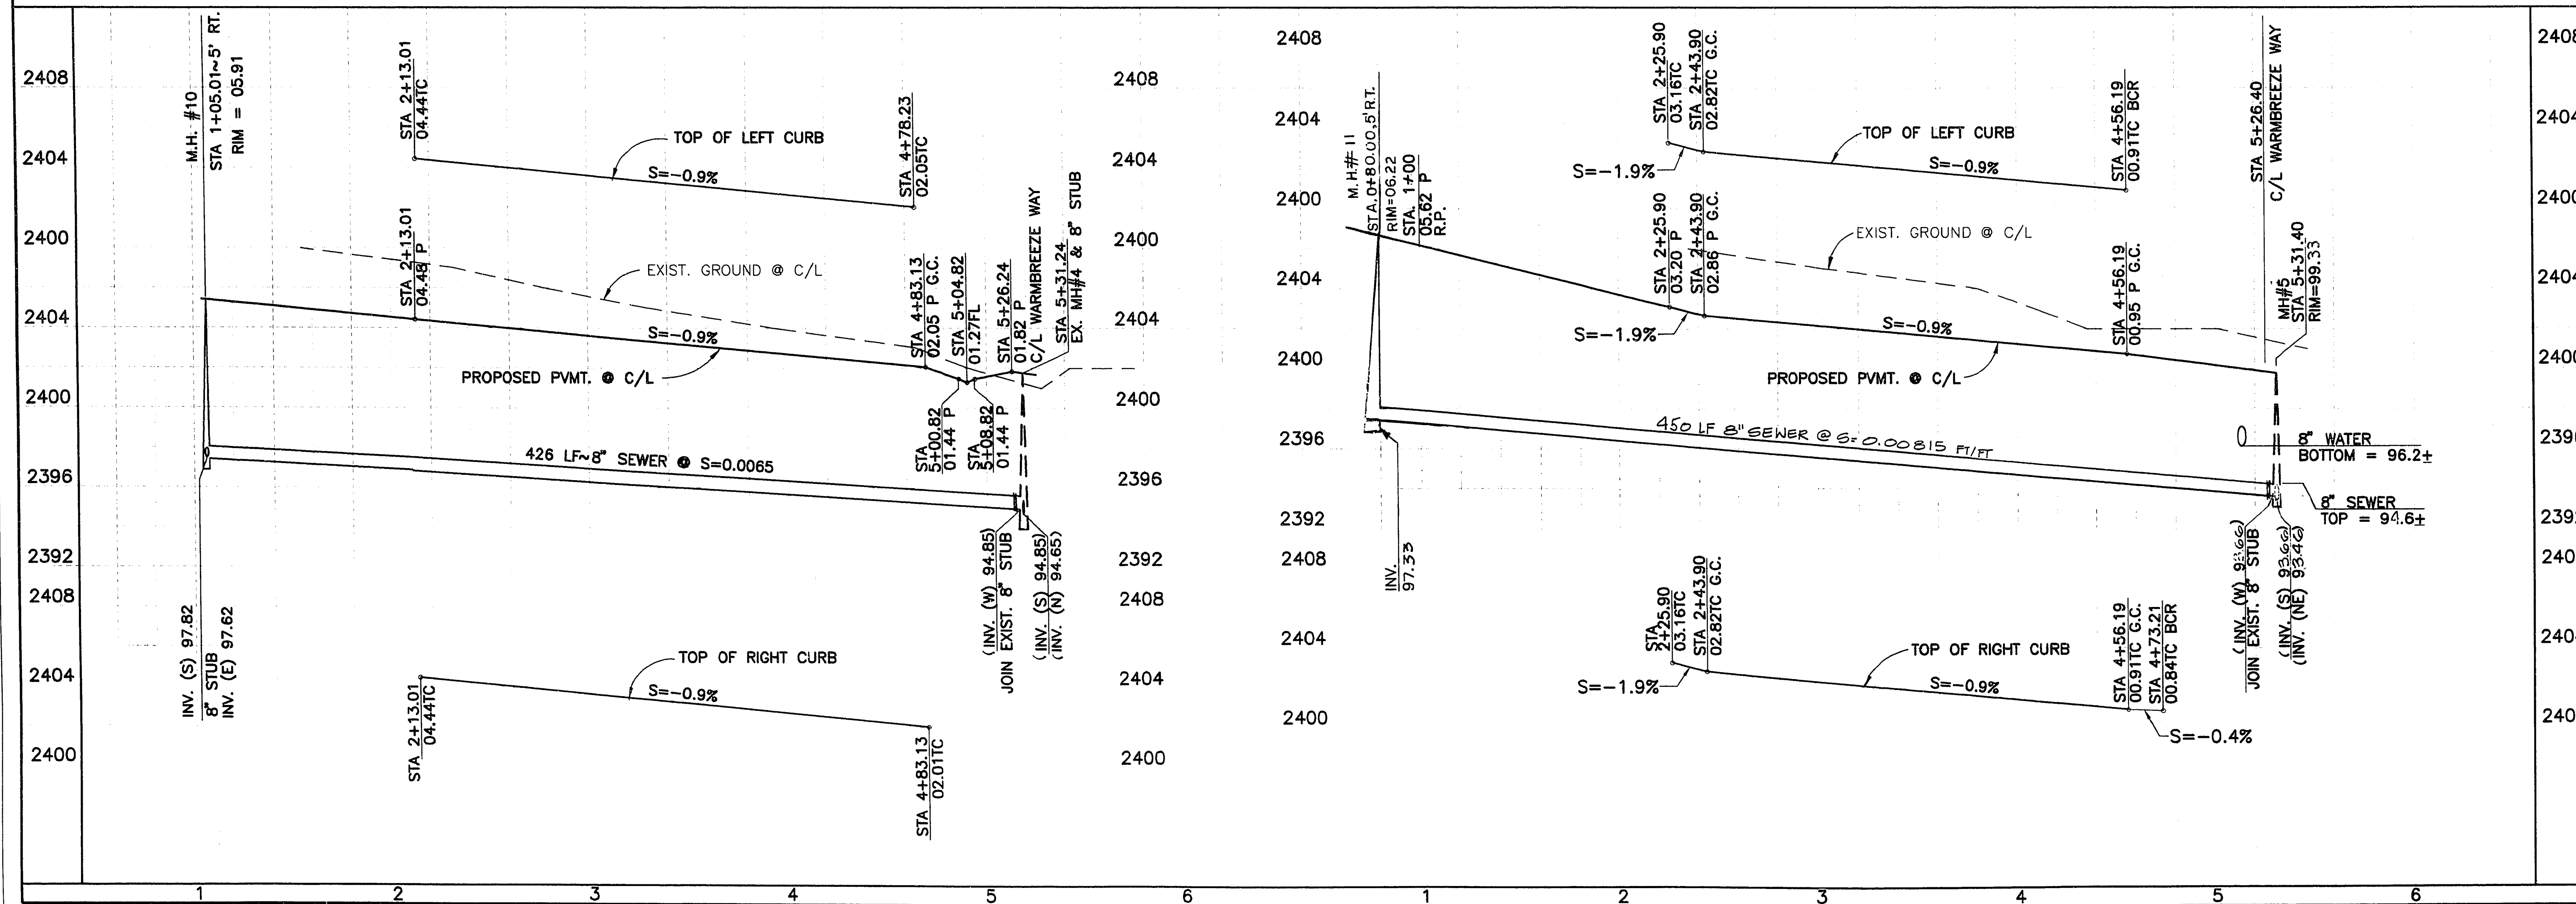


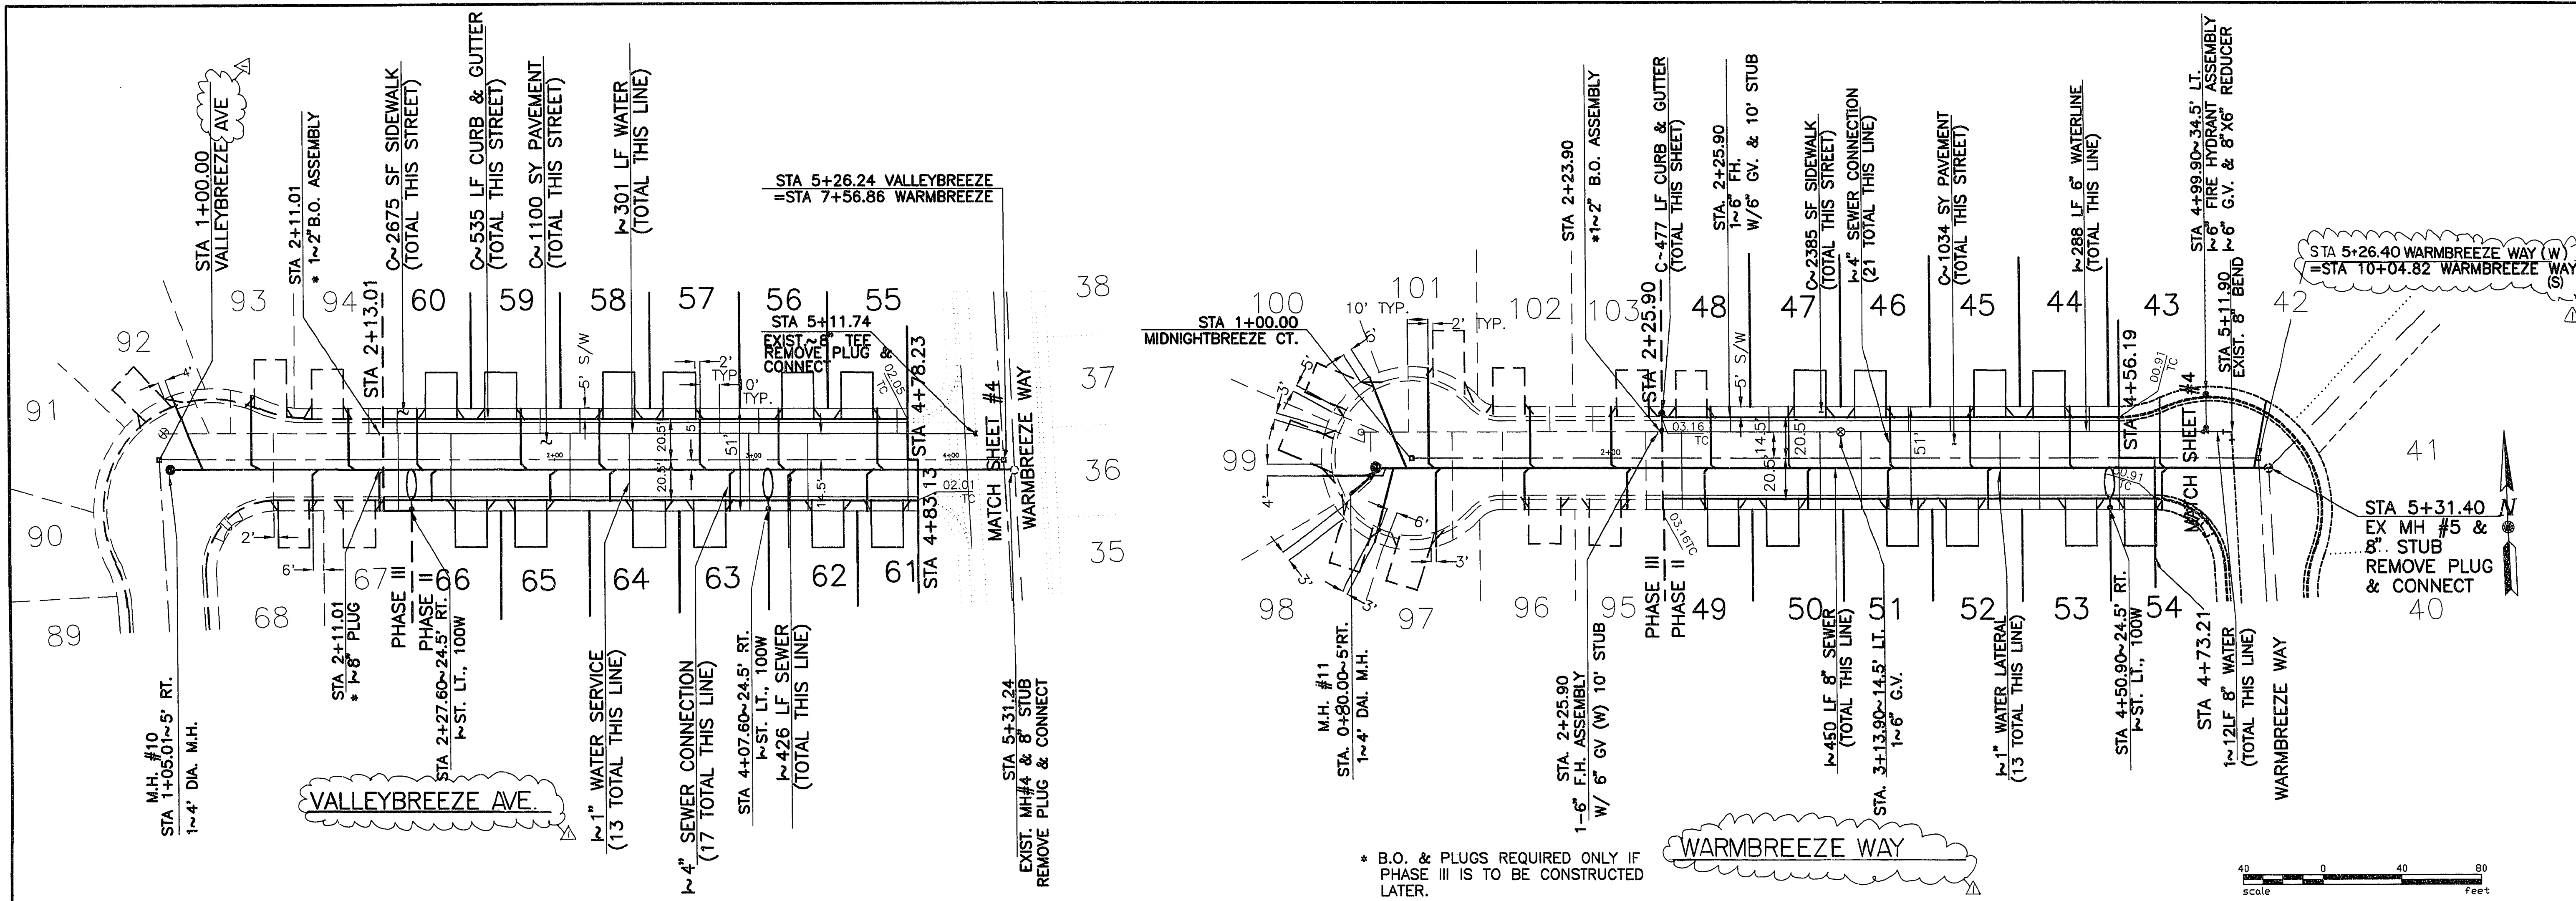

REVISIONS:

NO.	DATE	BY	REVISION
1	10/31/95	REVISED	STREET NAMES

Standage & Truitt Engineering, Ltd.
CIVIL ENGINEERING AND SURVEYING
6855 W. CHARLESTON BLVD.
LAS VEGAS, NEVADA 89117
PHONE (702) 255-2550

WINDGATE UNIT II

PROJECT: VALLEYBREEZE AVE & WARMBREEZE WAY

LAS VEGAS, NEVADA

DATE: JUNE 1994
JOB NO. 94042003
DRAWN BY: AEG

SHEET NO. 55 OF 55

11-16-92 107Y-4343-2